

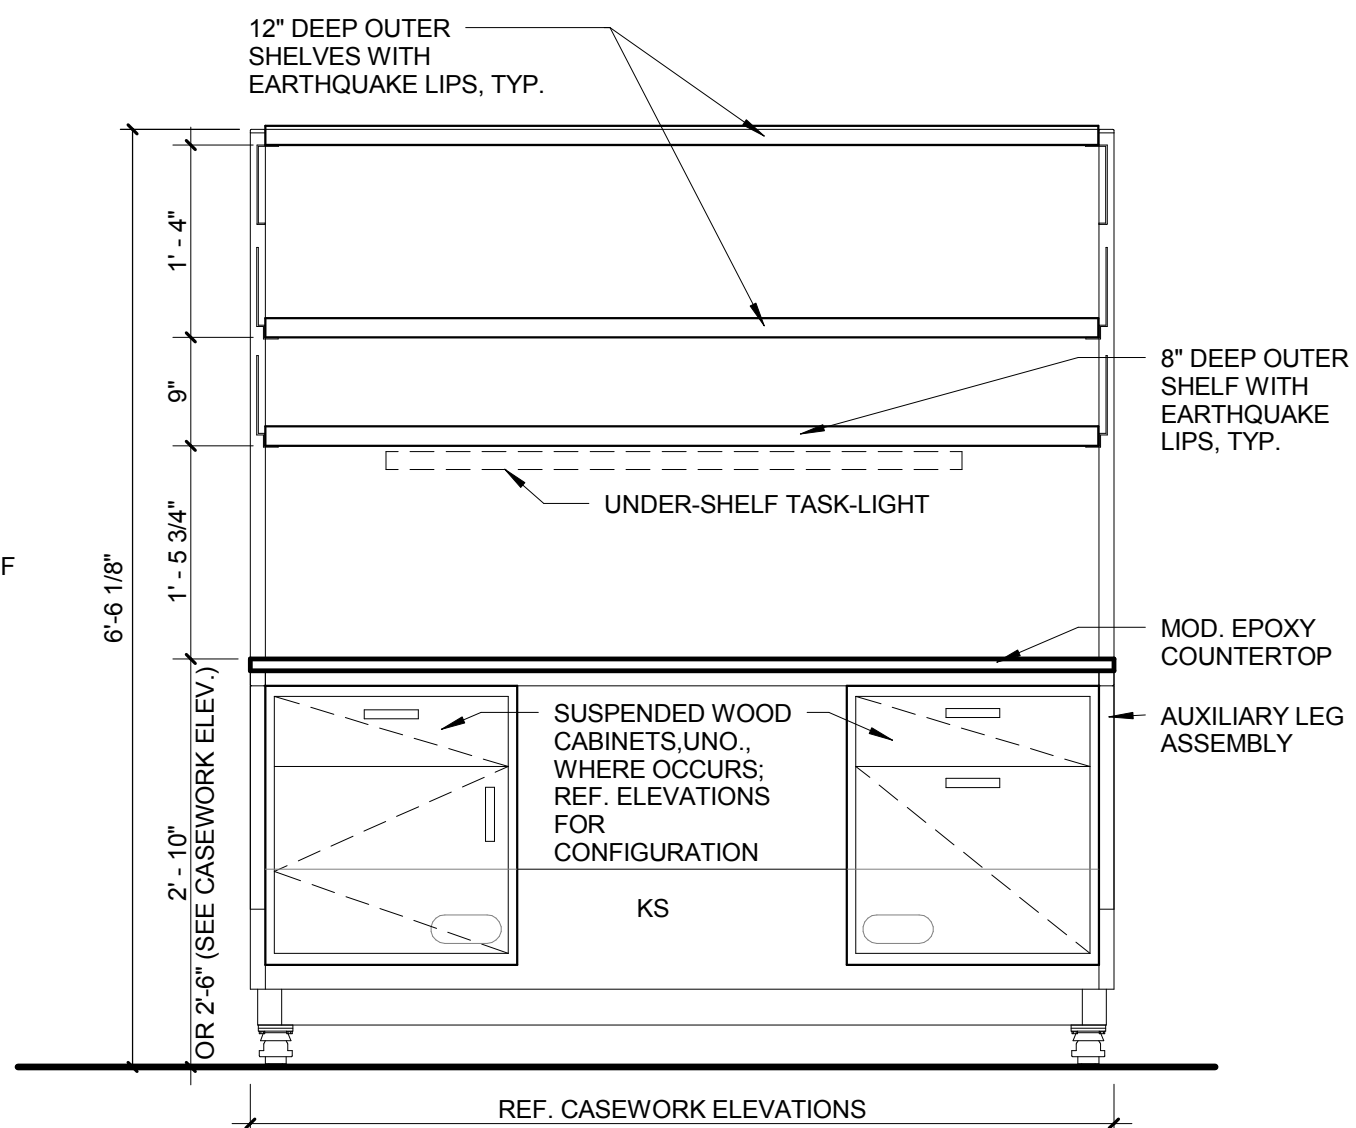



23-1/4" HIGH & 21-1/2" DEEP
SUSPENDED CABINETS -
WOOD (UNO.)

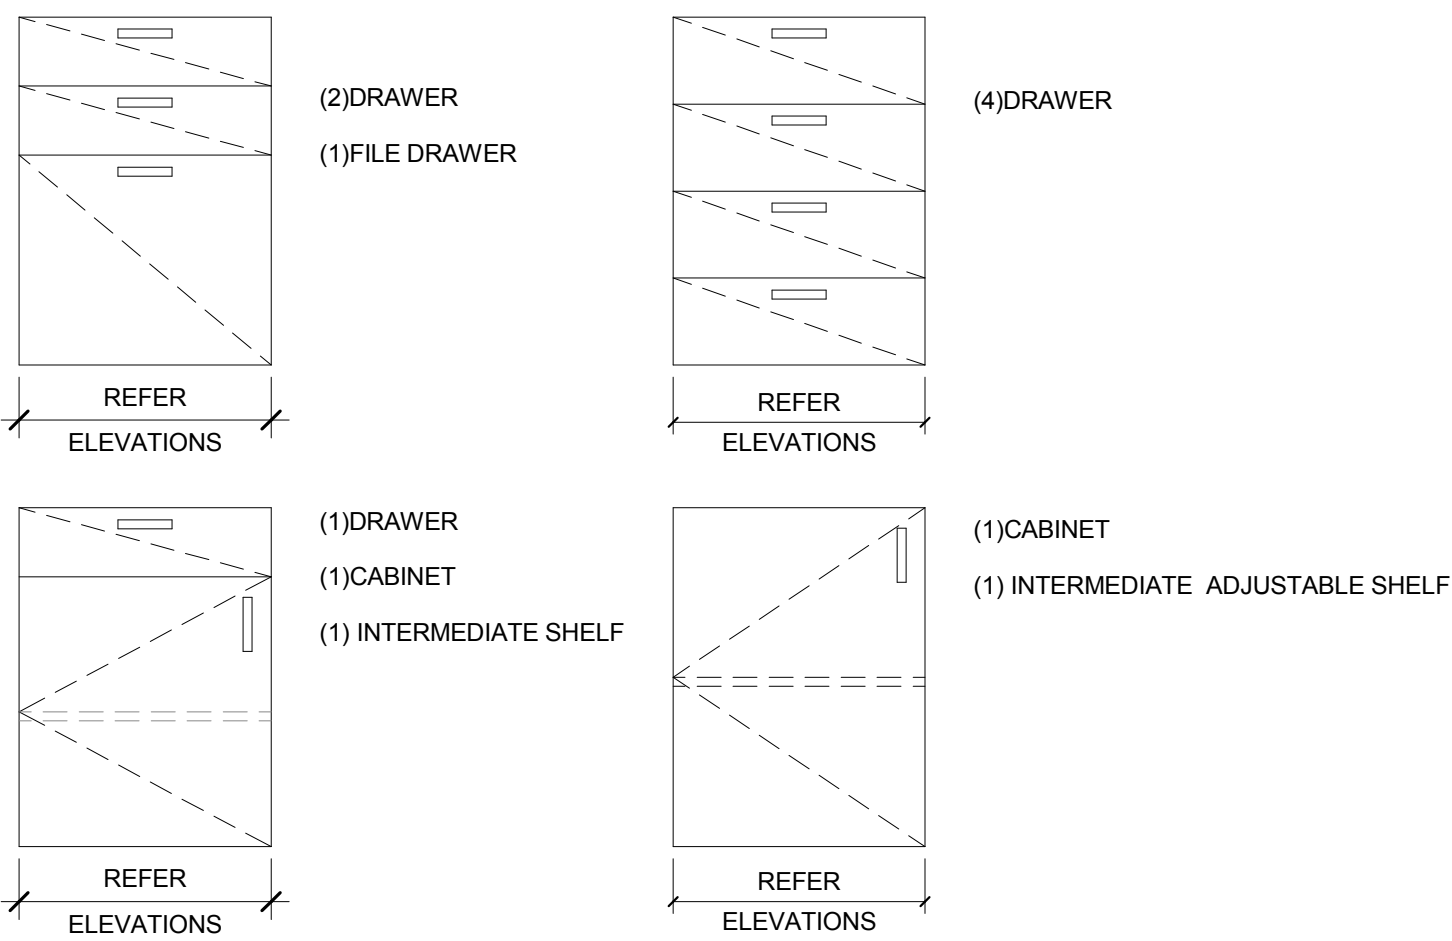

TYP. ELEVATION

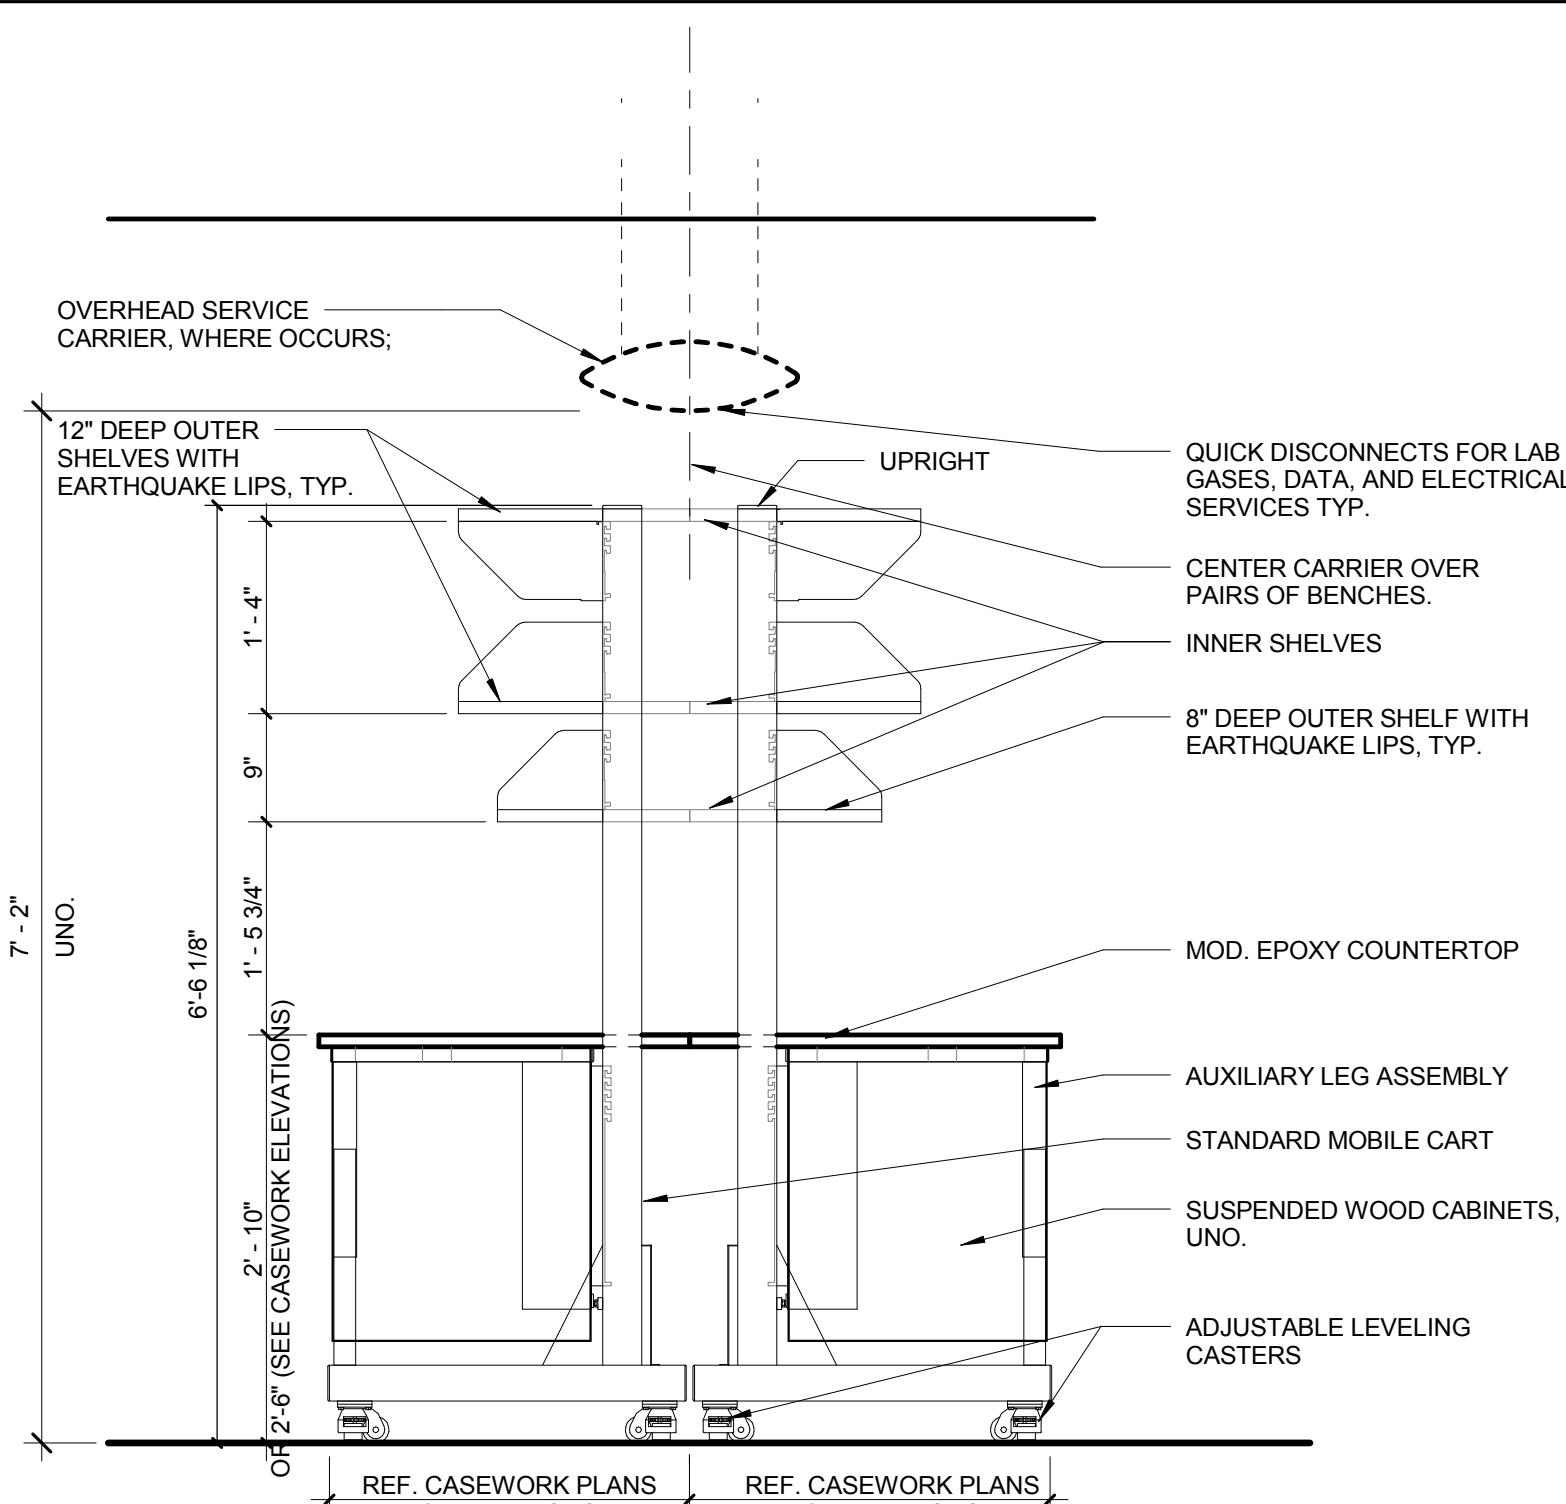


TYP. SECTION WITH SHELVES

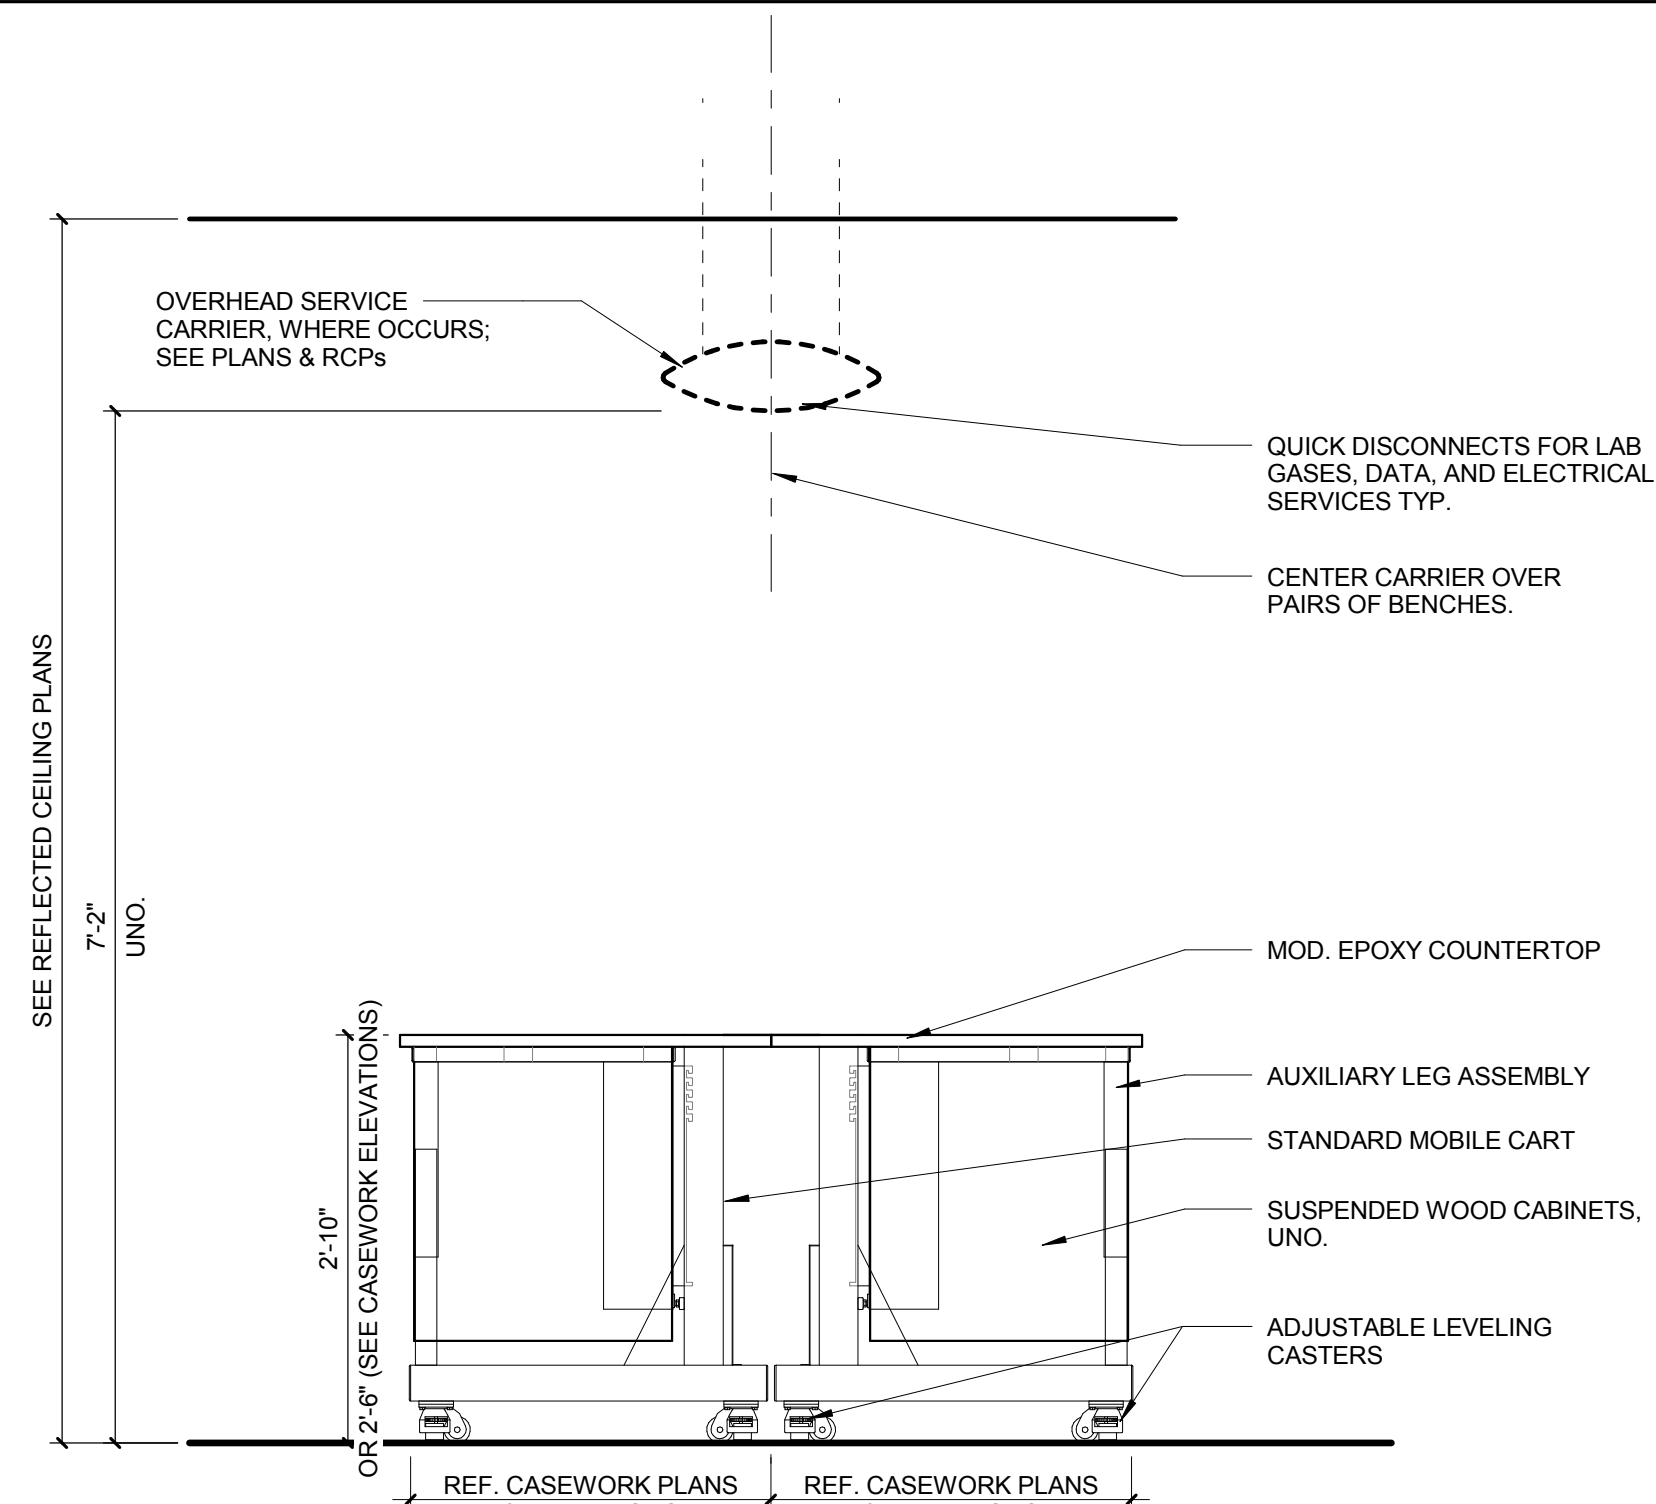


TYP. SECTION WITHOUT SHELVES


⑨ MOBILE CASEWORK DETAILS
3/4" = 1'-0"

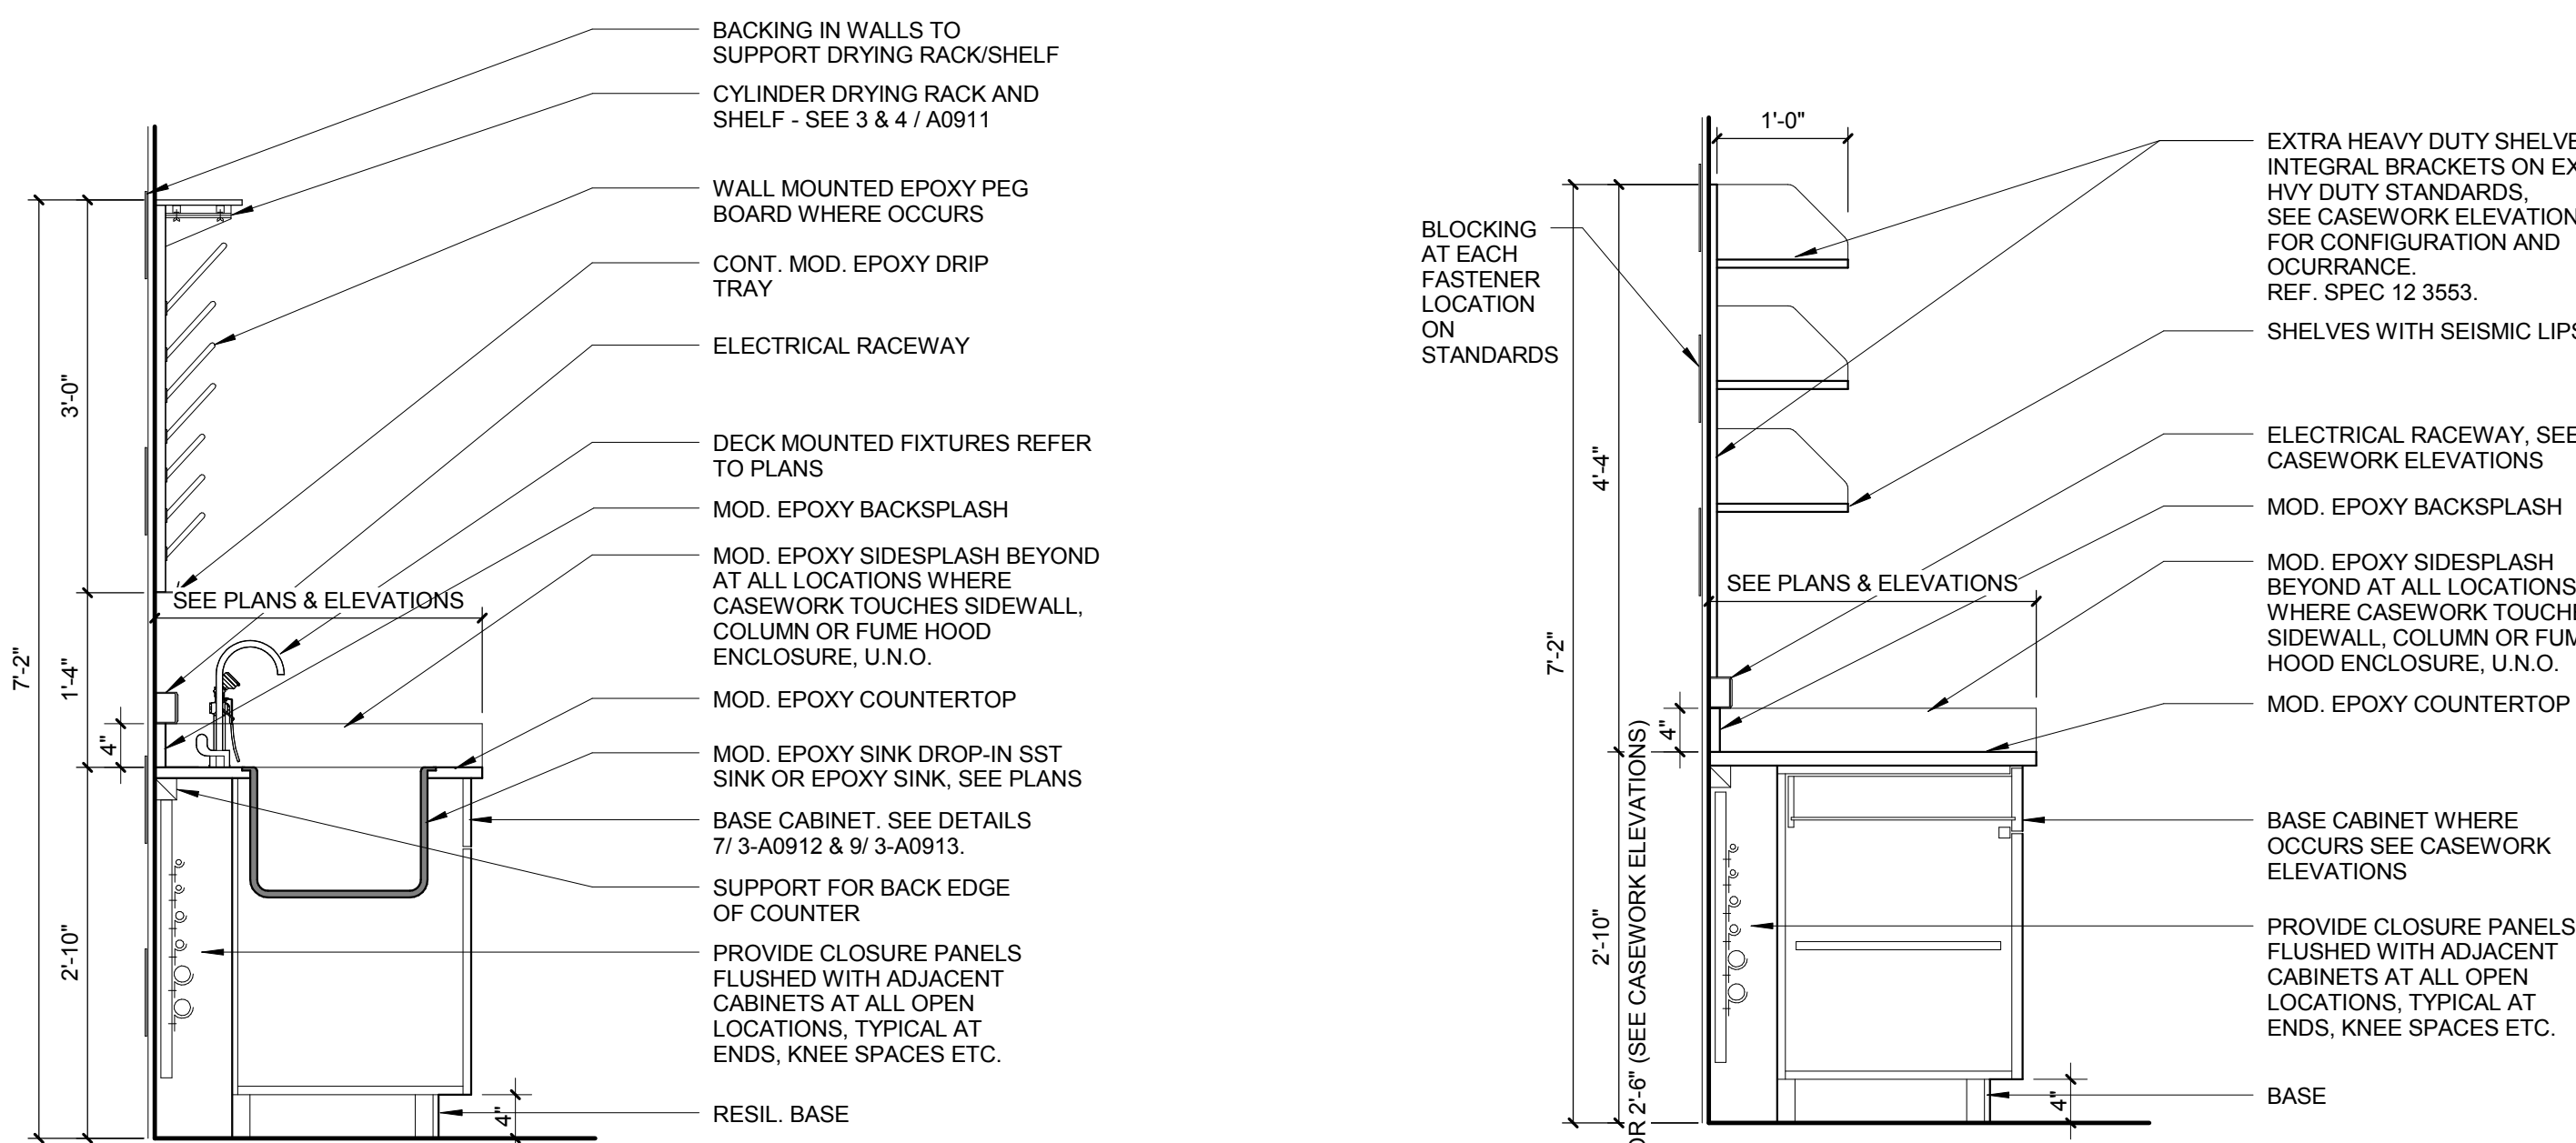

⑦ CASEWORK DETAILS
3/4" = 1'-0"

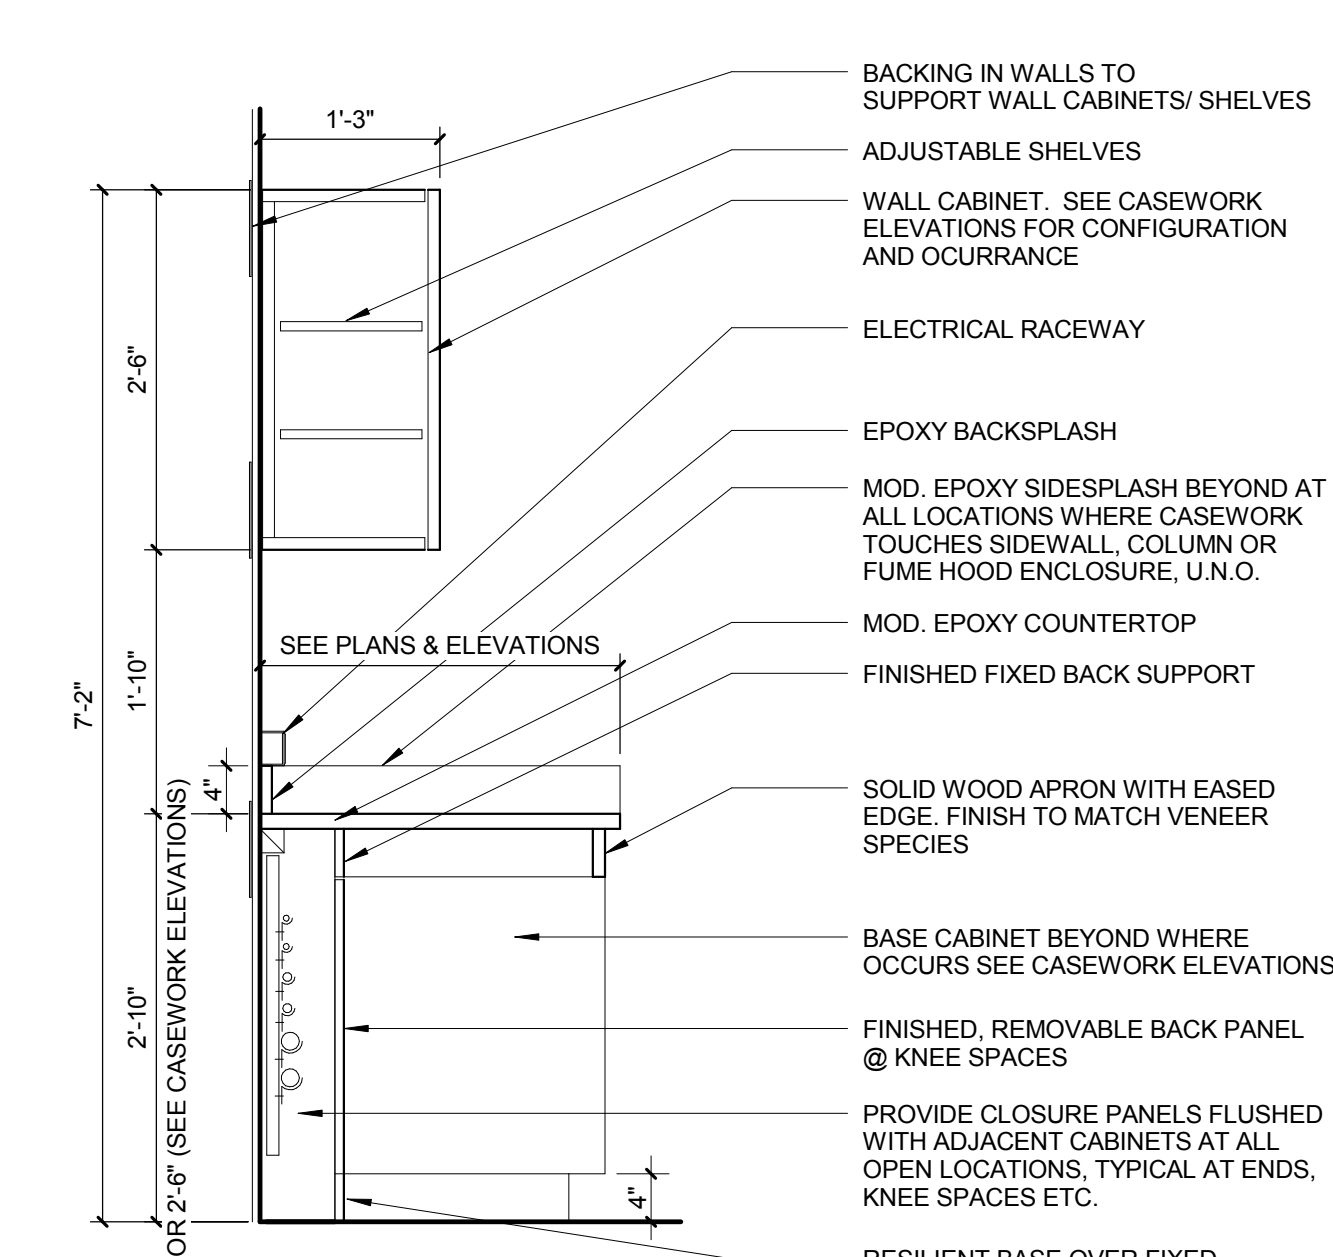


⑥ CASEWORK DETAILS
3/4" = 1'-0"

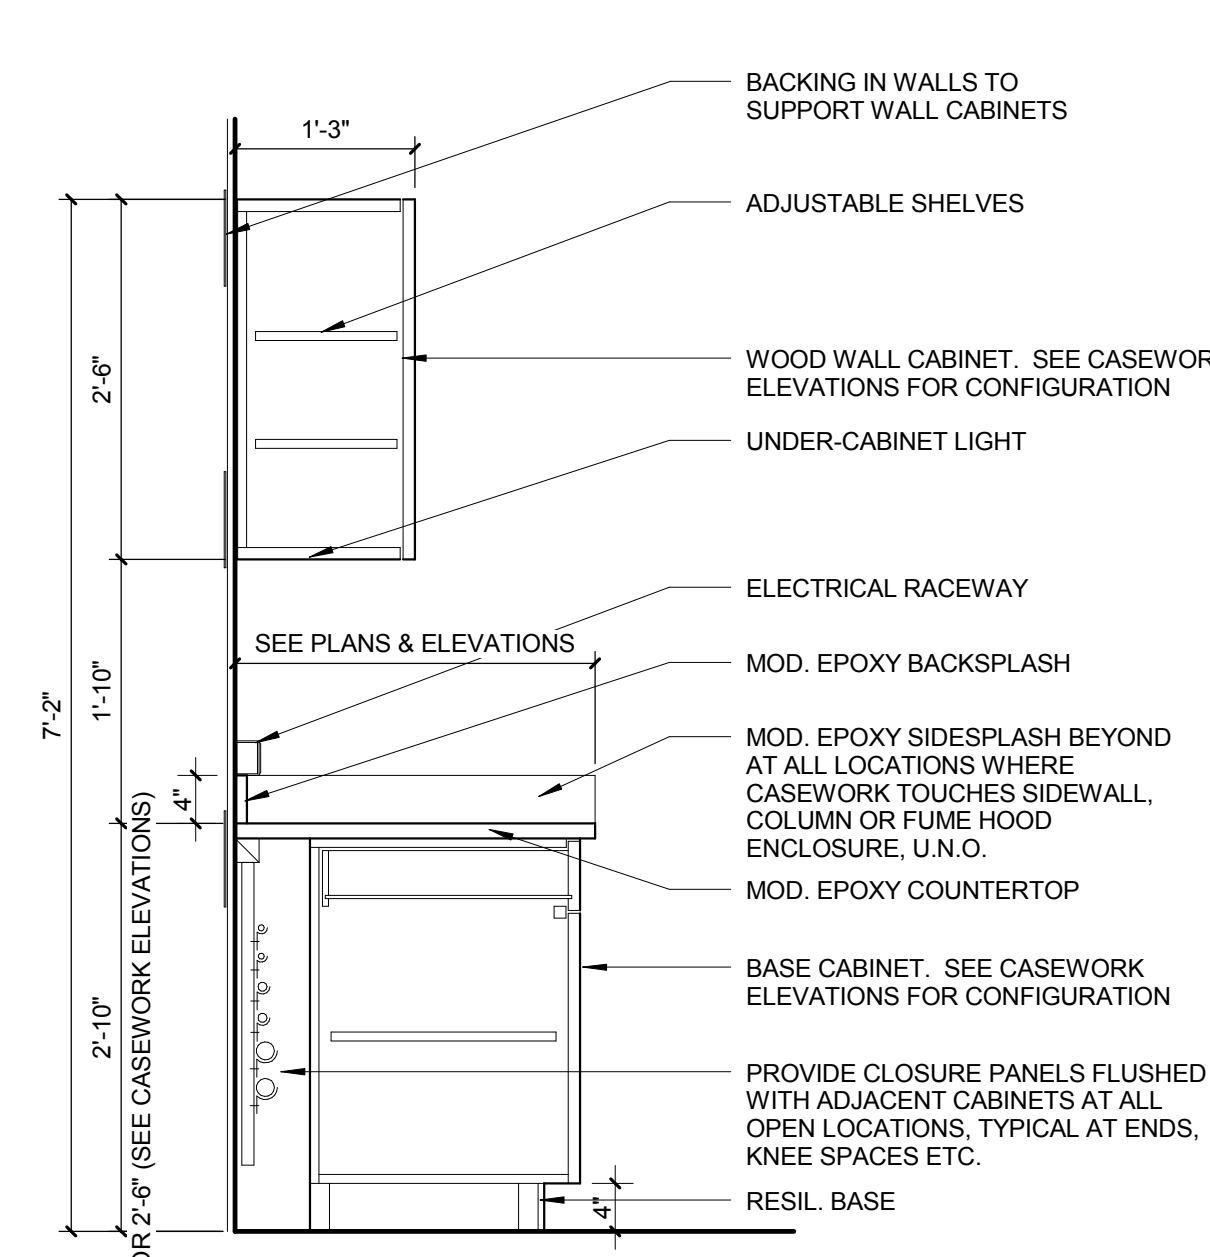


⑤ CASEWORK DETAILS
3/4" = 1'-0"

⑧ CASEWORK DETAILS
3/4" = 1'-0"

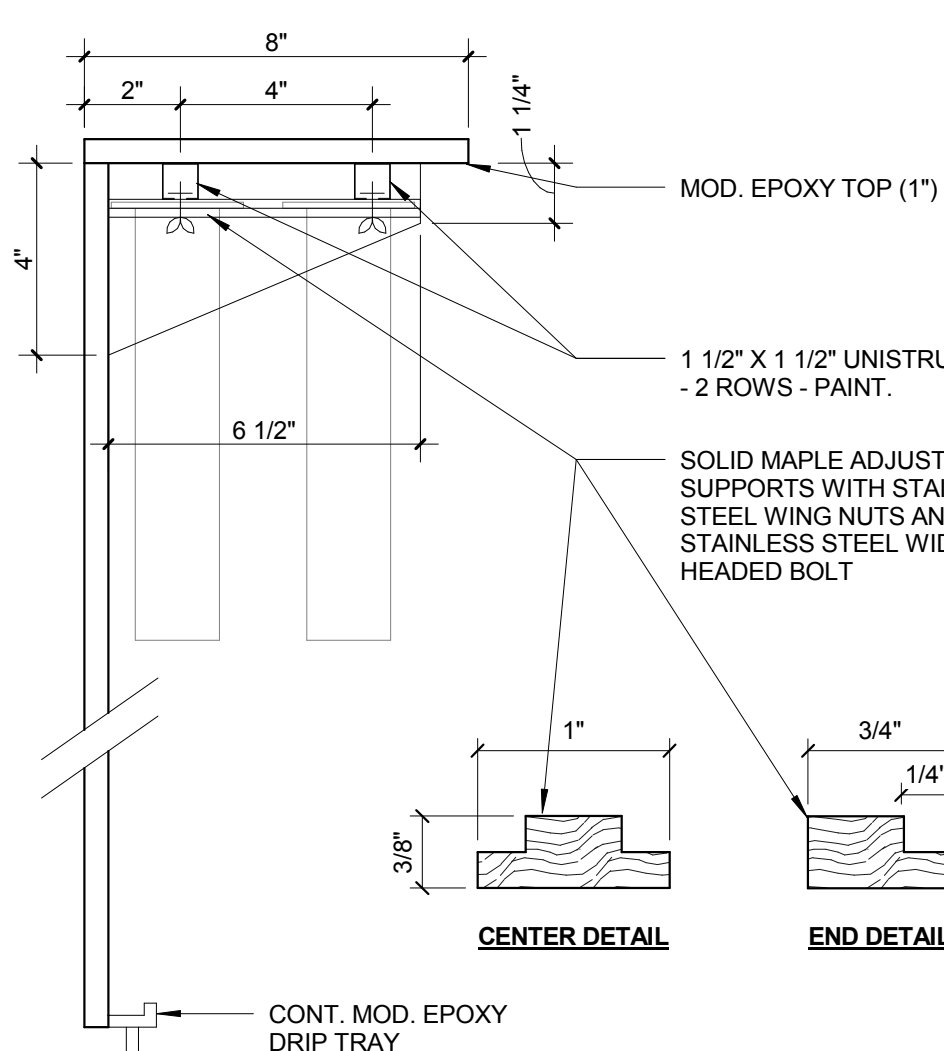


④ GRADUATED CYLINDER RACK - SECTION
3" = 1'-0"

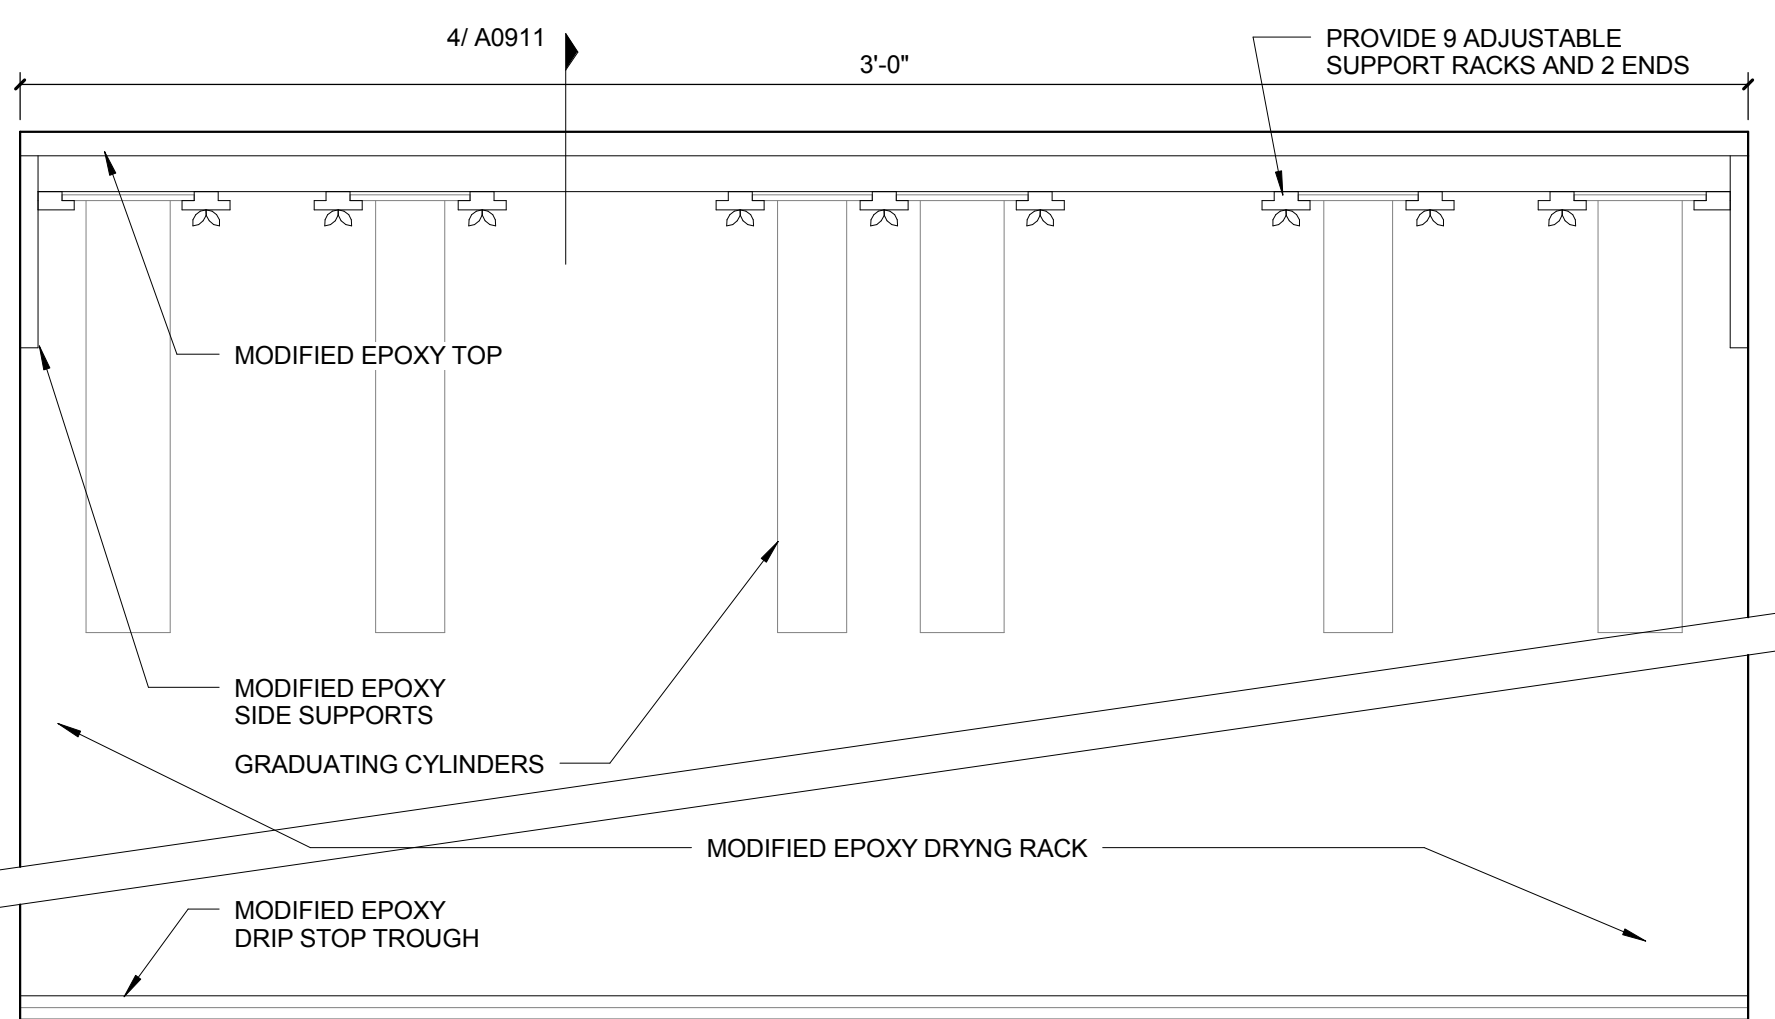


ELEVATION

GRADUATED CYLINDER RACK -

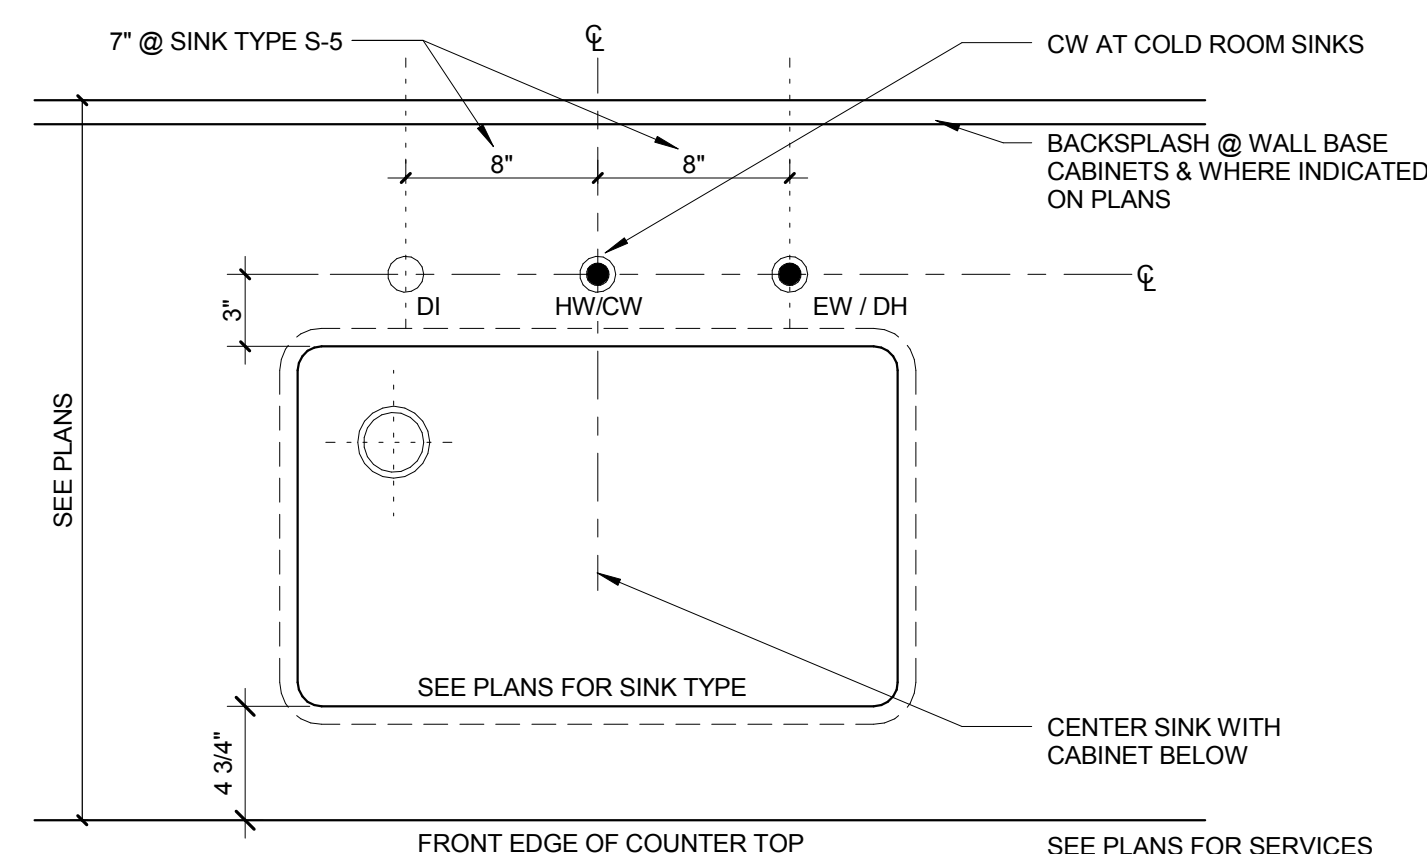

② TYP. SINK DETAIL @ BASE CABINETS
1 1/2" = 1'-0"

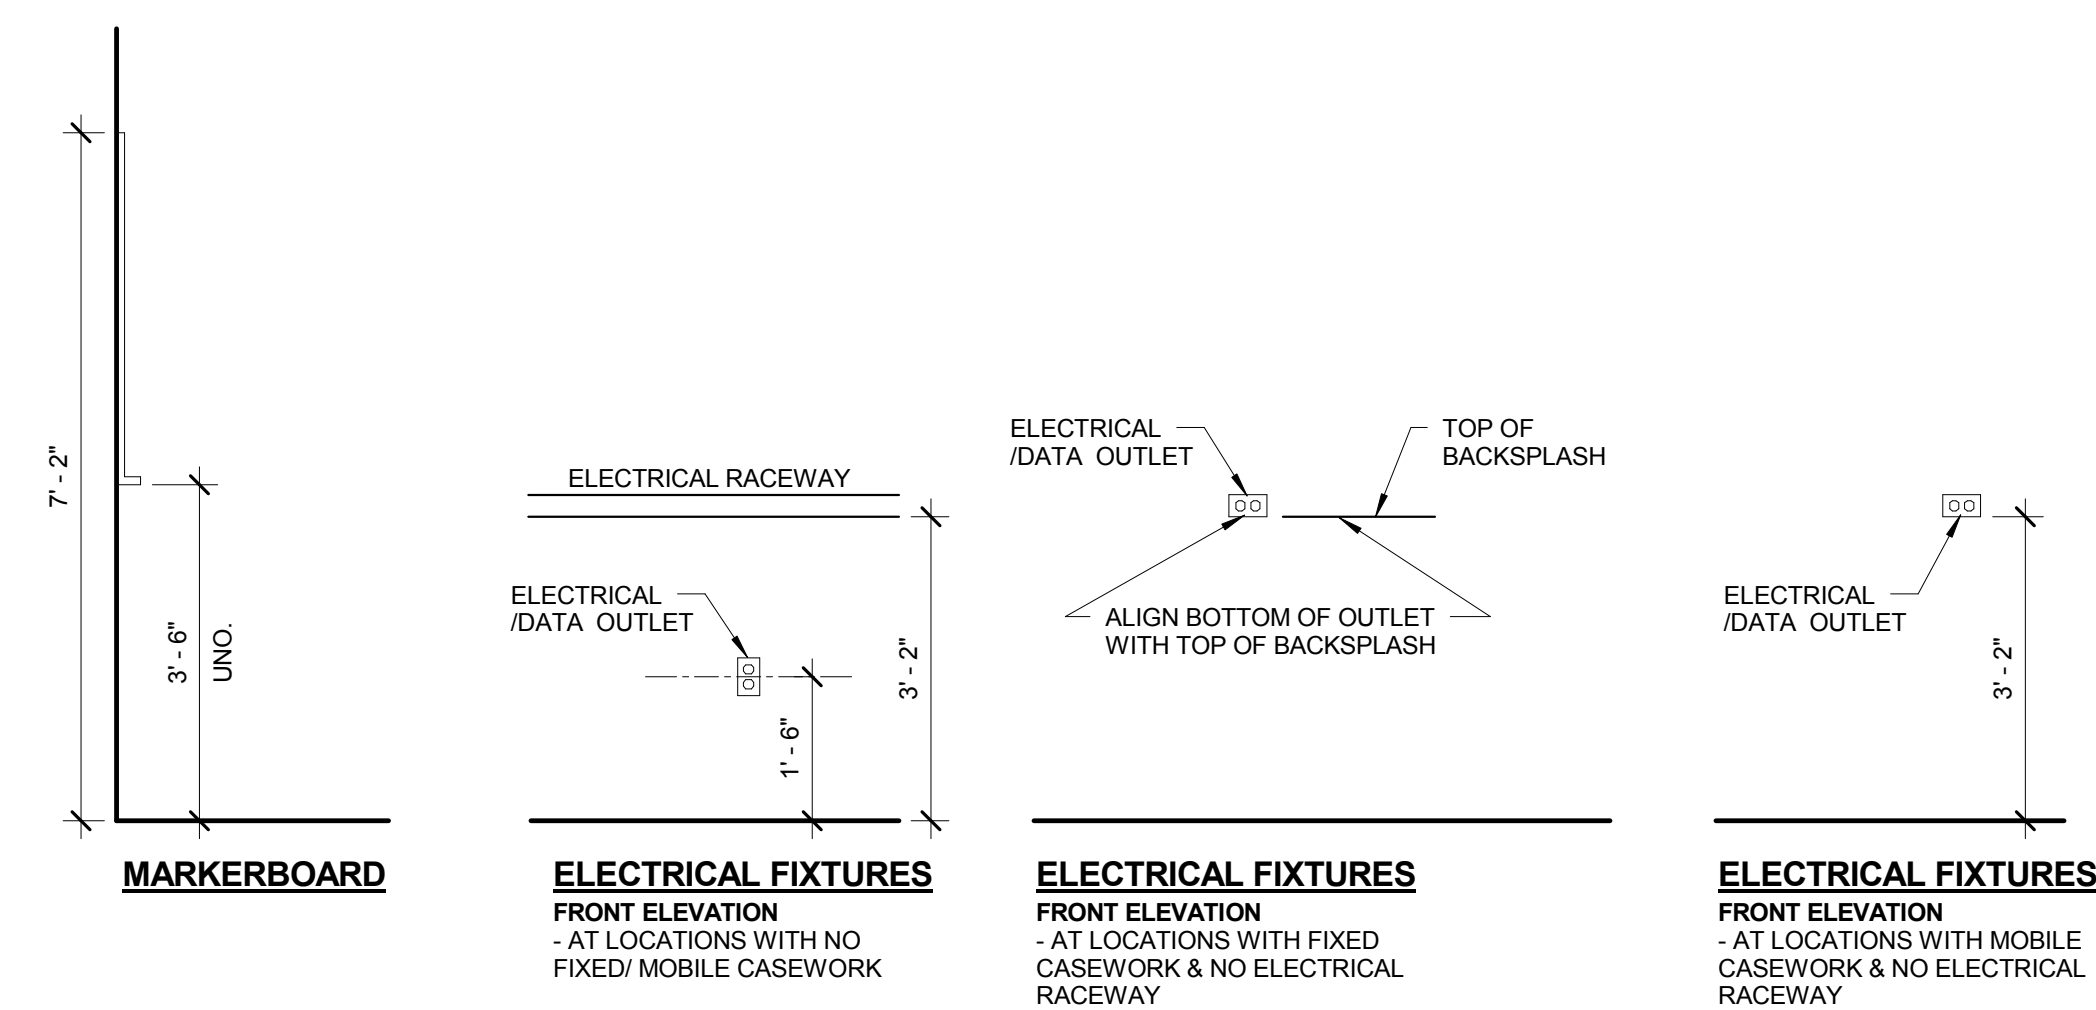

① LAB SERVICES MOUNTING HEIGHTS
1/2" = 1'-0"

