




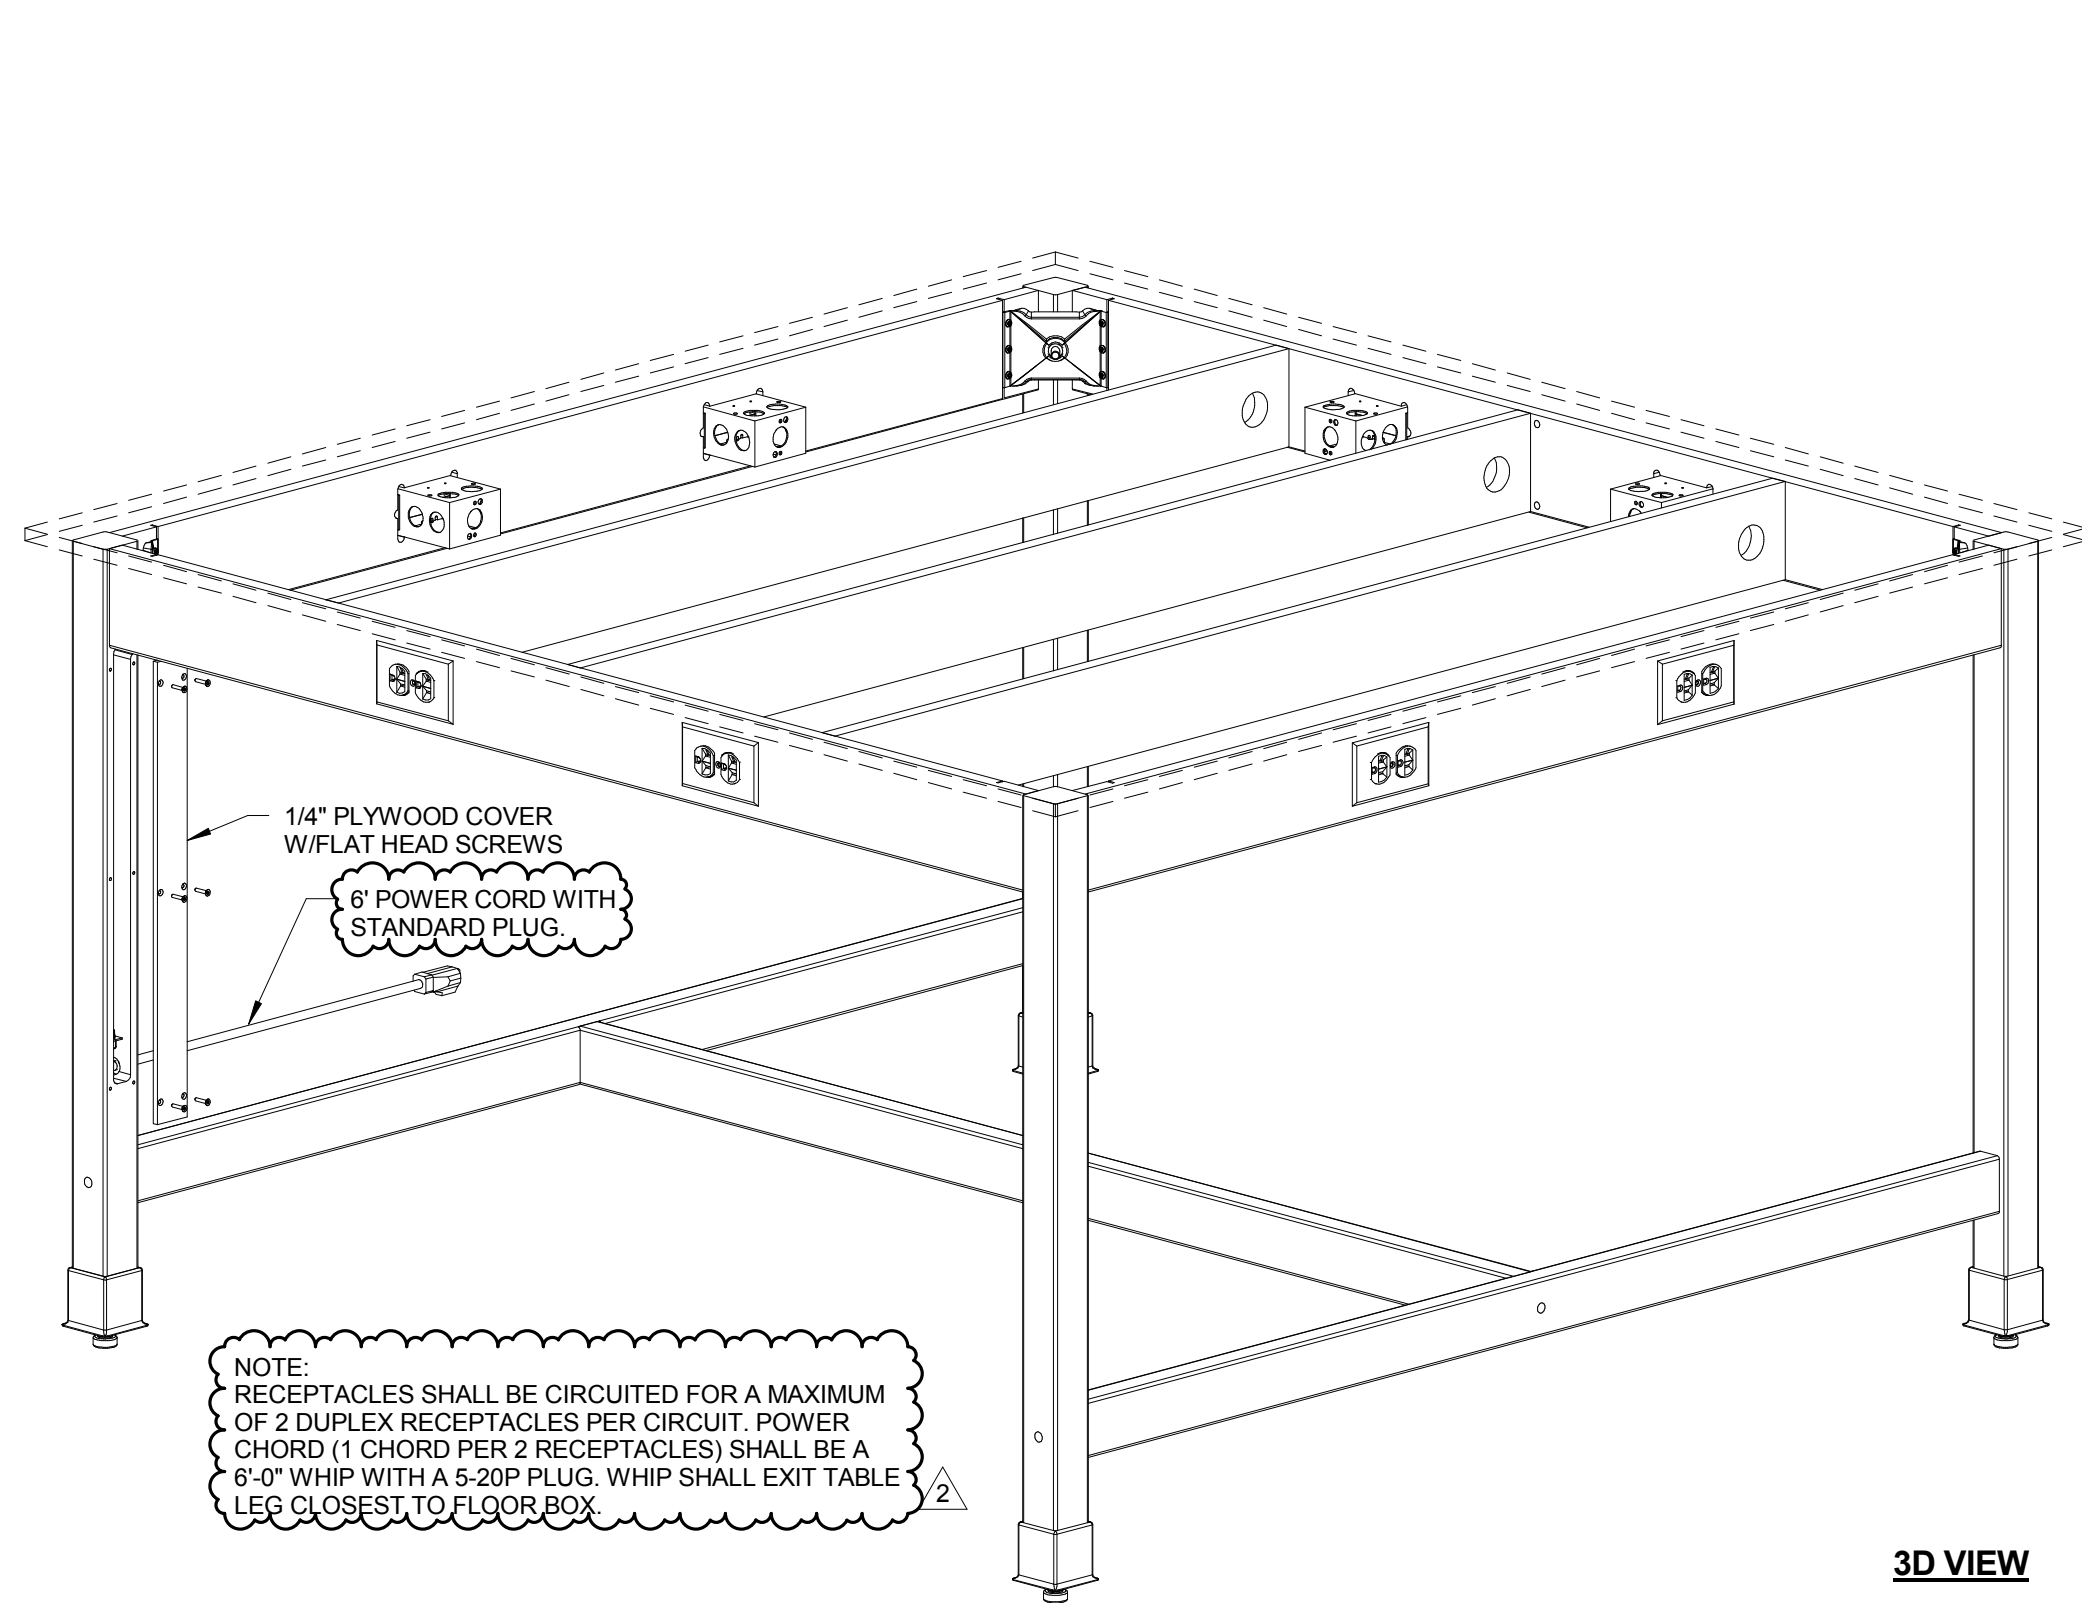


12 TABLE WITH ELEC. OUTLETS ON APRON
3/4" = 1'-0"

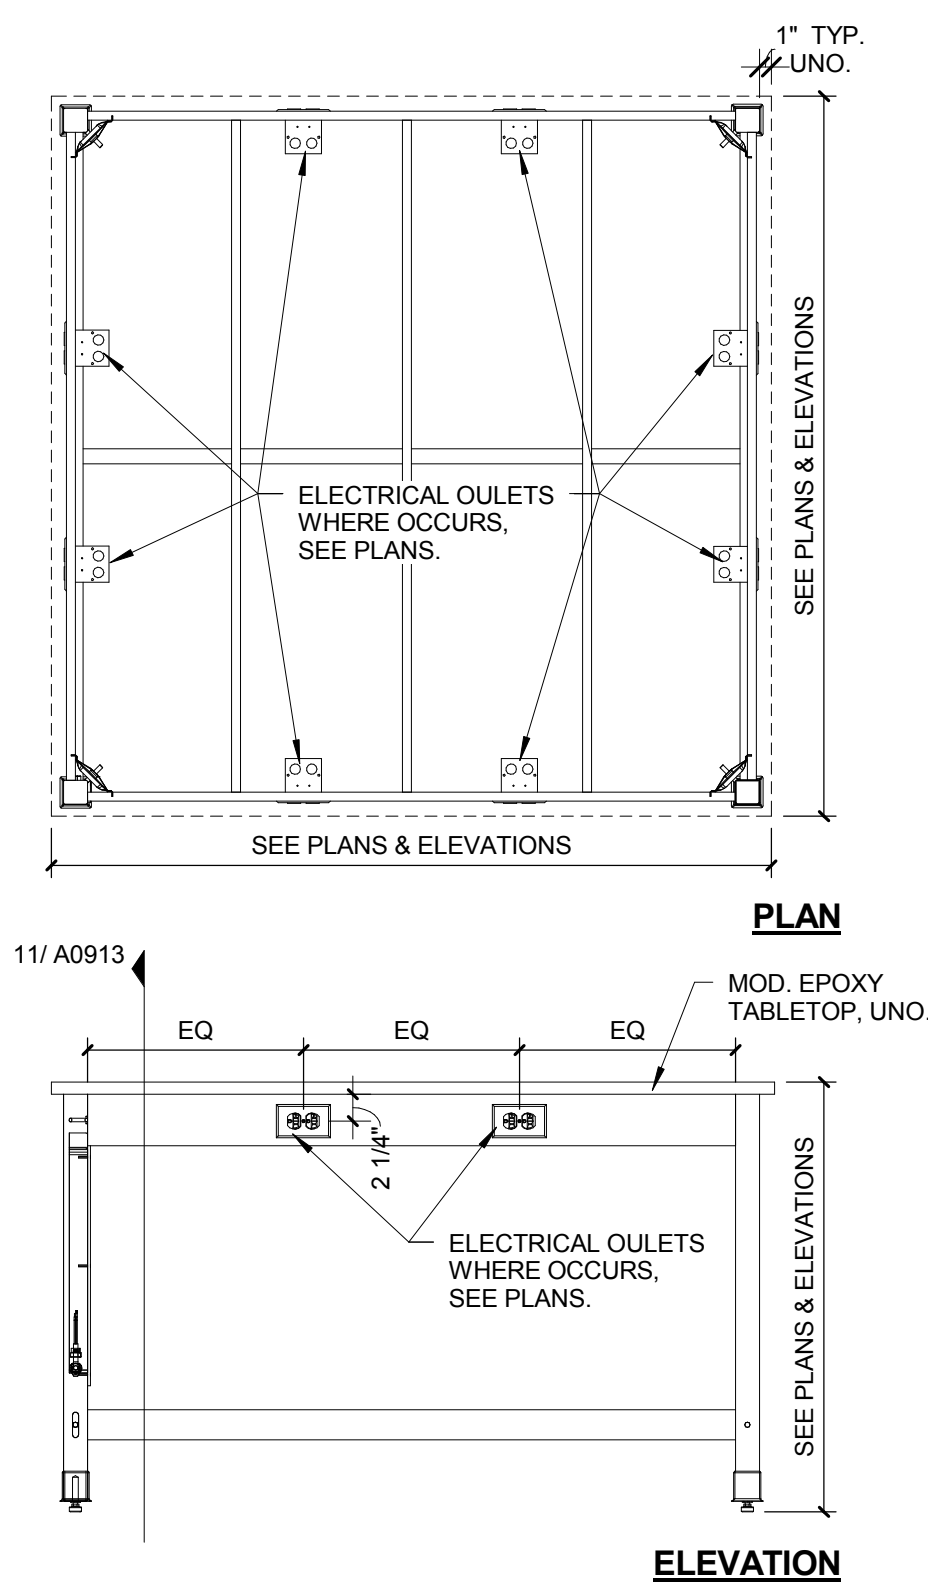


11 TABLE LEG DETAIL
1 1/2" = 1'-0"

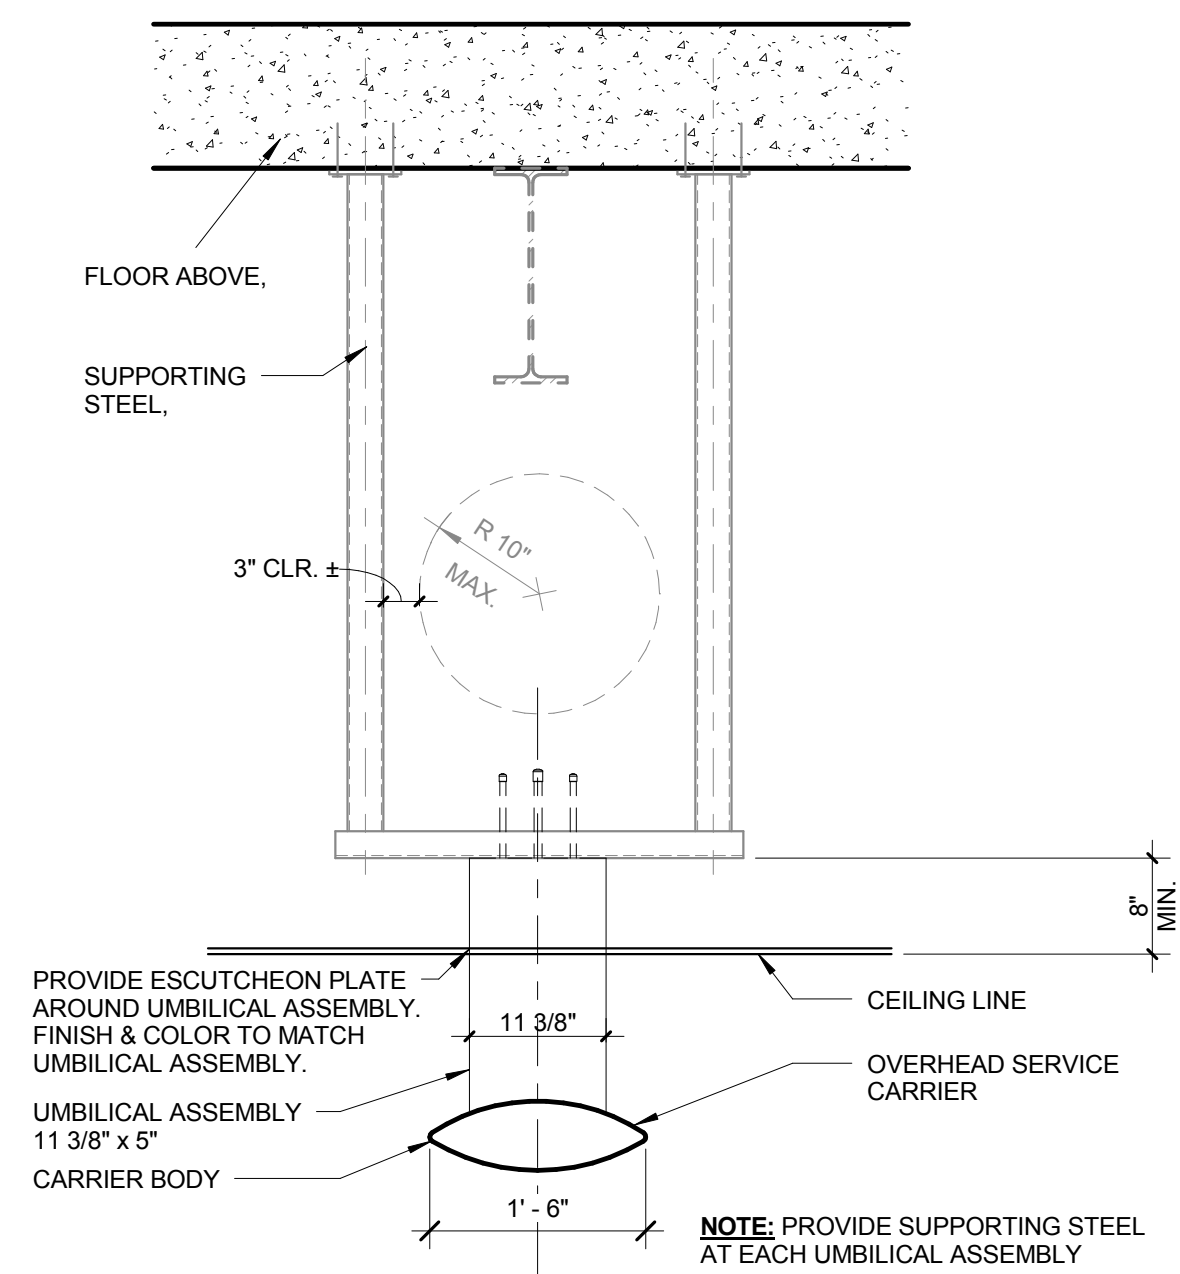


10 OSC MOUNTING DETAIL
3/4" = 1'-0"

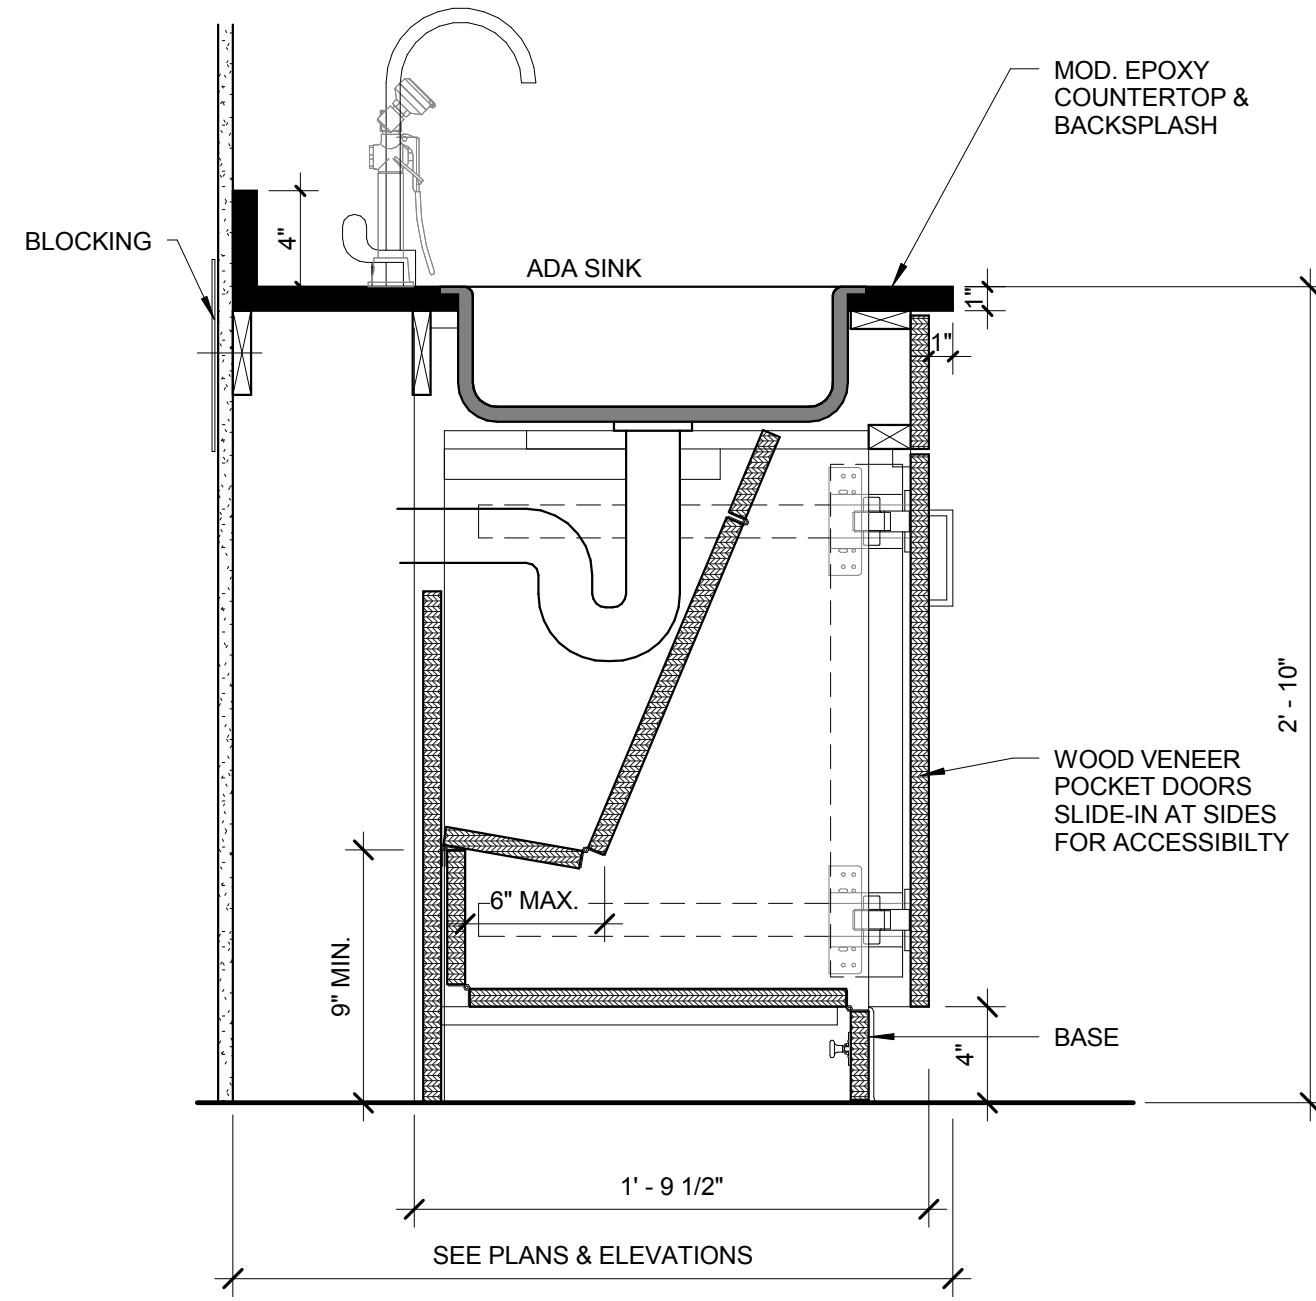


9 ADA SINK DETAIL AT SINK TYPES - S-2, S-4, S-5
1 1/2" = 1'-0"

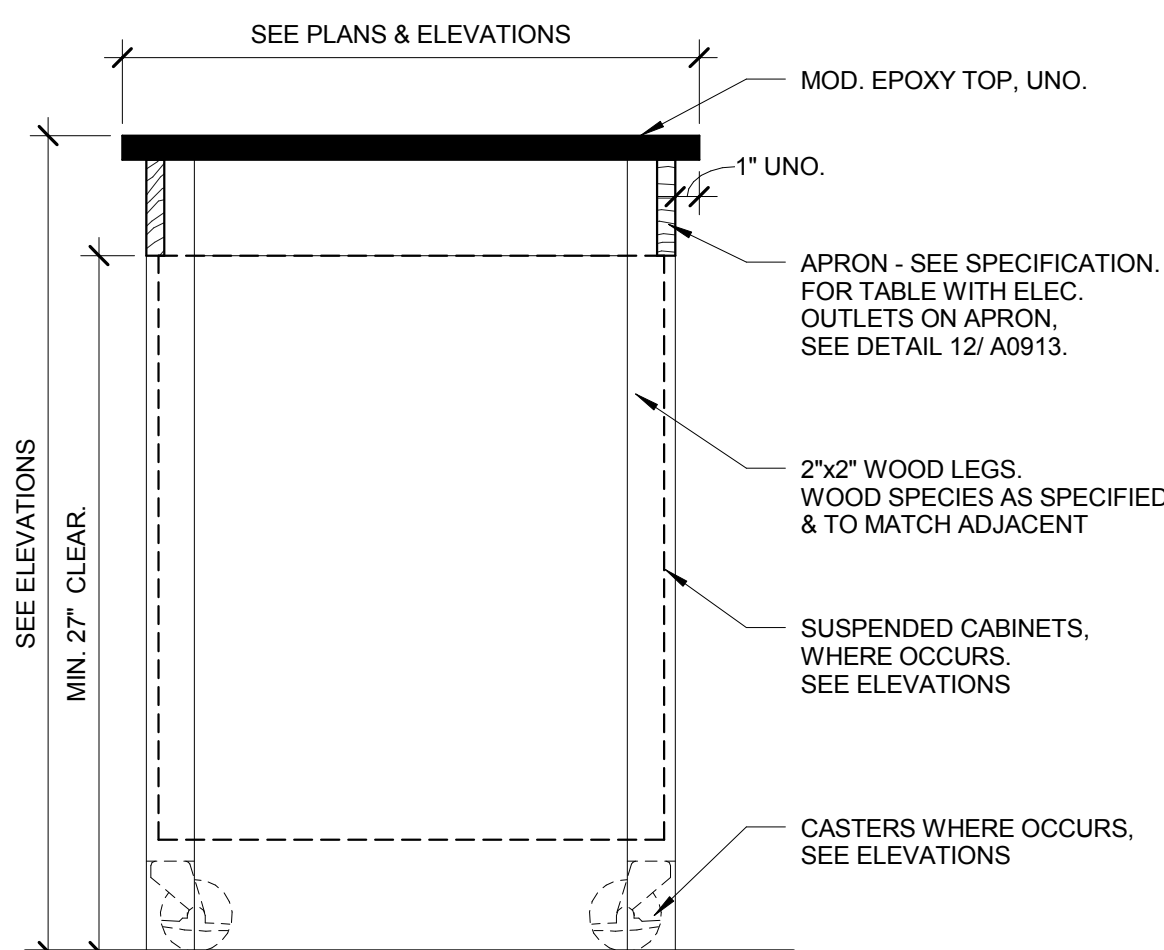


8 TYP. TABLE DETAIL
1 1/2" = 1'-0"

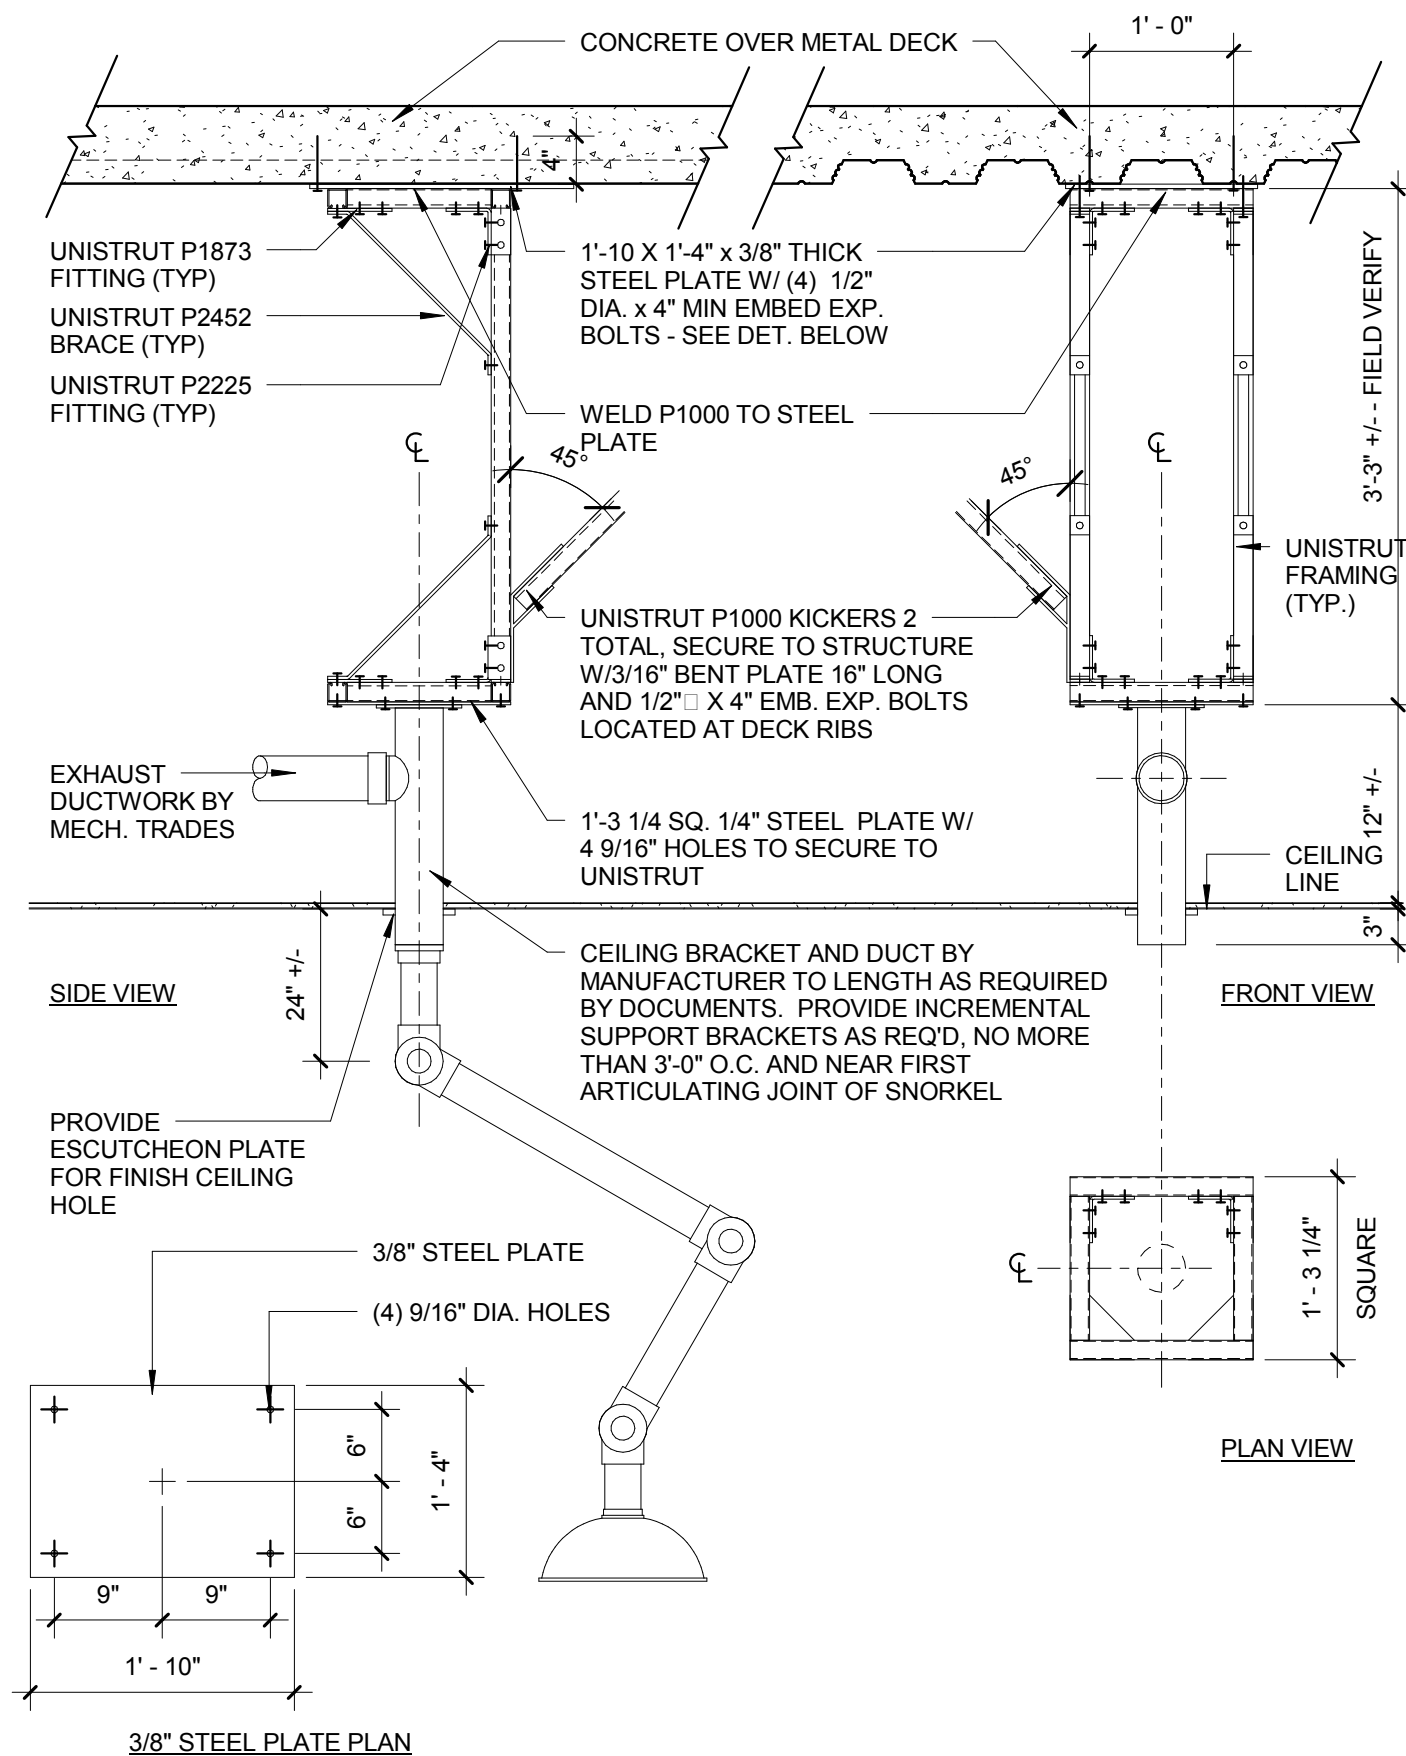


5 SNORKEL EXHAUST MOUNTING DETAIL
3/4" = 1'-0"

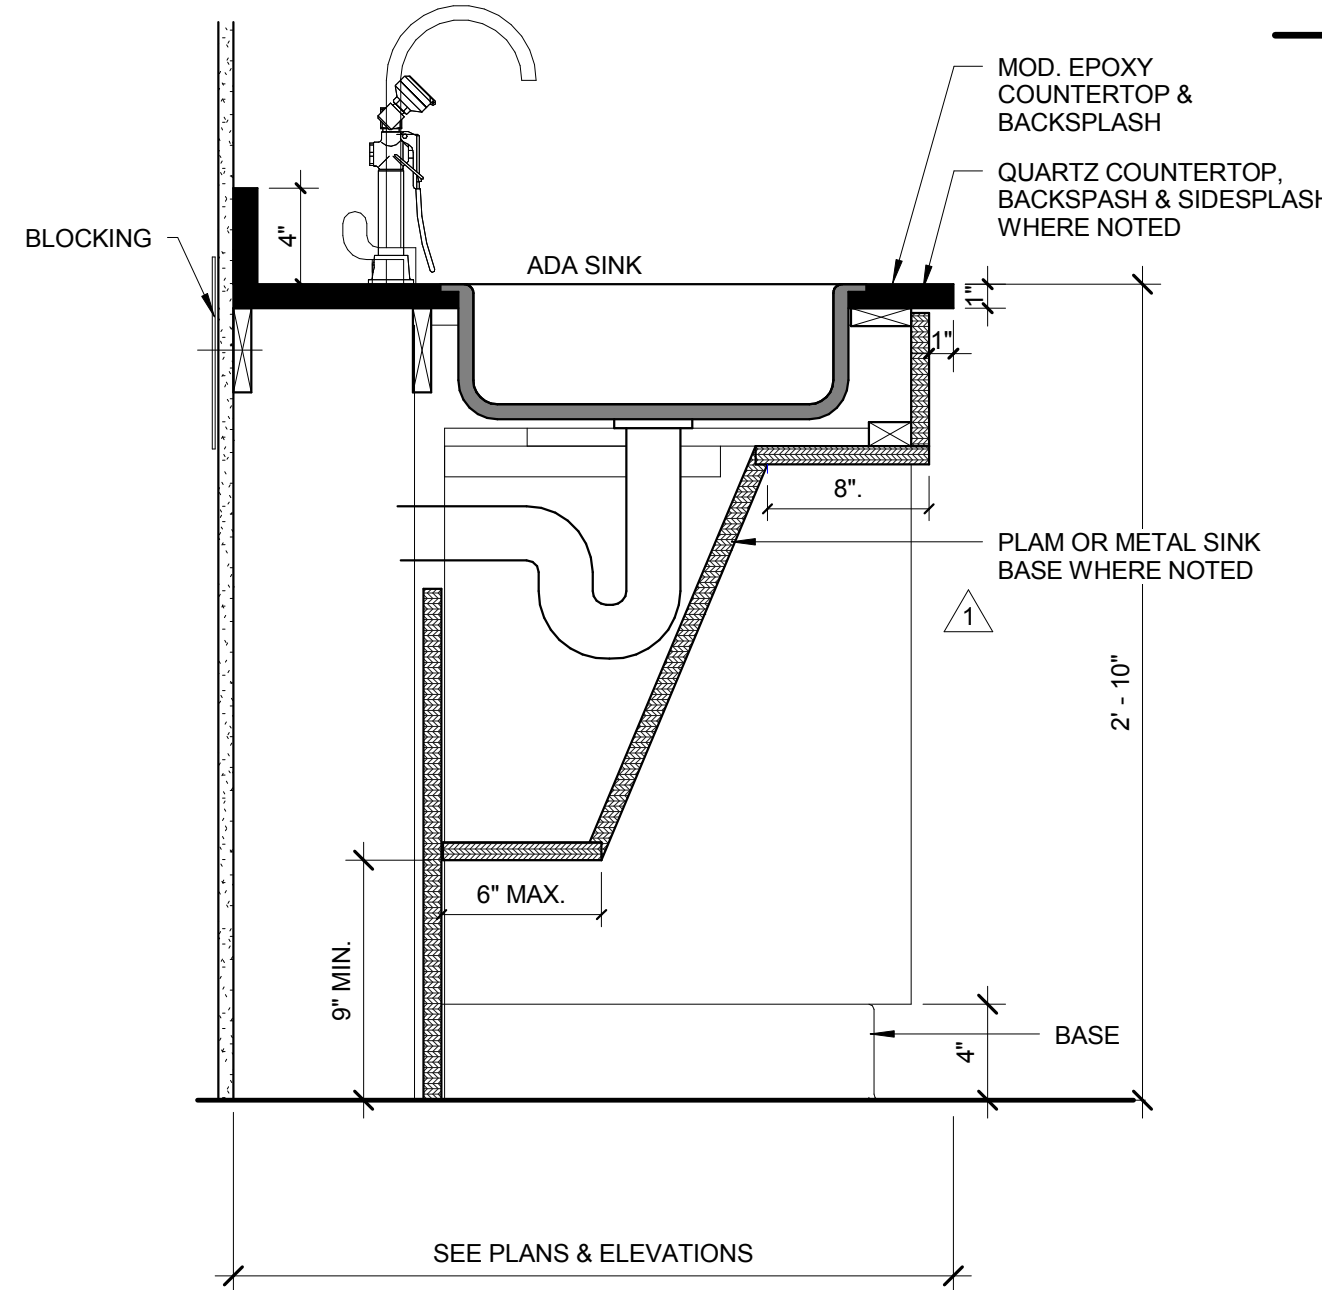


4 ADA SINK DETAIL W/O POCKET DOORS
1 1/2" = 1'-0"

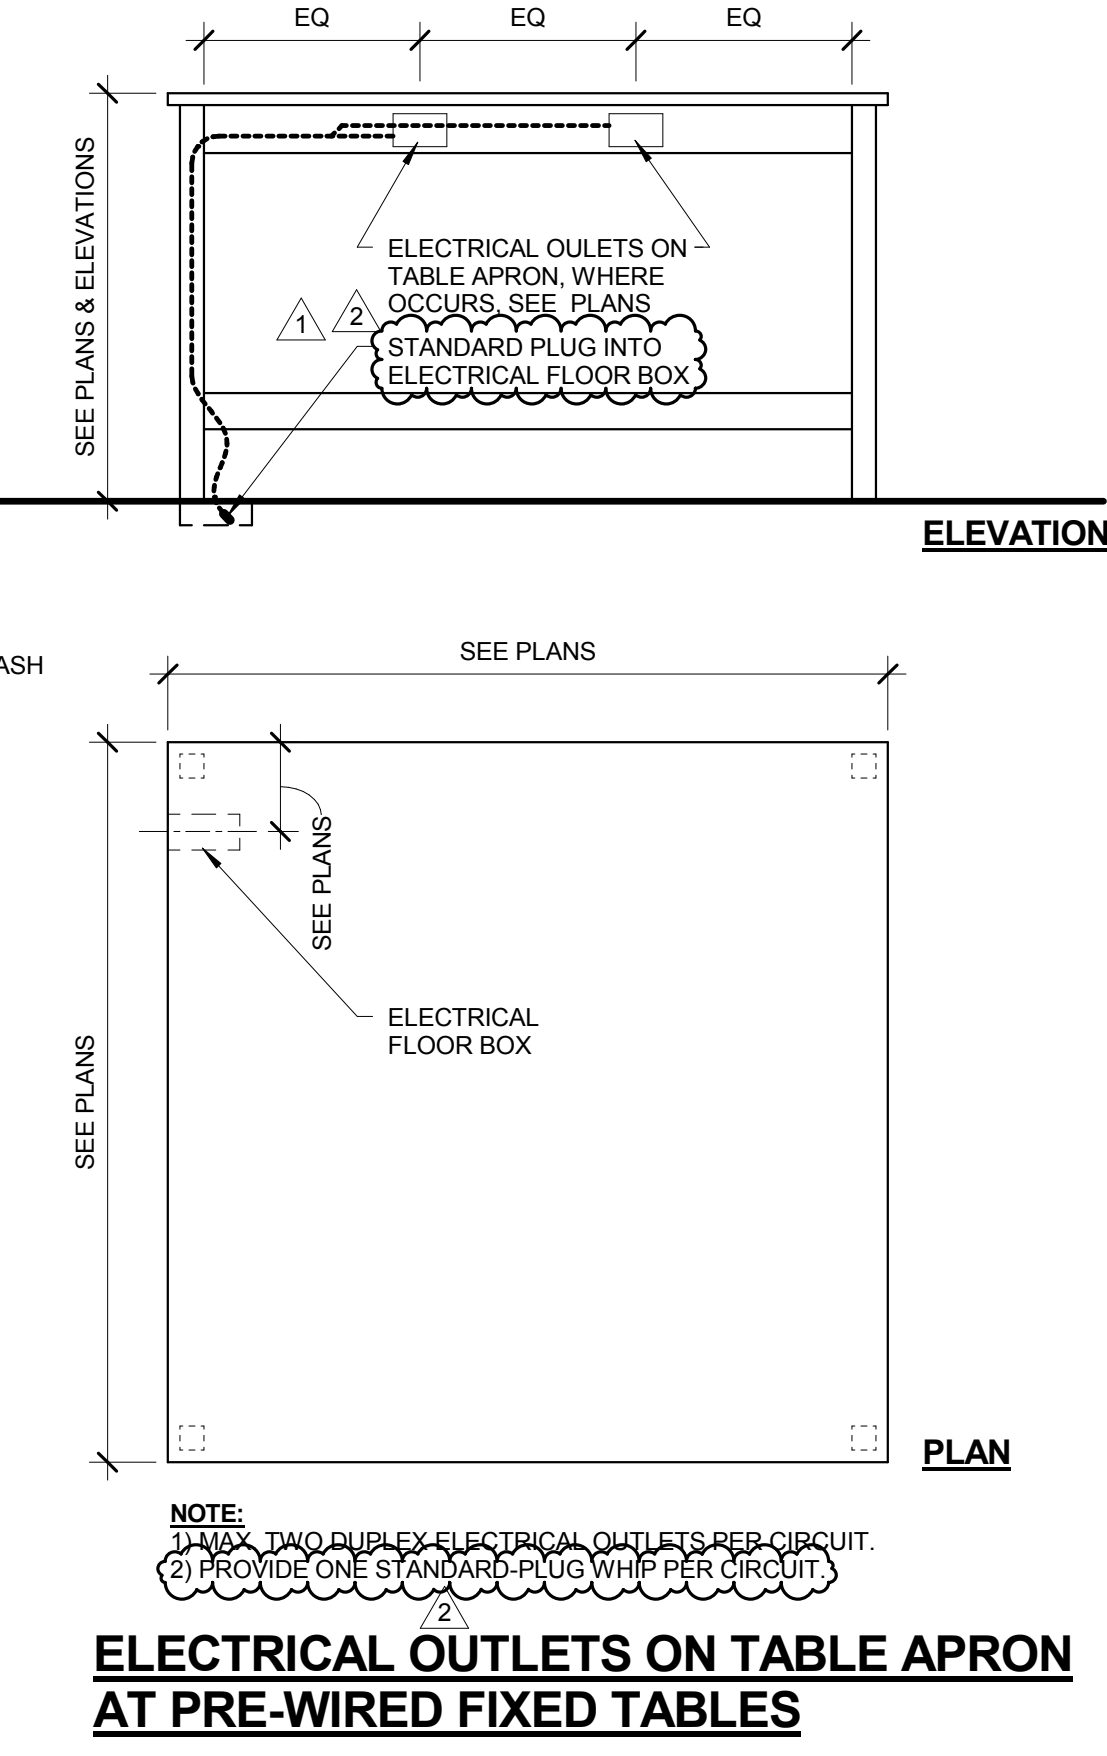


3 ELEC. OUTLETS AT TABLE APRON
3/4" = 1'-0"

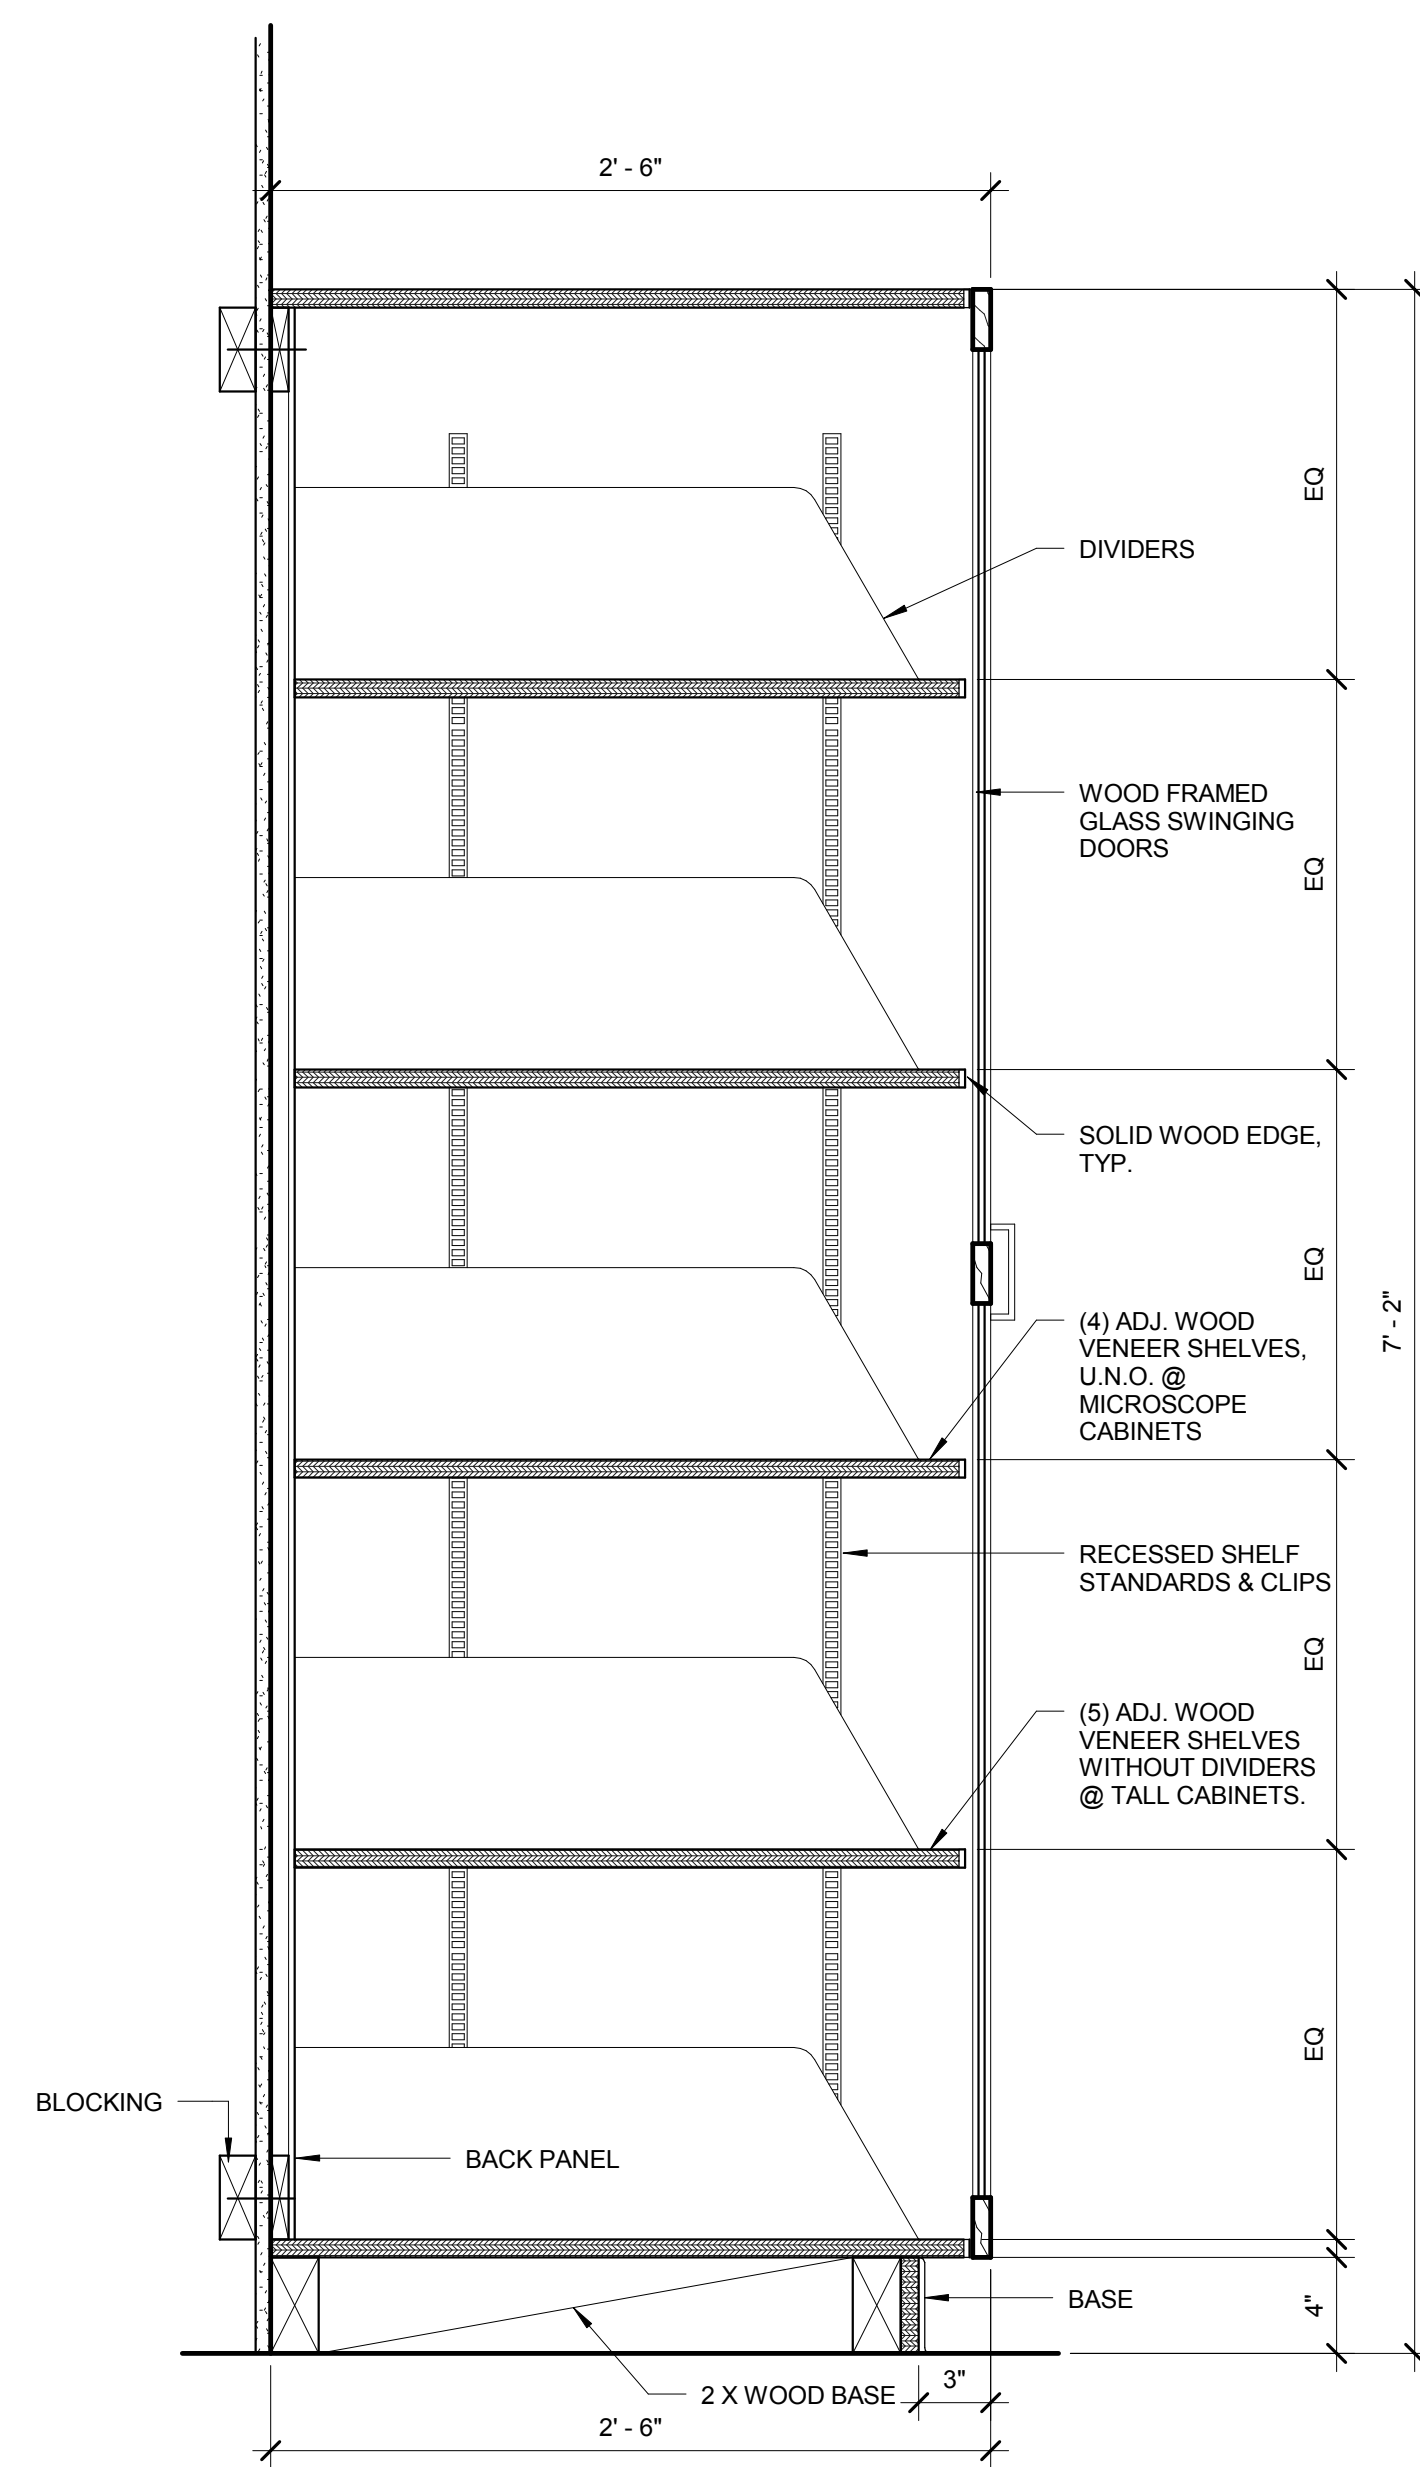


7 MICROSCOPE CABINET & TALL CABINET DETAIL
1 1/2" = 1'-0"

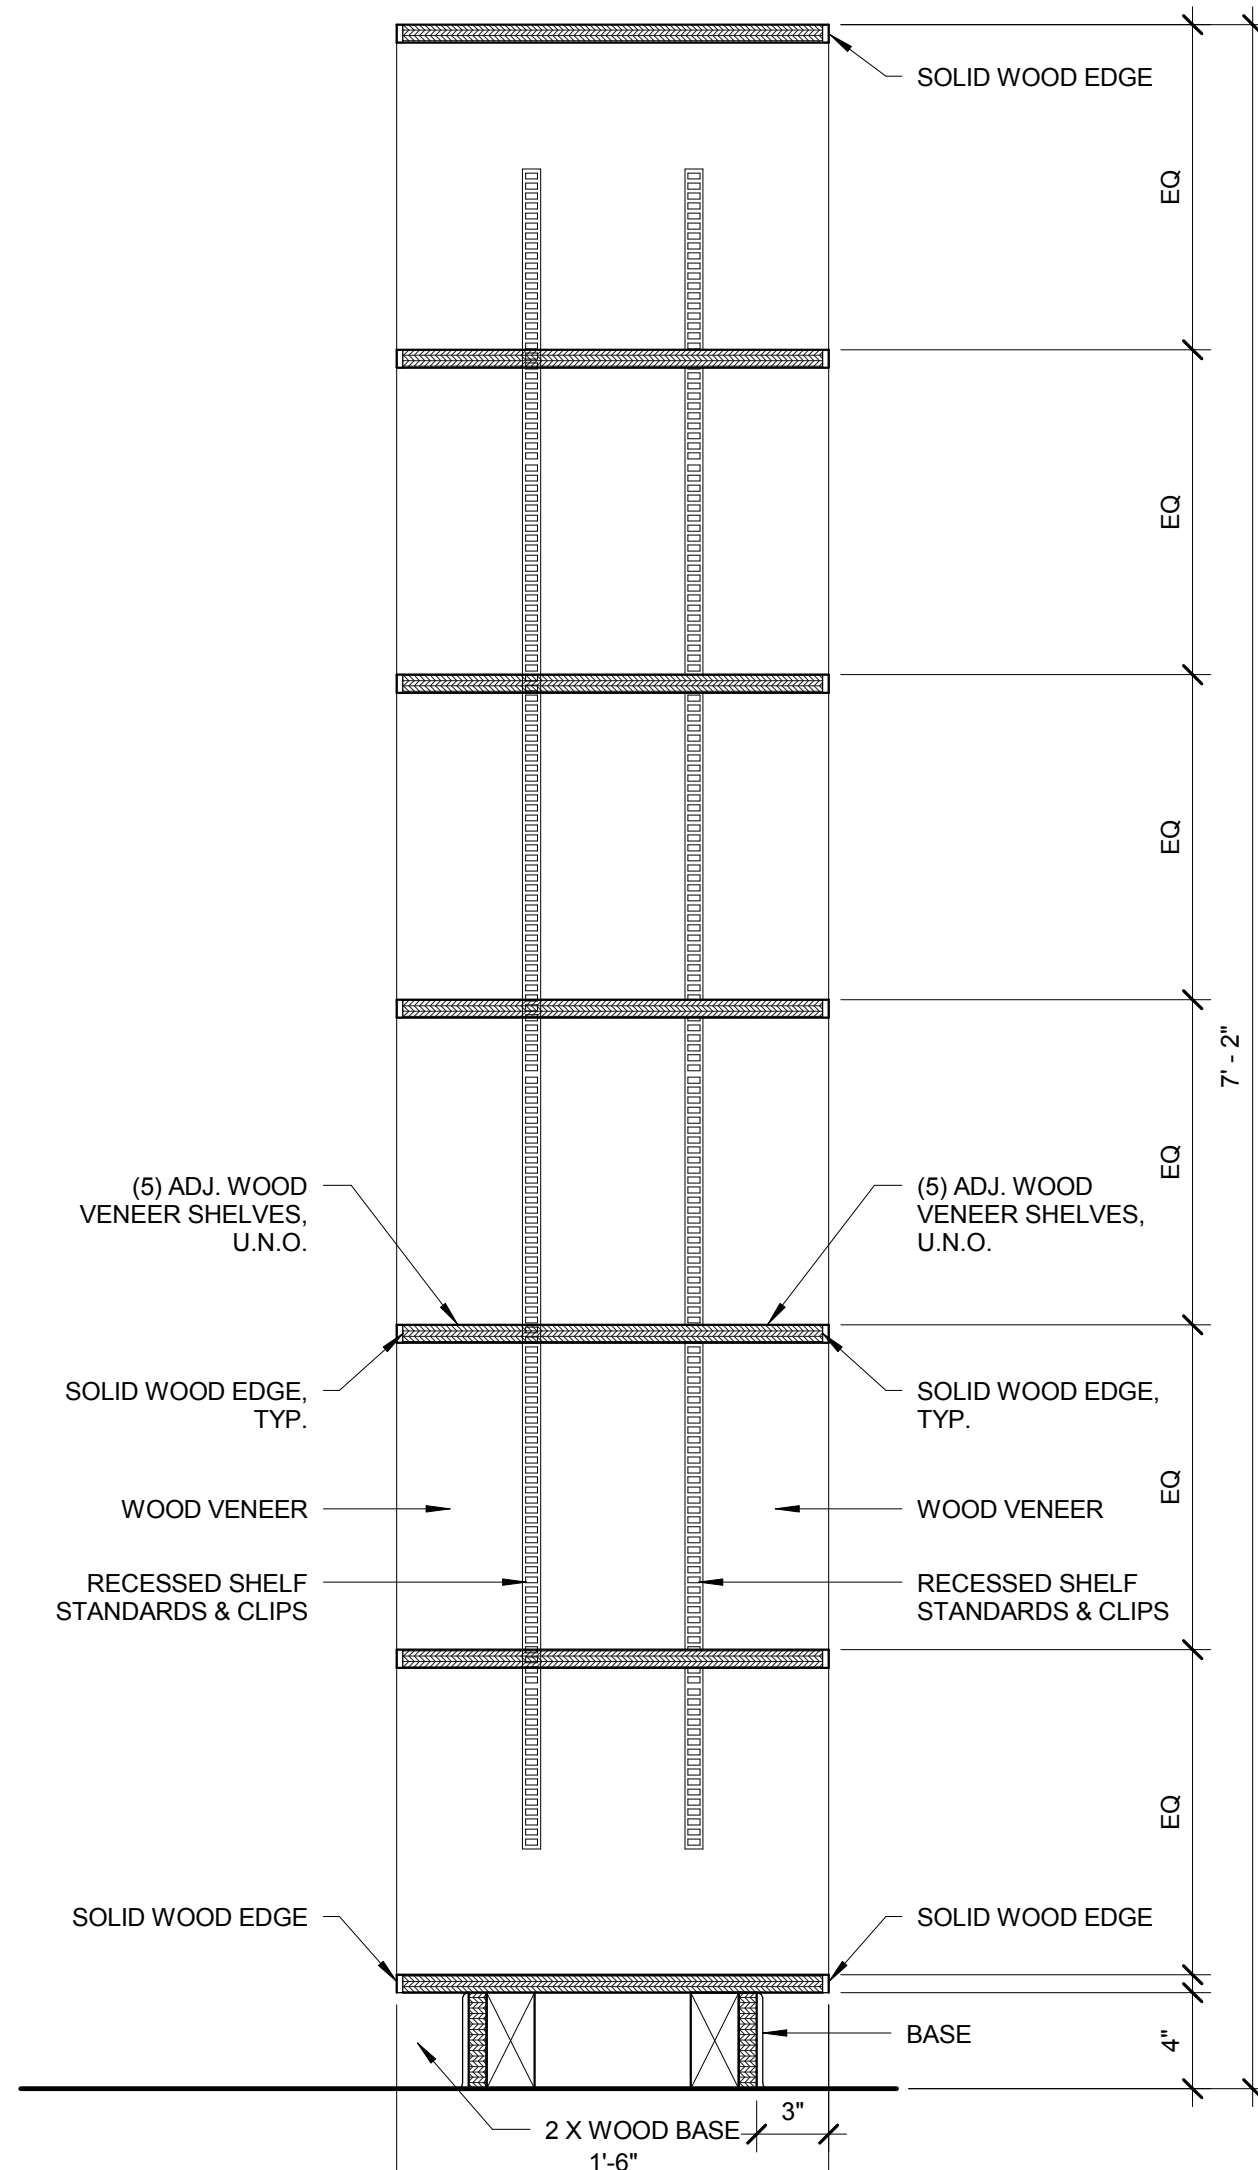

2 BONE DISPLAY SHELVING
1 1/2" = 1'-0"

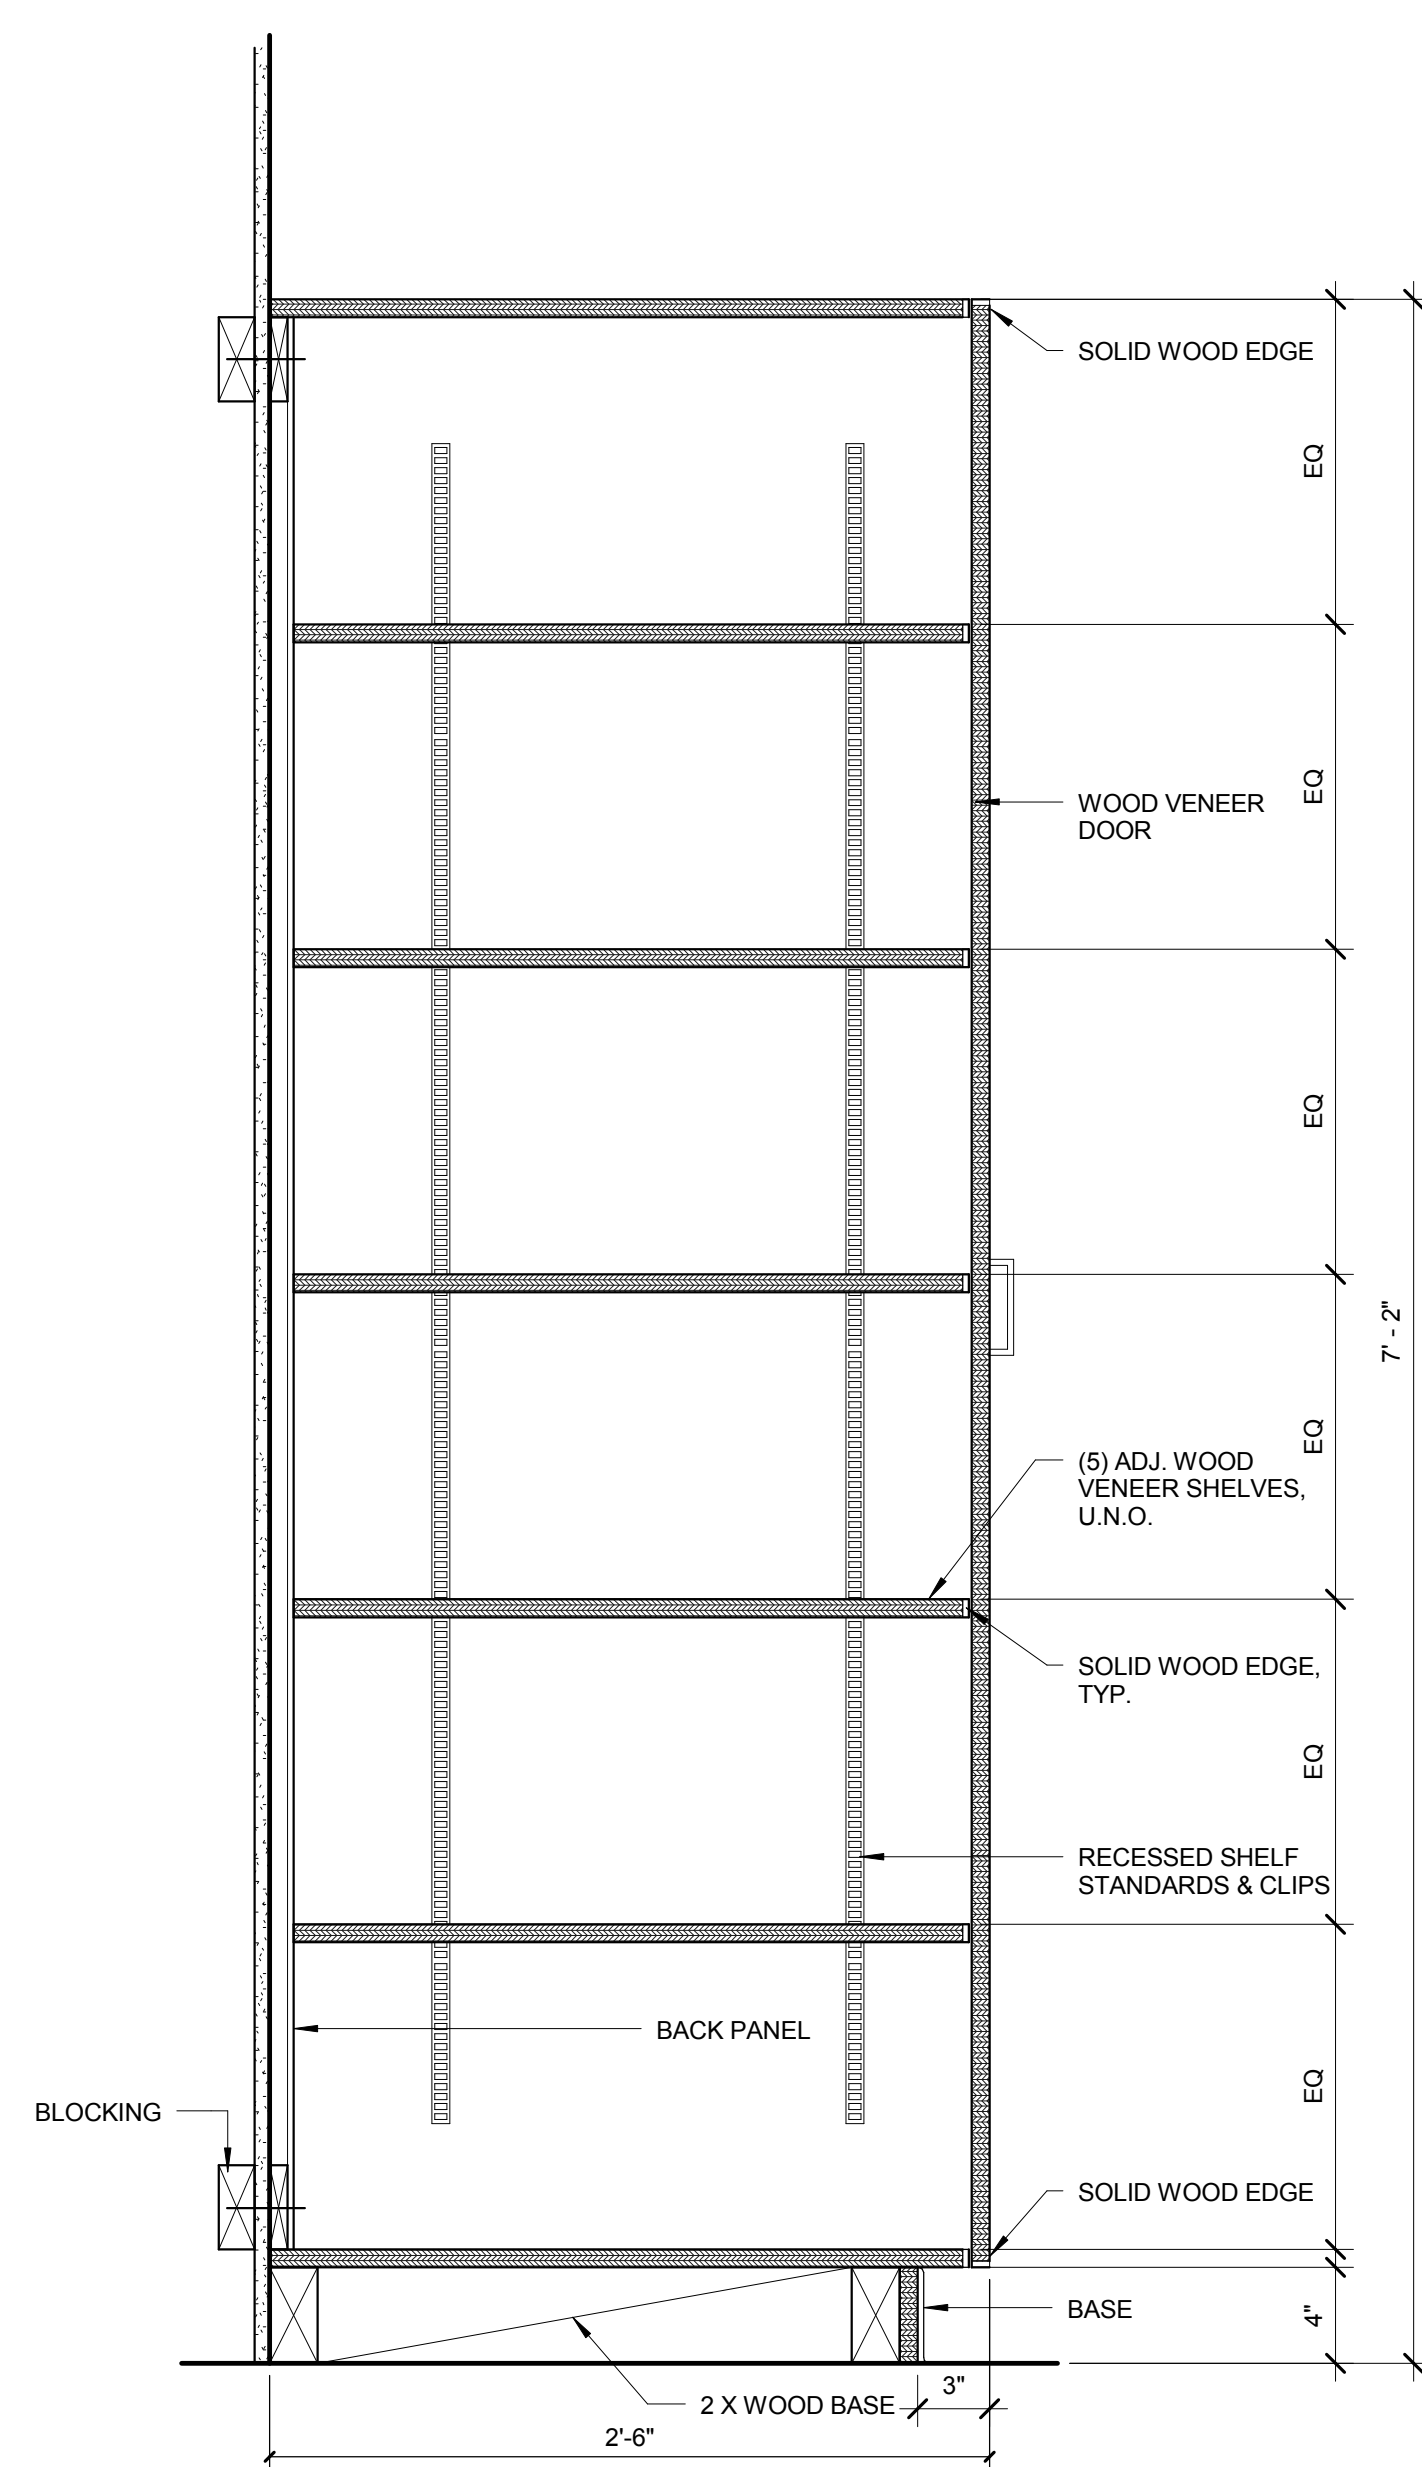

6 CASEWORK DETAIL - TALL CABINETS, FLUSH DOORS
1 1/2" = 1'-0"

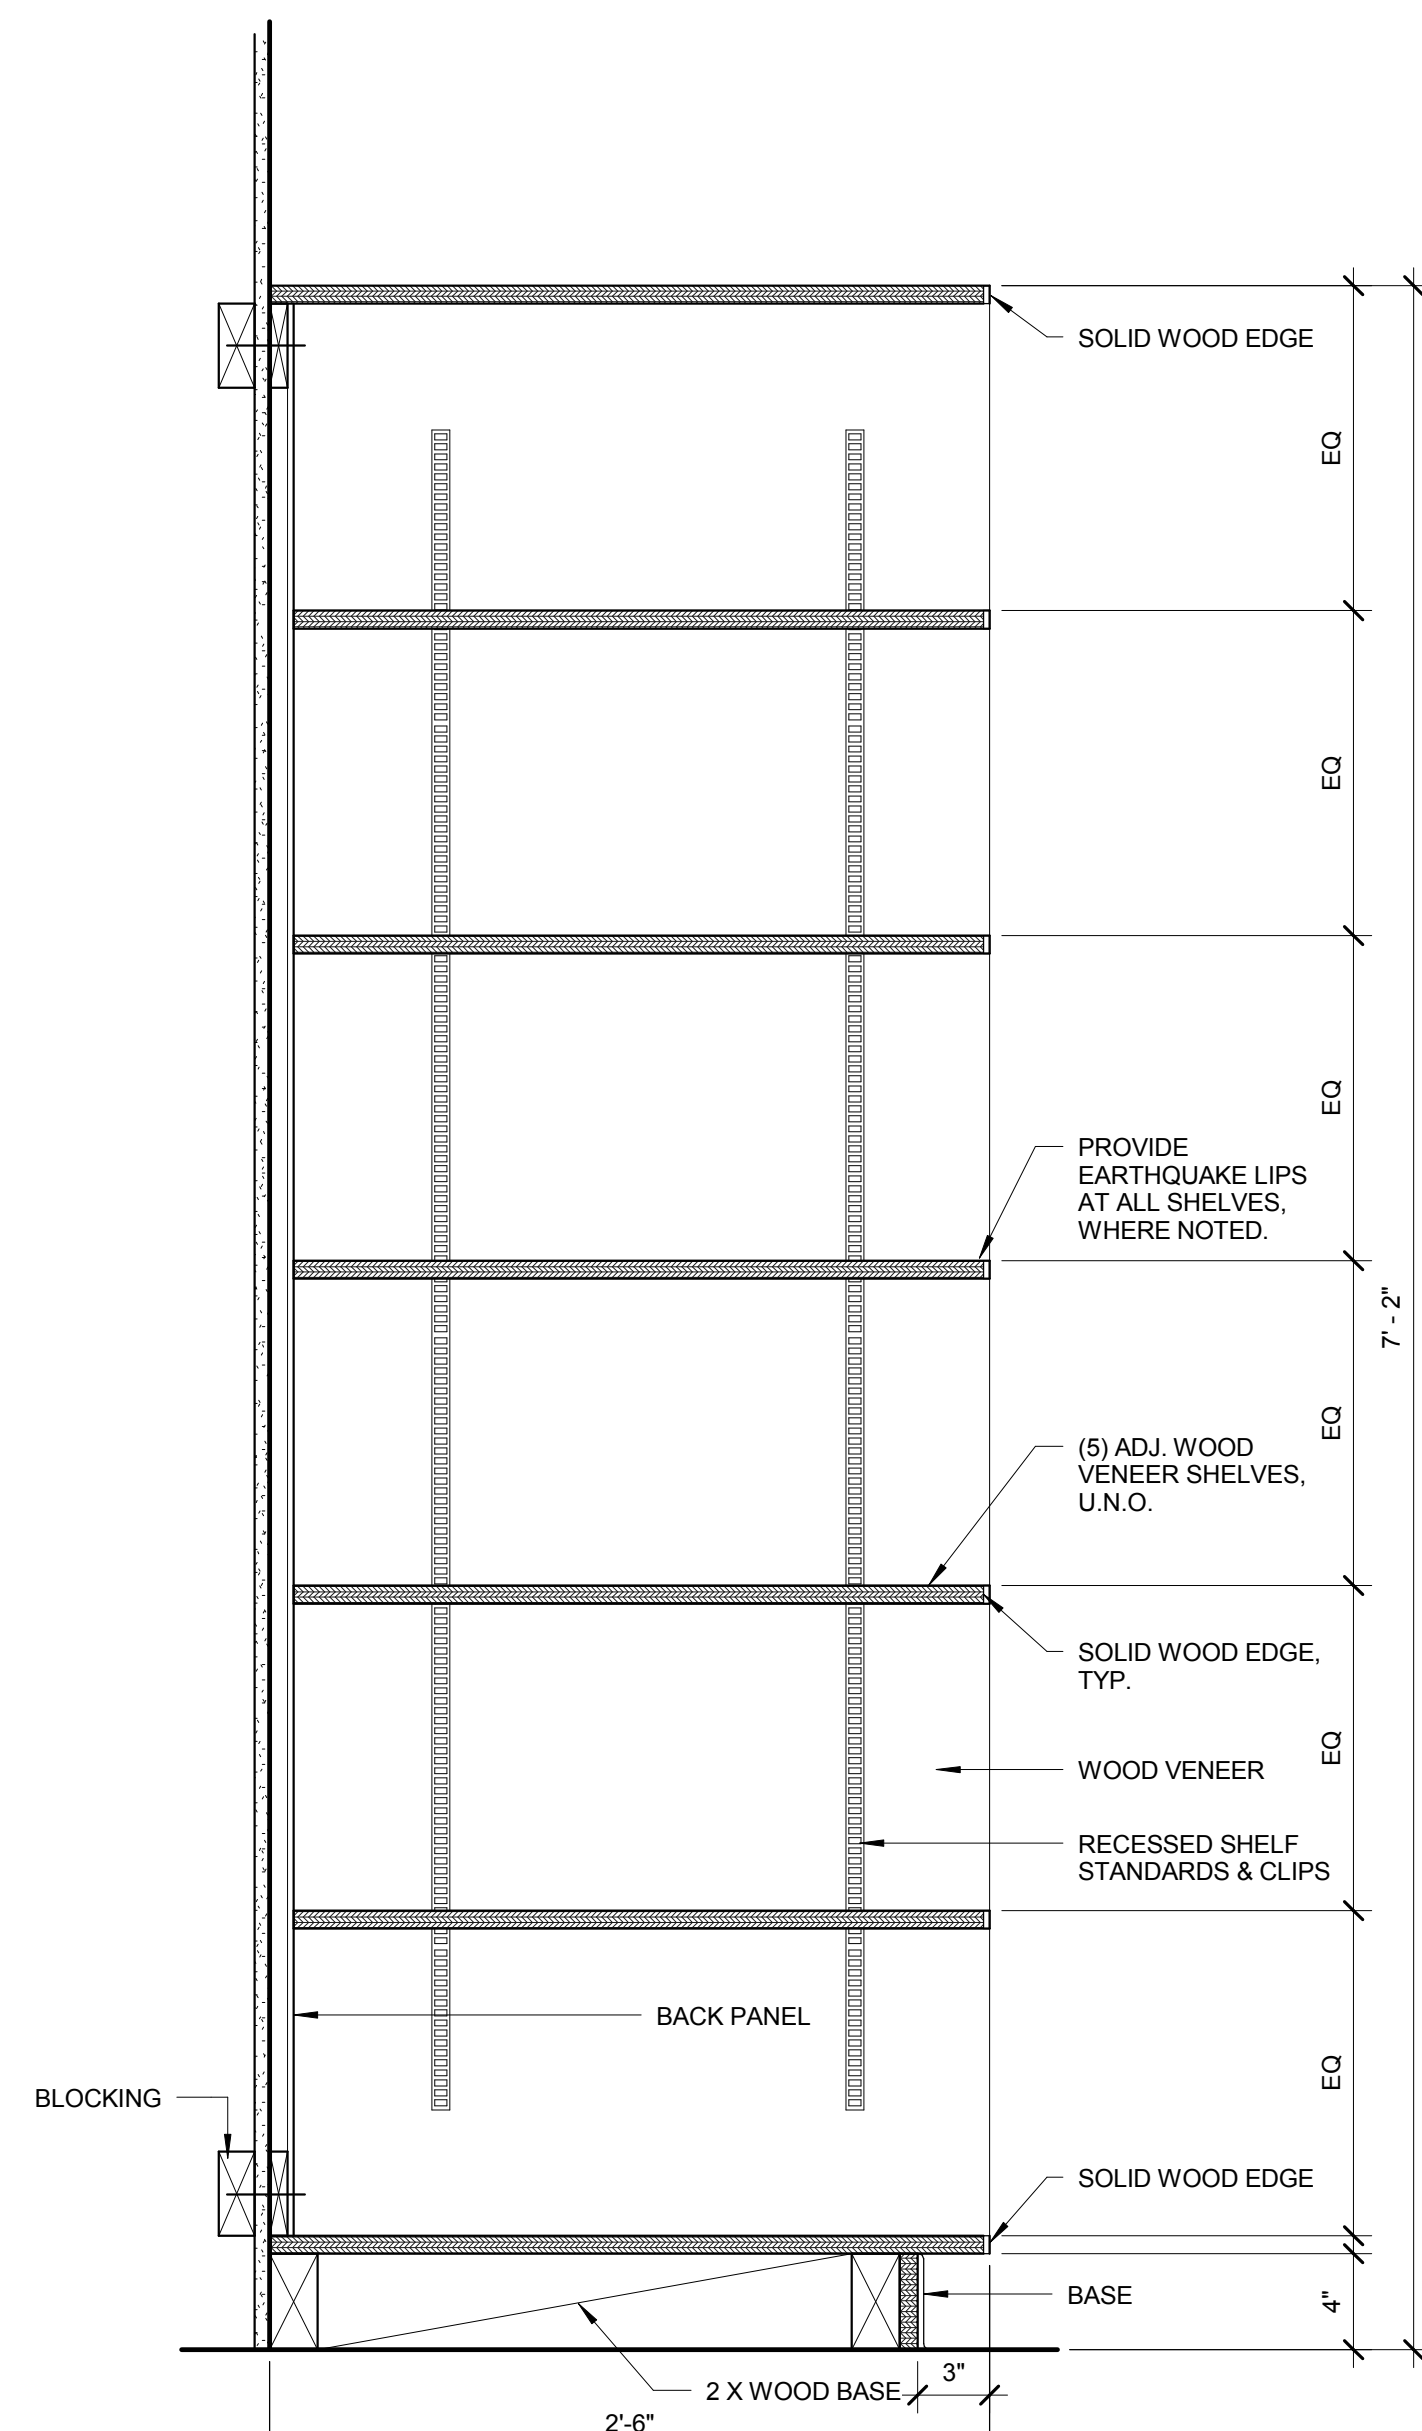

1 CASEWORK DETAIL - BOOKS / BAGS STORAGE
1 1/2" = 1'-0"