




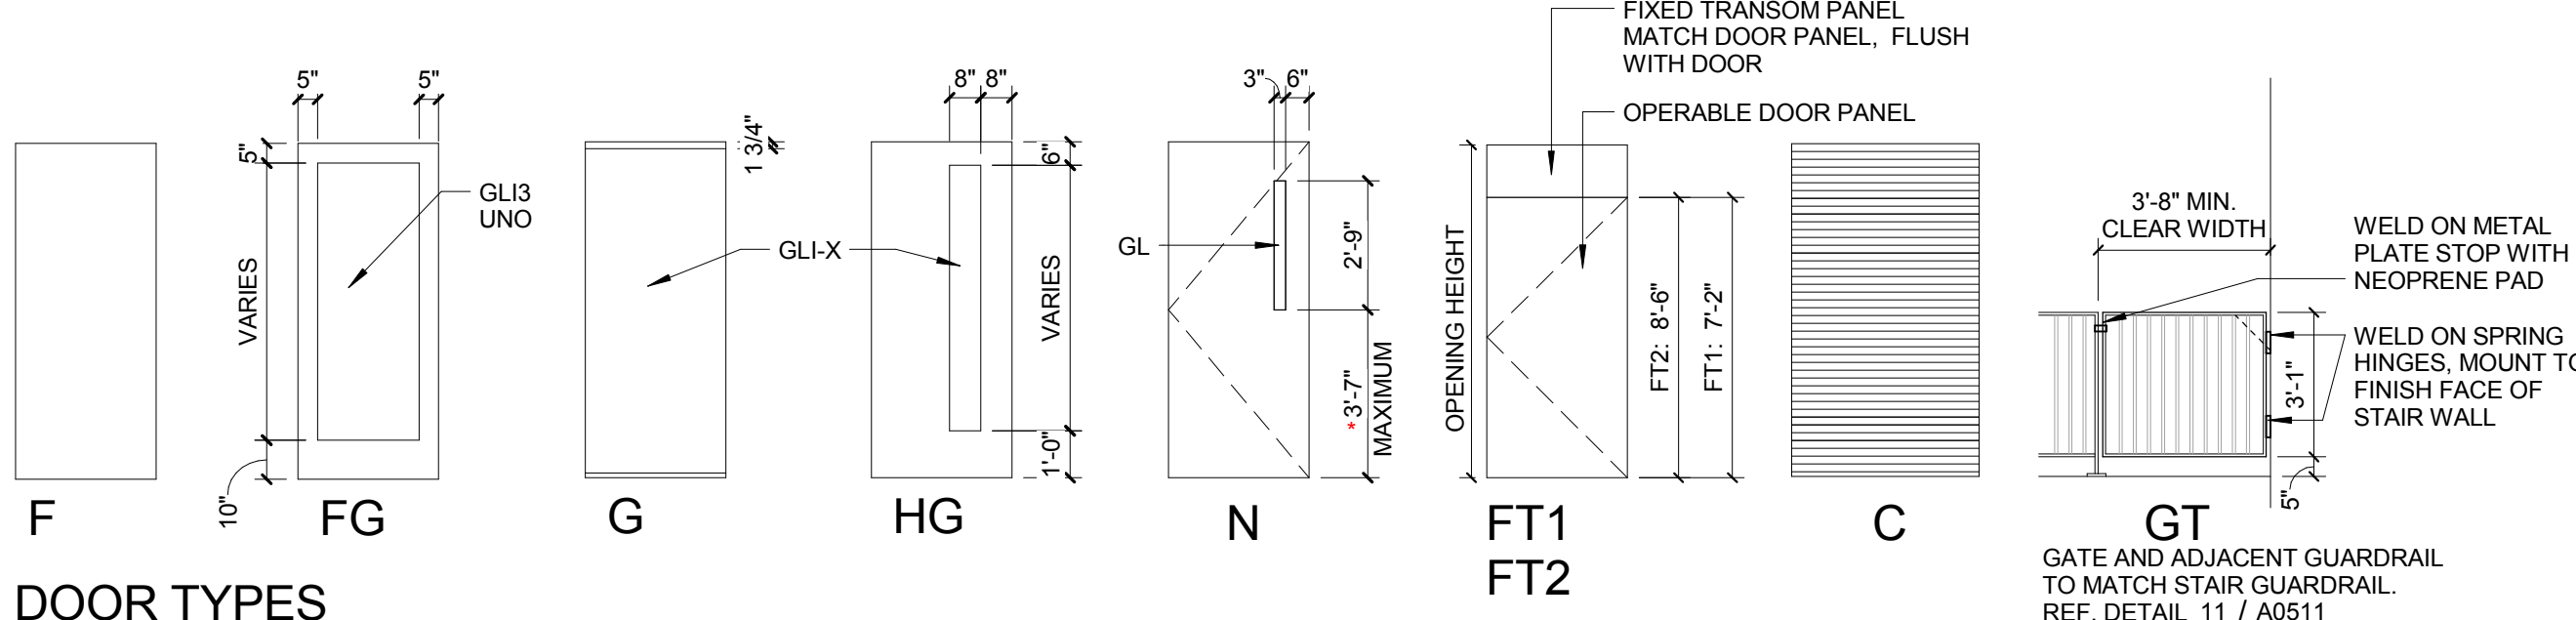

DOOR TYPES

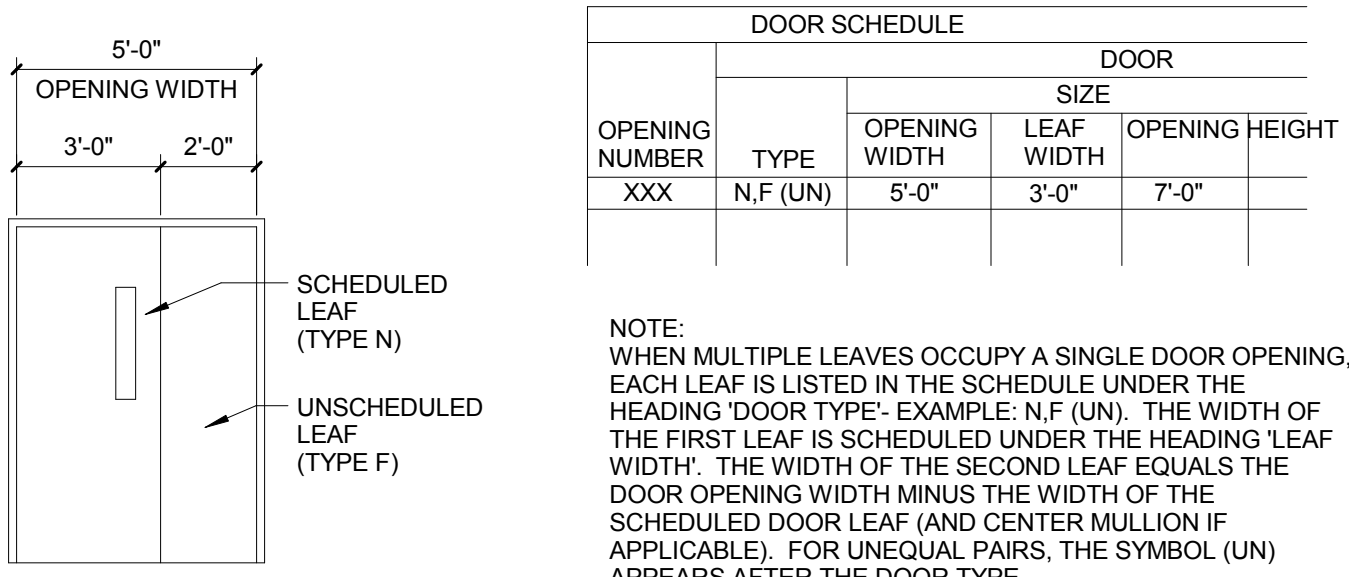

MULTIPLE LEAF KEY

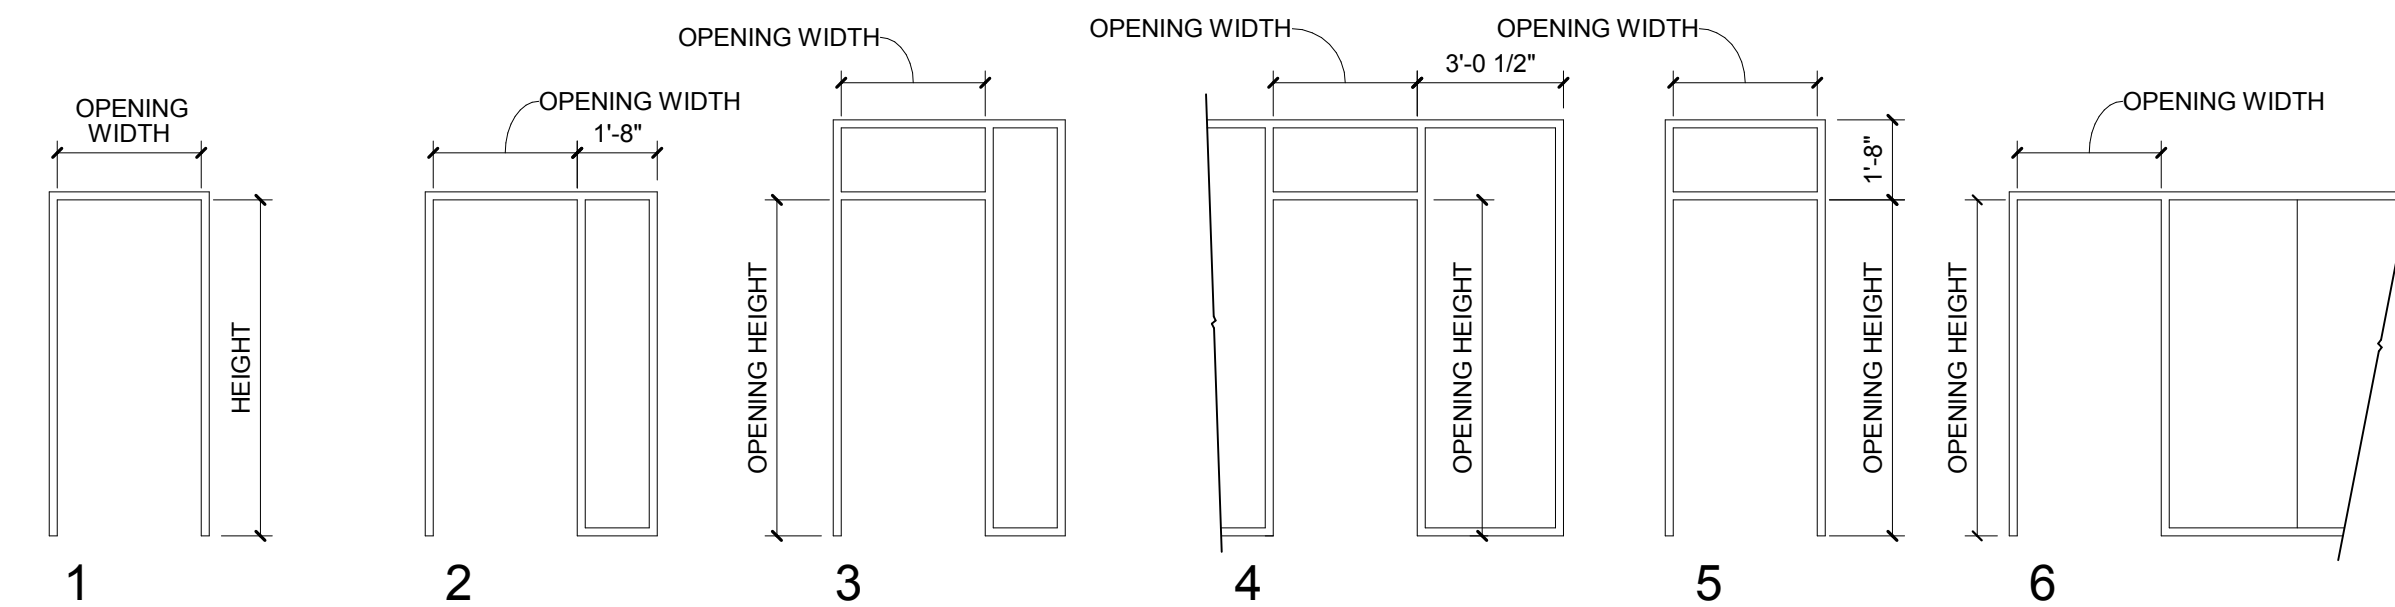

FRAME TYPES

ALUMINUM FRAME TYPE LEGEND

ALUMINUM FRAME TYPES: REFER TO SPECIFICATION SECTION 081216 FOR FULL DESCRIPTION AND SCHEDULE
 AL1: IGS-1 (INTERIOR ALUMINUM FRAMING) 3/4" X PARTITION WIDTH)
 AL2: IGS-2 (ALUMINUM STOREFRONT SYSTEM 1/34" X 1/2")
 AL3: IGS-3 (ALUMINUM STOREFRONT SYSTEM 2" X 1/2")
 AL4: IGS-4 (ALUMINUM STOREFRONT SYSTEM FOR 1/38" THICK GLASS GLI-8 2" X 4 1/2")
 AL6: IGS-6 (MATCH EGS-2 (EXTERIOR CURTAINWALL SYSTEM)

DOOR SCHEDULE														
	TYPE	DOOR			FRAME							FIRE RATING (MIN.)	HOLD SET	REMARKS
		OPENING WIDTH	LEAF WIDT H	OPENING HEIGHT	THK	MATL	GLASS	TYPE	MATL	HEAD	JAMB			
LEVEL 00														
S076	N	3'-0"		7'-0"	1 3/4"	HM	GLI-7	1	HM				45 MIN	
LEVEL 01 (542")														
100A	Pocket Door	4'-8"	7'-4"	1 3/4"	WD				WD	17	16		21	5
100B	F	3'-0"	7'-2"	1 3/4"	WD			1	HM	3	2		45 MIN	08A
101	F	3'-0"	7'-2 1/4"	1 3/4"	WD	6	AL1	3/A841	8, 7B			GLI-1	22	2
104	F	3'-0"	7'-2 1/4"	1 3/4"	WD	2	AL1	9	8			GLI-3	22	2
105	F	3'-0"	7'-2 1/4"	1 3/4"	WD	6	AL1	3/A841	8, 7B			GLI-1	22	2
106	F	3'-0"	7'-2 1/4"	1 3/4"	WD	2	AL1	9	8			GLI-3	22	2
107	F	3'-0"	7'-2 1/4"	1 3/4"	WD	6	AL1	3/A841	8, 7B			GLI-1	22	2
108	F	3'-0"	7'-2 1/4"	1 3/4"	WD	2	AL1	9	8			GLI-3	22	2
109	F	3'-0"	7'-2 1/4"	1 3/4"	WD	6	AL1	3/A841	8, 7B			GLI-1	22	2
110A	F	3'-0"	7'-2"	1 3/4"	WD	1	HM						45 MIN	08A
110B	F	3'-0"	7'-2"	1 3/4"	WD	1	HM						90 MIN	08A
110B.2	F	2'-0"	8'-0"	1 3/4"	WD									
111	F	3'-0"	7'-2 1/4"	1 3/4"	WD	6	AL1	3/A841	8, 7B			GLI-1	22	2
112	F	3'-0"	7'-2"	1 3/4"	WD	1	HM						08A	3
113	F	3'-0"	7'-2 1/4"	1 3/4"	WD	6	AL1	3/A841	8, 7B			GLI-1	22	2
114	F	3'-6"	7'-2"	1 3/4"	WD	1	AL1	4	3				18	3
115	F	3'-0"	7'-2 1/4"	1 3/4"	WD	6	AL1	3/A841	8, 7B			GLI-1	22	2
116	F	3'-6"	7'-2"	1 3/4"	WD	1	AL1	4					22	2
117	F	3'-0"	7'-2 1/4"	1 3/4"	WD	6	AL1	3/A841	8, 7B			GLI-1	22	2
131	FG	3'-6"	7'-2"	1 3/4"	AL/GL	GLI-3		AL2	15	14, 19			18	2
133A	FG	3'-0"	7'-2"	1 3/4"	WD	1	HM	3	2				14A	2, 9
133B	F	3'-6"	7'-2"	1 3/4"	WD		HM						13	2, 9
133B.2	F	3'-0"	7'-2"	1 3/4"	HM	1	HM						08A	3
133B.3	F	3'-0"	7'-2"	1 3/4"	HM	1	HM						08A	3
135.1	FG	3'-6"	7'-2"	1 3/4"	AL/GL	4	AL2	15	14, 19			GLI-1	14A	2, 9, 13
135.2	F	3'-0"	7'-2"	1 3/4"	WD	1	HM	3	2				18	3
137	FG	3'-0"	7'-2"	1 3/4"	AL/GL	GLI-3	1	AL2	19	SIM			13A	3
137A	F	3'-6"	7'-2"	1 3/4"	HM	1	HM						08A	3
140.1	F	3'-0"	8'-10 1/4"	1 3/4"	AL/GL	AL3	15	SIM	14, 19				18A	3
140.2	F	3'-0 1/4"	8'-10 1/4"	1 3/4"	WD	6	SIM	AL3	15	14		GLI-4	18A	3
144	F	3'-0"	8'-10 1/4"	1 3/4"	WD	6	AL1	9	8, 7B			GLI-1	22	2, 10
150	FG, FG	6'-0"	3'-0"	7'-2"	1 3/4"	WD	1	HM	3	2			20B	4, 9
151	F	3'-0"	7'-2"	1 3/4"	WD	1	HM	3	2				05	4
154	HG	3'-0"	7'-0"	1 3/4"	WD	6	SIM	AL1	11/A0842	8, 7B		GLI-1	19	2
156.1	HG	3'-0"	7'-0"	1 3/4"	WD	6	SIM	AL1	11/A0842	8, 7B		GLI-1	19	2
156.2	F	3'-0"	7'-2"	1 3/4"	WD	1	HM	3	2				19A	3
160.1	F.F	6'-0"	3'-0"	8'-10 1/4"	1 3/4"	WD	1	HM					24	3
160.2	N.N	6'-0"	3'-0"	8'-10 1/4"	1 3/4"	WD/GL	1	HM					25	3
160A	F	3'-0"	7'-10"	1 3/4"	WD	1	HM	3	2				19	3
160B	F	3'-0"	7'-2"	1 3/4"	WD	1	HM	3	2				22A	3, 17
160D	F	3'-0"	7'-10"	1 3/4"	WD	1	HM	3	2				09	3
172.1	F.F	6'-0"	3'-0"	7'-2"	1 3/4"	HM	1	HM	5	SIM	5	SIM	4	11
172A	F	3'-6"	7'-2"	1 3/4"	HM	1	HM	5	SIM	4			11	1
174	FG	3'-6"	7'-2"	1 3/4"	AL/GL	GLI-3	6	SIM	AL3	15	14, 19	GLI-4	18	3
175	F	3'-0"	7'-2"	1 3/4"	WD	1	HM						08	3
176	F	3'-0"	7'-2"	1 3/4"	WD	1	HM						08B	3
177	F	3'-0"	7'-2"	1 3/4"	WD	1	HM						08	3
178.1	F.F	6'-0"	3'-0"	7'-2"	1 3/4"	HM	1	HM	3	2			12A	3
179	F	3'-0"	7'-2"	1 3/4"	WD	1	HM						11	1
180	F	3'-0"	7'-2"	1 3/4"	WD	1	HM	3	2				10	1
182	F	3'-0"	7'-2"	1 3/4"	WD	1	HM	3	2				10	1
183A	HG	3'-6"	7'-2"	1 3/4"	WD	1	HM	3	2				13A	9
183B.1	F.F	6'-0"	3'-0"	7'-2"	1 3/4"	HM	1	HM	3	2			15	1, 9
183B.2	FG, FG	6'-0"	3'-0"	7'-2"	1 3/4"	HM	1	HM	3	2			16	1
183C	HG	3'-6"	7'-2"	1 3/4"	HM	1	HM	3	2				16	1
184	F	3'-0"	7'-2"	1 3/4"	WD	1	HM	3	2				06	3
185	F	3'-0"	7'-2"	1 3/4"	HM	1	HM	3	2				06	3
186	F	3'-6"	7'-2"	1 3/4"	HM	1	HM	3	2				06	3
187	F	3'-0"	7'-2"	1 3/4"	HM	1	HM	3	2				06	3
192.1	F	3'-0"	7'-2"	1 3/4"	HM	1	HM	3	2				45 MIN	07
195	F	3'-0"	7'-2"	1 3/4"	HM	1	HM	3	2				06	3
196	F	3'-0"	7'-2"	1 3/4"	HM	1	HM	3	2				08	3
C153	FG, FG	6'-0"	3'-0"	8'-10 1/4"	1 3/4"	AL/GL	GLI-3	AL3	15	SIM	14, 19	GLI-1	20A	2, 9
C170	F.F	7'-0"	3'-6"	8'-8"	1 3/4"	WD	1	HM	3				45 MIN	20C
S140	SIDE COILING	8'-8"	9'-0"										90 MIN	16
S176.2	F	3'-0"	7'-2"	1 3/4"	HM	1	HM	5	SIM	5	14		90 MIN	01
S194	N	3'-0"	7'-2"	1 3/4"	WD	GLI-7	1	HM	3	2			90 MIN	05
LEVEL 02 (556")														
200A	Pocket Door	5'-2"	7'-4"	1 3/4"	WD				AL	17	16		21	5
200B	F	3'-0"	7'-2"	1 3/4"	WD	1	HM	3	2				45 MIN	01
202	FT	3'-0"	9'-4"	1 3/4"	WD	1	AL3						10	3
203	F	3'-0"	7'-2 1/4"	1 3/4"	WD	6	AL1	3/A841	8, 7B			GLI-1	19	2
205	F	3'-0"	7'-2 1/4"	1 3/4"	WD	6	AL1	3/A841	8, 7B			GLI-1	22	2
206	F	3'-0"	7'-2 1/4"	1 3/4"	WD	2	AL1	9	8			GLI-3	22	2
207	F	3'-0"	7'-2 1/4"	1 3/4"	WD	6	AL1	3/A841	8, 7B			GLI-1	22	2
208	F	3'-0"	7'-2 1/4"	1 3/4"	WD	2	AL1	9	8			GLI-3	22	2
209	F	3'-0"	7'-2 1/4"	1 3/4"	WD	6	AL1	3/A841	8, 7B			GLI-1	22	2
210A	F	3'-0"	7'-2"	1 3/4"	WD	1	HM	3	2				09	3
210B	F	3'-0"	7'-2"	1 3/4"	WD	1	HM	3	2				01A	3
210B.2	F	2'-0"	8'-0"	1 3/4"	HM	1	HM	3	2				90 MIN	01A
211	F	3'-0"	7'-2 1/4"	1 3/4"	WD	6	AL1	3/A841	8, 7B			GLI-1	22	2
212	F	3'-0"	7'-2 1/4"	1 3/4"	WD	2	AL1	9	8				22	2
214	F	3'-0"	7'-2 1/4"	1 3/4"	WD	2	AL1	9	8			GLI-3	22	2
215	F	3'-0 7/8"	7'-2 1/4"	1 3/4"	WD	6	SIM	AL1	3/A841	8, 7B			23	2
231	FG	3'-0"	7'-2"	1 3/4"	AL/GL	GLI-11			AL4				GLI-8	13B
233	FG	3'-0"	7'-2"	1 3/4"	AL/GL	GLI-11			AL4				GLI-8	19B
235	FG	3'-6"	7'-2"	1 3/4"	AL/GL	GLI-3			AL4				GLI-14	13A
272	F	3'-6"	7'-2"	1 3/4"	HM	1	HM	3	2				45 MIN	01
272B	F	3'-6"	7'-2"	1 3/4"	HM	1	HM	3	2				08	3
274	F	3'-6"	7'-2"	1 3/4"	HM	1	HM	3	2				13C	8, 20
275	F	3'-0"	7'-2"	1 3/4"	WD	1	HM	3	2				10	1
276.1	FG	3'-6"	7'-2"	1 3/4"	AL/GL	GLI-3	4	AL2	15	14		GLI-1	14	2
276.2	FG	3'-6"	7'-2"	1 3/4"	AL/GL	GLI-3	4	AL2	15	14		GLI-1	26	2, 9
277	F	3'-0"	7'-2"	1 3/4"	WD	1	HM	3	2				11	14
279	F	3'-0"	7'-2"	1 3/4"	WD	1	HM	3	2				11	14
282.1	FG	3'-6"	7'-2"	1 3/4"	AL/GL	GLI-3	4	AL2	15	14		GLI-1	08A	3
282.2	FG	3'-6"	7'-2"	1 3/4"	WD/GL	GLI-3	1	HM	3	2			18	3
282.3	FG	3'-6"	7'-2"	1 3/4"	WD/GL	GLI-3	1	HM	3	2			18	3
283.1	FG	3'-6"	7'-2"	1 3/4"	AL/GL	GLI-3	4	AL2	15	14		GLI-1	14	2
283.2	FG	3'-6"	7'-2"	1 3/4"	AL/GL	GLI-3	4	AL2	15	14		GLI-1	26	2, 9
284.1	FG	3'-6"	7'-2"	1 3/4"	AL/GL	GLI-3	4	AL2	15	14		GLI-1	31	2, 9
284.2	FG	3'-6"	7'-2"	1 3/4"	AL/GL	GLI-3	4	AL2	15	14		GLI-1	31	2, 9
288A.1	FG	3'-6"	7'-2"	1 3/4"	WD/GL	GLI-3	1	HM	3	2			18	3
288A.2	FG	3'-6"	7'-2"	1 3/4"	WD/GL	GLI-3	1	HM	3	2			18	3
288B.1	FG	3'-6"	7'-2"	1 3/4"	WD/GL	GLI-3	1	HM	3	2			18	3
288B.2	FG	3'-0"	7'-2"	1 3/4"	WD/GL	GLI-3	1	HM	3	2			18	3
291.1	FG	3'-6"	7'-2"	1 3/4"	AL/GL	GLI-3	4	AL2	15	14		GLI-1	14	2
291.2	FG													