




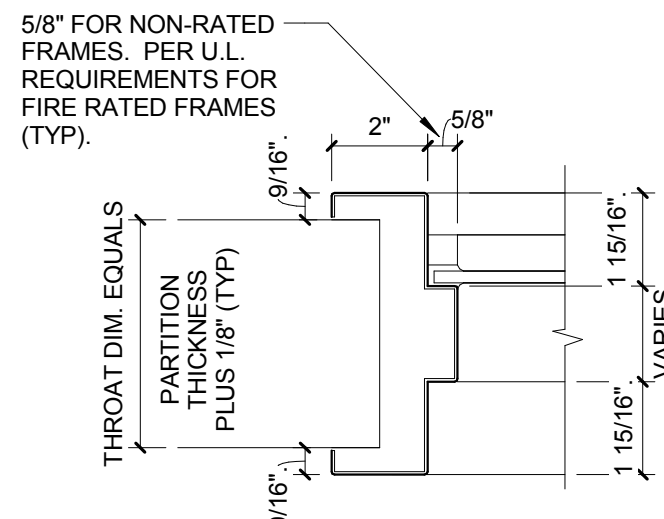


30 HM PROFILE-GLAZING
3" = 1'-0"

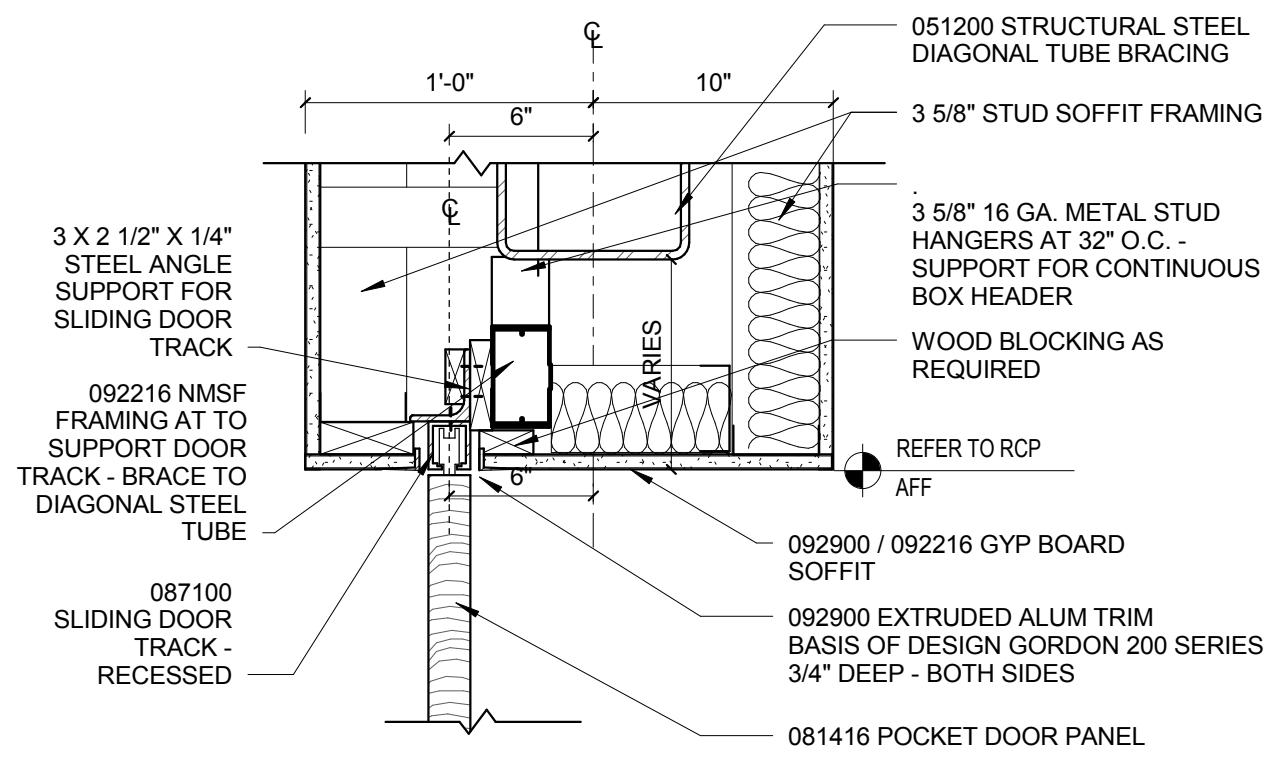


17 POCKET SLIDING DOOR HEAD
1 1/2" = 1'-0"

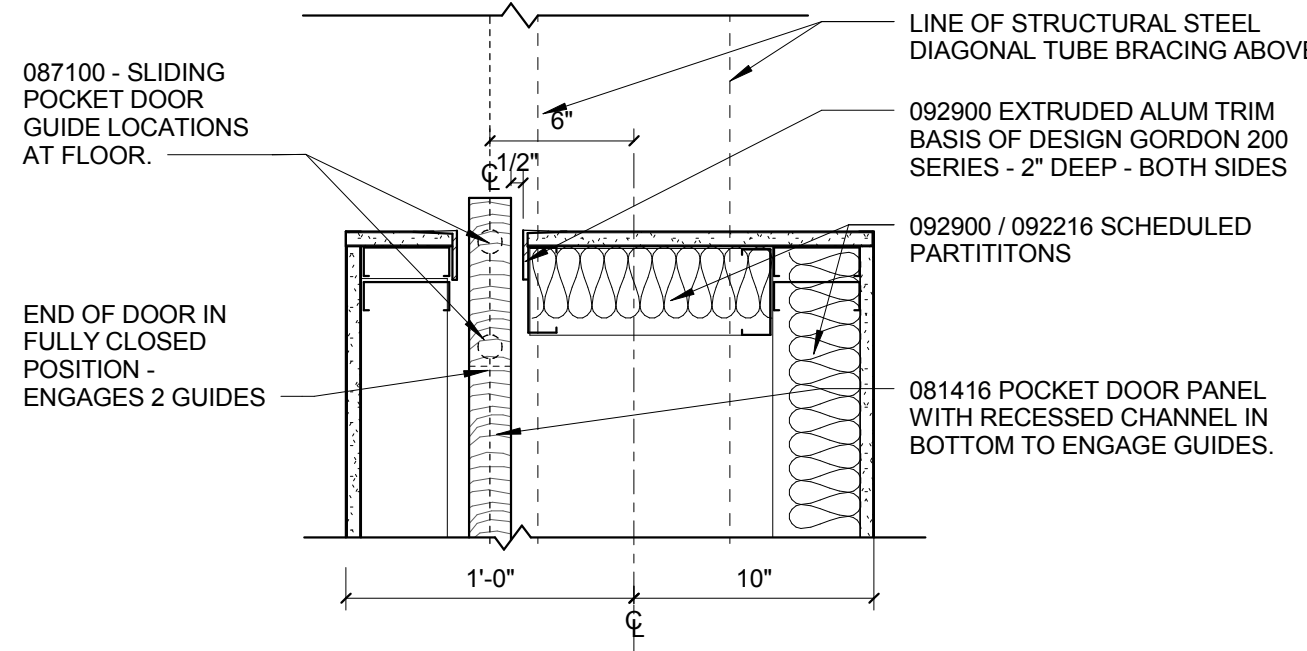


16 POCKET SLIDING DOOR JAMB
1 1/2" = 1'-0"

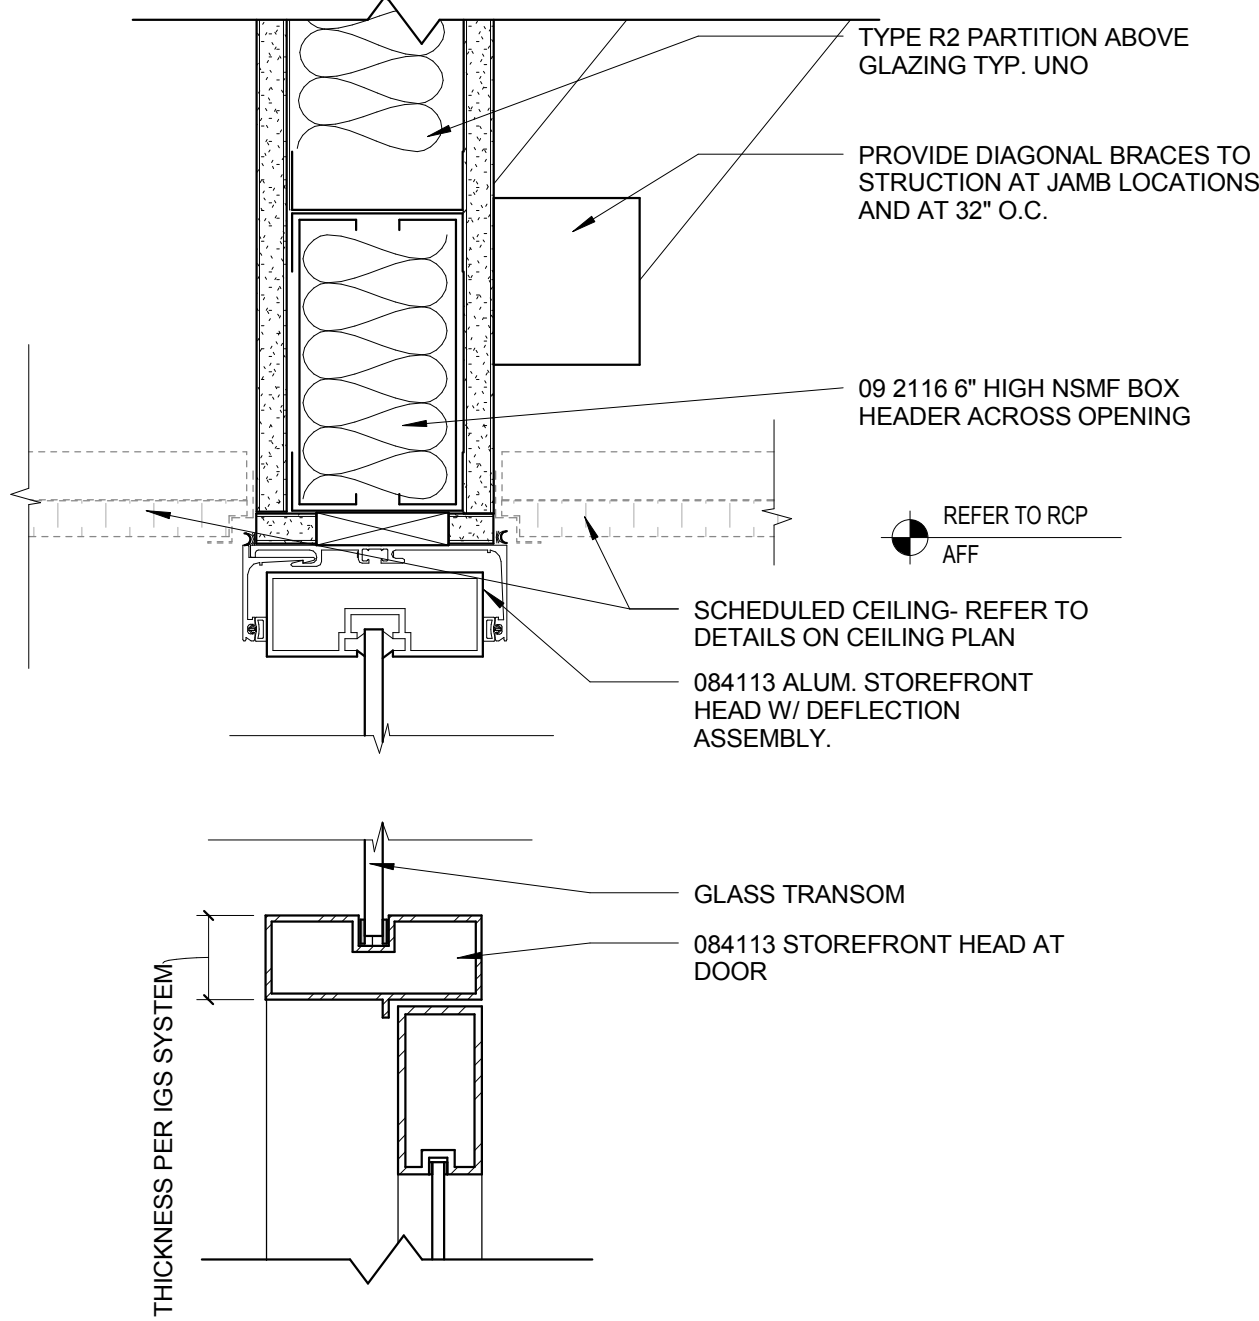


15 STOREFRONT DOOR HEAD AT TRANSOM
3" = 1'-0"

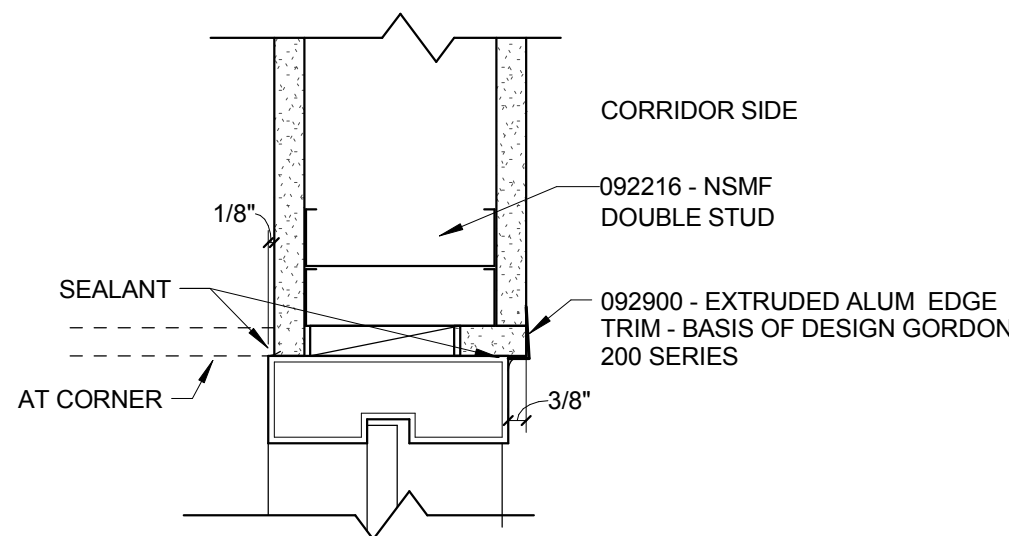


19 TYP IGS 2 OR 3 PLAN DETAIL
3" = 1'-0"

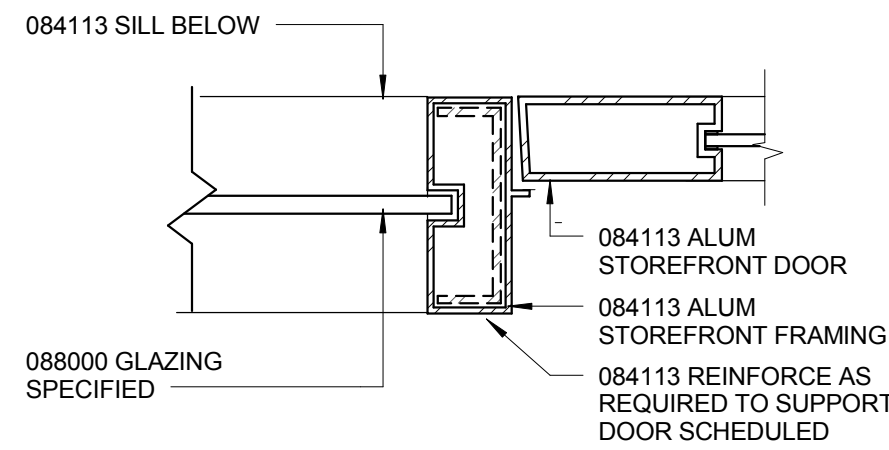

14 ALUM STOREFRONT JAMB
3" = 1'-0"

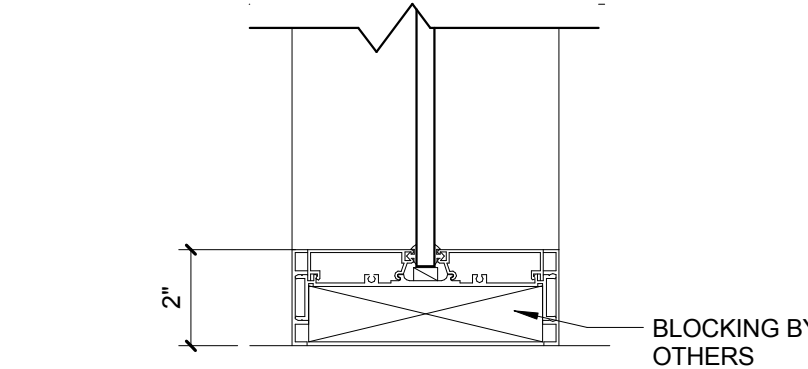


11 ALUM PROFILE
3" = 1'-0"

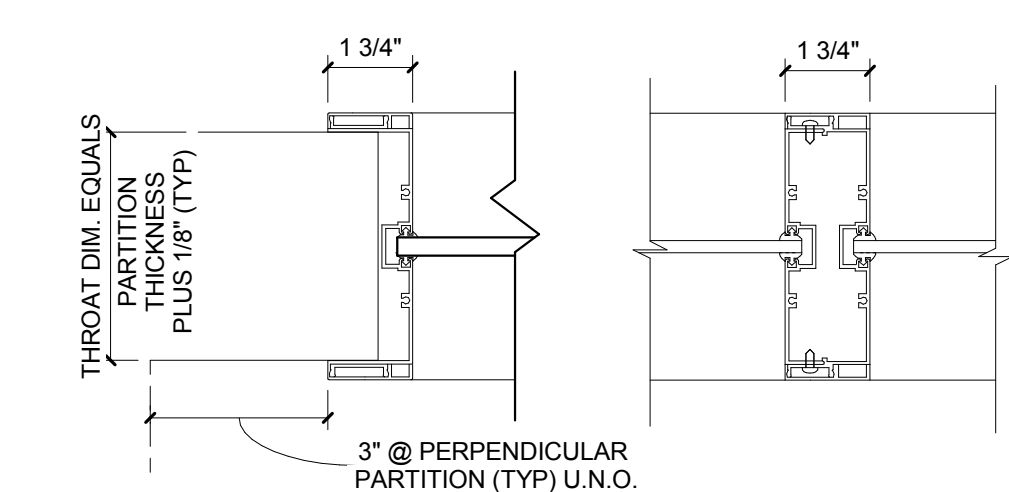


10B ALUM PROFILE
3" = 1'-0"


10A ALUM PROFILE
3" = 1'-0"

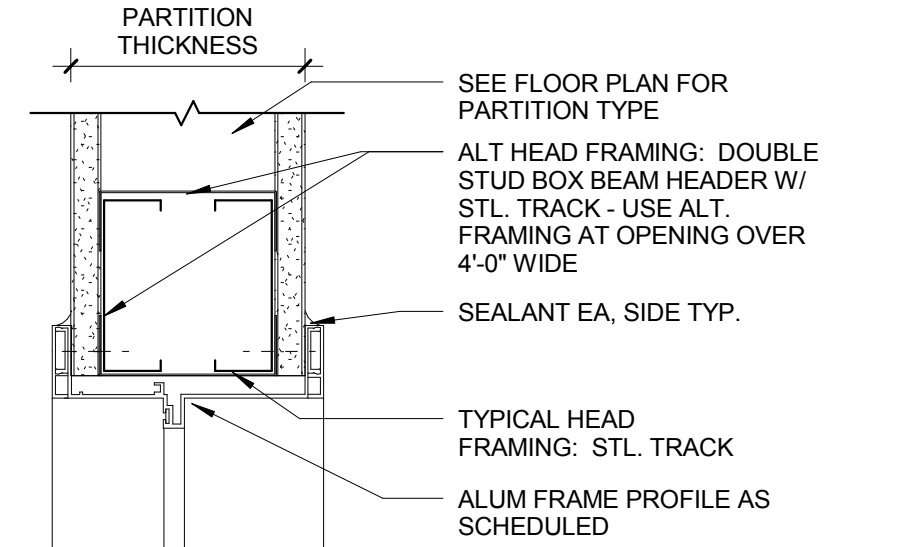

9 ALUM AL1 @ GYP HEAD DETAIL
3" = 1'-0"

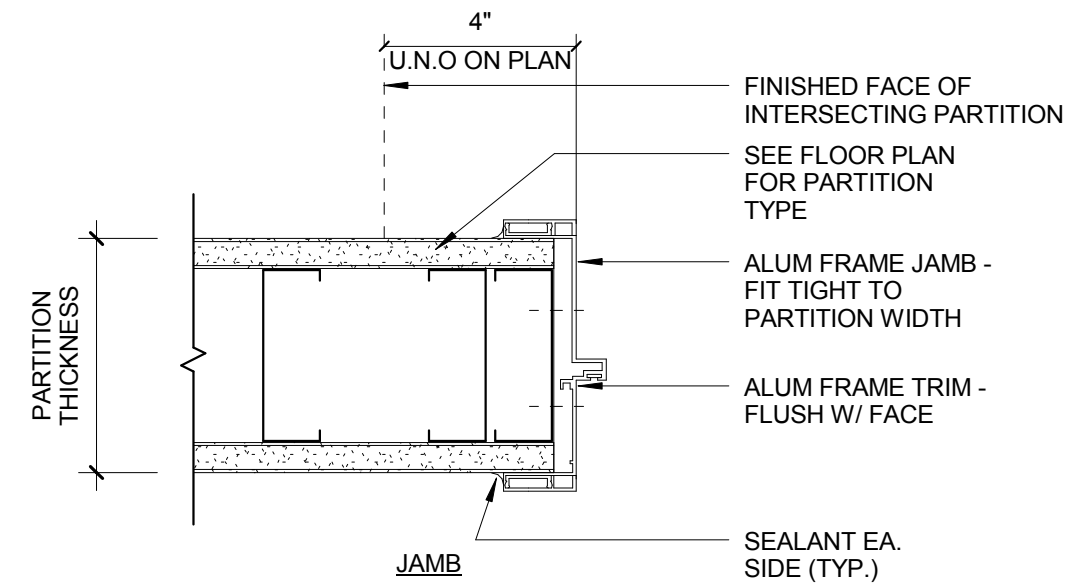


8 ALUM AL1 @ GYP JAMB DETAILS
3" = 1'-0"

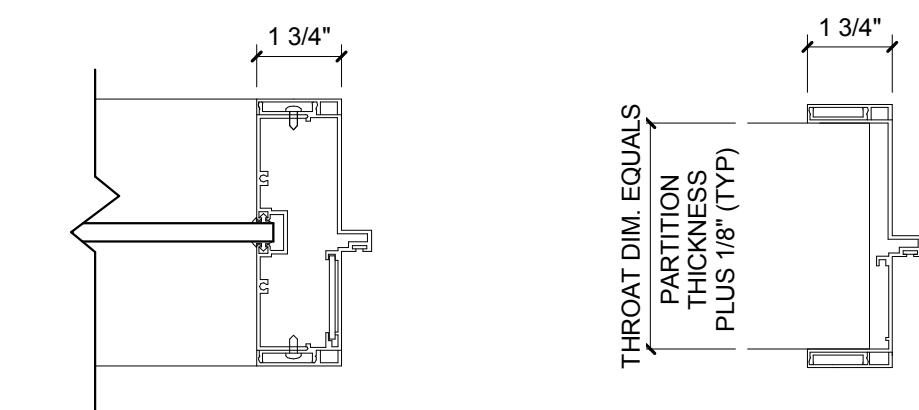


7B ALUM PROFILE
3" = 1'-0"


7A ALUM PROFILE
3" = 1'-0"

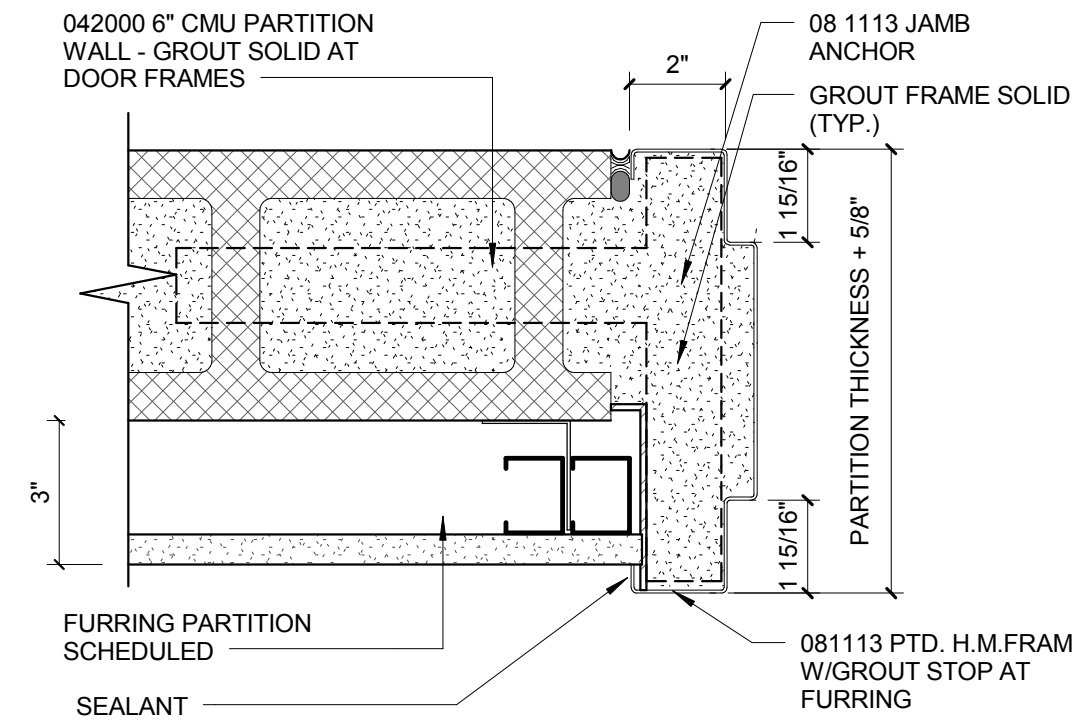


6 H.M. FRAME DETAILS-CMU W/FURRING
3" = 1'-0"

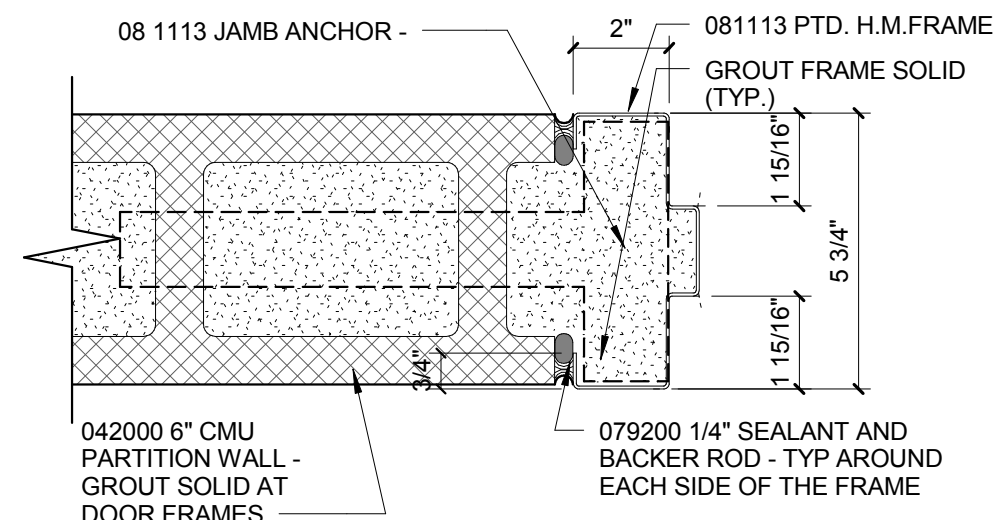


5 H.M. FRAME DETAIL - CMU JAMB
3" = 1'-0"

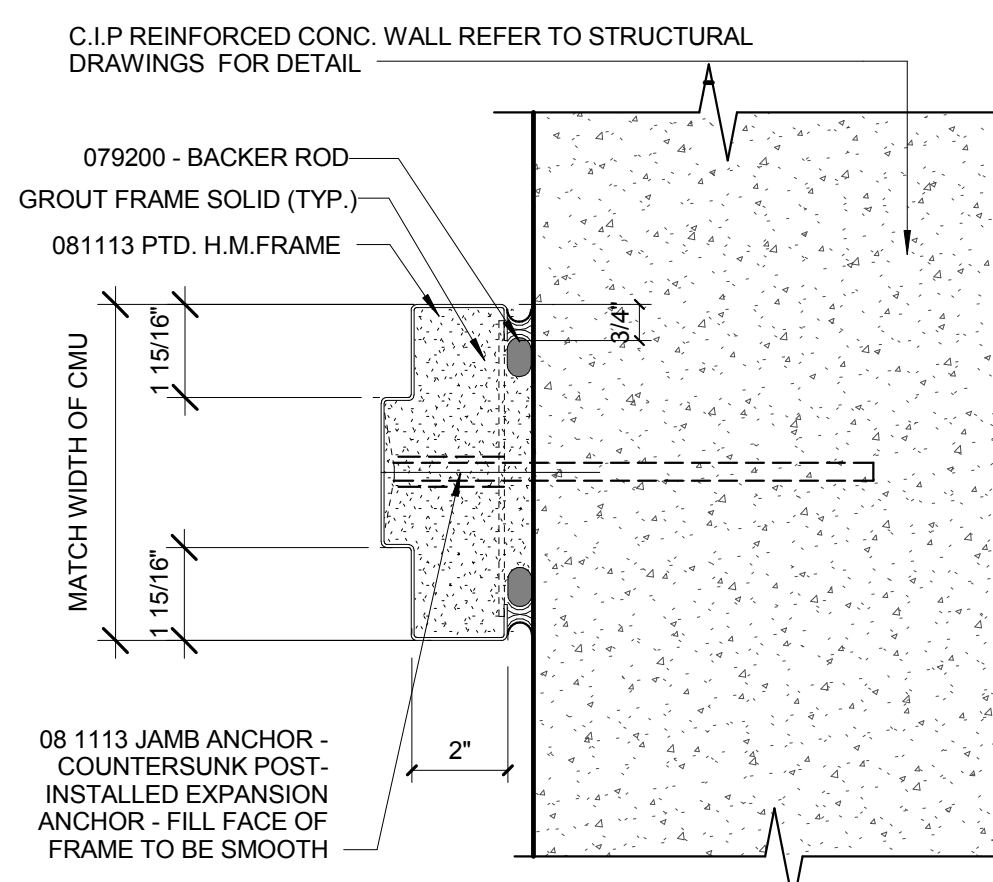


4 H.M. FRAME DETAILS-CONC
3" = 1'-0"

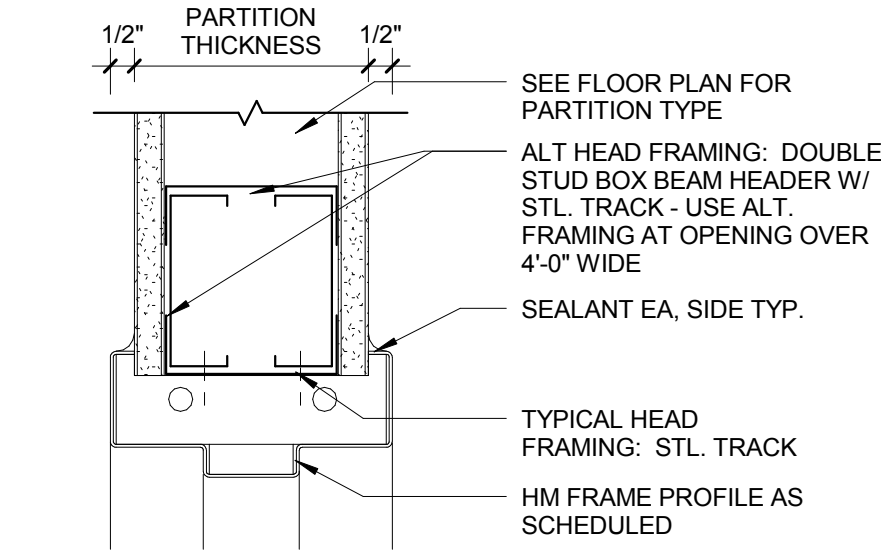

3 HM @ GYP HEAD DETAIL
3" = 1'-0"

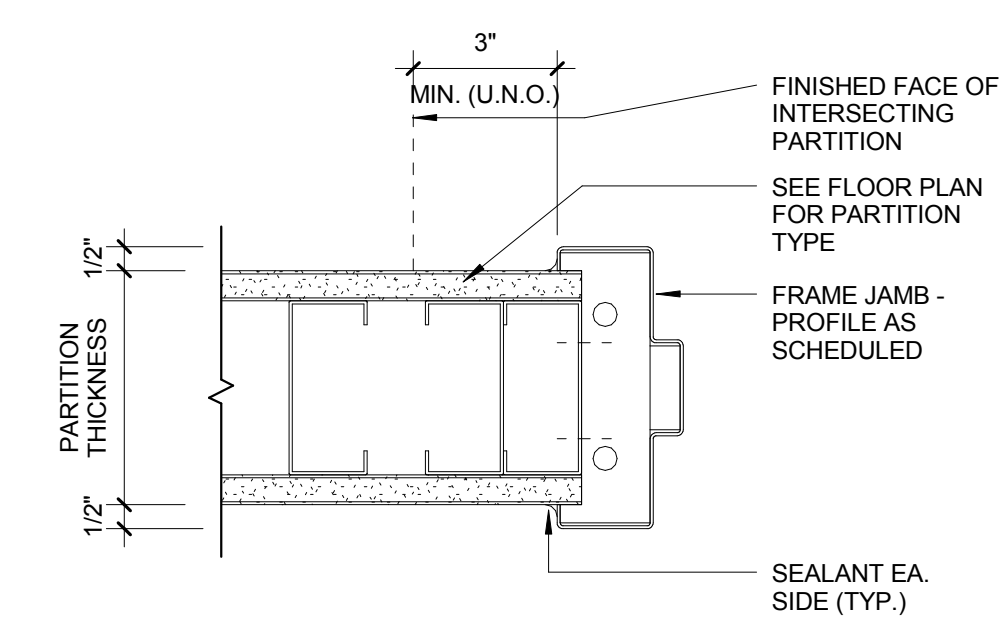

2 HM @ GYP JAMB DETAILS ABC
3" = 1'-0"

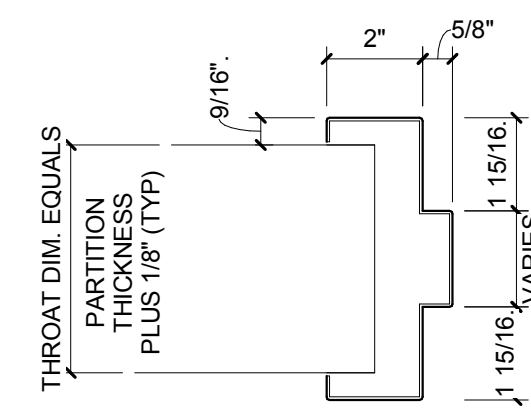

1 HM PROFILE
3" = 1'-0"