



EXTERIOR DOOR SCHEDULE															
	DOOR						FRAME								
	TYPE	OPENING WIDTH	LEAF WIDTH	OPENING HEIGHT	THK	MATL	GLASS	TYPE	MATL	HEAD	JAMB	SILL	GLASS	FIRE RATING (MIN.)	HDW SET
LEVEL 01															
X160.3	F	3'-0"		9'-0"	1 3/4"	HM		1	HM	7/A1011	3/A1011	10/A1011		N/A	
X172.2	F,F	6'-0"	3'-0"	7'-10"	1 3/4"	HM		1	HM	6/A1011	2/A1011	9/A1011		N/A	
X178.2	F,F	6'-0"	3'-0"	7'-10"	1 3/4"	HM		1	HM	5/A1011	1/A1011	9/A1011		N/A	
X188	F,F	6'-0"	3'-0"	7'-10"	1 3/4"	HM		1	HM	5/A1011	1/A1011	9/A1011		N/A	
X192.2	F,F	6'-0"	3'-0"	7'-10"	1 3/4"	HM		1	HM	5/A1011	1/A1011	9/A1011		N/A	
XC130	FG	3'-0"		9'-0"	1 3/4"	AL/GL		1	ALUM	12/A1011	12/A1011	11/A1011		N/A	
XC153	FG,FG	6'-0"	3'-0"	9'-0"	1 3/4"	AL/GL		1	ALUM	12/A1011	12/A1011	11/A1011		N/A	
XS176.1	F	3'-6"		7'-10"	1 3/4"	HM		1	HM	5/A1011	1/A1011	9/A1011		N/A	
LEVEL 02															
XC270A.1	FG,FG	6'-0"	3'-0"	8'-0"	1 3/4"	AL/GL		1	ALUM	12/A1011	12/A1011	11/A1011		N/A	
XC270A.2	FG,FG	6'-0"	3'-0"	8'-0"	1 3/4"	AL/GL		1	ALUM	12/A1011	12/A1011	11/A1011		N/A	
X294.2	F	3'-0"		7'-10"	1 3/4"	HM		5	HM	8/A1011	4/A1011	9/A1011		N/A	
XC230	FG,FG	6'-0"	3'-0"	7'-0"	1 3/4"	AL/GL		1	ALUM	12/A1011	12/A1011	11/A1011		N/A	
XC230	FG	3'-2"		7'-0"	1 3/4"	AL/GL		1	ALUM	12/A1011	12/A1011	11/A1011		N/A	
Grand total: 13															

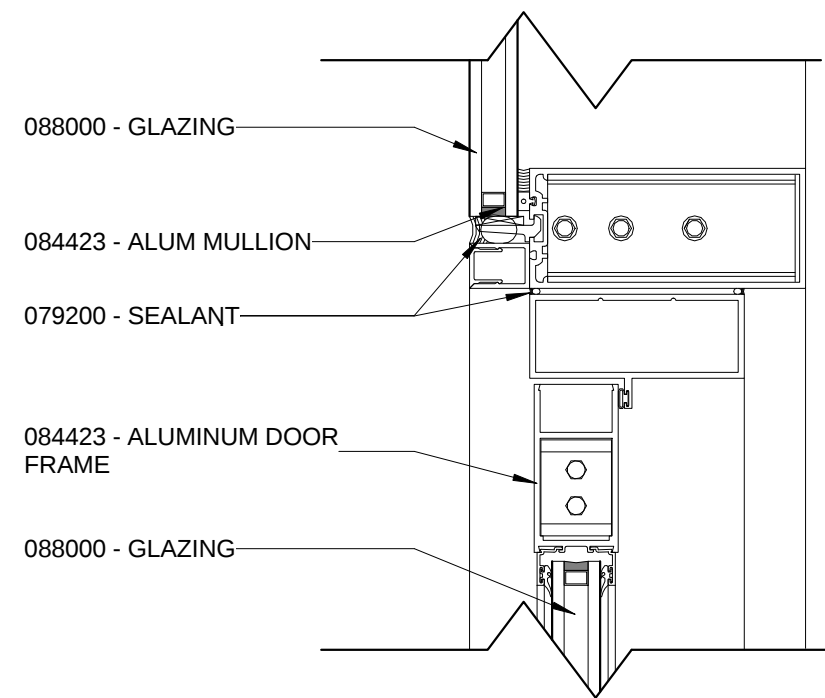


12 CURTAINWALL HEAD/JAMB
3" = 1'-0"

(DOORS: X294.2)

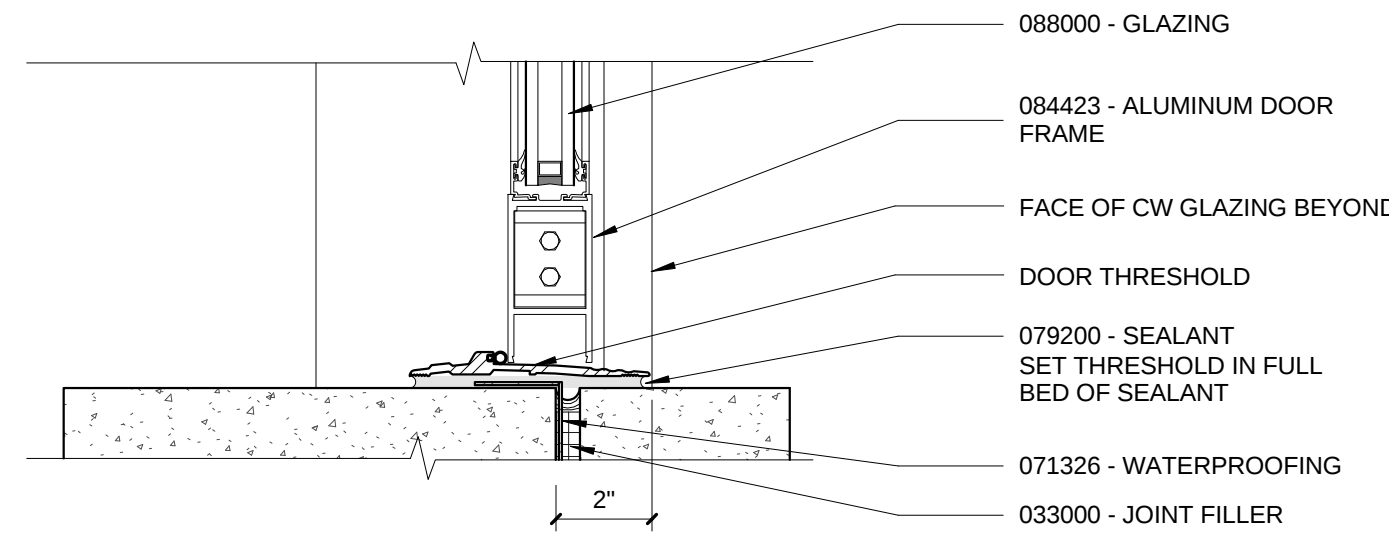


11 DOOR THRESHOLD AT ALUMINUM DOOR ASSEMBLY
3" = 1'-0"

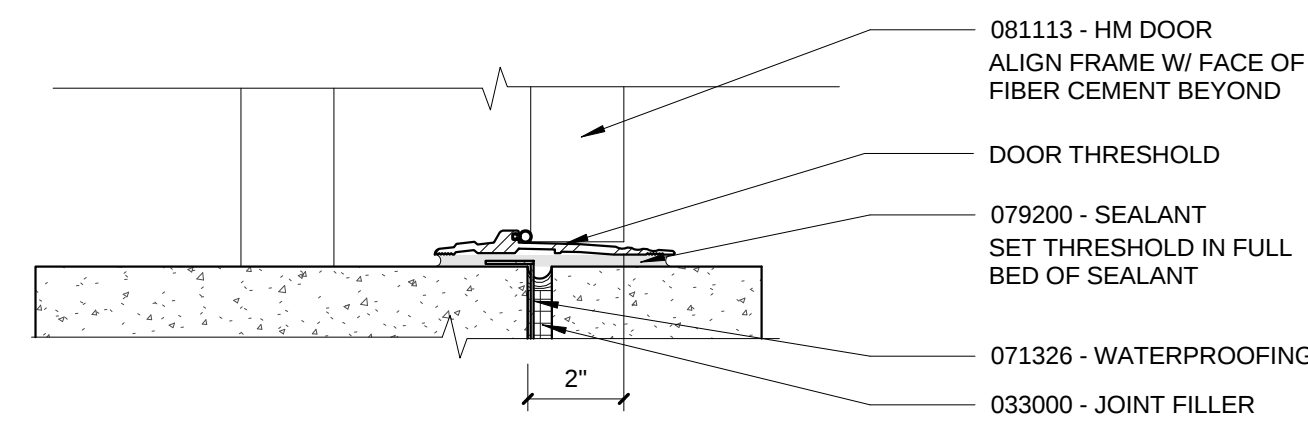


10 HM DOOR THRESHOLD AT WA-L2
3" = 1'-0"

(DOOR X160.3)

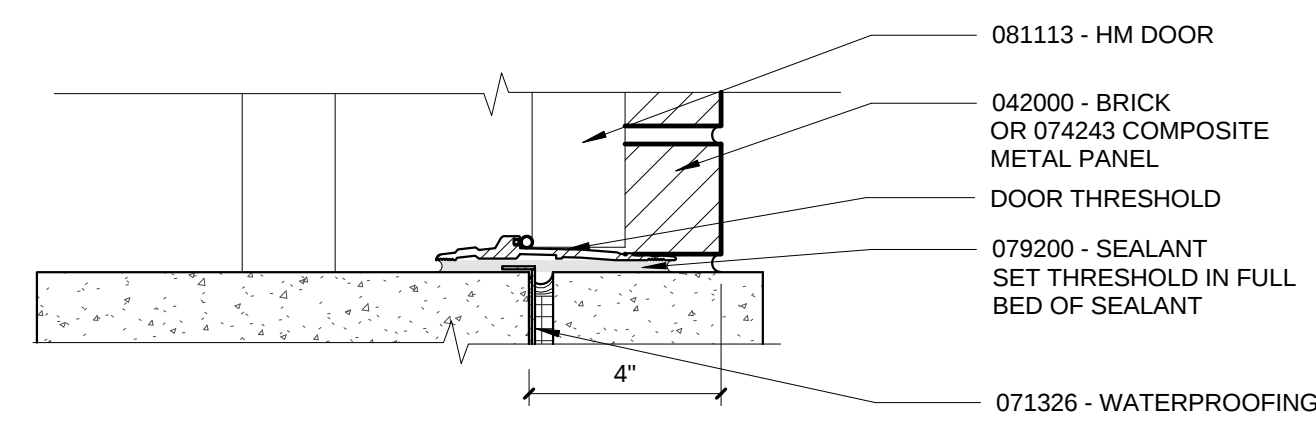


9 HM DOOR THRESHOLD DETAIL
3" = 1'-0"

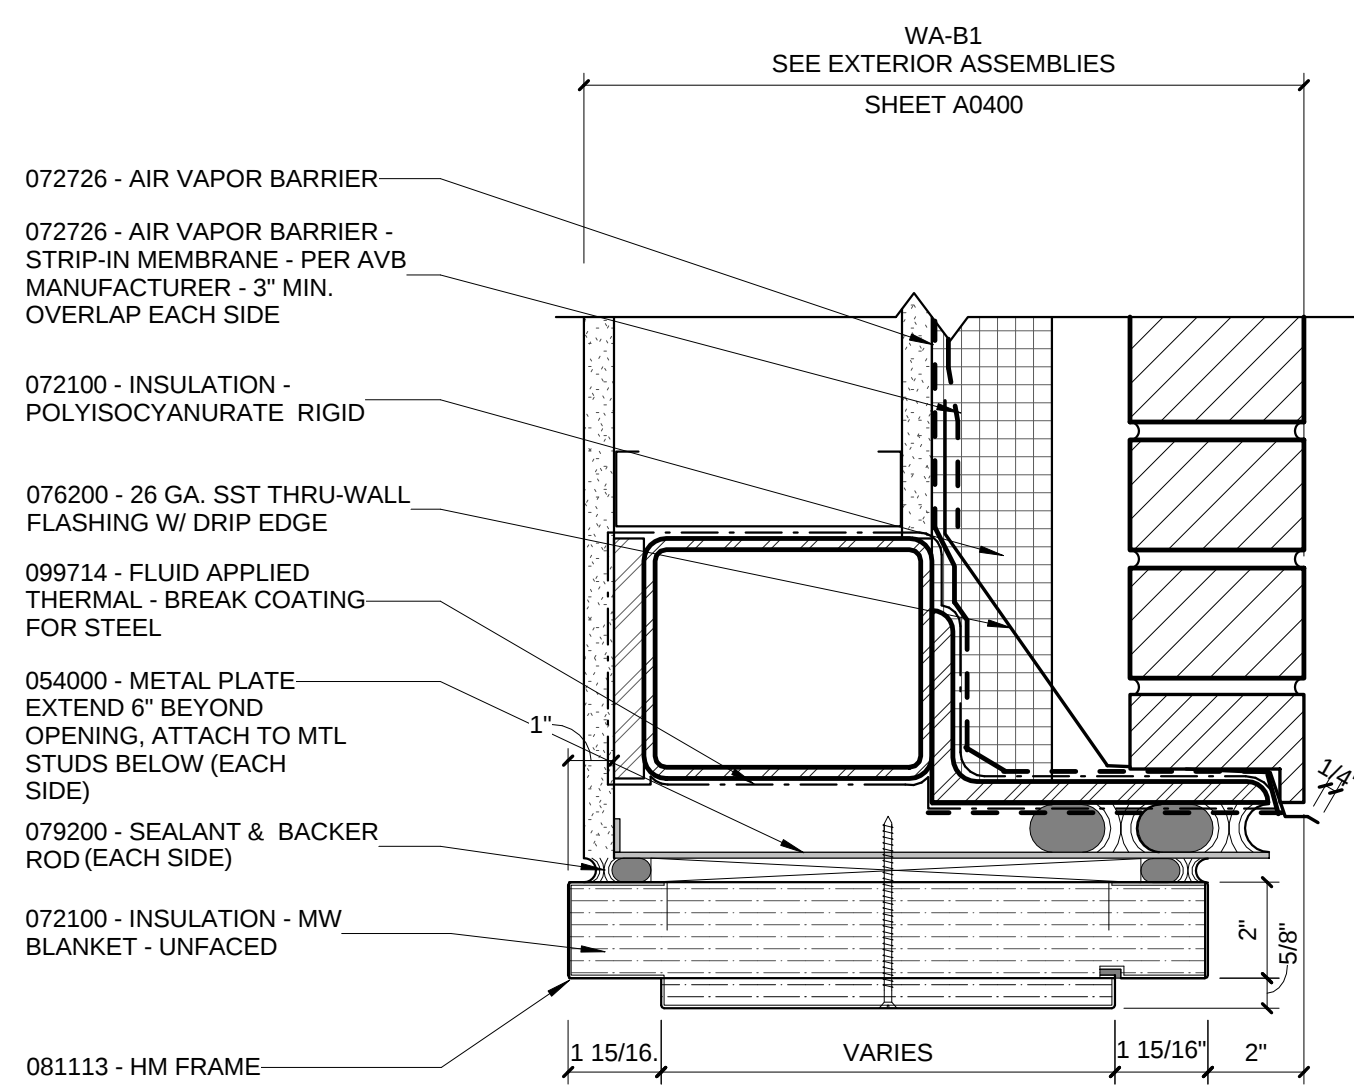


8 HM DOOR HEAD DETAIL @ BRICK/MTL. STUD
3" = 1'-0"

(DOORS: X294.2)

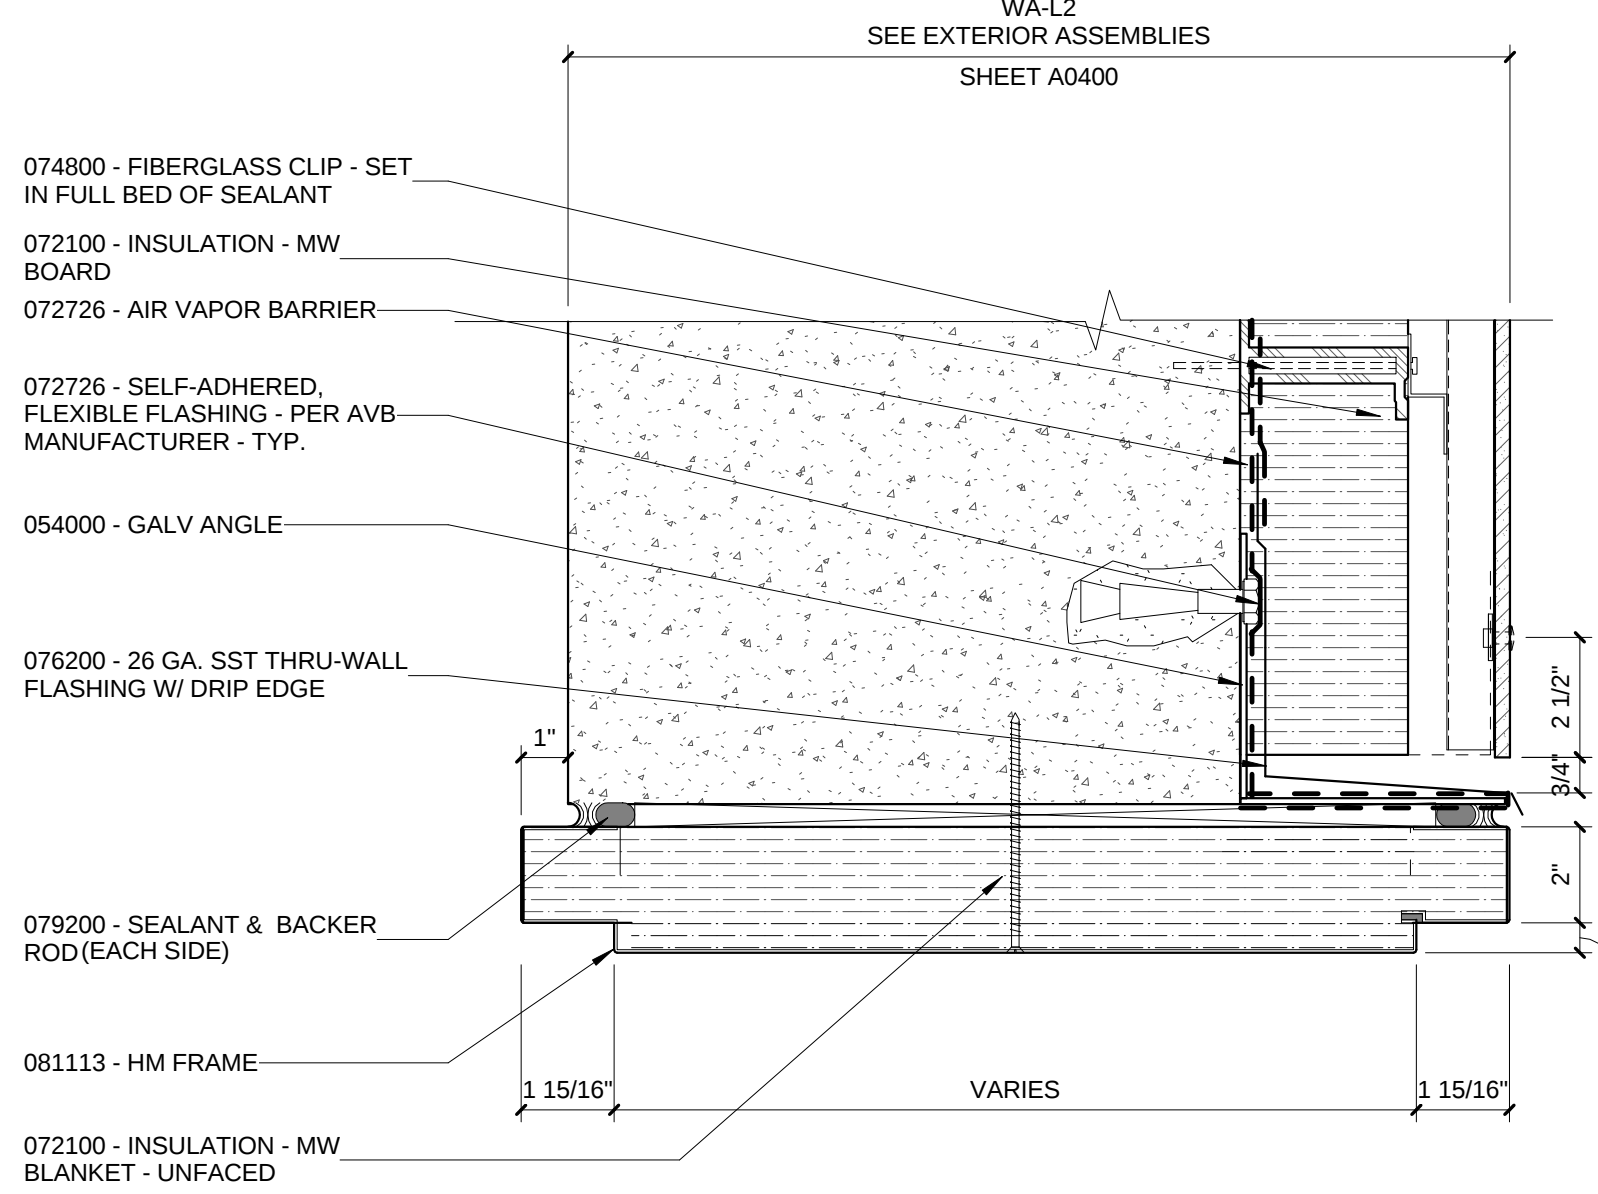


7 HM DOOR HEAD DETAIL @ FIBER CEMENT PANEL
3" = 1'-0"

(DOORS: X160.3)

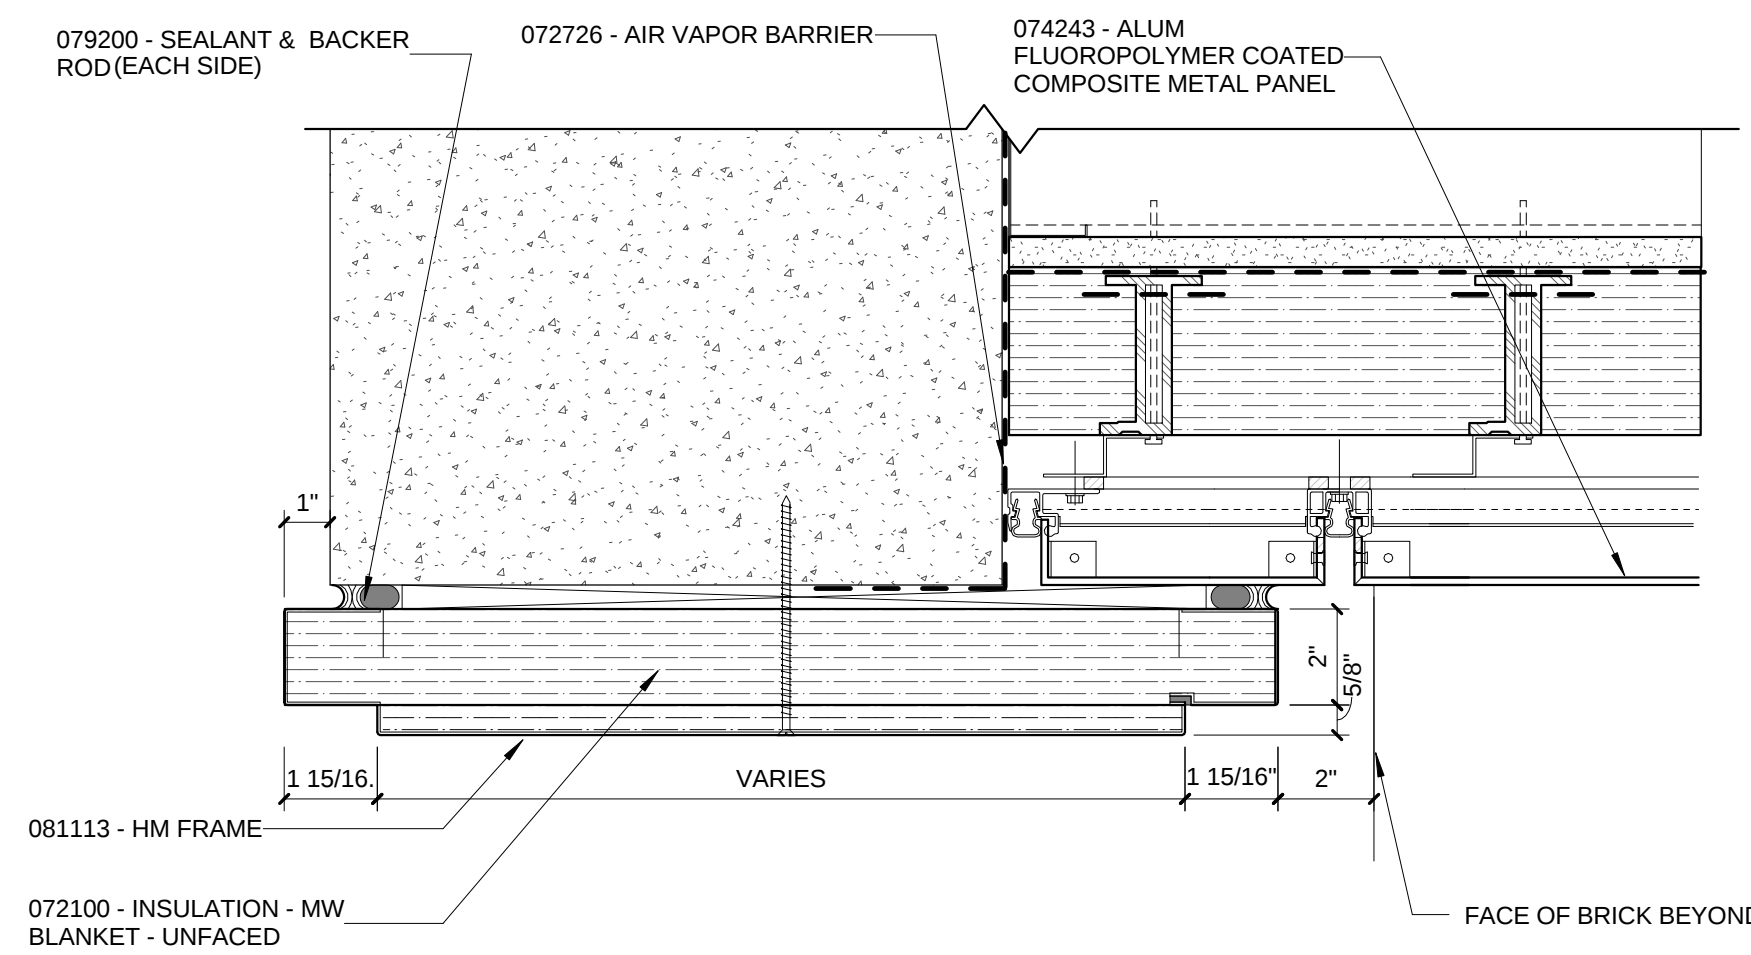


6 HM DOOR HEAD DETAIL @ METAL PANEL SOFFIT
3" = 1'-0"

(DOORS: X172.2)

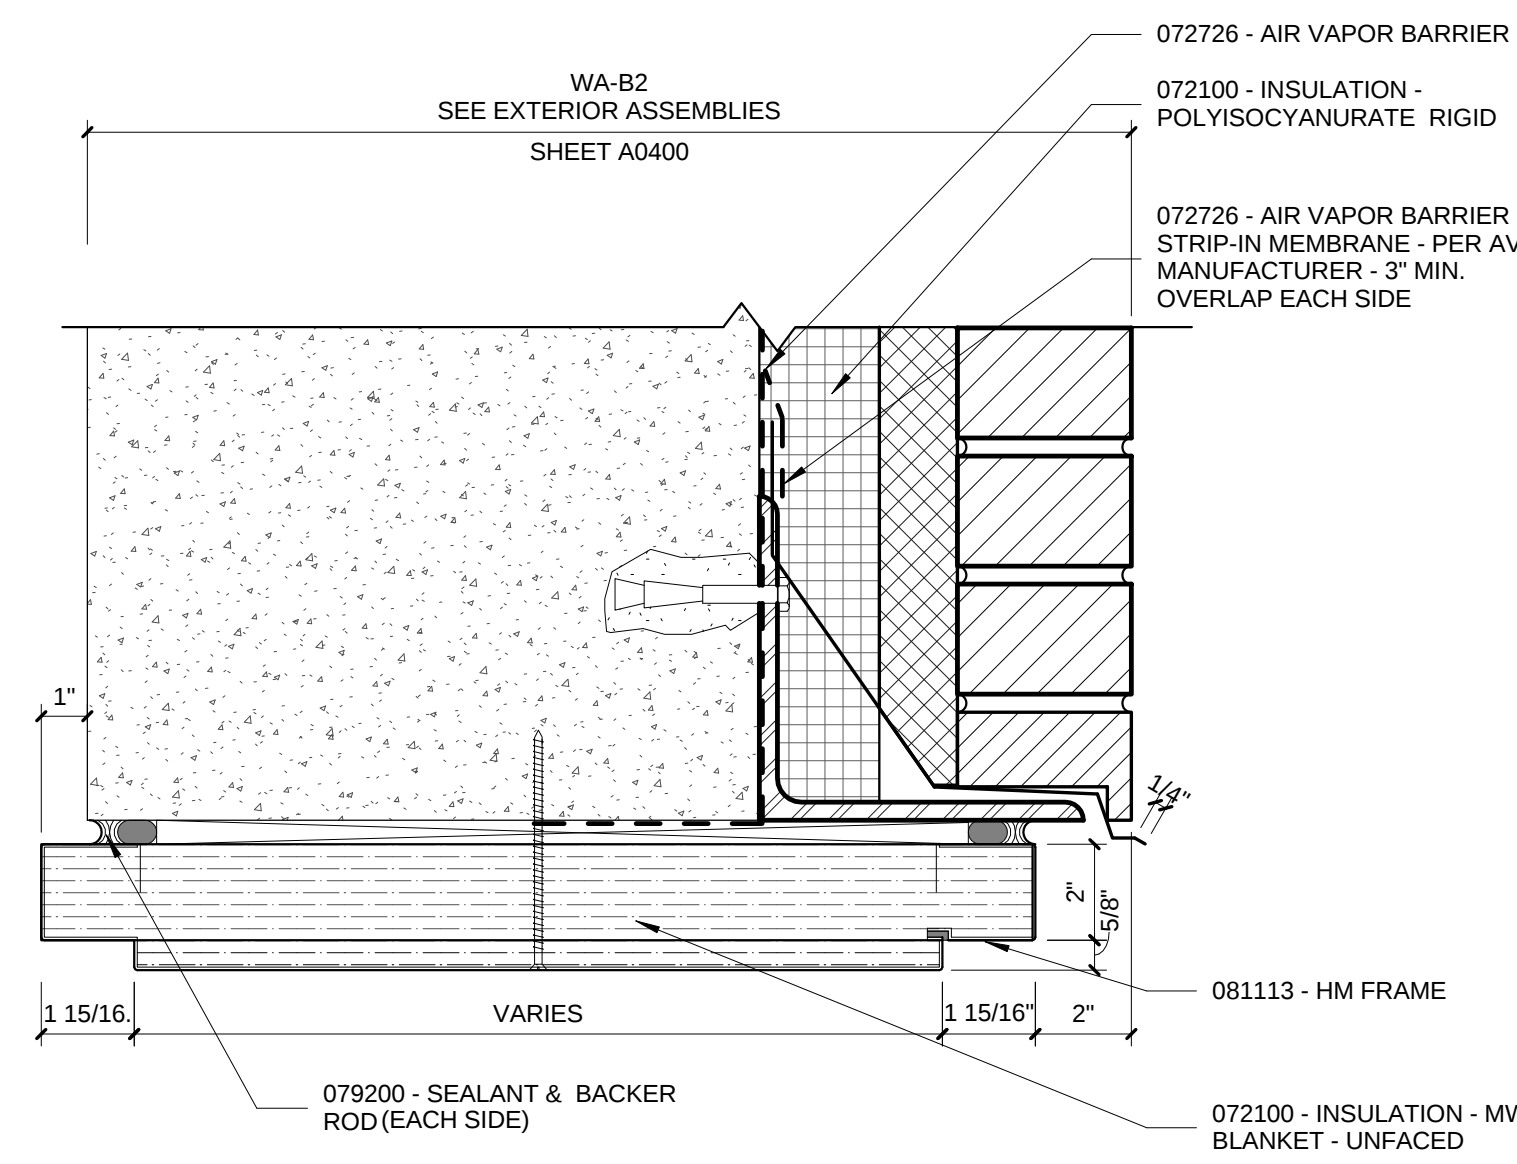


5 HM DOOR HEAD DETAIL @ BRICK/CONCRETE
3" = 1'-0"

(DOORS: XS176.1, X178.2, X188 & X192.2)

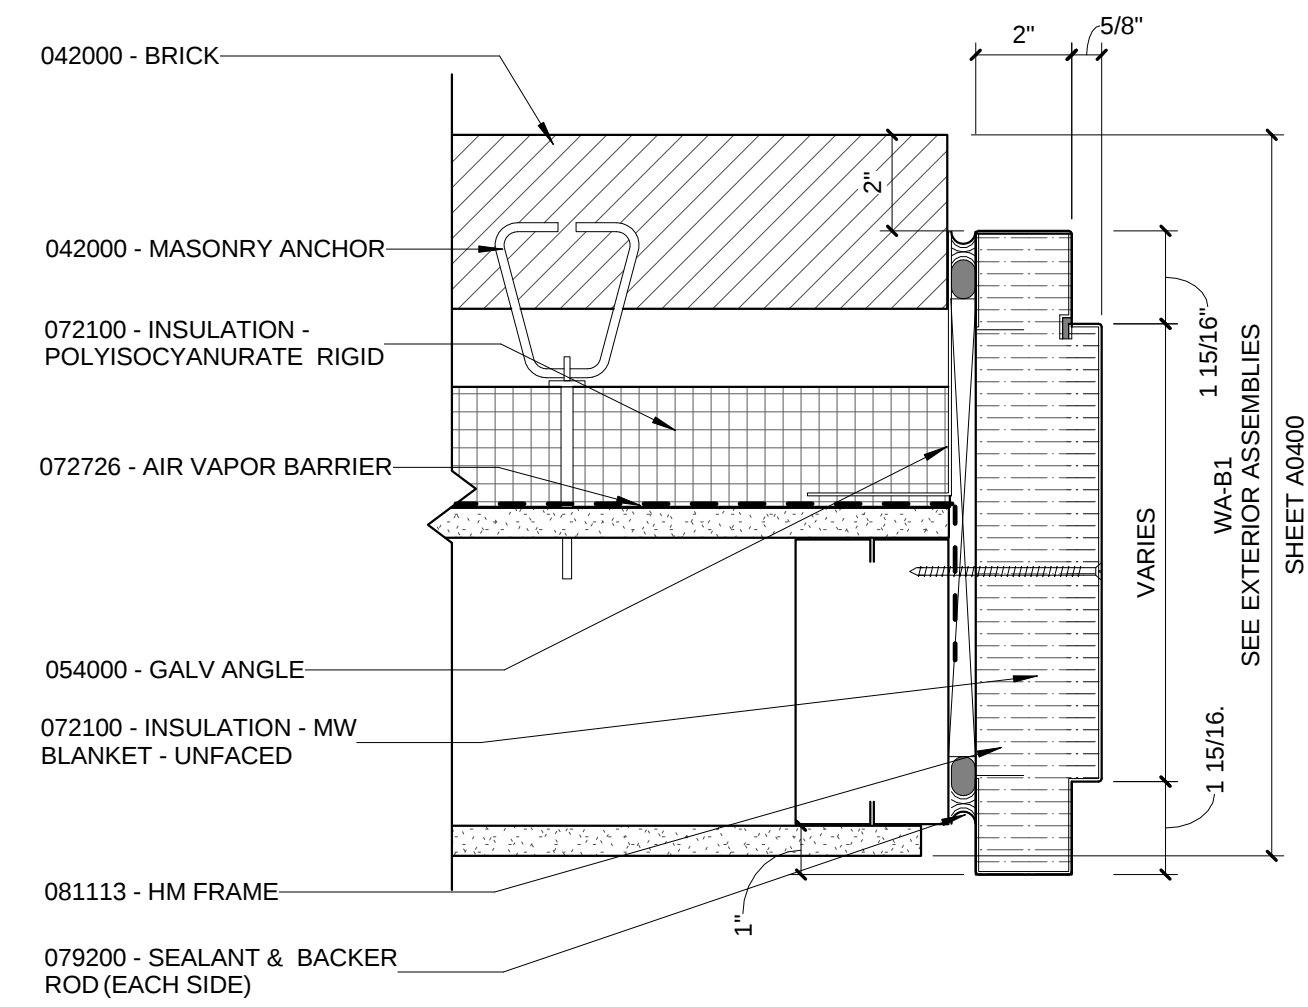


4 HM DOOR JAMB DETAIL @ BRICK/MTL. STUD
3" = 1'-0"

(DOORS: X294.2)

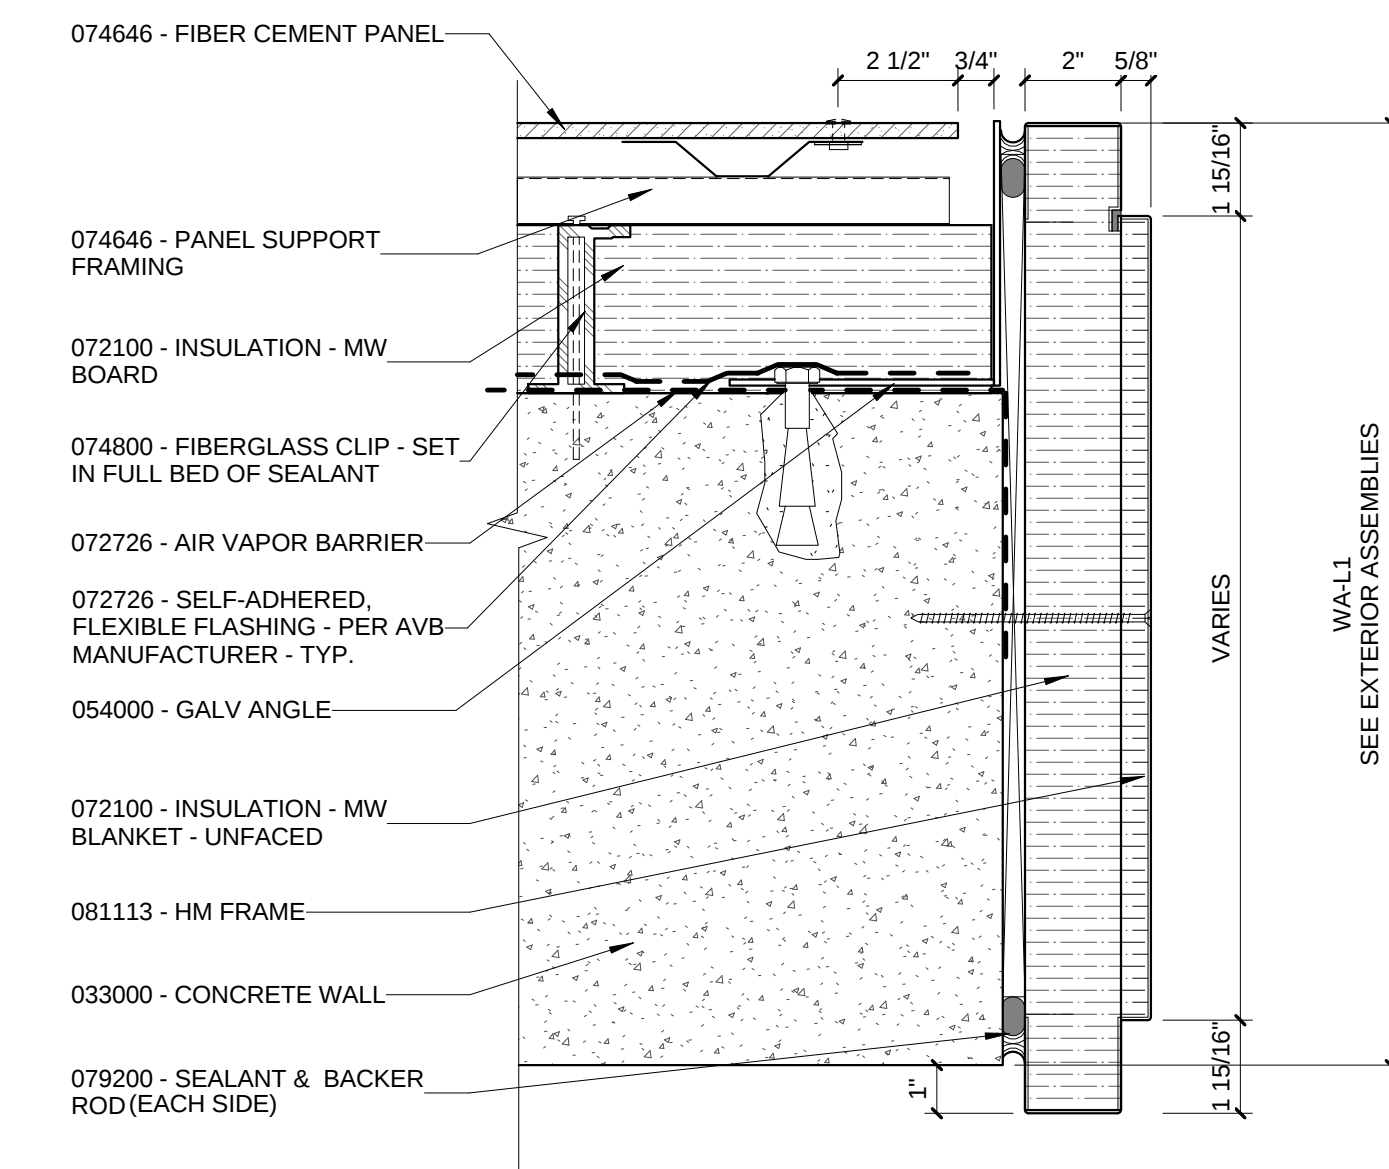


3 HM DOOR JAMB DETAIL @ FIBER CEMENT PANEL
3" = 1'-0"

(DOORS: X160.3)

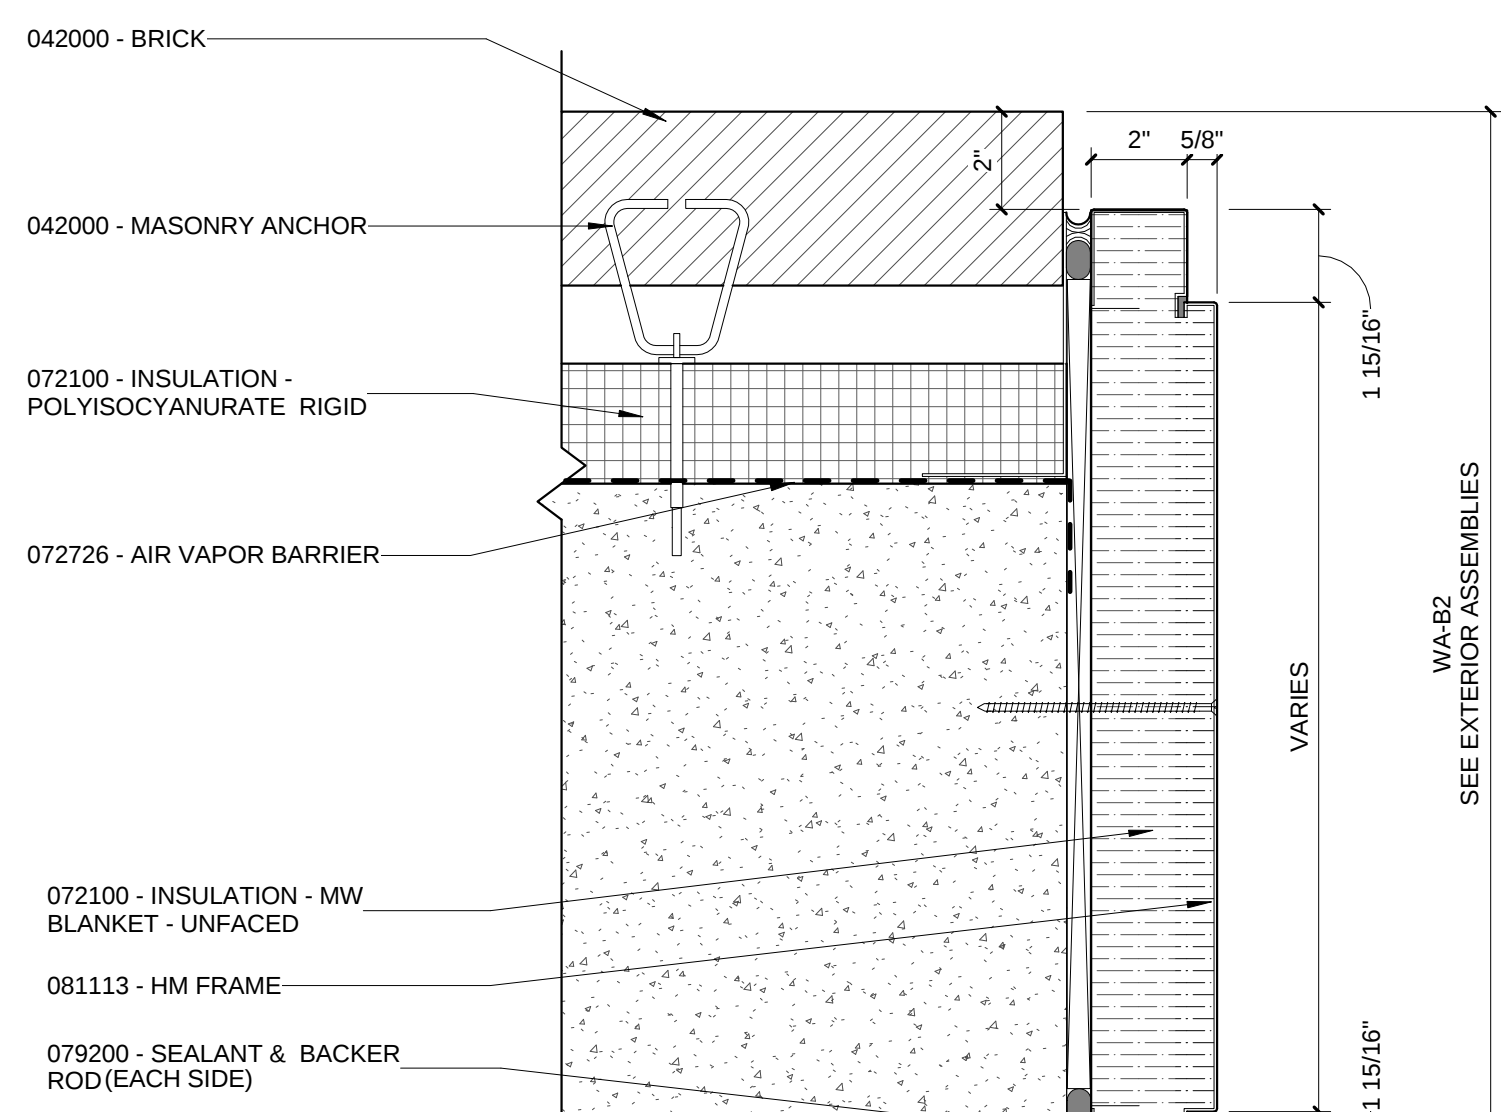

2 HM DOOR JAMB DETAIL @ BRICK/CONCRETE
3" = 1'-0"

(DOORS: X172.2)

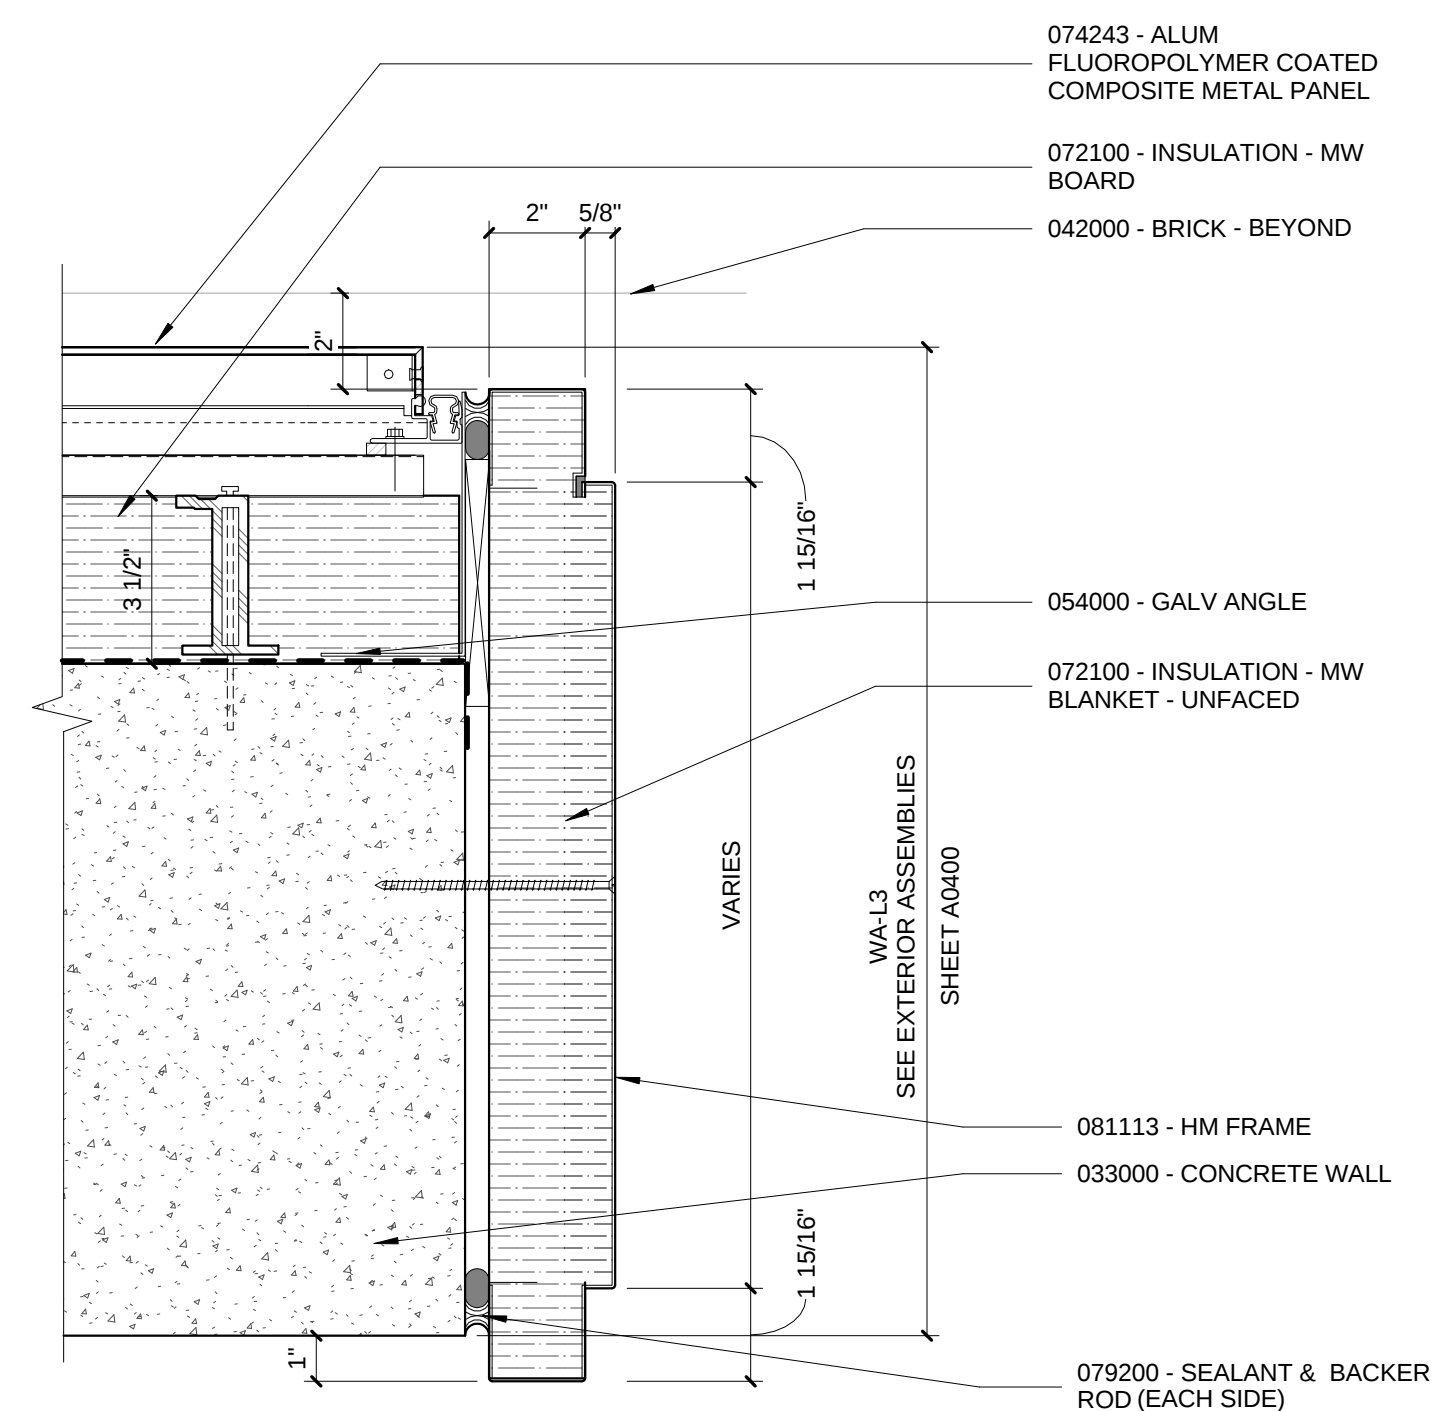

1 HM DOOR JAMB DETAIL @ METAL PANEL
3" = 1'-0"

(DOORS: XS176.1, X178.2, X188 & X192.2)