


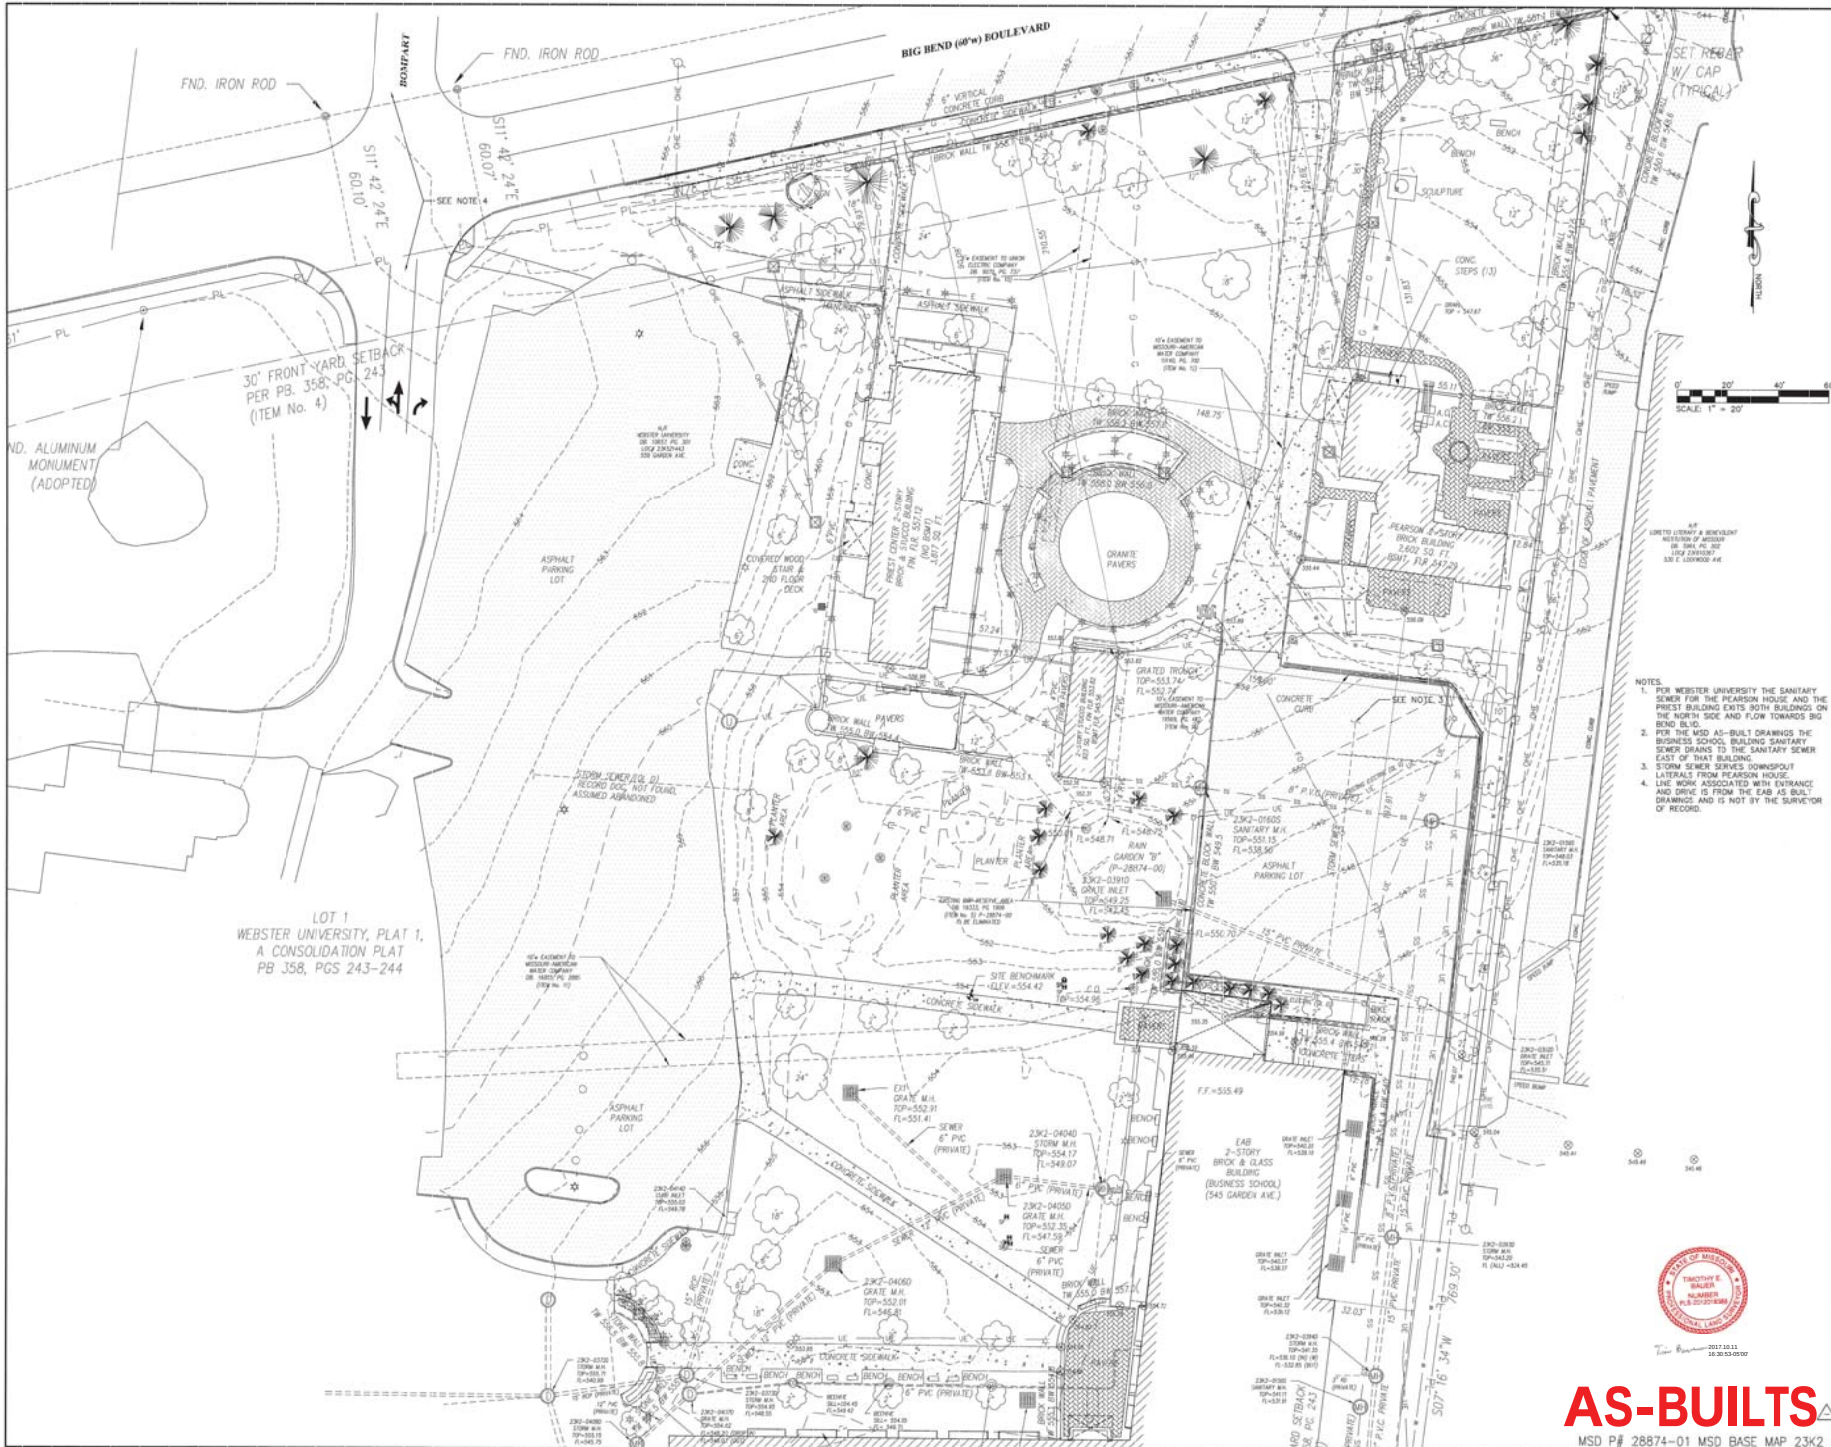

Webster
UNIVERSITY

Webster University
Interdisciplinary Science
Building

CANNONDESIGN

1100 Clark Avenue
St. Louis, Missouri 63102
P: 314.241.6100
F: 314.241.2570

William Tax & Associates, Inc.
1700 Manchester Road, Suite 100
St. Louis, MO 63113
314.884.7800

David Mason & Associates, Inc.
Structural & Civil Engineer
MO Civil Code of Authority # 011105
800 South Vandeventer Avenue
St. Louis, MO 63110
314.234.1001

Fath Group
Technology
3101 S. Hanley Ave., Suite 100
St. Louis, MO 63111
314.997.2228

Kohlmeyer Land, Inc.
Environmental Graphics & Design
2000 Parkview Ave.
St. Louis, MO 63110
314.742.8910

KWA Architects
Architects
8721 Langer Road
St. Louis, MO 63124
314.662.2000

Speelman Brady & Company
Interior Designer
6211 Maryland Avenue, Suite 300
St. Louis, MO 63119
314.862.9070

BWT Design
Landscape Architect
1722 Big Bend Road
St. Louis, MO 63119
314.844.5701

Webb Engineering Services, Inc.
Planning & Fire Protection
1402 S. 2nd Street, Suite 201
St. Louis, MO 63104
314.588.0001

- NOTES:
1. FOR WEBSTER UNIVERSITY THE SANITARY SEWER FOR THE PEARSON HOUSE AND THE PRESTON BUILDING EXITS BOTH BUILDINGS ON THE NORTH SIDE AND FLOW TOWARDS BIG BEND BLVD.
 2. FOR THE MSD AS-BUILT DRAWINGS THE BUSINESS SCHOOL BUILDING SANITARY SEWER DRAINS TO THE SANITARY SEWER EAST OF THAT BUILDING.
 3. STORM SEWER SERVES DOWNSPOUT LATERALS FROM PEARSON HOUSE.
 4. LINE WORK ASSOCIATED WITH ENTRANCE AND DRIVE IS FROM THE EAB AS BUILT DRAWINGS AND IS NOT BY THE SURVIVOR OF RECORD.



ADDENDUM 1-10

5 MAY 2016

ISSUED FOR CONSTRUCTION (BPT) 15 JAN 2016

No.	Description	Date
1	KEY PLAN	



EXISTING
CONDITIONS

Project No. 0401-101 Checked by

C200

AS-BUILTS
MSD P# 28874-01 MSD BASE MAP 23K2