




1. ADDENDUM 1-10 5 MAY 2016

1. ADDENDUM 1-11 ISSUED FOR CONSTRUCTION (BPT) 29 JAN 2016

No. Description Date

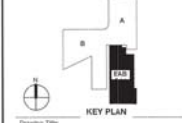

Drawing Title

DEMOLITION PLAN

Project No. 04501-00 Checked by

C300

P: 314.241.6200

LEGEND (THIS SHEET ONLY)

- UTILITY TO BE REMOVED
- WALL TO BE REMOVED
- PAV'T TO BE REMOVED
- TREE TO BE REMOVED

1
RSITY, PLAT 1,
ATION PLAT
2S 243-244

KEYED DEMOLITION NOTES

1. SEE LANDSCAPE DRAINAGE FOR LIMITS OF EXISTING IRRIGATION SYSTEM REMOVAL.
2. DISCONNECT EXISTING DOWNSPOUT LATERAL FROM COLLECTOR LINE AND REMOVE COLLECTOR LINE.
3. SEE LANDSCAPE TREE PROTECTION PLAN FOR ADDITIONAL TREES TO BE REMOVED AND LIMITS OF TREE PROTECTION ZONE FOR TREES THAT ARE TO REMAIN.
4. TO BE REMOVED AND REPLACED AT MSD INSPECTORS DISCRETION.

SHEET GENERAL NOTES

1. ANY ABANDONED SEWERS SHALL BE REMOVED OR COMPLETELY GROUT FILLED.
2. MSD PERMITS ARE REQUIRED PRIOR TO THE ABANDONMENT OR REMOVAL OF EXISTING SEWERS. TO REMOVE MSD FORMS THE PROJECT MUST HAVE MSD PLAN APPROVAL, NOTIFY MSD 48 HOURS PRIOR TO SEWER ABANDONMENT AND/OR REMOVAL.

AS-BUILTS

MSD P# 28874-01 MSD BASE MAP 23K2

Time Review 2017.05.11 04:50:00



Time Review 2017.05.11 04:50:00

