




2	AS-BUILT RAINGARDEN 2 RECORDING	01 JUN 2017
3	AS-BUILT	08 MAR 2017
4	ACCOMMODATION 1-1	08 MAR 2017
5	ISSUED FOR CONSTRUCTION (BPT)	15 JAN 2016
No.	Description	Date

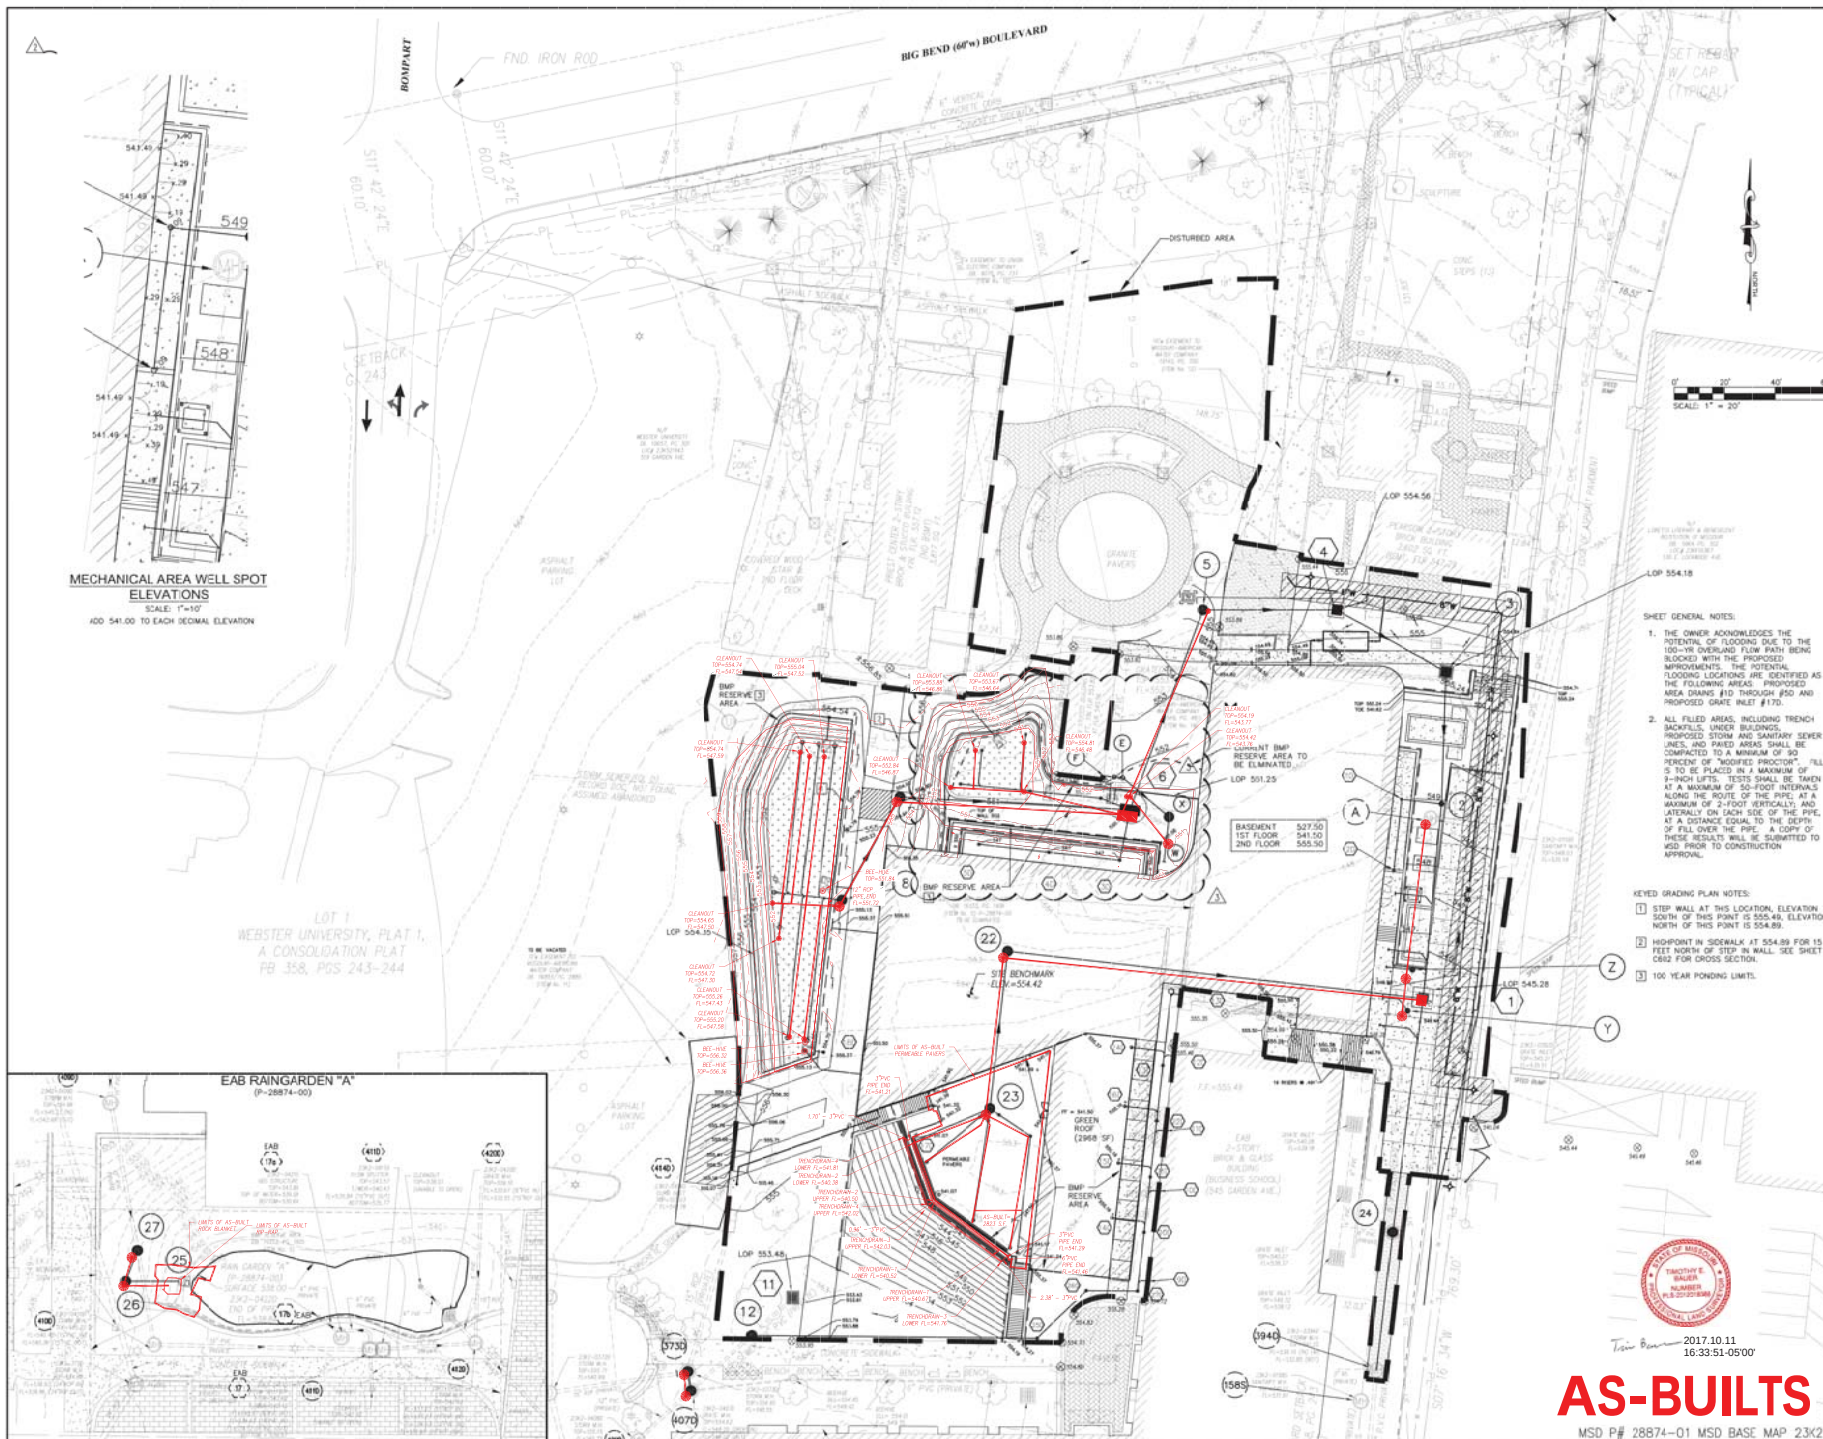