

AS-BUILTS



STORM SYSTEM LOCATION
 1. MAIN STORM SEWER
 2. DOWNSPOUT LATERAL SYSTEM FOR EAB
 3. THRU BUILDING SYSTEM
 4. INLET 11
 5. PLAZA TRENCH DRAIN
 6. AREA WELL EAST SIDE OF ISB
 7. AREA WELL NORTH OF WEST WING

Webster
UNIVERSITY

Webster University
Interdisciplinary Science
Building

CANNONDESIGN

1108 Clark Avenue
St. Louis, Missouri 63103
P: 314.241.5100
F: 314.241.5170

William T. & Associates, Inc.
1000 E. Main Street, Suite 100
St. Louis, MO 63103
P: 314.588.8800

David Mason & Associates, Inc.
Structural & Civil Engineer
601 Oak Court at University #10103
200 South Grand Avenue
St. Louis, MO 63103
P: 314.588.8800

Felix Group
Technology
3101 S. Brentwood, Suite 100
St. Louis, MO 63103
P: 314.588.8800

Kullmann Law, Inc.
Environmental Engineers & Planners
1400 Pershing Ave.
St. Louis, MO 63103
P: 314.725.5615

KMA Architects
Architects
8721 Kanger Road
St. Louis, MO 63103
P: 314.588.8800

Technical Drafting & Imaging
Interior Designers
621 Maryland Avenue, Suite 300
St. Louis, MO 63103
P: 314.588.8800

3MT Design
Landscape Architect
7720 Bay View Blvd.
St. Louis, MO 63103
P: 314.588.8800

Web Engineering Services, Inc.
Planning & Site Production
1400 S. 2nd Street, Suite 201
St. Louis, MO 63103
P: 314.588.8800



APPENDIX 1-10 5 MAY 2018

APPENDIX 1-1 29 JAN 2018

ISSUED FOR CONSTRUCTION (BFP) 15 JAN 2018



Drawing Title


SEWER PROFILES

Project No.: 04551-00 Checked by:


C600

© 2018 Design Pro


SANITARY SYSTEM 1 PROFILE

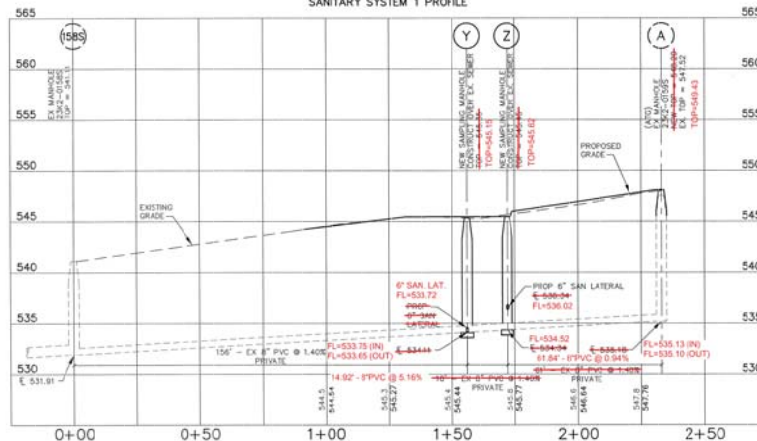


SANITARY SYSTEM 2 PROFILE

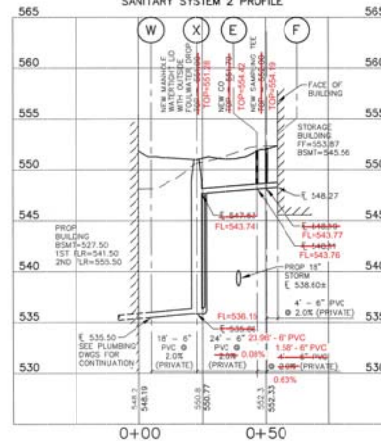


STORM SYSTEM 1 PROFILE

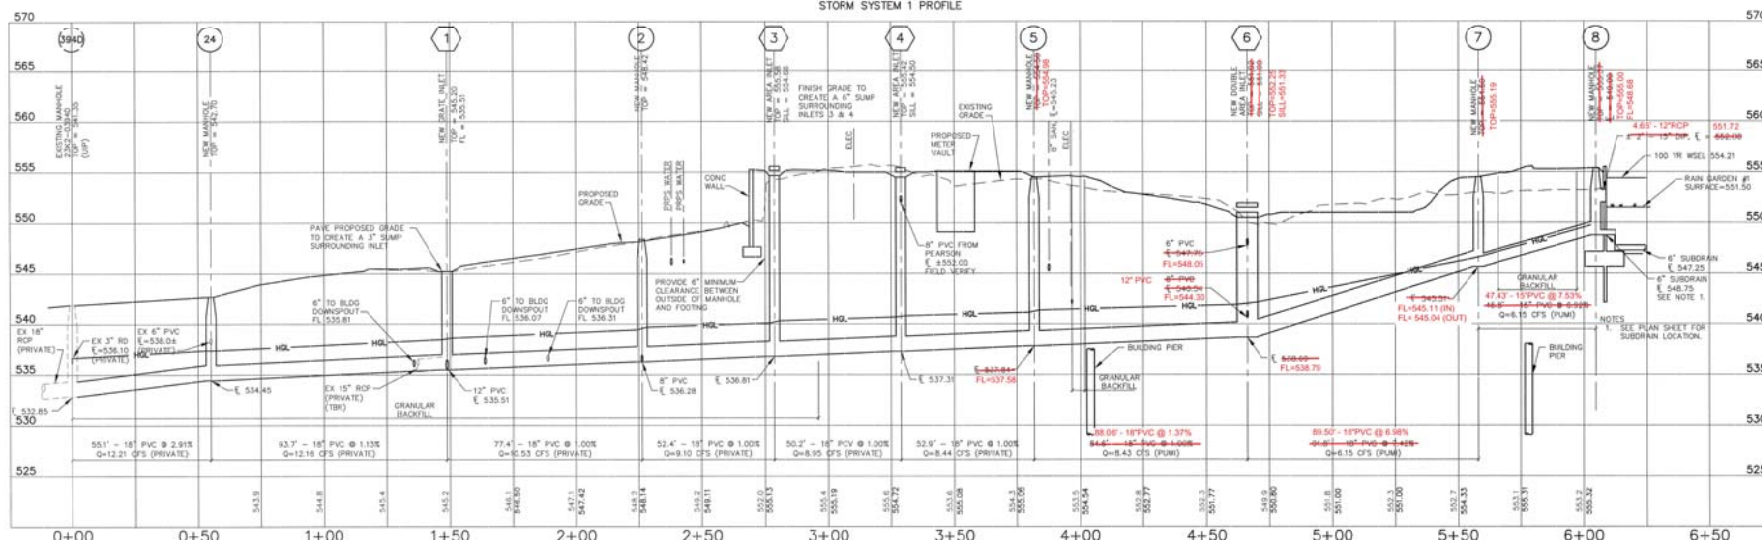

EAB9 TO 3940 PROFILE

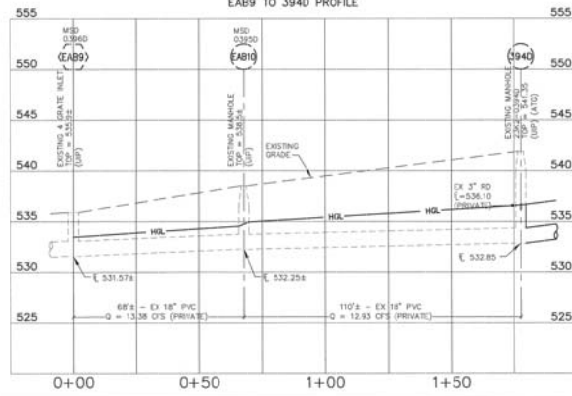

STORM SYSTEM 2 PROFILE

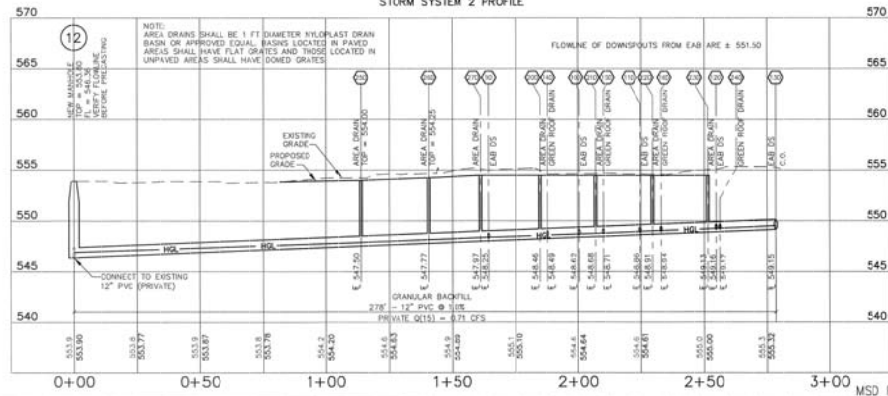

NOTE:

FLWS (Q) AND HYDRAULIC GRADE LINE (HGL) INFORMATION ARE FOR 100 YEAR 20 MINUTE STORM EVENT EXCEPT AS NOTED.

FLWS (Q) AND HYDRAULIC GRADE LINE (HGL) INFORMATION ARE FOR 100 YEAR 20 MINUTE STORM EVENT EXCEPT AS NOTED.

