













ADDENDUM 1-10	9 MAY 2016
ADDENDUM 1-11	29 JAN 2016
ISSUED FOR CONSTRUCTION (BFP)	19 JAN 2016
No.	Description
	Date

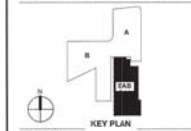

Drawing Title

Project No.: 04851-00 Checked by:
C601
MSD P# 28874-01 MSD BASE MAP 23K2

- STORM LOCATION
SYSTEM
1. MAIN STORM SEWER
2. DOWNSPOUT LATERAL SYSTEM FOR EAB
3. THRU BUILDING SYSTEM
4. INLET 11
5. PLAZA TRENCH DRAIN
6. AREA WELL EAST SIDE OF ISB
7. AREA WELL NORTH OF WEST WING

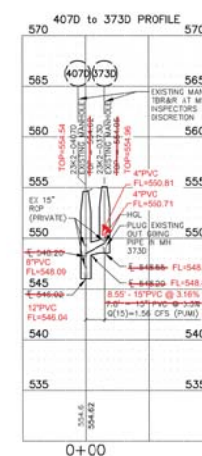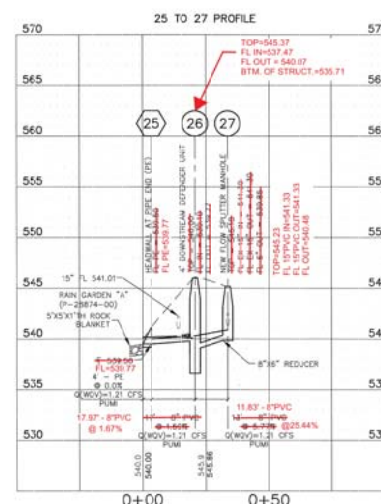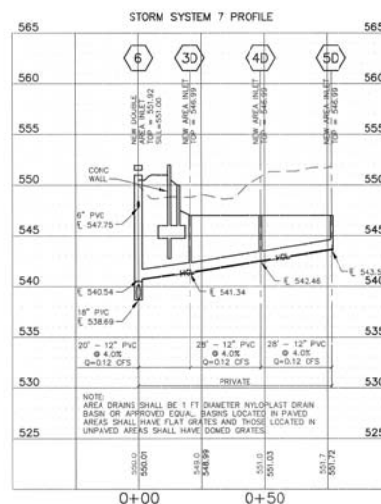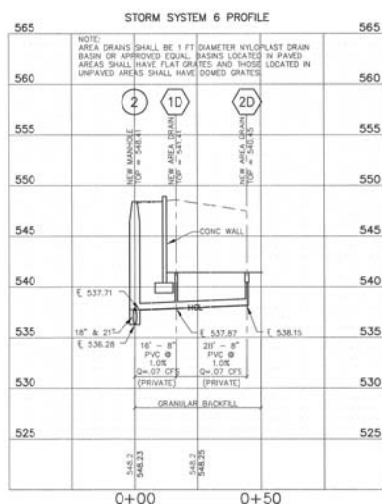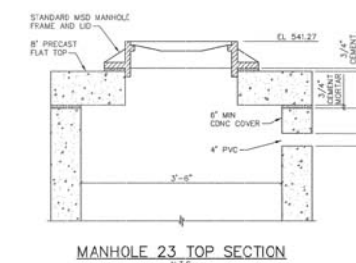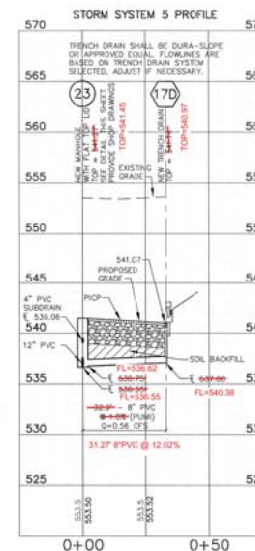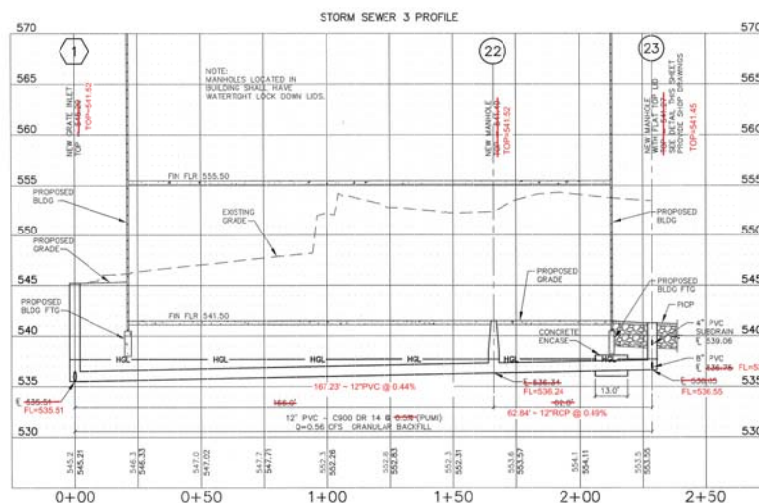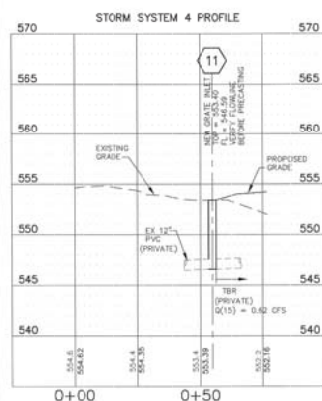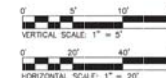

NOTE:
FLOWS (Q) AND HYDRAULIC GRADE LINE (HGL) INFORMATION ARE FOR 100 YEAR 20 MINUTE STORM EVENT EXCEPT AS NOTED.

AS-BUILTS
MSD P# 28874-01 MSD BASE MAP 23K2

C601