



4	AS-BUILT RAIN GARDEN 2 RECONFIG	01 JUN 2017
3	ADDENDUM-12	18 JUN 2016
2	ADDENDUM-10	18 JUN 2016
1	ADDENDUM-1	29 JAN 2016
	ISSUED FOR CONSTRUCTION (BPI)	15 JAN 2016
No.	Description	Date












Drawing Title: **BASIN SECTIONS**

Project No.: 0061-00 Checked by:

C602

AS-BUILTS

MSD P# 28874-01 MSD BASE MAP 23K2
MSD FIELD CHANGE 1 (SHEET 3 OF 4)

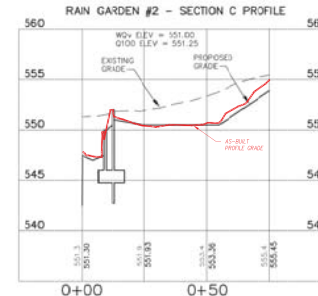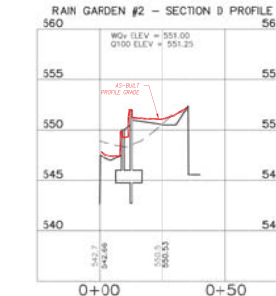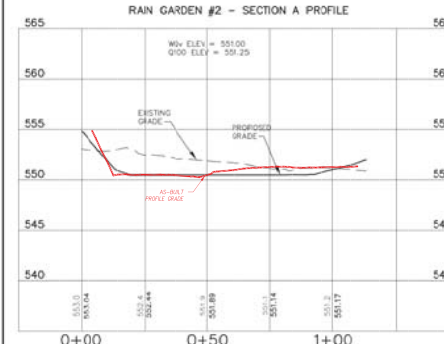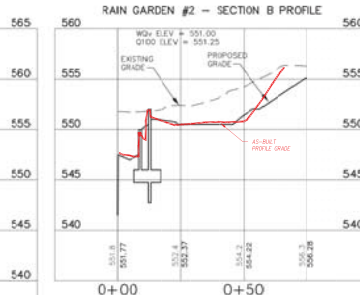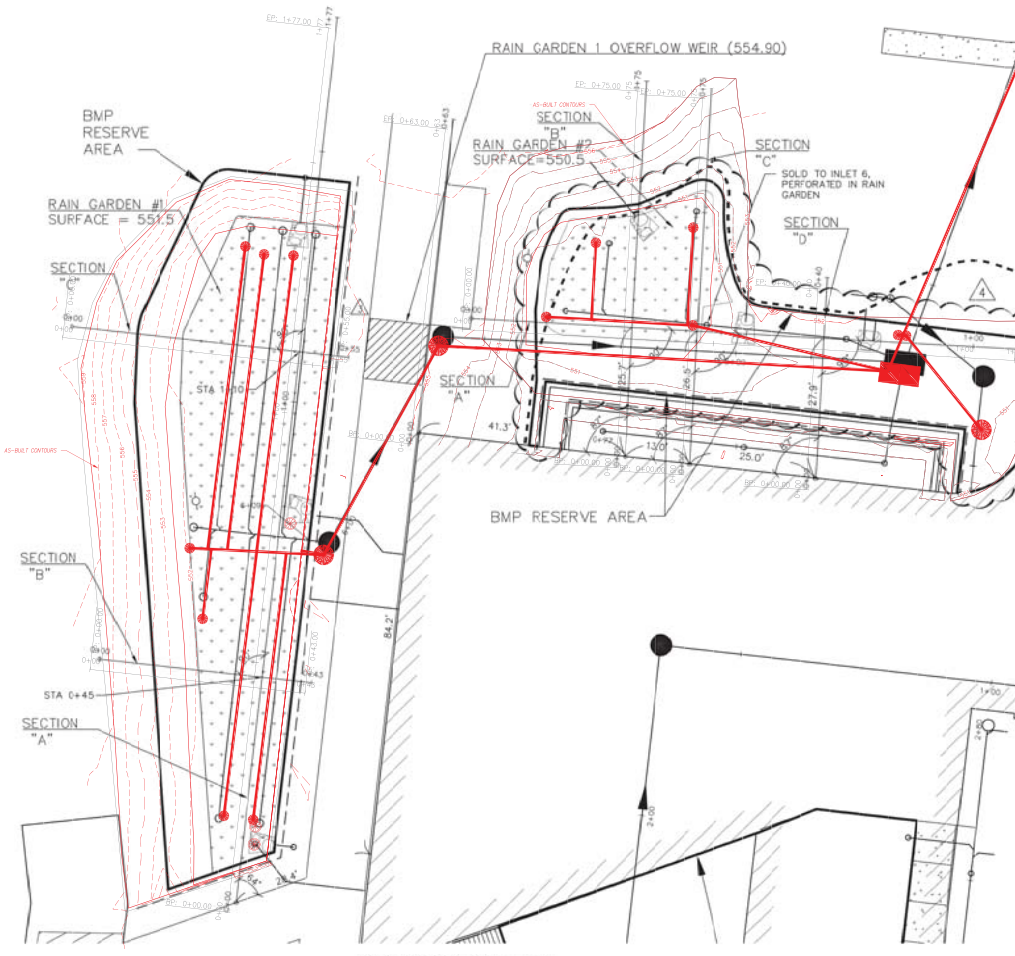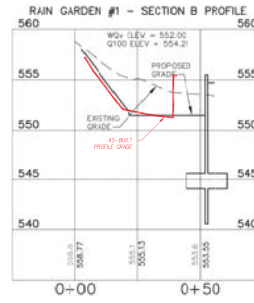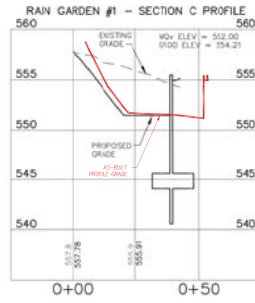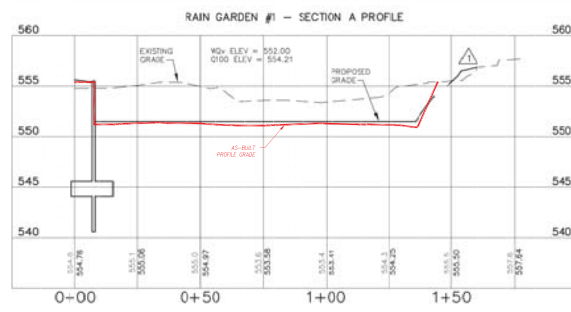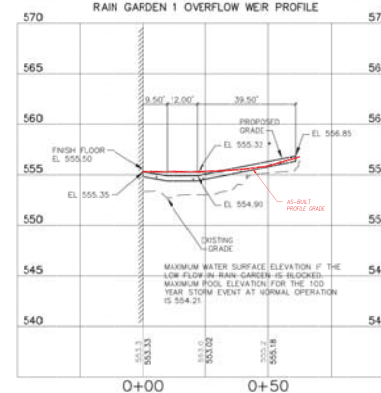

SCALES FOR PROFILES
HORIZONTAL SCALE: 1" = 20'
VERTICAL SCALE: 1" = 5'

NOTE:
CONTRACTOR TO PROVIDE SIGNED AND SEALED SHOP
DRAWINGS TO BE APPROVED BY THE PROJECT ENGINEER
AND MSD. CONTACT MSD AT 314-335-2072.

HORIZONTAL SCALE: 1" = 10'