



Webster University
Interdisciplinary Science
Building

CANNONDESIGN

1100 Clark Avenue
St. Louis, Missouri 63102
T: 314.241.6250
F: 314.241.2570

William Tao & Associates, Inc.
ME/PE/PP Engineer
7955 Manchester Road, Suite 125
St. Louis, MO 63143
314.884.7600

David Mason & Associates, Inc.
Structural & Civil Engineer
MO Civil Cert of Authority # 003103
800 South Vandeventer Avenue
St. Louis, MO 63110
314.534.1053

Faith Group
Technology
3101 S. Hanley Rd., Suite 100
St. Louis, MO 63143
314.991.2228

Kuhlmann Leavitt, Inc.
Environmental Graphics & Signage
7400 Pershing Ave.
St. Louis, MO 63130
314.725.6616

KWA Architects
Architecture
9721 Lezinger Road
St. Louis, MO 63124
314.962.2560


Spelman Brady & Company
Interior Designer
8251 Maryland Avenue, Suite 300
St. Louis, MO 63105
314.862.0070

SWT Design
Landscape Architect
7722 Big Bend Blvd
St. Louis, MO 63104
314.544.5700

Webb Engineering Services, Inc.
Interior Designer
1400 S. 3rd Street, Suite 201
St. Louis, MO 63104
314.588.0600



1. ADDENDUM 1-10
2. ISSUED FOR CONSTRUCTION (BPI)
3. No. Description Date
4. 5 MAY 2016
5. 15 JAN 2016

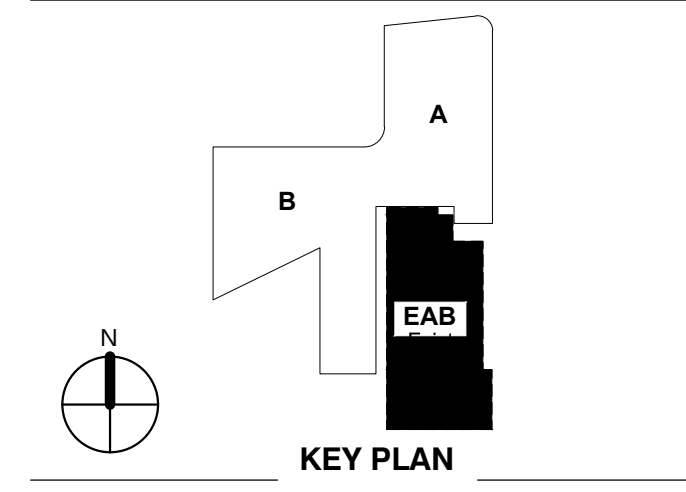

EXISTING CONDITIONS

Project No.: 04561.00 Checked by:

C200

MSD P# 28874-01 MSD BASE MAP 23K2