



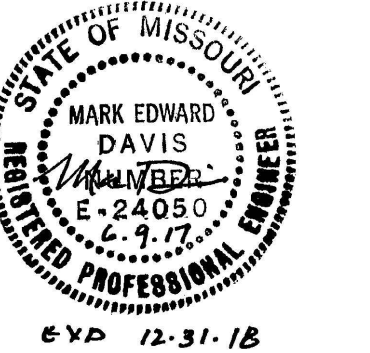

4	ASI 070 RAIN GARDEN 2 RECONFIG	09 JUN 2017
3	ADDENDUM 1-12	16 JUN 2016
2	ADDENDUM 1-10	5 MAY 2016
1	ADDENDUM 1-1	29 JAN 2016
-	ISSUED FOR CONSTRUCTION (BP1)	15 JAN 2016

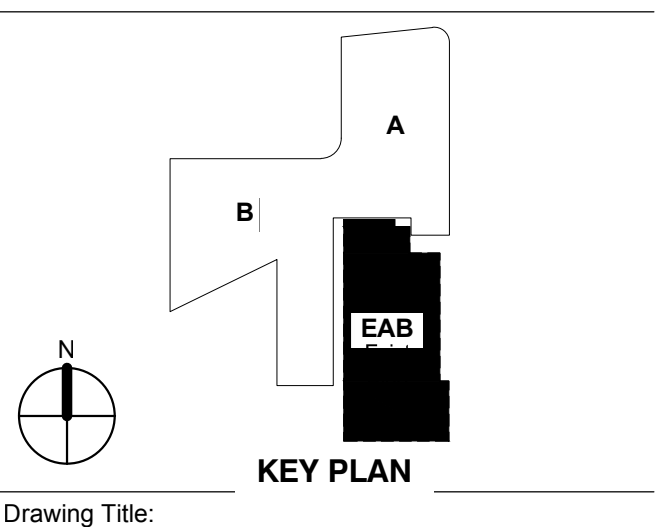


KEY PLAN

BASIN
SECTIONS


Project No.: 04561.00 Checked by:

C602


RAIN GARDEN #1 - SECTION A PROFILE

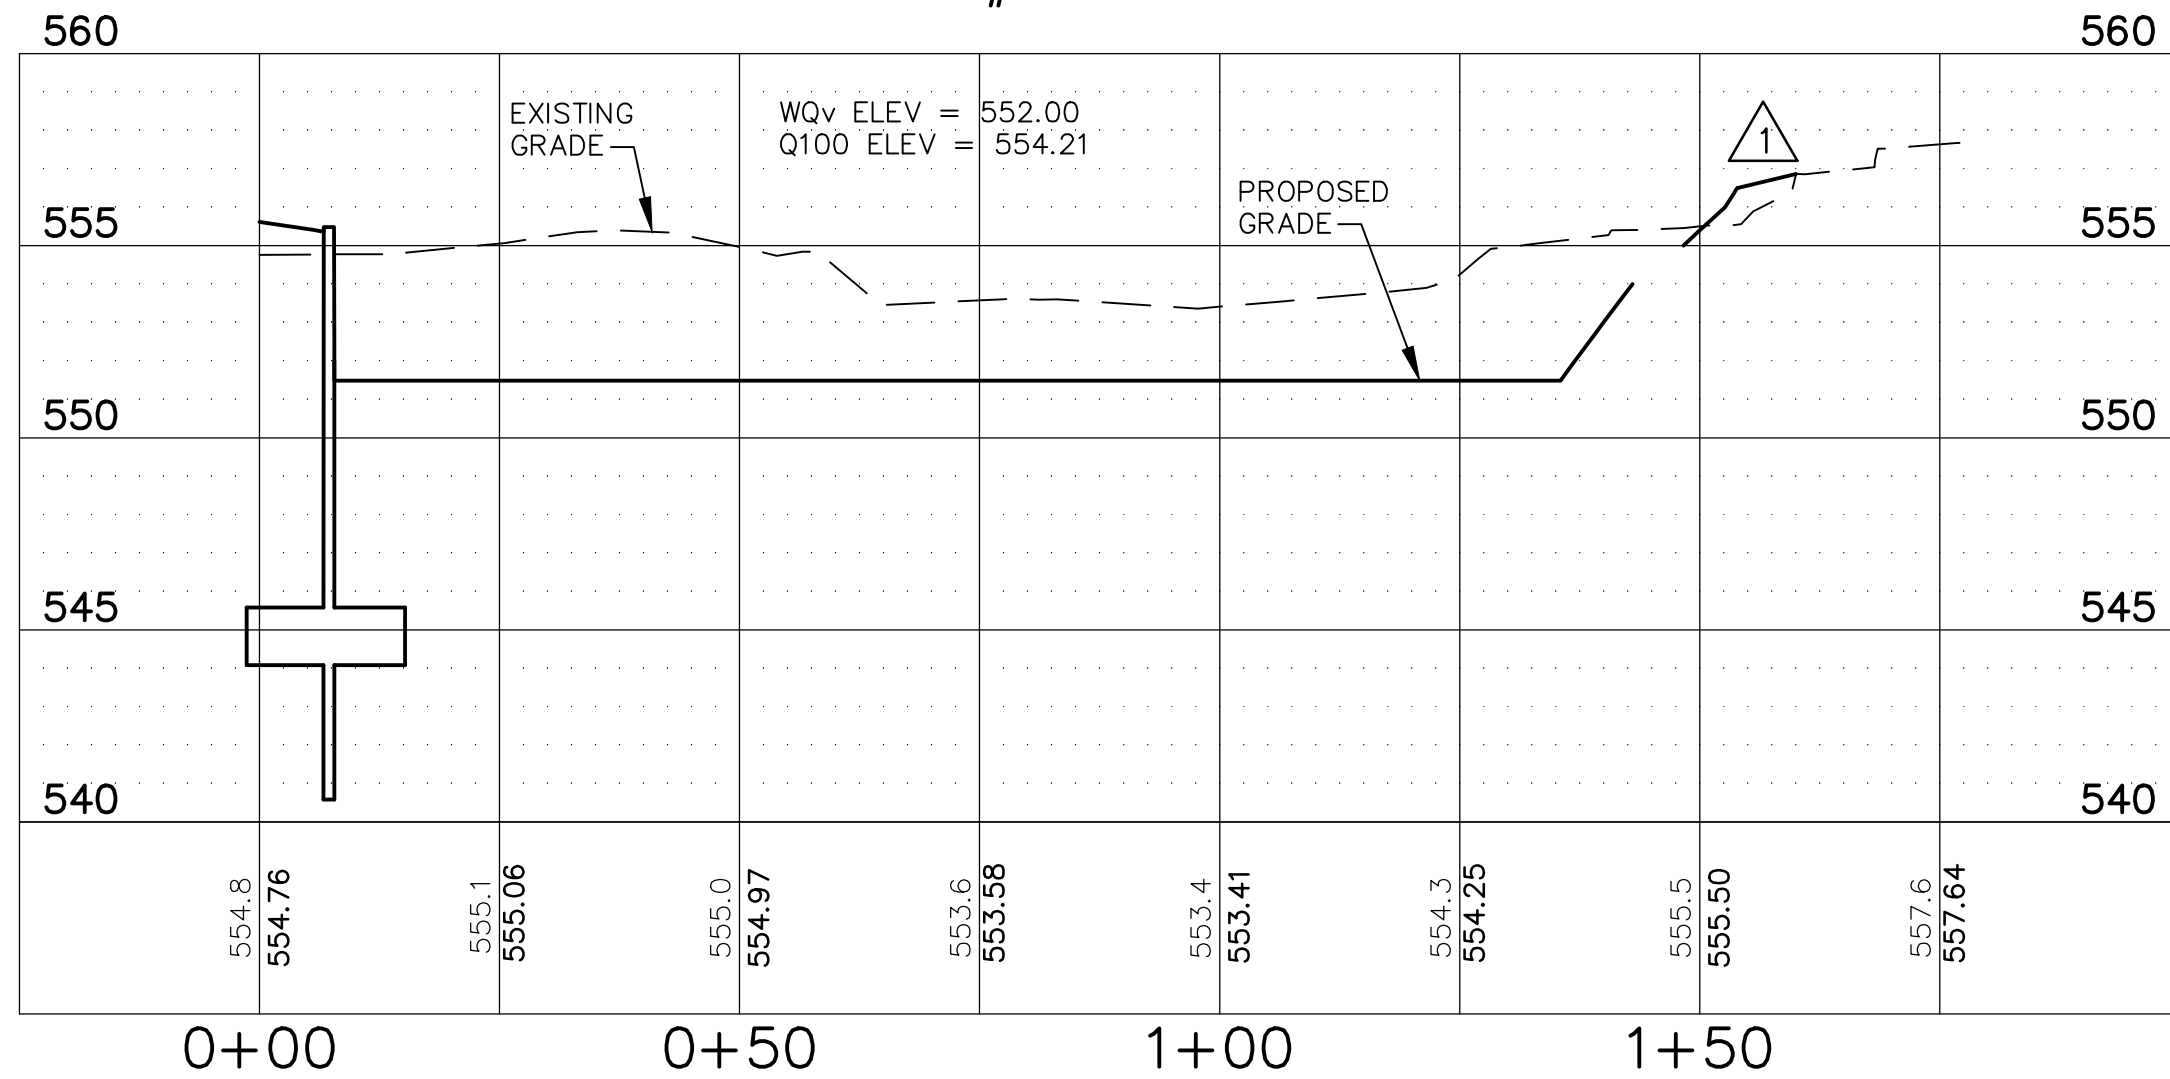


RAIN GARDEN #1 - SECTION B PROFILE

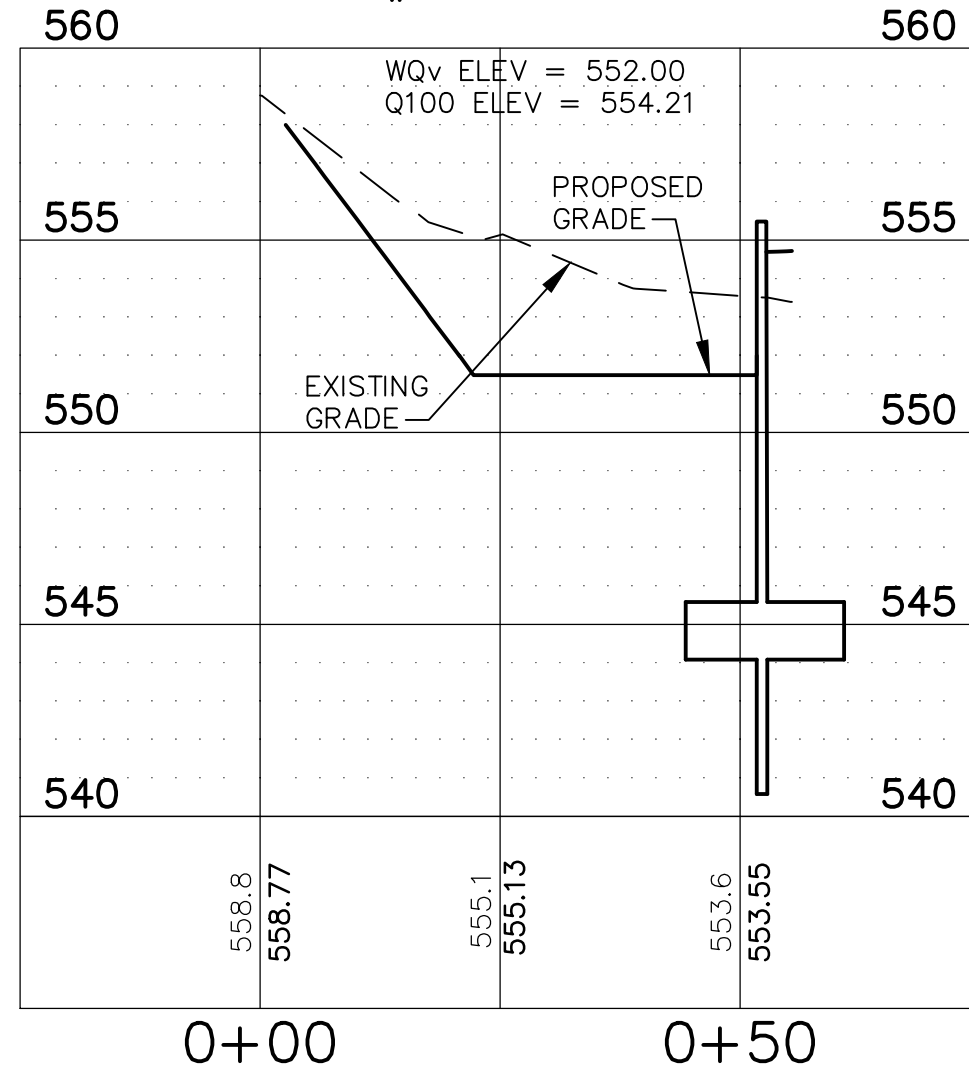


RAIN GARDEN #1 - SECTION C PROFILE

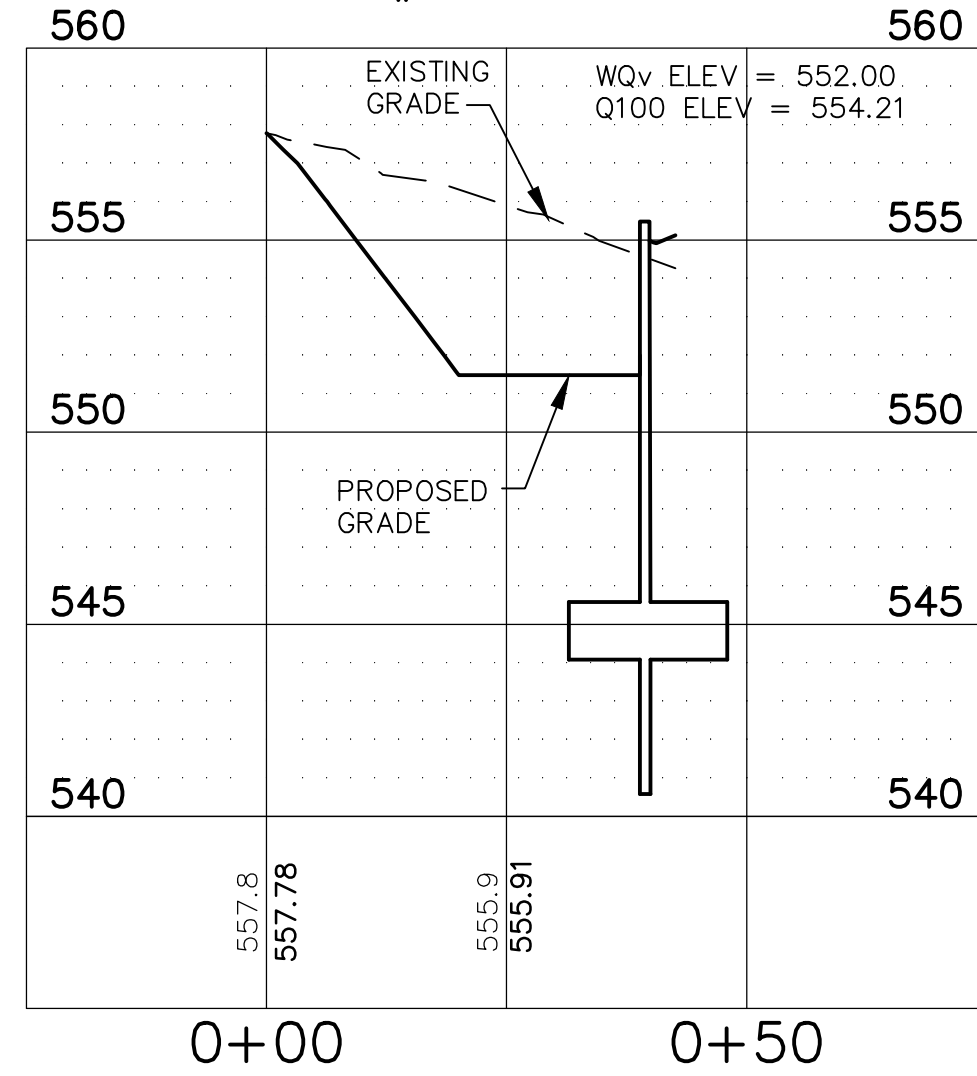


RAIN GARDEN 1 OVERFLOW WEIR PROFILE

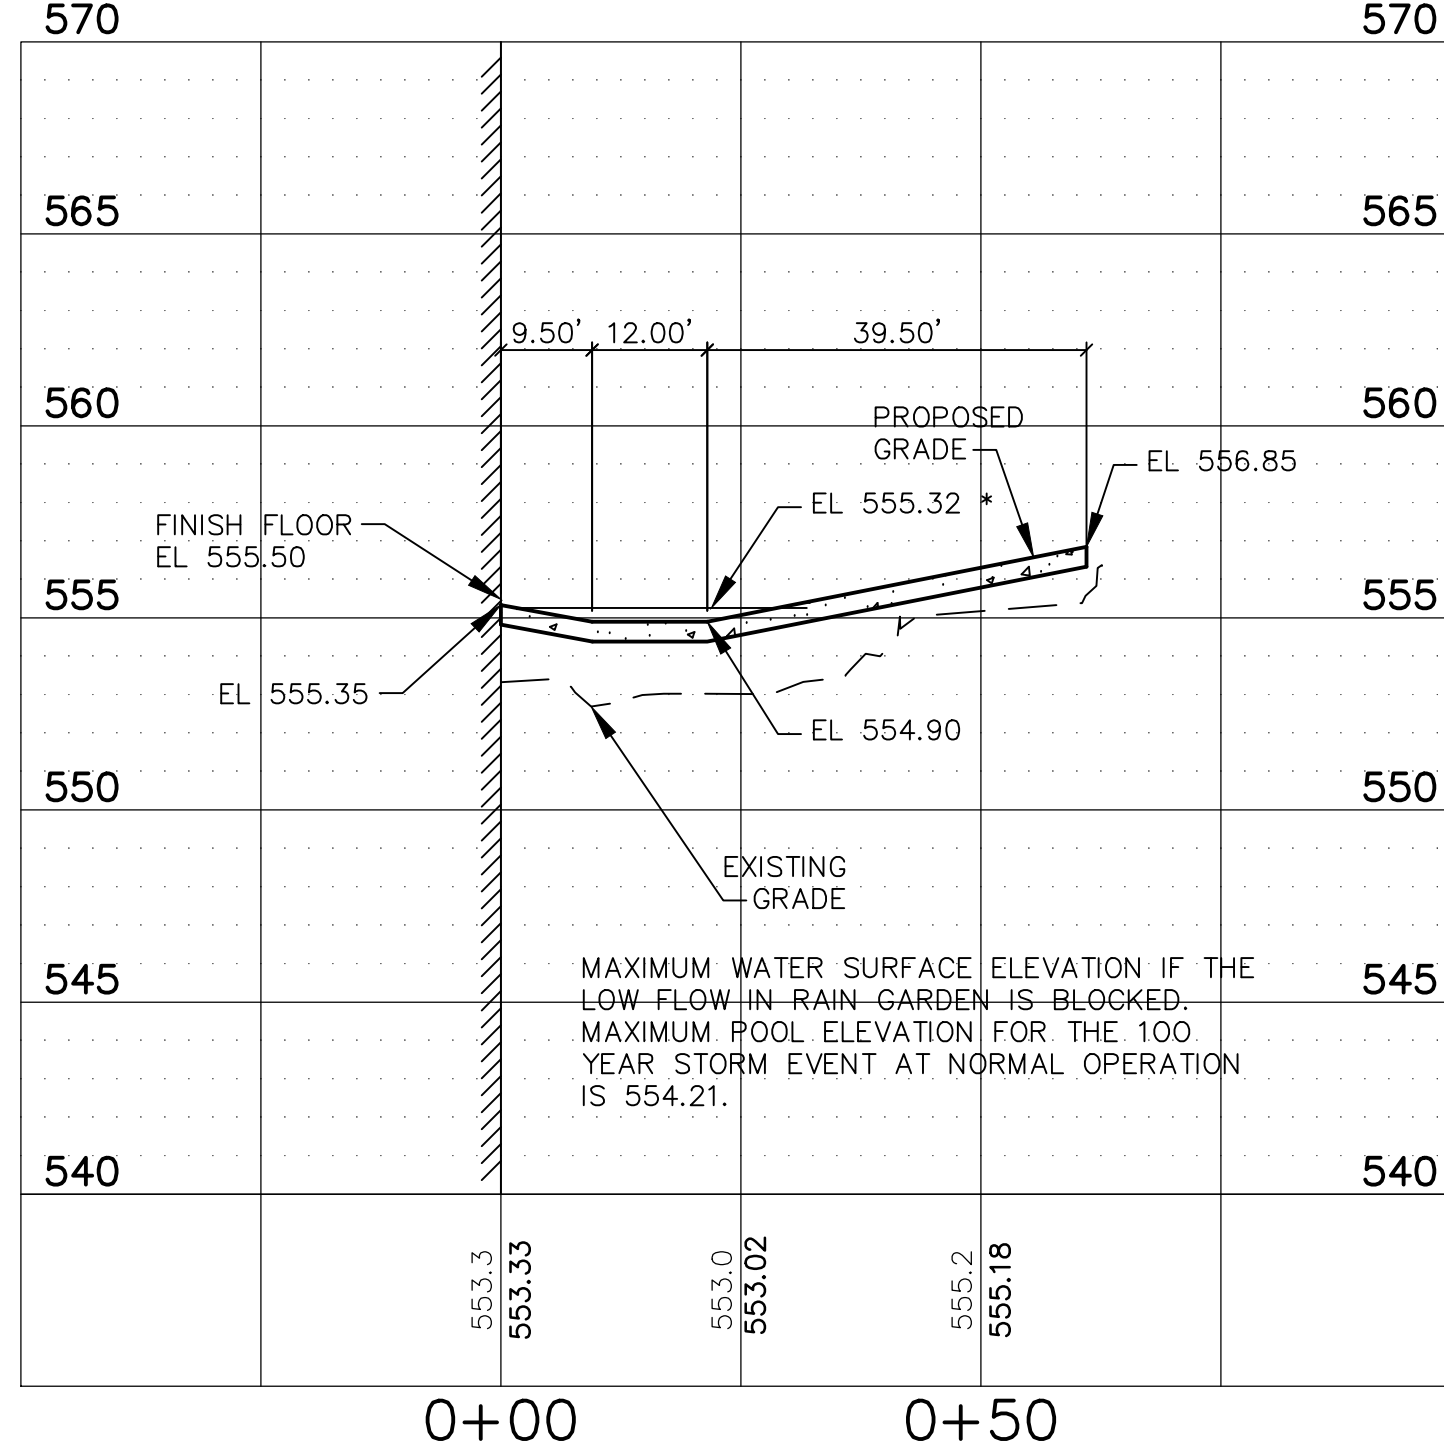


RAIN GARDEN #2 - SECTION A PROFILE

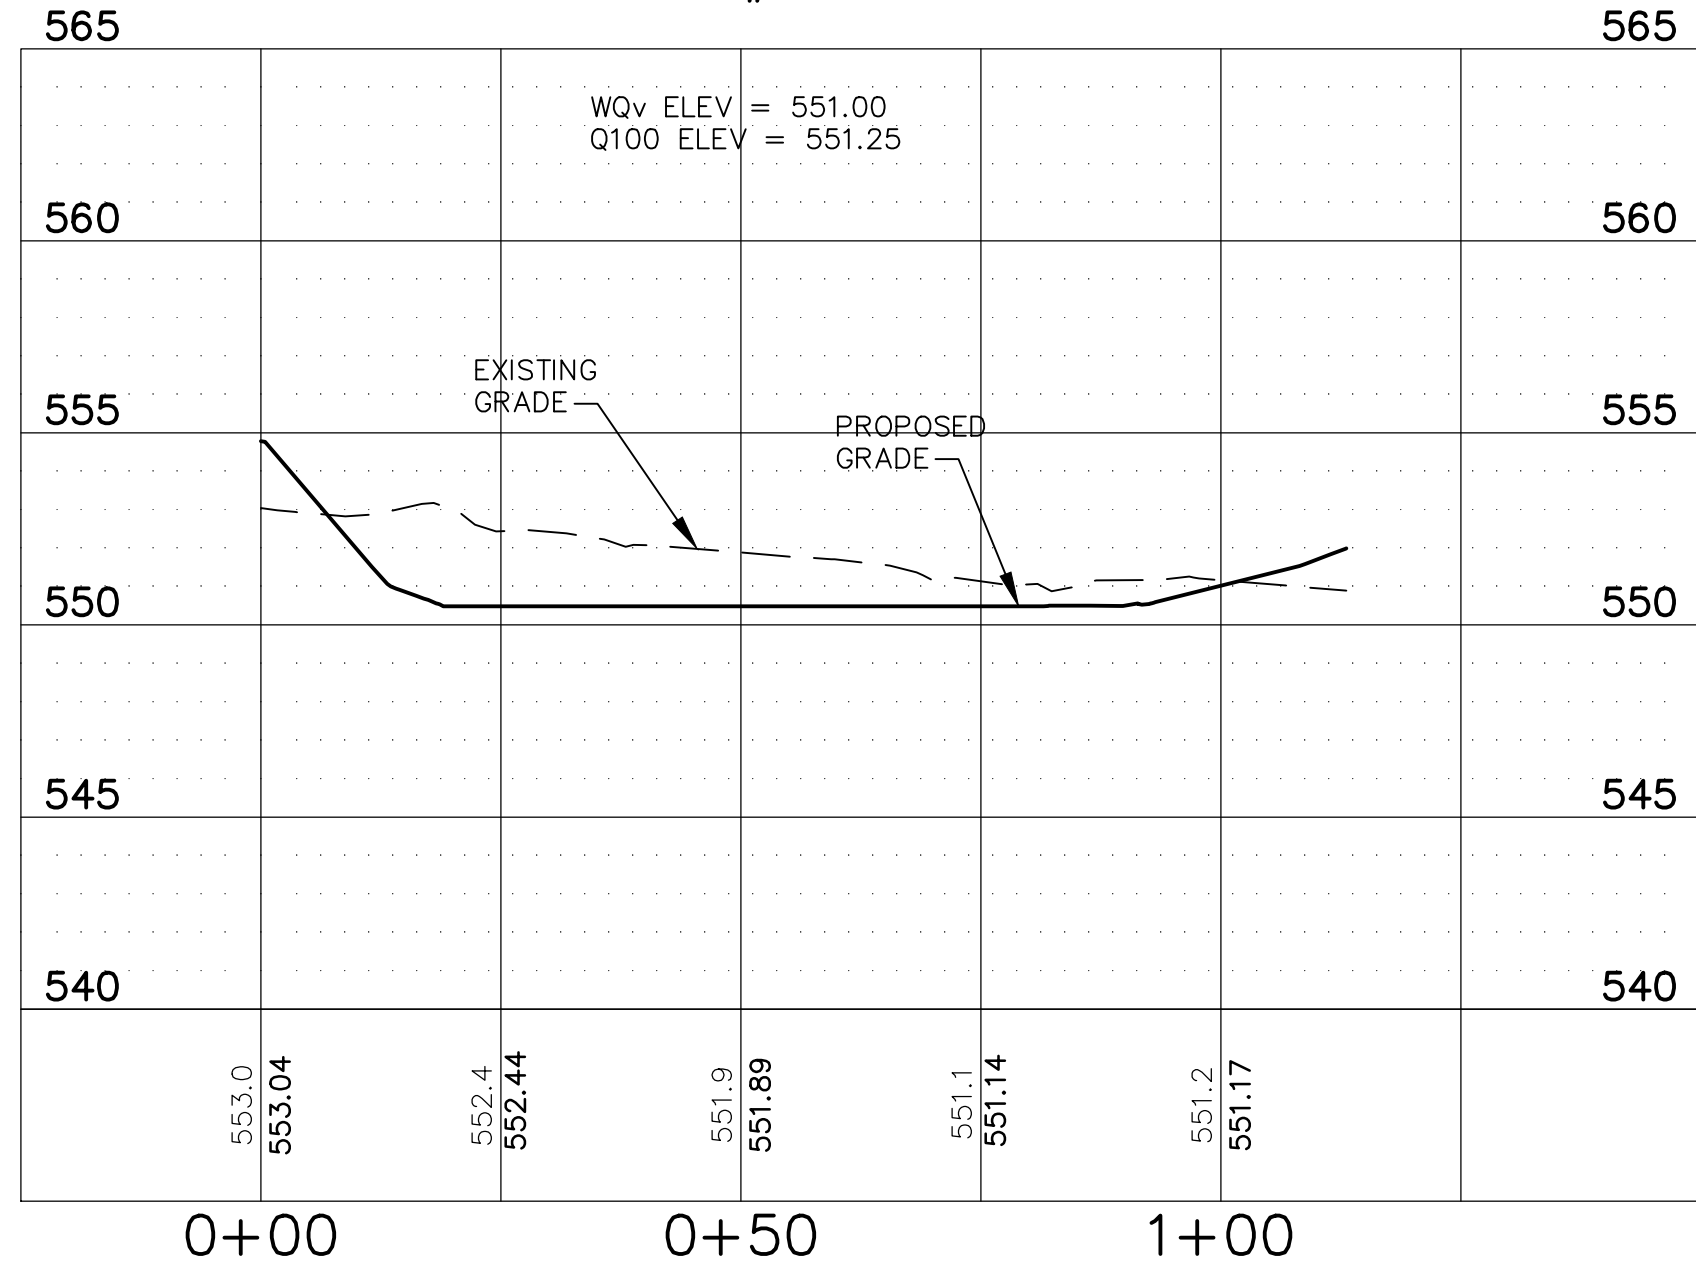



RAIN GARDEN #2 - SECTION B PROFILE

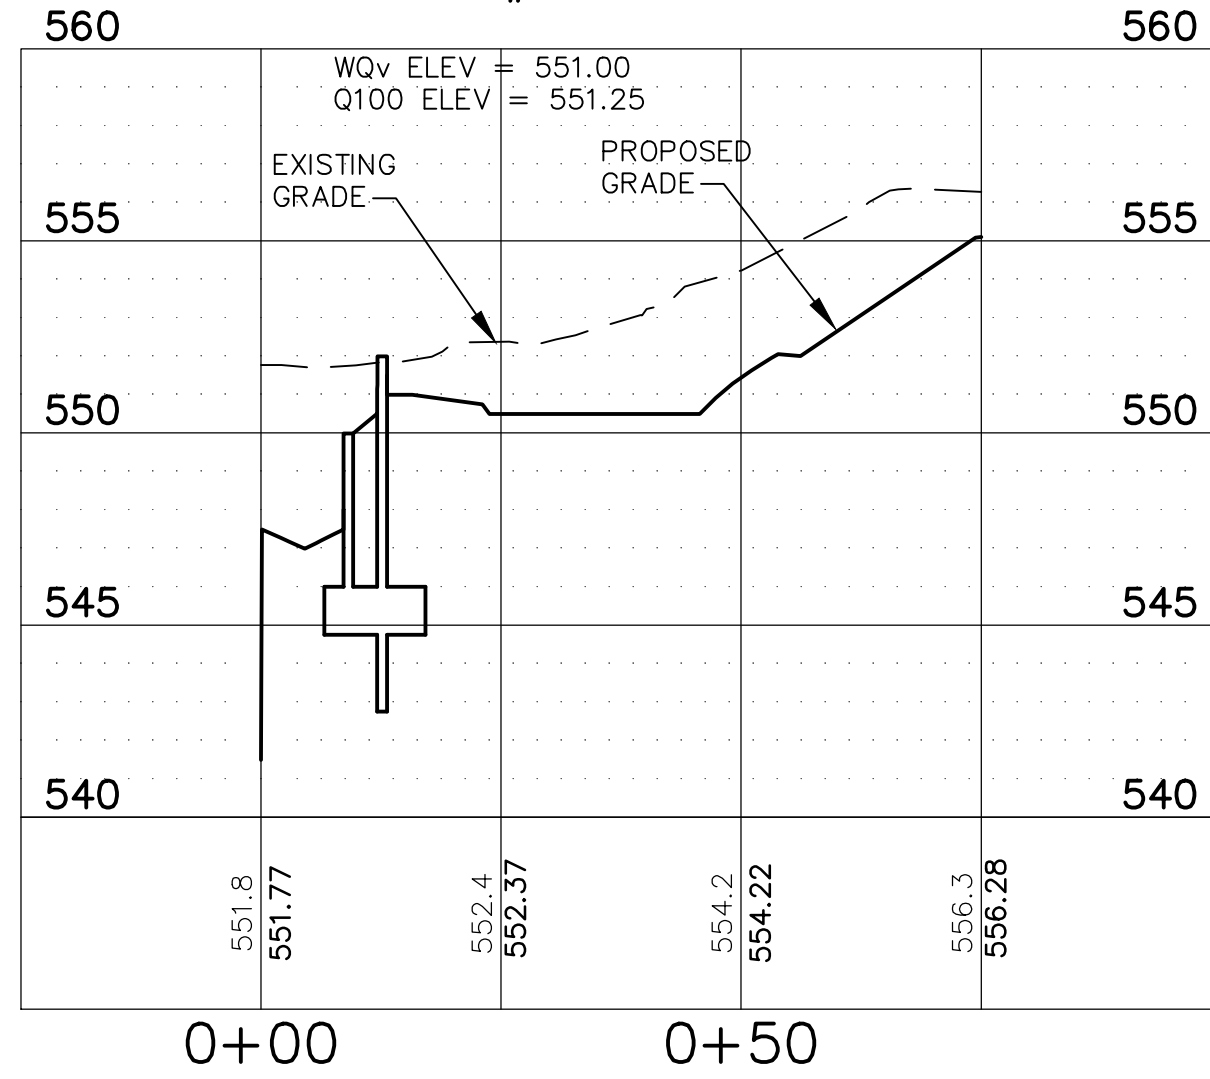

RAIN GARDEN #2 - SECTION C PROFILE



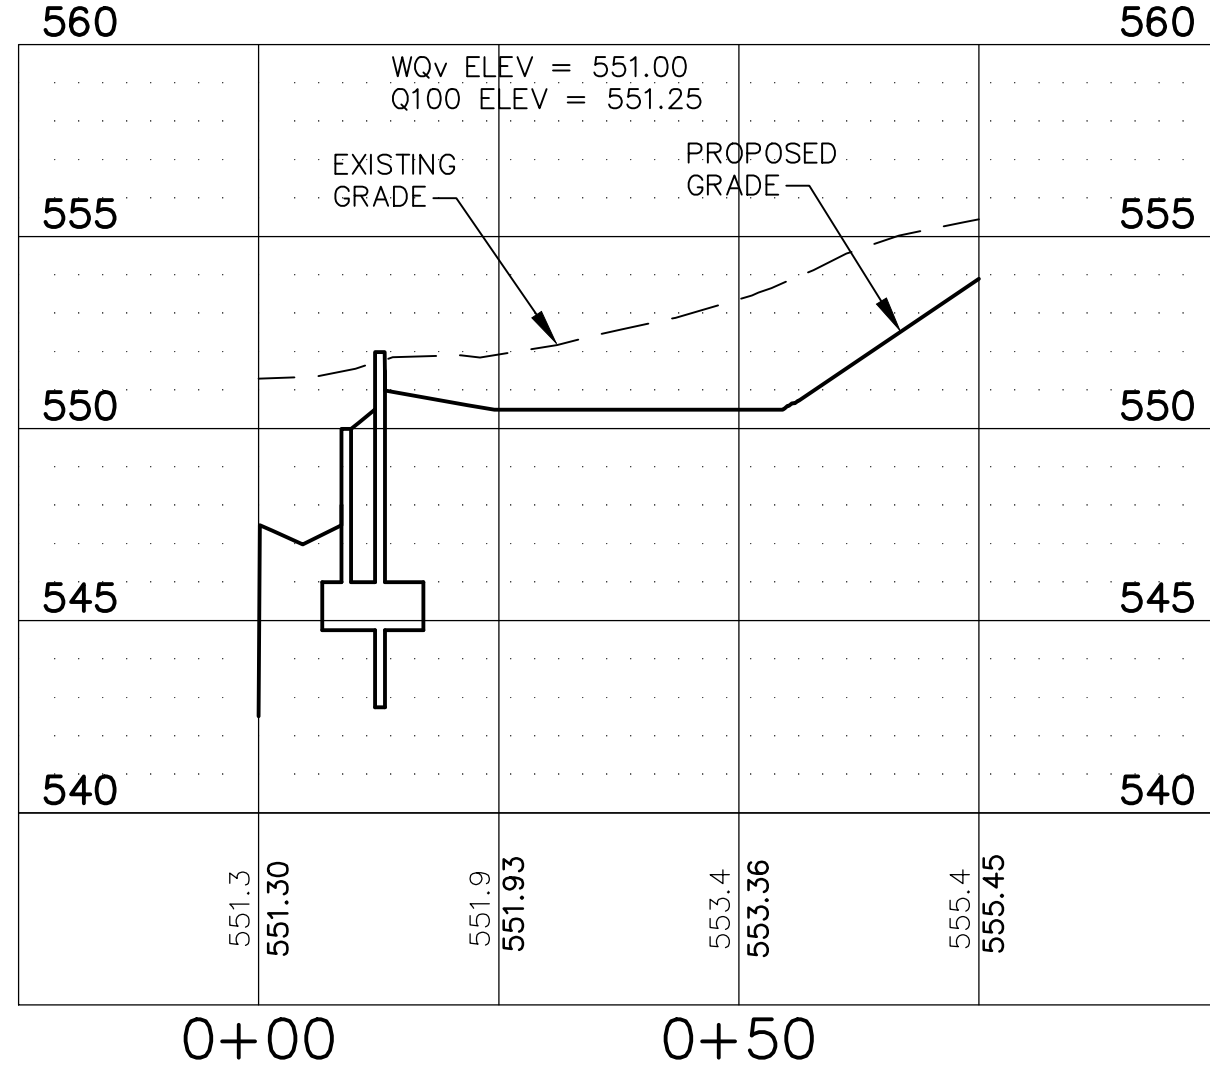


RAIN GARDEN #2 - SECTION D PROFILE

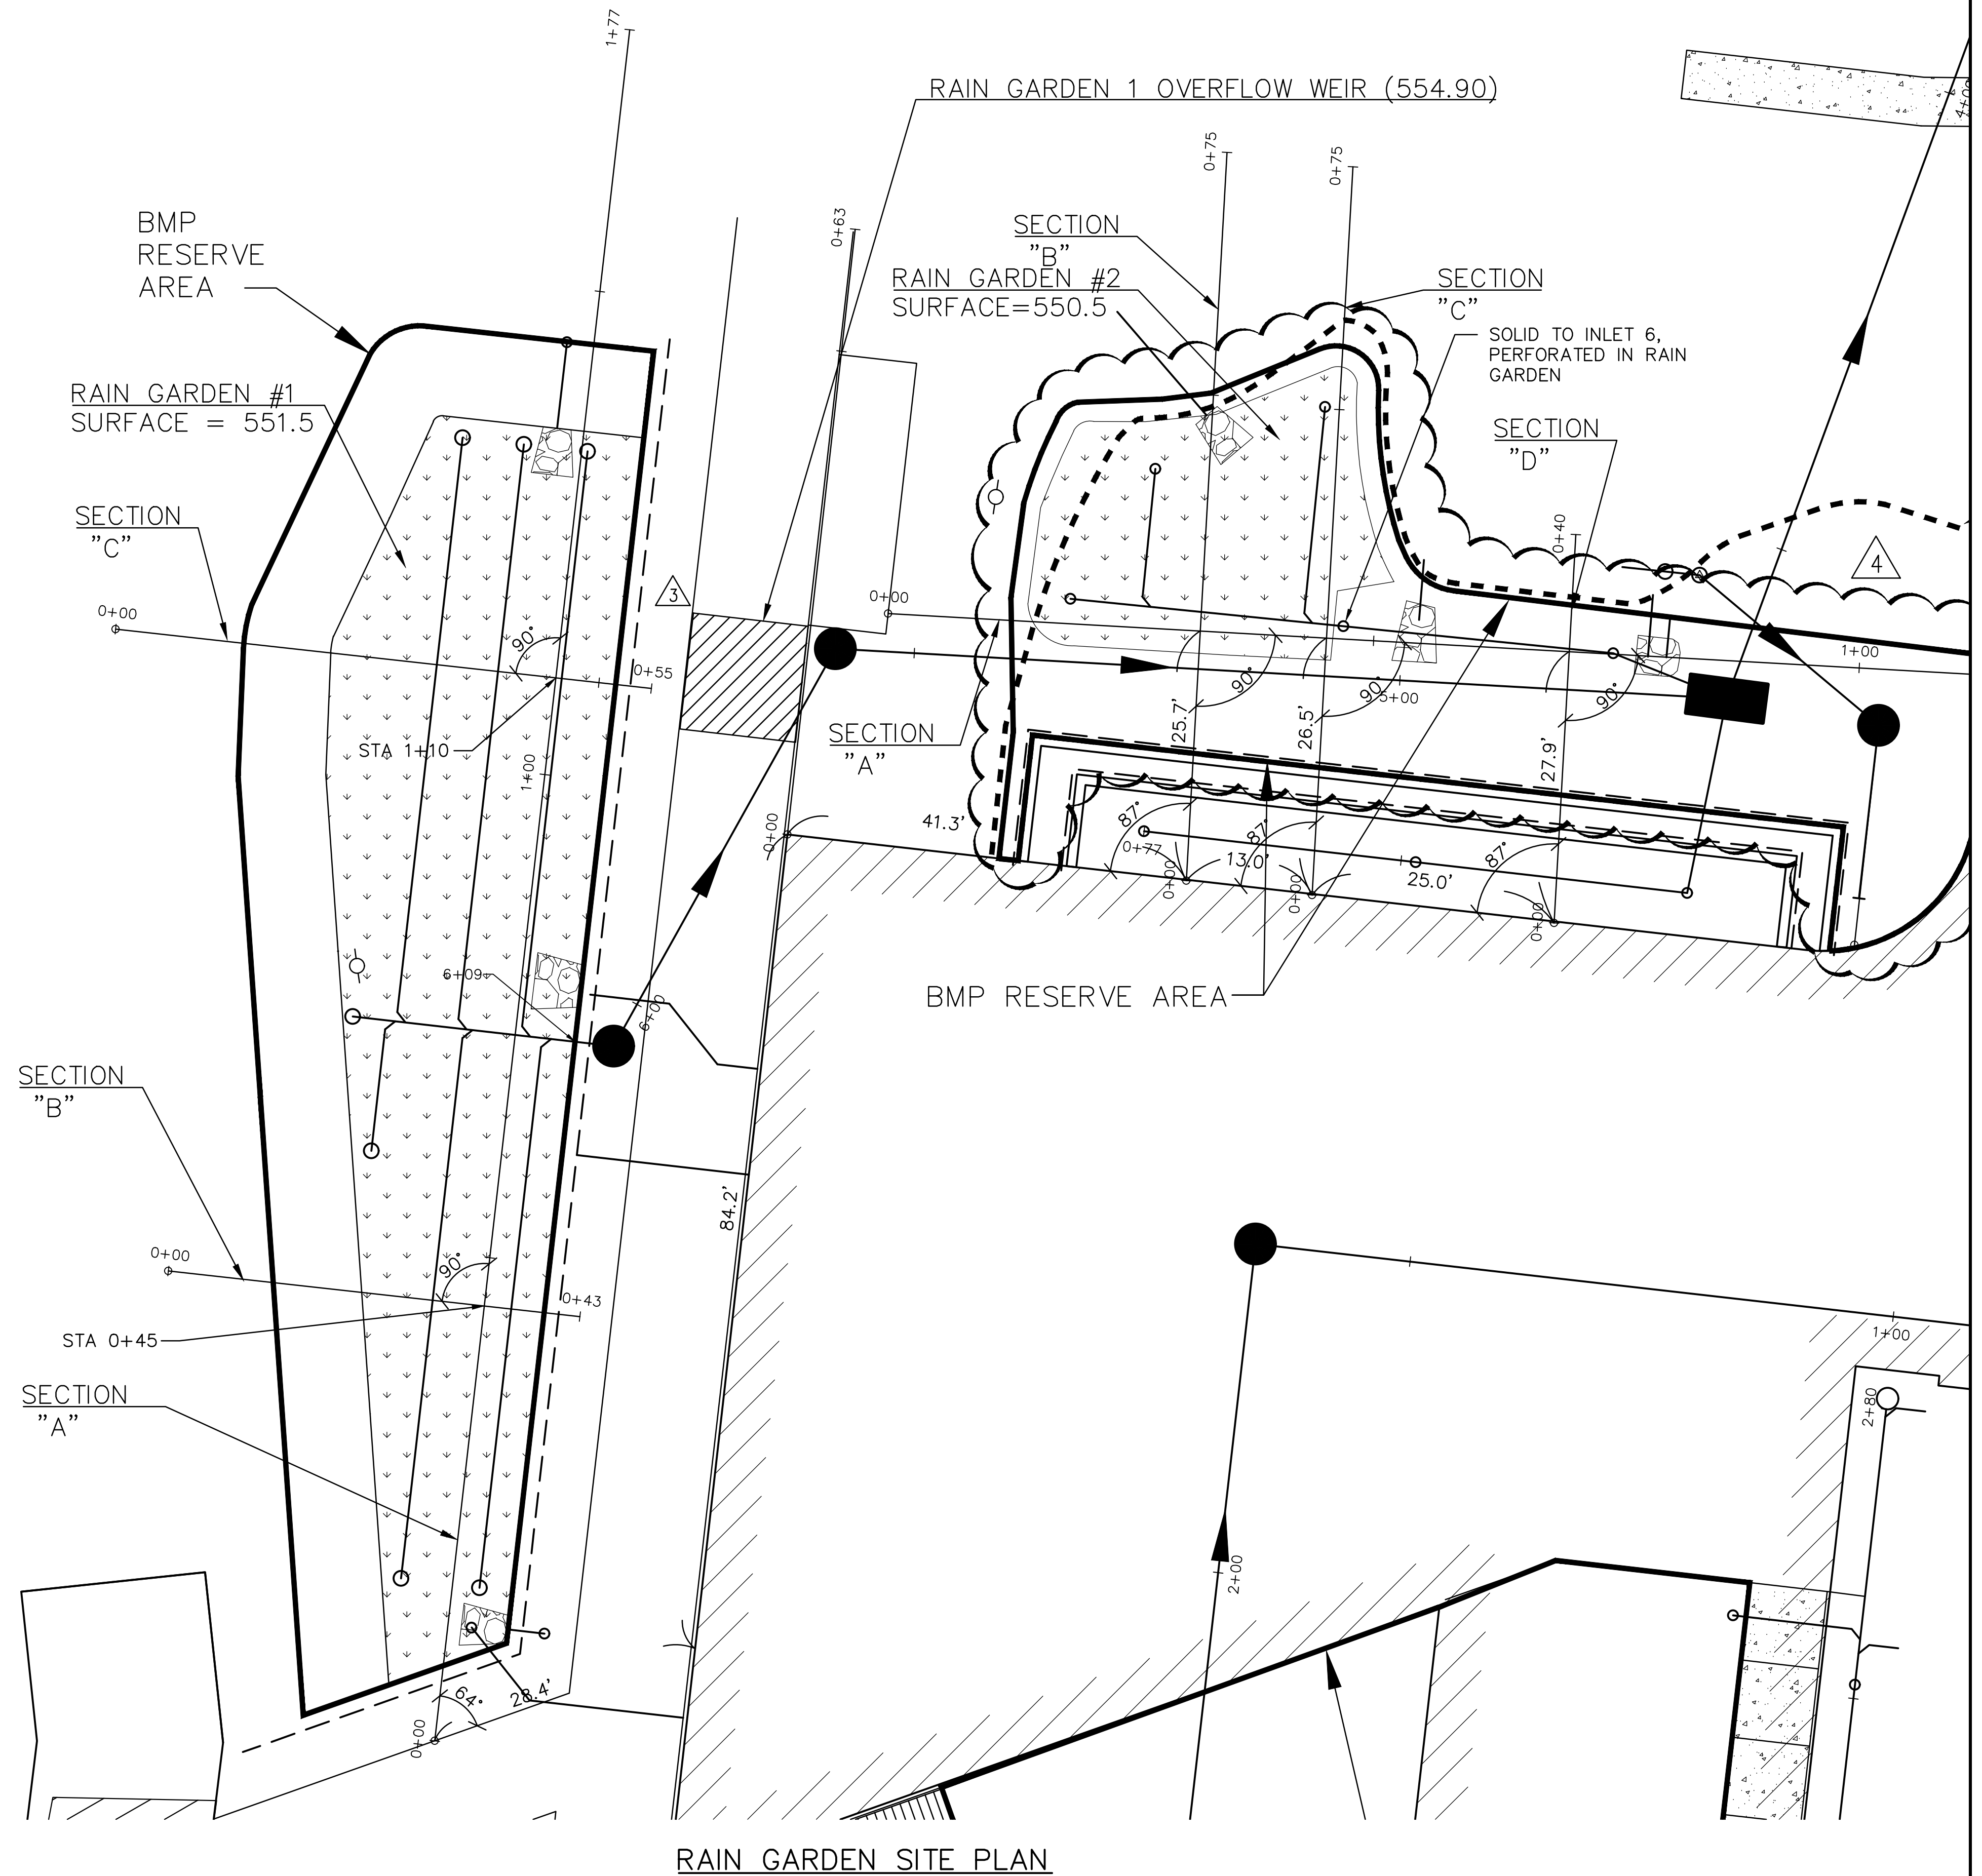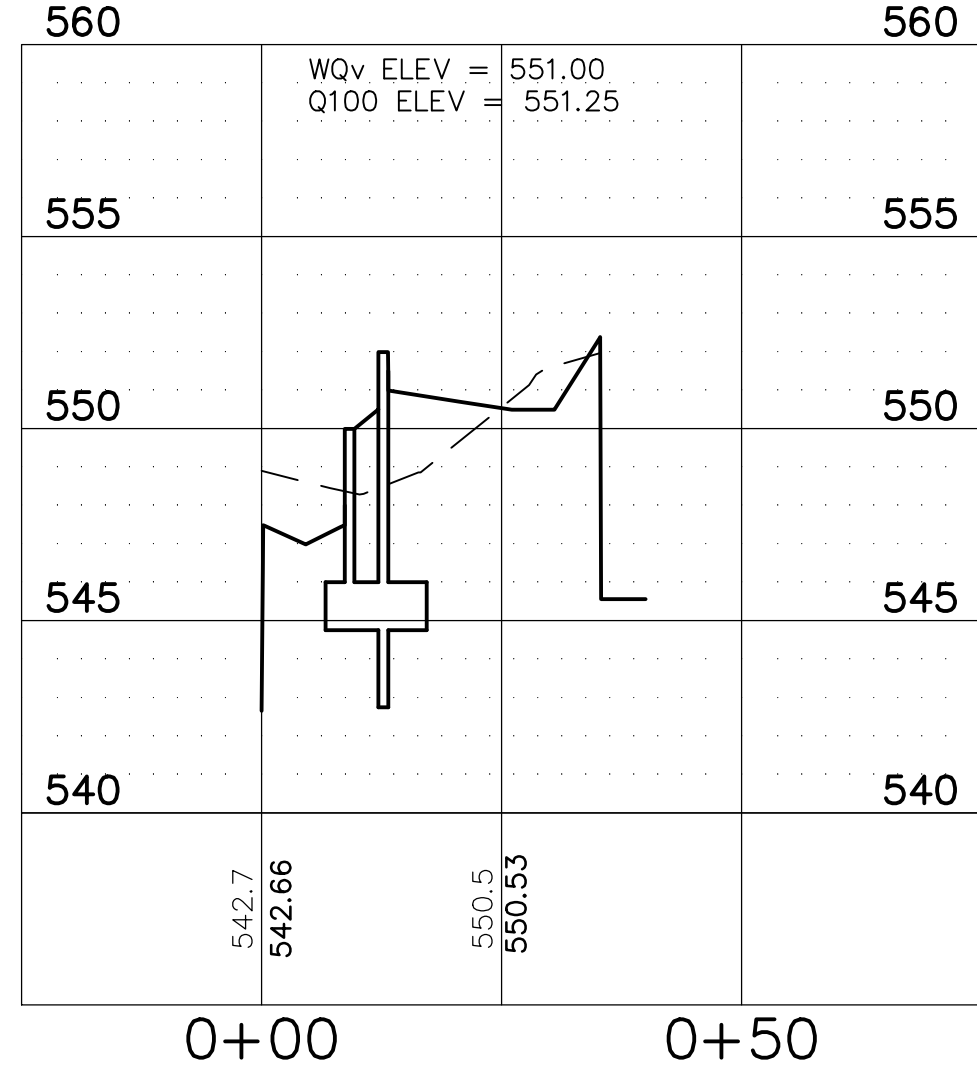

RAIN GARDEN SITE PLAN

NOTE:
CONTRACTOR TO PROVIDE SIGNED AND SEALED SHOP
DRAWINGS TO BE APPROVED BY THE PROJECT ENGINEER
AND MSD. CONTACT MSD AT 314-335-2072.

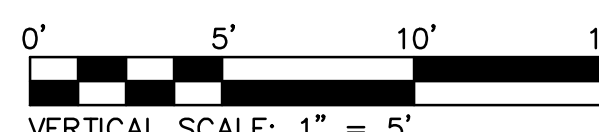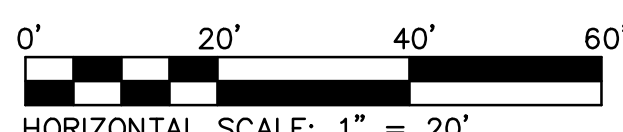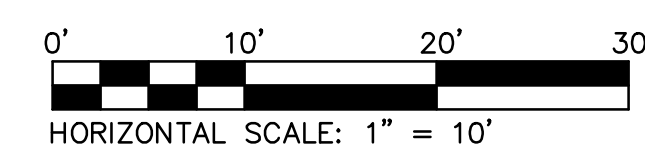

SCALES FOR PROFILES

MSD P# 28874-01 MSD BASE MAP 23K2

MSD FIELD CHANGE 1 (SHEET 3 OF 4)