


SHEET GENERAL NOTES.

1. THE CONTRACTOR SHALL FOLLOW ALL RULES AND GUIDELINES AS SET FORTH IN CHAPTER 81, LAND DISTURBANCE CODE & CHAPTER 82, STORM WATER IN THE CODE OF WEBSTER GROVES.
2. THE CONTRACTOR CAN USE THIS EROSION CONTROL PLAN AS A BASE TO IDENTIFY LAY DOWN AREAS, WASH DOWN AREAS, SEDIMENTATION BASINS, HAZARDOUS MATERIAL LOCATION AND SPILL AND CONTAINMENT PROCEDURES. THE CONTRACTOR WILL BE REQUIRED TO FOLLOW ALL GUIDELINES SET FORTH BY THE CITY OF WEBSTER GROVES, THE MISSOURI DEPARTMENT OF NATURAL RESOURCES, AND THE ENVIRONMENTAL PROTECTION AGENCY REGARDING ALL LAND DISTURBANCE ACTIVITIES.
3. ANY LAND CLEARING, CONSTRUCTION, OR DEVELOPMENT INVOLVING THE MOVEMENT OF EARTH SHALL BE IN ACCORDANCE WITH THE STORMWATER POLLUTION PREVENTION PLAN, AND THE CONTRACTOR WILL ASSUME AND ACKNOWLEDGE RESPONSIBILITY FOR COMPLIANCE WITH THIS ARTICLE AND THE STORMWATER POLLUTION PREVENTION PLAN AT THE SITE OF THE PERMITTED ACTIVITY.
4. THE CONTRACTOR SHALL CERTIFY THAT THEY HAVE FOLLOWED THE GUIDELINES AS OUTLINED IN "THE MODEL BEST MANAGEMENT PRACTICES (BMPS) FOR LAND DISTURBANCE, SEDIMENT AND EROSION CONTROL OF ST. LOUIS COUNTY", THIS DOCUMENT SHALL BE THE GENERAL DESIGN GUIDELINES FOR ADDRESSING LAND DISTURBANCE ACTIVITIES.
5. THE PERMIT-HOLDER SHALL SIGN A "DEVELOPER AGREEMENT" ATTESTING TO THE FOLLOWING:

- NOTIFY ALL CONTRACTORS AND OTHER ENTITIES (INCLUDING UTILITY CREWS, CITY EMPLOYEES, OR THEIR AGENTS) THAT WILL PERFORM WORK AT THE SITE, OF THE EXISTENCE OF THE STORMWATER POLLUTION PREVENTION PLAN (SWPPP) AND WHAT ACTIONS OR PRECAUTIONS SHALL BE TAKEN WHILE ON SITE TO MINIMIZE THE POTENTIAL FOR EROSION AND THE POTENTIAL FOR DAMAGING ANY BEST MANAGEMENT PRACTICES (BMPS) ;

- DETERMINE THE NEED FOR AND ESTABLISH TRAINING PROGRAMS TO ENSURE THAT ALL SITE WORKERS HAVE BEEN TRAINED, AT A MINIMUM, IN EROSION CONTROL, MATERIAL HANDLING AND STORAGE, AND HOUSEKEEPING ; AND
- PROVIDE COPIES OF THE STORMWATER POLLUTION PREVENTION PLAN (SWPPP) TO ALL PARTIES WHO ARE RESPONSIBLE FOR INSTALLATION, OPERATION OR MAINTENANCE OF ANY BEST MANAGEMENT PRACTICES (BMPS) ; AND
- MAINTAIN A CURRENT COPY OF THE STORMWATER POLLUTION PREVENTION PLAN (SWPPP) ON THE SITE AT ALL TIMES.

6. PROVIDE INLET PROTECTION FOR ALL AREA DRAINS.

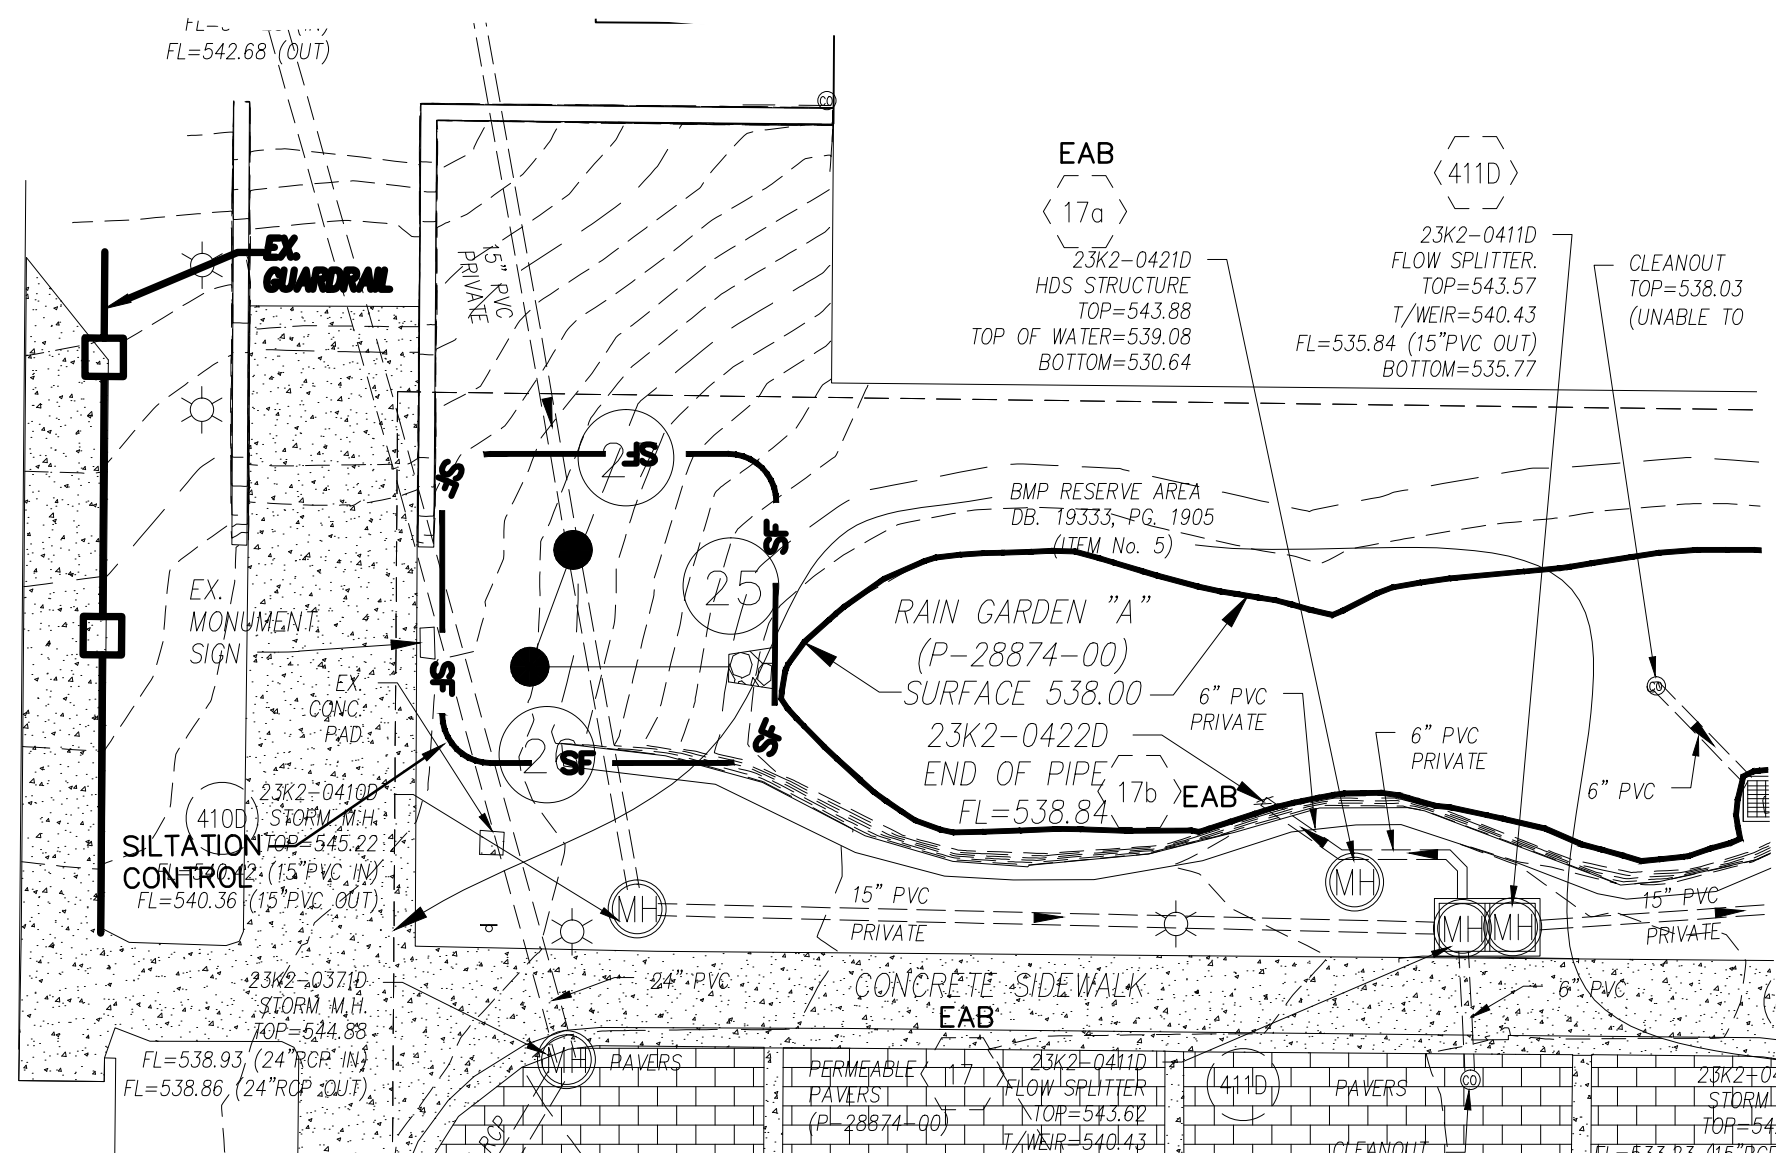

Webster University
Interdisciplinary Science Building

CANNONDESIGN

1100 Clark Avenue
St. Louis, Missouri 63102
T: 314.241.6200
F: 314.241.2570

William Tao & Associates, Inc.
ME/PE/PP Engineer
7955 Manchester Road, Suite 125
St. Louis, MO 63143
314-884-7600

David Mason & Associates, Inc.
Structural & Civil Engineer
MO Civil Cert of Authority # 003103
800 South Vandeventer Avenue
St. Louis, MO 63110
314.534.1053

Faith Group Technology
3101 S. Hanley Rd., Suite 100
St. Louis, MO 63143
314.991.2228

Kuhlmann Leavitt, Inc.
Environmental Graphics & Signage
7400 Pershing Ave.
St. Louis, MO 63130
314.725.6616

KWA Architects
Architecture
9721 Lezinger Road
St. Louis, MO 63124
314.962.2560


Spellman Brady & Company
Interior Designer
8251 Maryland Avenue, Suite 300
St. Louis, MO 63105
314.862.0070

SWT Design
Landscape Architect
7722 Big Bend Blvd
St. Louis, MO 63119
314.544.5700

Webb Engineering Services, Inc.
Planning & Fire Protection
1400 S. 3rd Street, Suite 201
St. Louis, MO 63104
314.588.0600



3	ADDENDUM 1-10	5 MAY 2016
2	ADDENDUM 1-5	09 FEB 2016
1	ADDENDUM 1-1	29 JAN 2016
ISSUED FOR CONSTRUCTION (BPI)		15 JAN 2016
No.	Description	Date

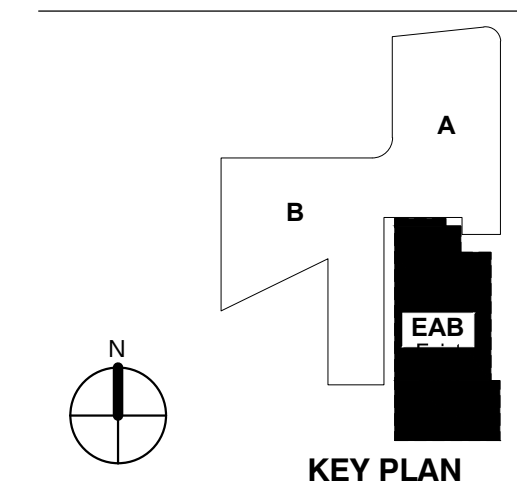

Drawing Title:

FINAL STORMWATER POLLUTION PREVENTION PLAN

Project No.: 04561.00 Checked by:

C805

MSD P# 28874-01 MSD BASE MAP 23K2