

Sign Locations by Floor:

L1

LOCATION KEY:

EG1 111

EG1 = environmental graphic type
111 = sign location

COLOR KEY:

EG1 = Multi-Level Feature Wall
EG2 = Film On Glass / Semi Private
EG3 = Film On Glass / Private
EG4= Vinyl Gorlok



Sign Locations by Floor:

L2


LOCATION KEY:

EG1 214

EG1 = environmental graphic type
214 = sign location

COLOR KEY:

EG1 = Multi-Level Feature Wall
EG2 = Film On Glass / Semi Private
EG3 = Film On Glass / Private
EG4= Vinyl Gorlok

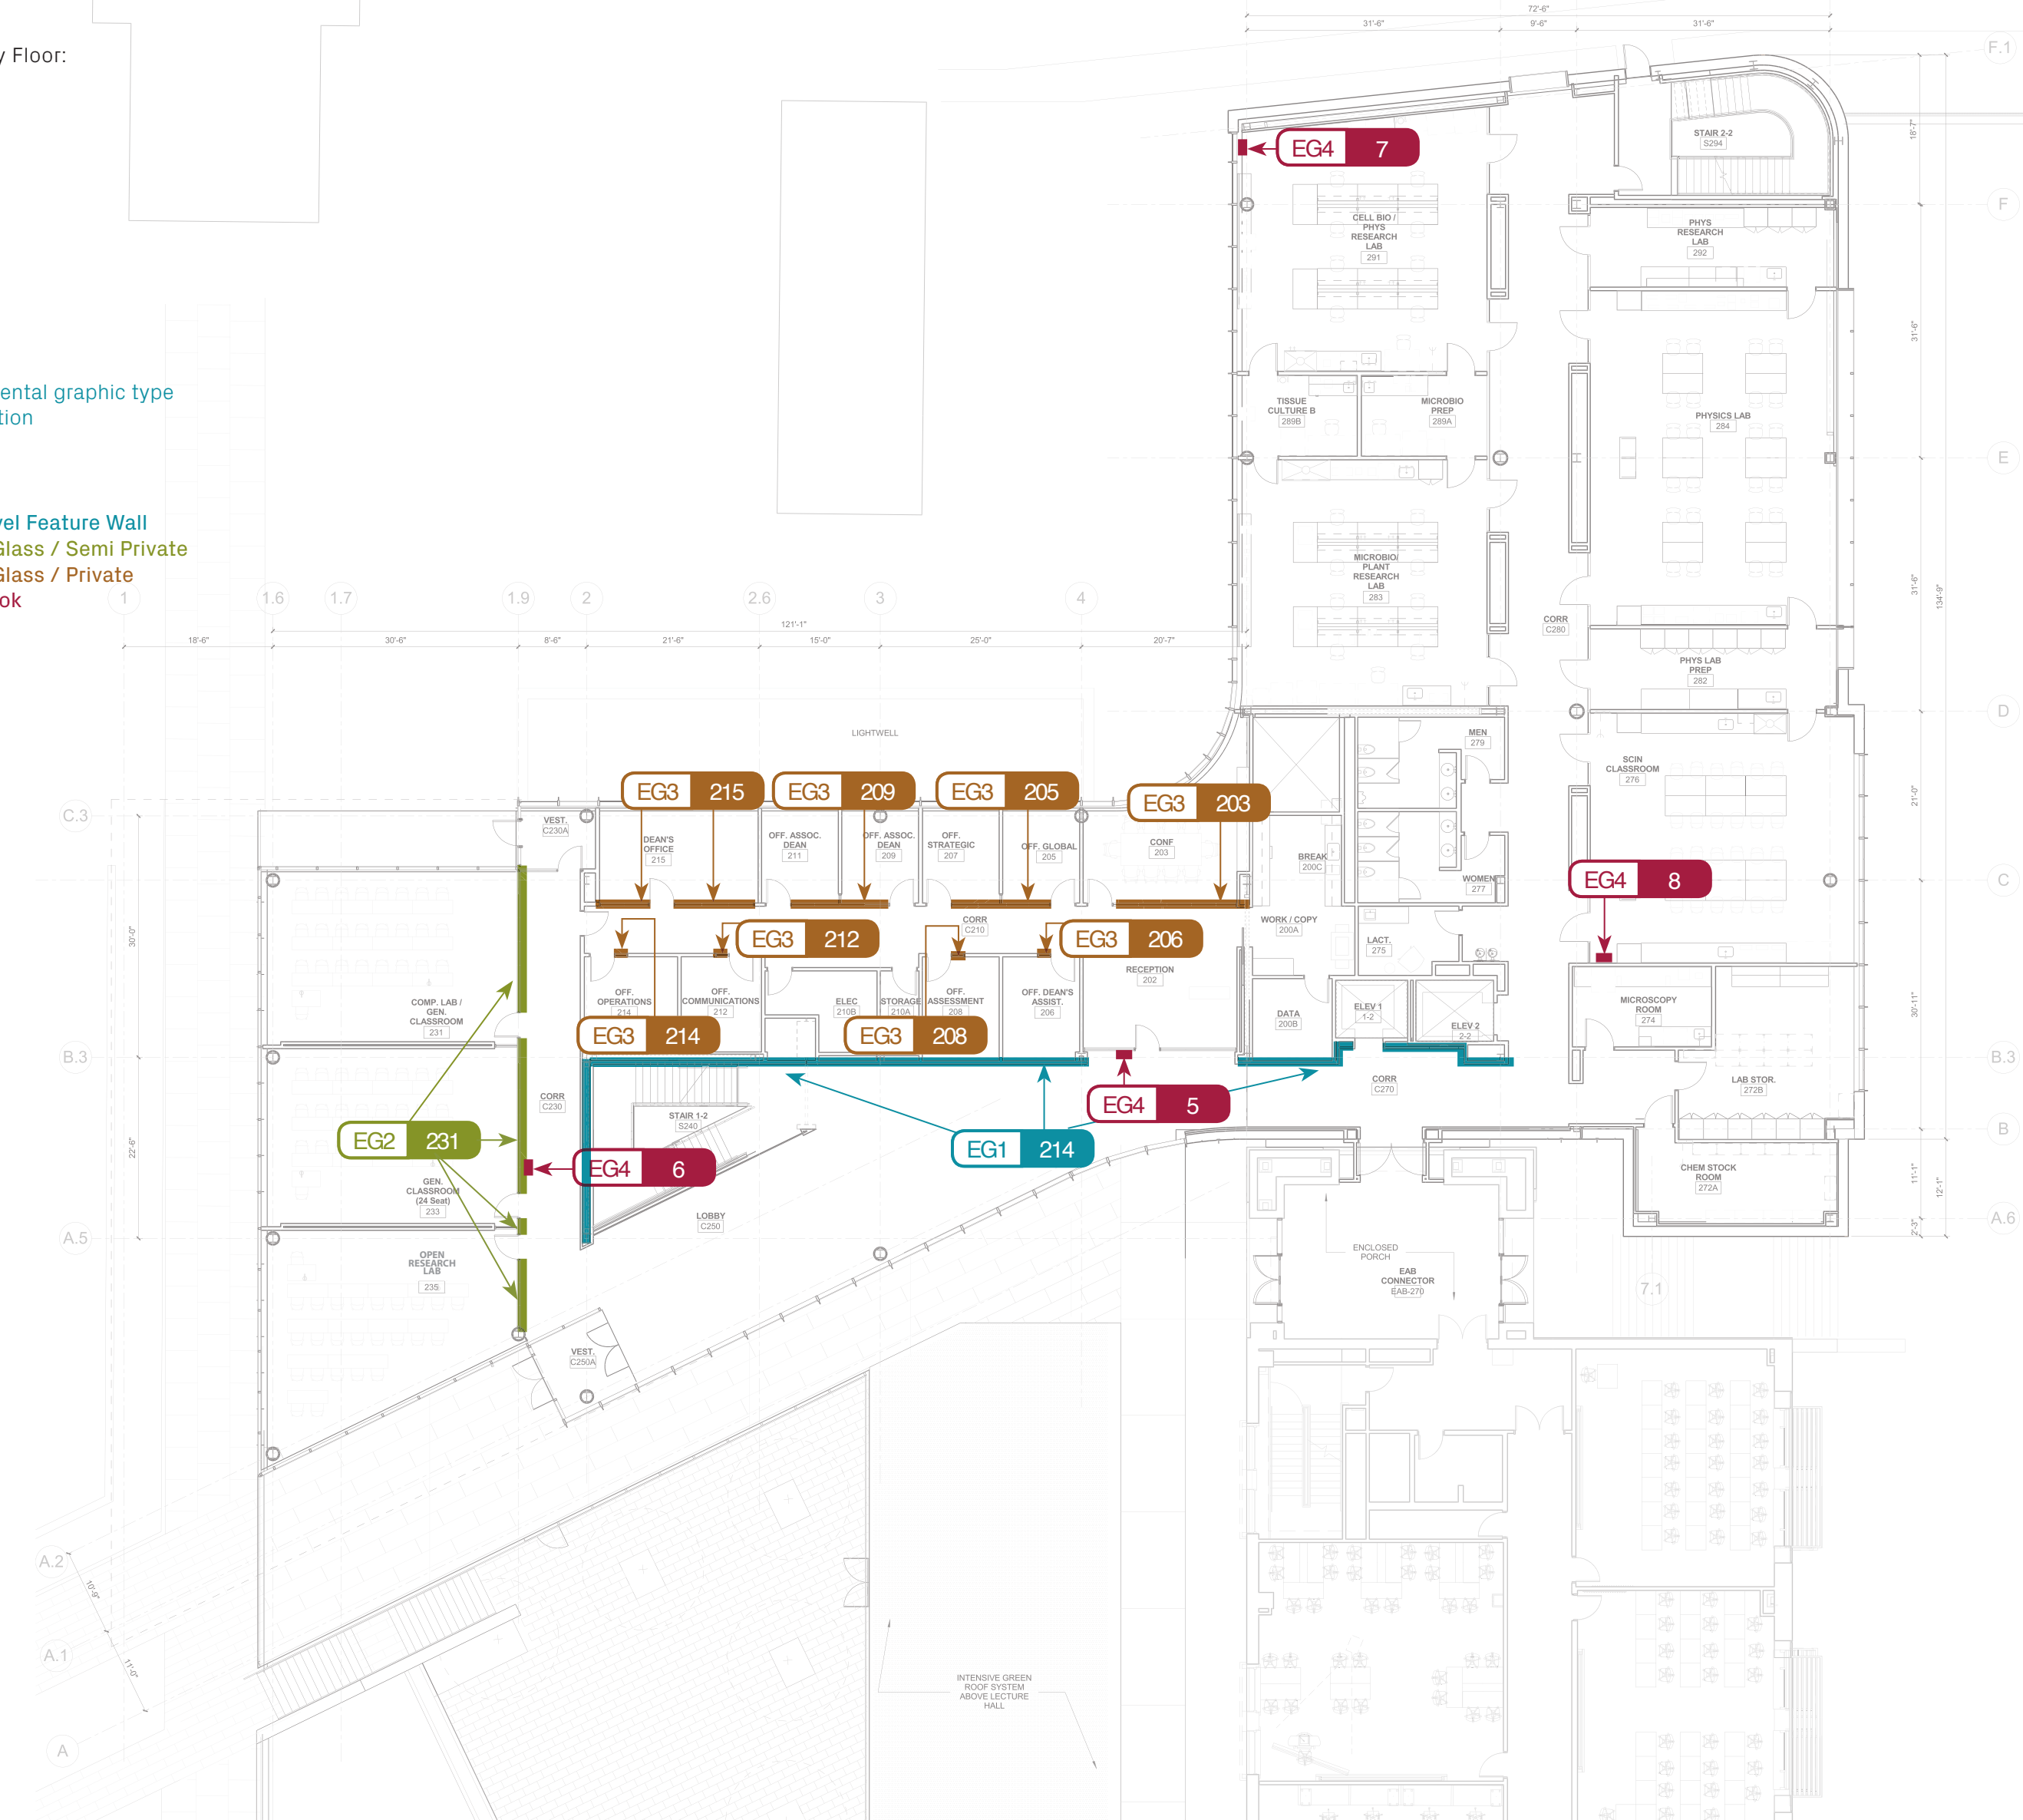

Sign Locations by Floor:

L3


LOCATION KEY:

EG1 303

EG1 = environmental graphic type
303 = sign location

COLOR KEY:

EG1 = Multi-Level Feature Wall
EG2 = Film On Glass / Semi Private
EG3 = Film On Glass / Private
EG4= Vinyl Gorlok

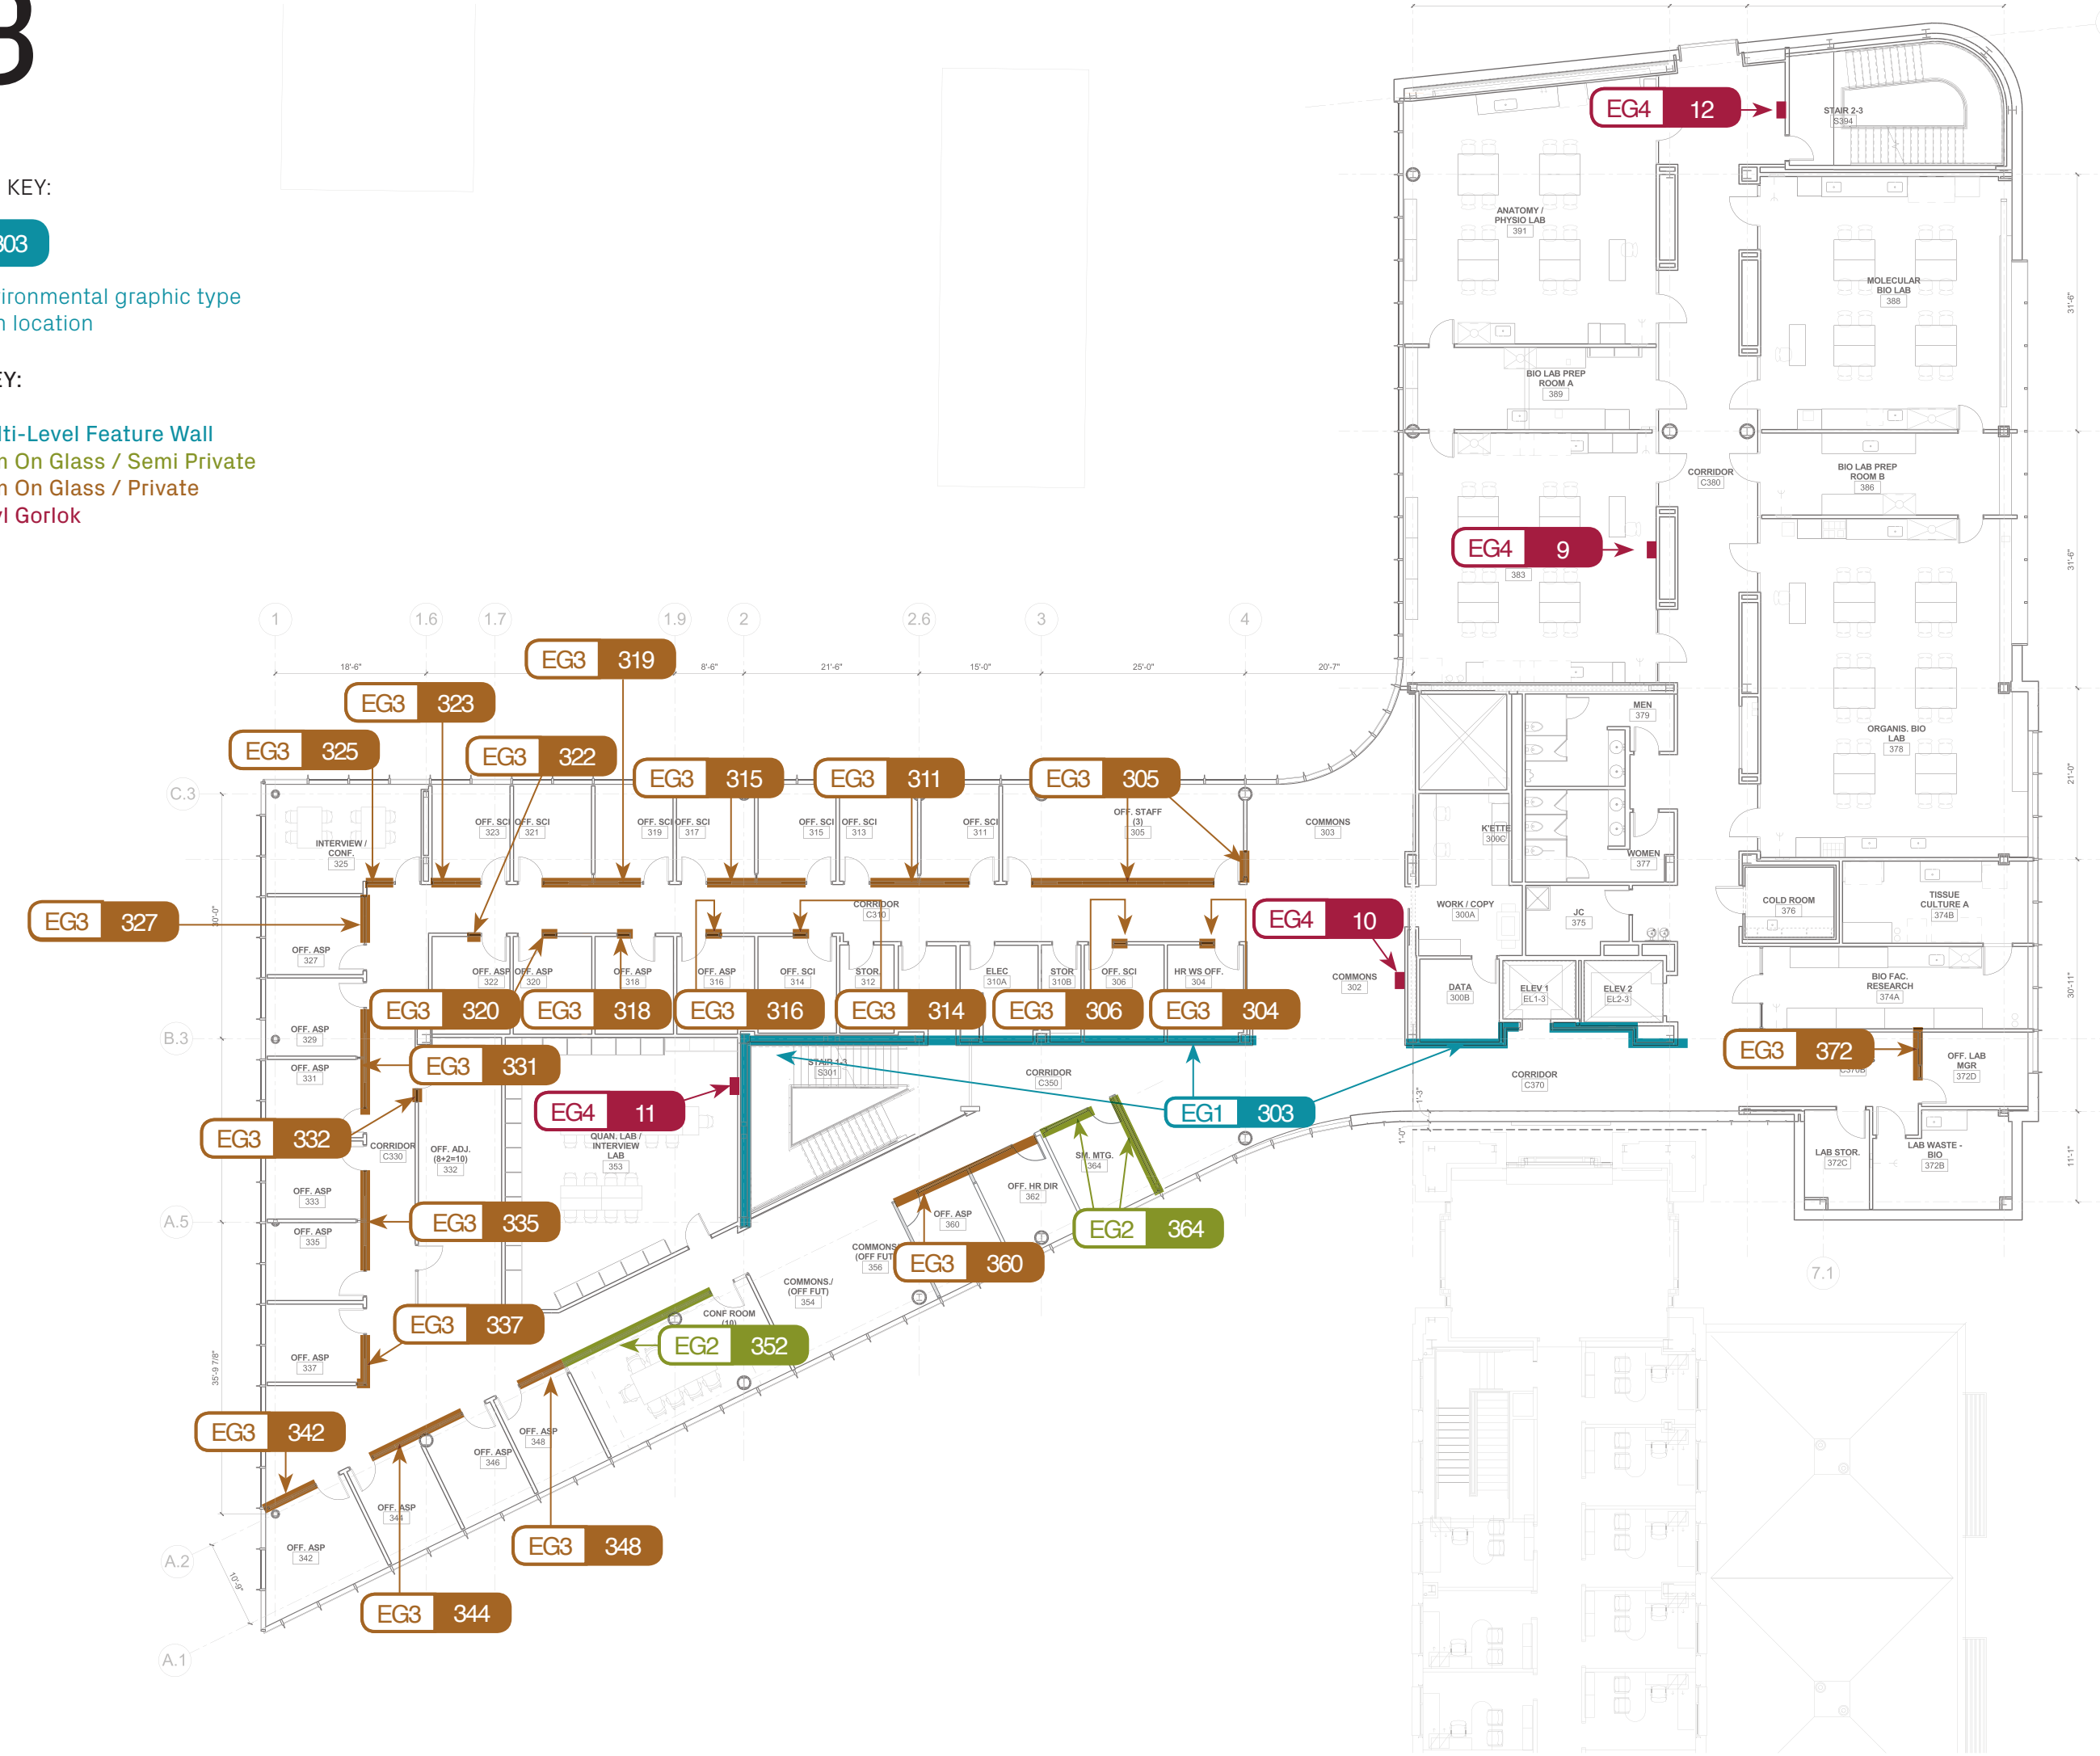

Sign Locations by Floor:

L4

LOCATION KEY:

EG1 409

EG1 = environmental graphic type
409 = sign location

COLOR KEY:

EG1 = Multi-Level Feature Wall
EG2 = Film On Glass / Semi Private
EG3 = Film On Glass / Private
EG4= Vinyl Gorlok

