


Environmental Graphic Type:

EG1

EG1-Overall Multi-Level Feature Wall

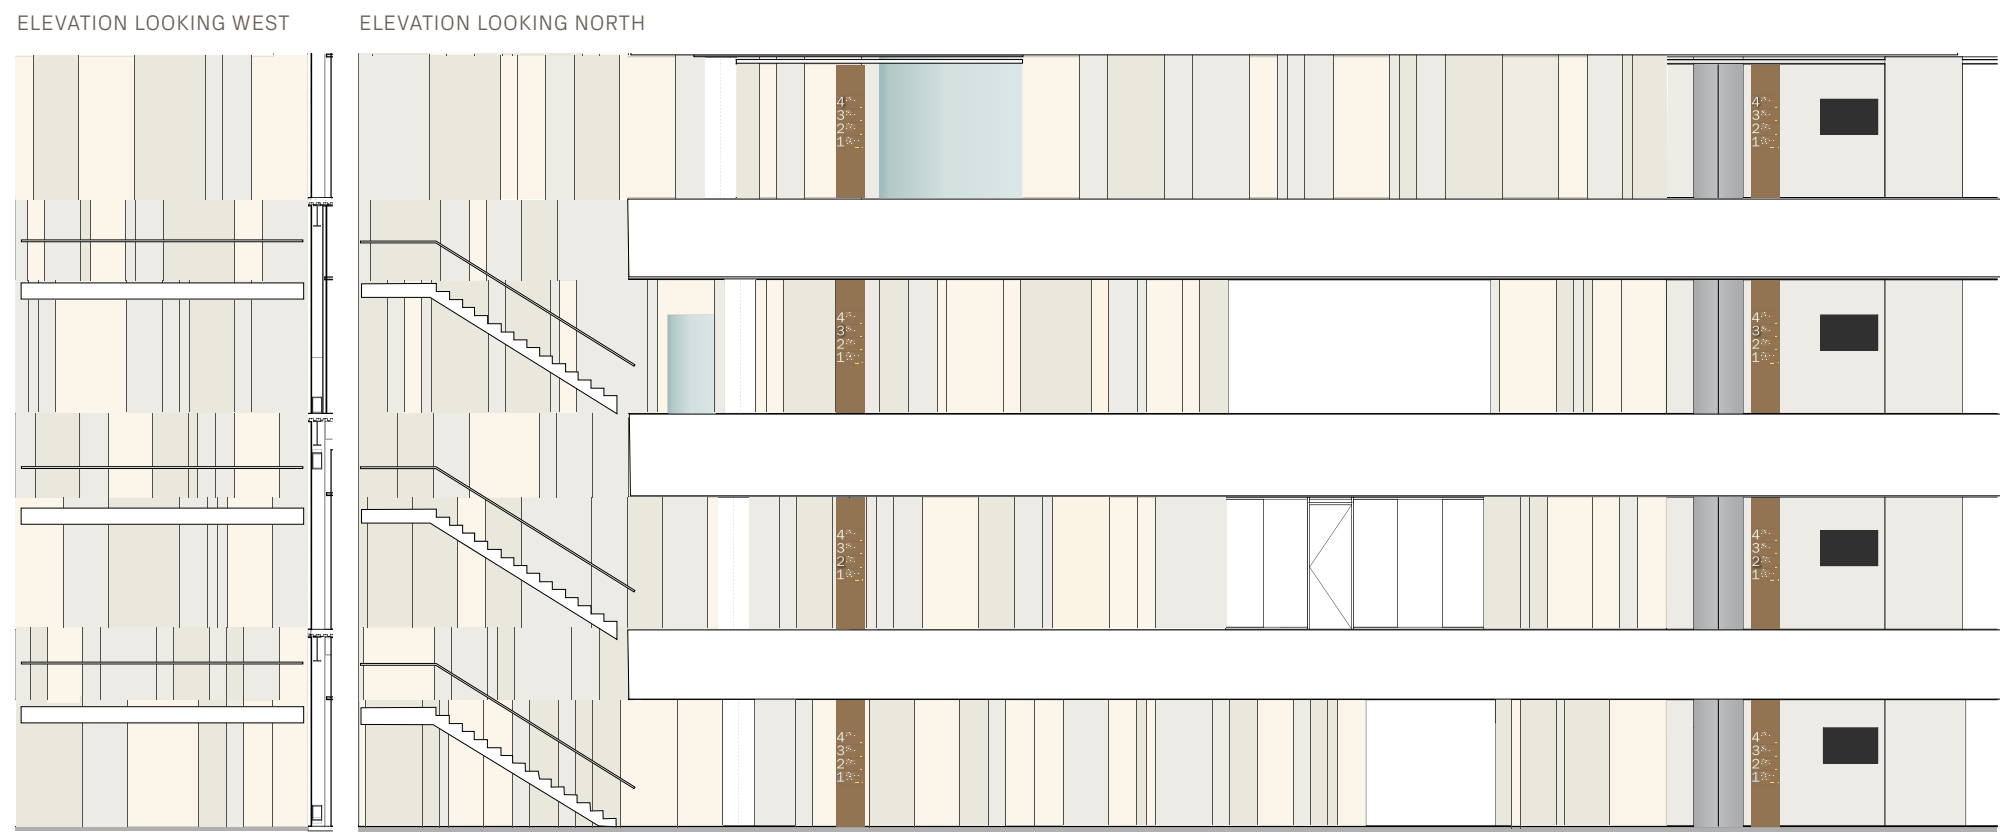

* DESIGN ASSIST:
FABRICATOR RESPONSIBLE FOR DETERMINING STRUCTURAL INTEGRITY OF INSTALLATION AND OVERALL ENGINEERING THROUGH SHOPS AND THE SAMPLE AND MOCKUP PROCESS. DRAWINGS HERE TO SHOW DESIGN INTENT ONLY AND ARE NOT A REPLACEMENT FOR SHOP DRAWINGS.

This information is no longer in scope

* SEE PROJECT MANUAL SECTION 101400 FOR SAMPLE AND MOCK-UP REQUIREMENTS.

EG1

Environmental Graphic Type:

EG1

EG1-111 Multi-Level Feature Wall


* DESIGN ASSIST:
SEE EG-1-OVERALL

PANELS ARE 3/4" PAINTED MDF WITH
3/32" BUTT JOINT REVEAL IN 3 DIFFERENT
PROJECT COLORS: 1. COLOR A,
2. COLOR B & 3. COLOR C WITH A SMOOTH
LACQUER FINISH

PANELS RUN CEILING HEIGHT TO
BASEBOARDS.
7 TOTAL PANEL WIDTHS USED
8", 14", 24", 30", 48" & 60"


COLOR AND PANEL WIDTH KEY:
COMMON PANEL WIDTH
8"
14"
24"
30"
38"
48"
60"
ODD PANEL WIDTH
8.5"
9"
12.5"
13"
34.5"

PANEL COLOR
COLOR A
COLOR B
COLOR C

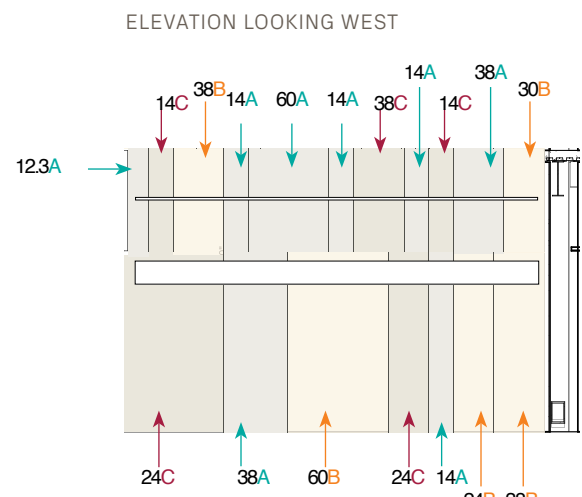

This information is no longer in scope

ELEVATION LOOKING NORTH

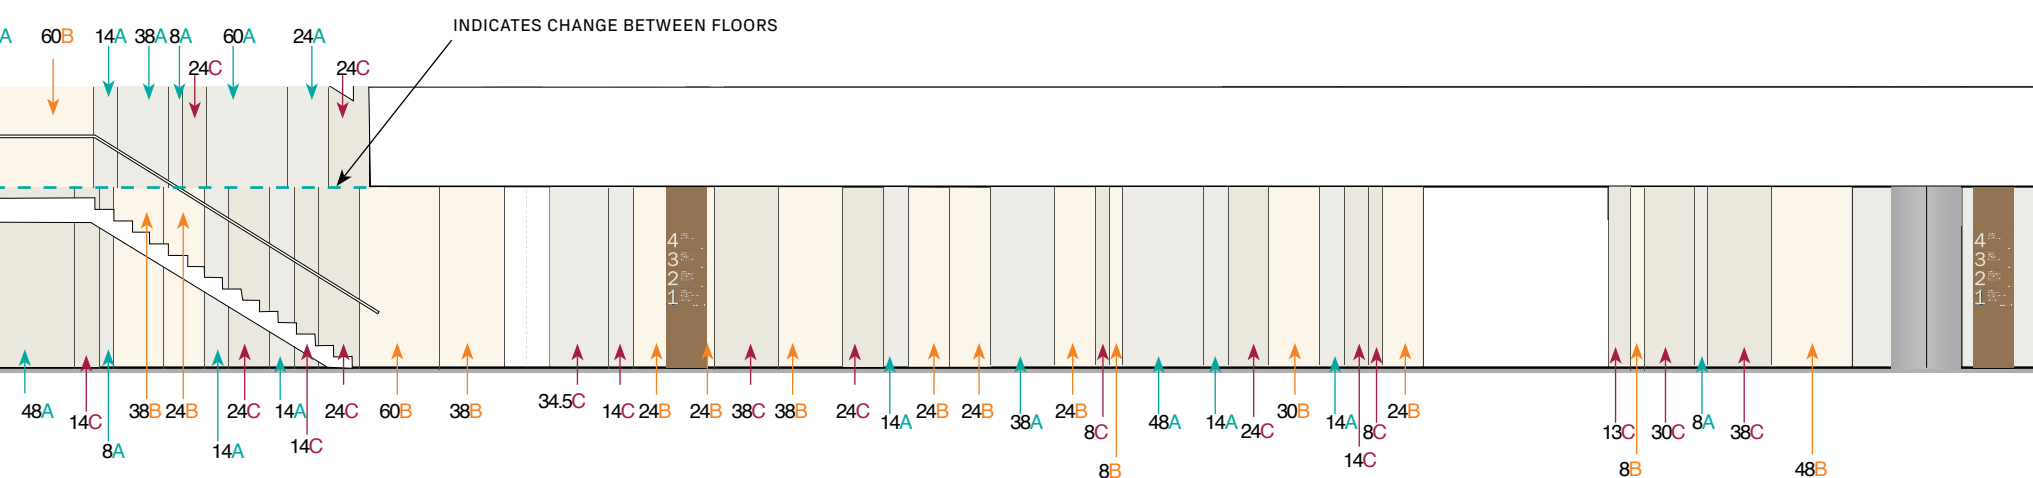

EG1

Environmental Graphic Type:

EG1

EG1-214 Multi-Level Feature Wall


* DESIGN ASSIST:
SEE EG-1-OVERALL

PANELS ARE 3/4" PAINTED MDF WITH
3/32" BUTT JOINT REVEAL IN 3 DIFFERENT
PROJECT COLORS: 1. COLOR A,
2. COLOR B & 3. COLOR C WITH A SMOOTH
LACQUER FINISH

PANELS RUN CEILING HEIGHT TO
BASEBOARDS.
7 TOTAL PANEL WIDTHS USED
8", 14", 24", 30", 48" & 60"


COLOR AND PANEL WIDTH KEY:
COMMON PANEL WIDTH
8"
14"
24"
30"
38"
48"
60"
ODD PANEL WIDTH
8.5"
9"
12.5"
13"
34.5"

PANEL COLOR
COLOR A
COLOR B
COLOR C

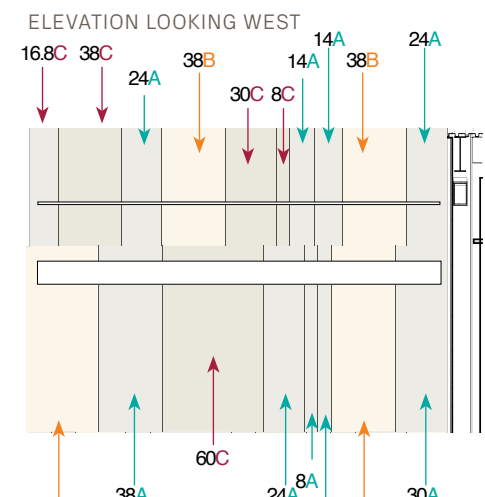

This information is no longer in scope

ELEVATION LOOKING NORTH

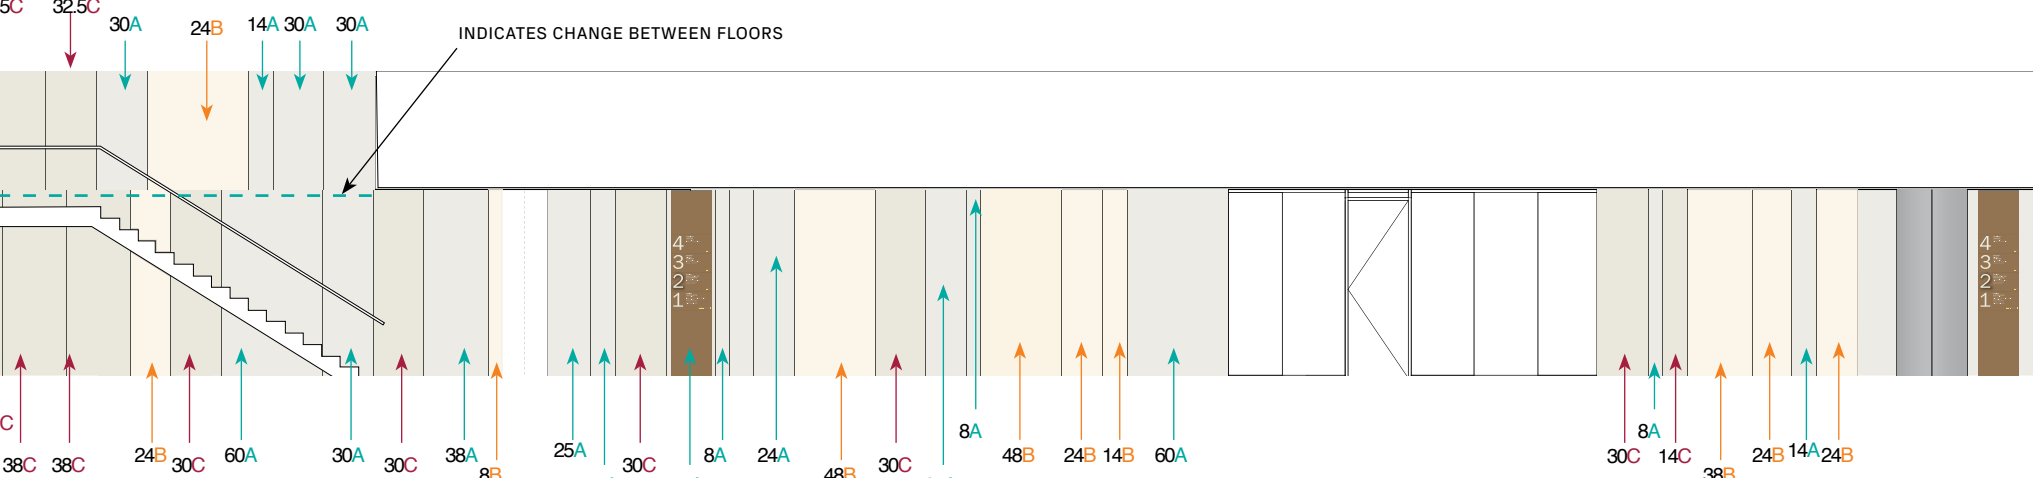

EG1

EG1

EG1-303 Multi-Level Feature Wall


* DESIGN ASSIST:
SEE EG-1-OVERALL

PANELS ARE 3/4" PAINTED MDF WITH
3/32" BUTT JOINT REVEAL IN 3 DIFFERENT
PROJECT COLORS: 1. COLOR A,
2. COLOR B & 3. COLOR C WITH A SMOOTH
LACQUER FINISH

PANELS RUN CEILING HEIGHT TO
BASEBOARDS.
7 TOTAL PANEL WIDTHS USED
8", 14", 24", 30", 48" & 60"


COLOR AND PANEL WIDTH KEY:
COMMON PANEL WIDTH
8"
14"
24"
30"
38"
48"
60"
ODD PANEL WIDTH
8.5"
9"
12.5"
13"
34.5"

PANEL COLOR
COLOR A
COLOR B
COLOR C

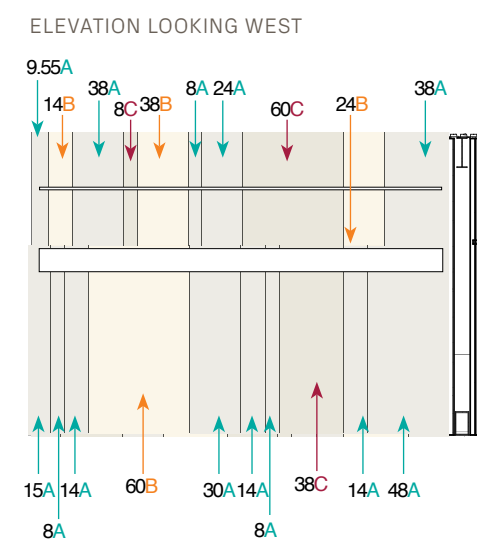

This information is no longer in scope

ELEVATION LOOKING NORTH

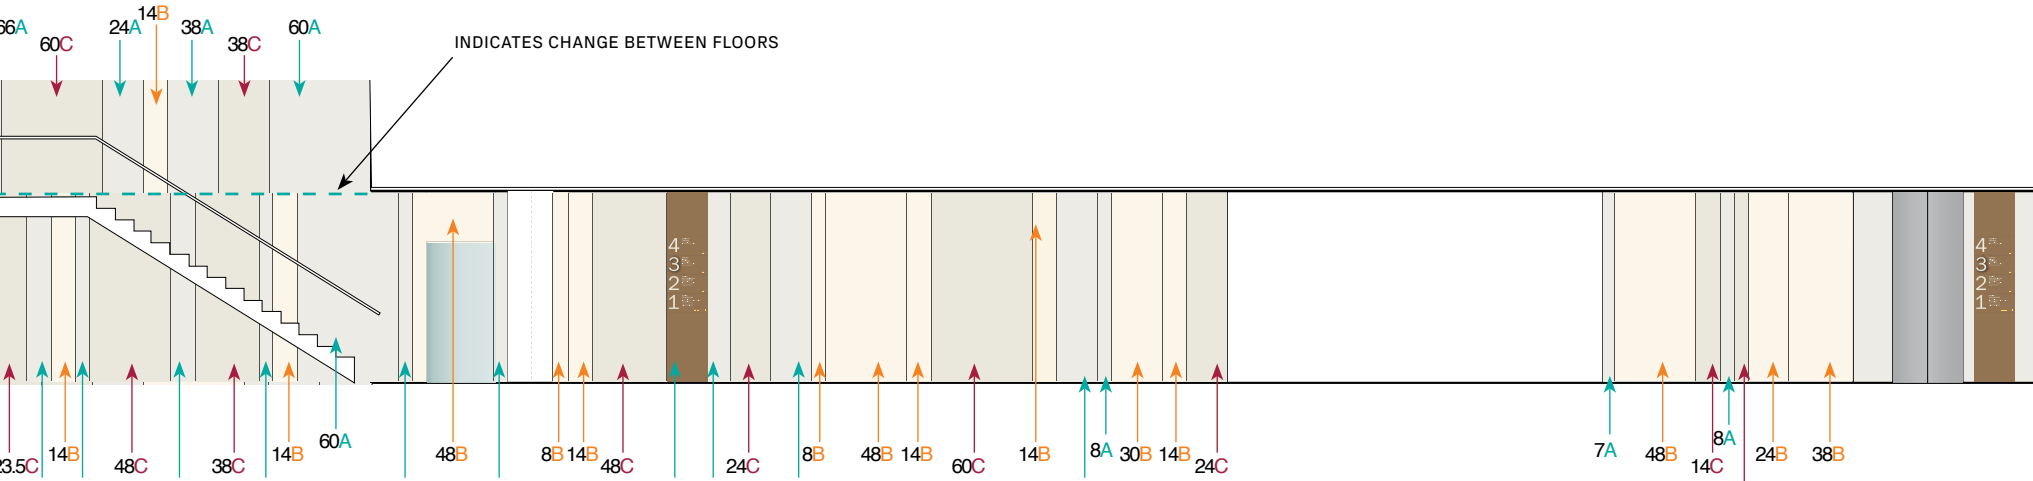

EG1

EG1

EG1-409 Multi-Level Feature Wall


* DESIGN ASSIST:
SEE EG-1-OVERALL

PANELS ARE 3/4" PAINTED MDF WITH
3/32" BUTT JOINT REVEAL IN 3 DIFFERENT
PROJECT COLORS: 1. COLOR A,
2. COLOR B & 3. COLOR C WITH A SMOOTH
LACQUER FINISH

PANELS RUN CEILING HEIGHT TO
BASEBOARDS.
7 TOTAL PANEL WIDTHS USED
8", 14", 24", 30", 48" & 60"


COLOR AND PANEL WIDTH KEY:
COMMON PANEL WIDTH
8"
14"
24"
30"
38"
48"
60"
ODD PANEL WIDTH
8.5"
9"
12.5"
13"
34.5"

PANEL COLOR
COLOR A
COLOR B
COLOR C

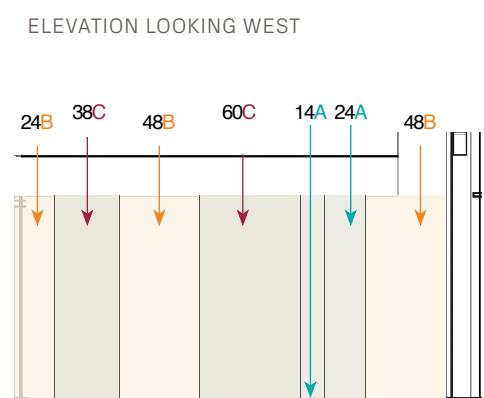

This information is no longer in scope

ELEVATION LOOKING NORTH

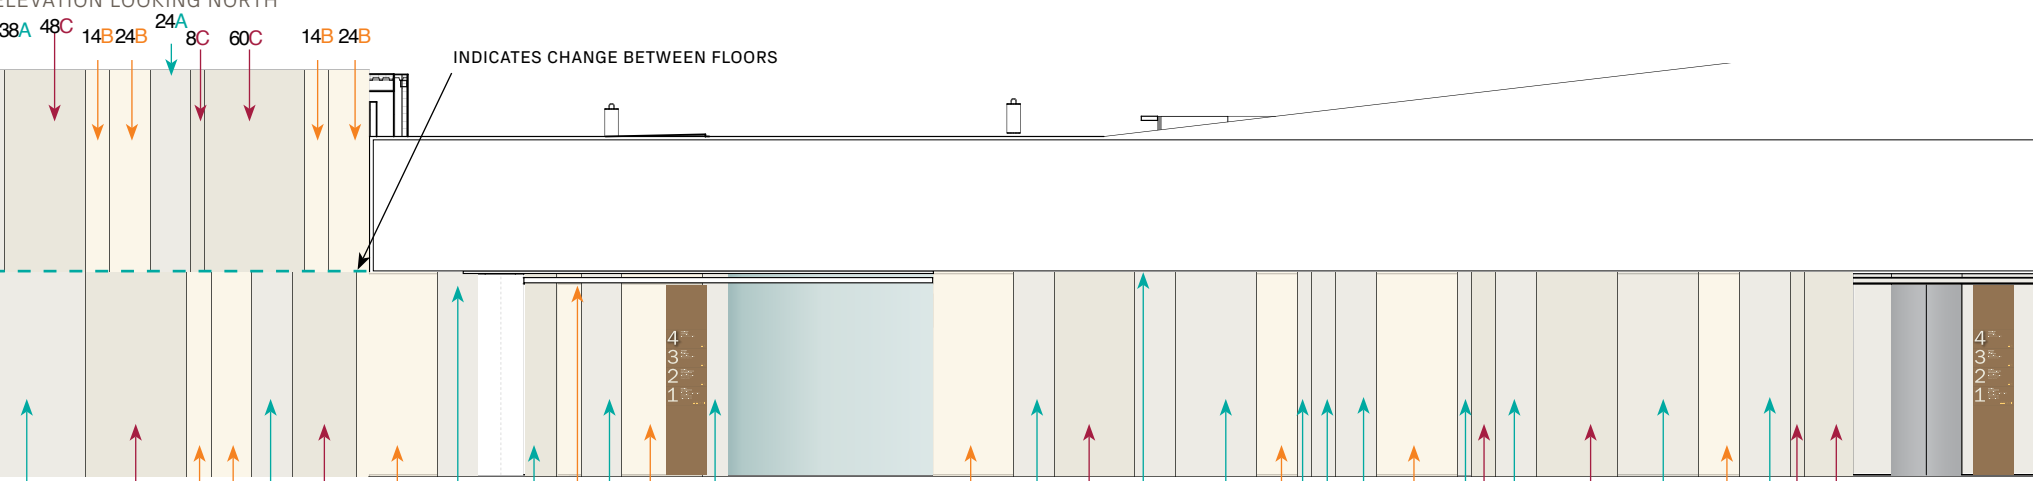

EG1

"W" with 1/16" Naval brass with satin finish on all levels has been removed. Painted MDF should run floor to ceiling in the areas that the "W" previously ran.