

Sign Locations by Floor:

L3

Section A


SIGN LOCATION KEY:

IDI-01 101

IDI-04 = sign type
103 = sign location

COLOR KEY:

Blue = Identification
Green = directional
Red = Regulatory/
Informational
Orange = Orientation

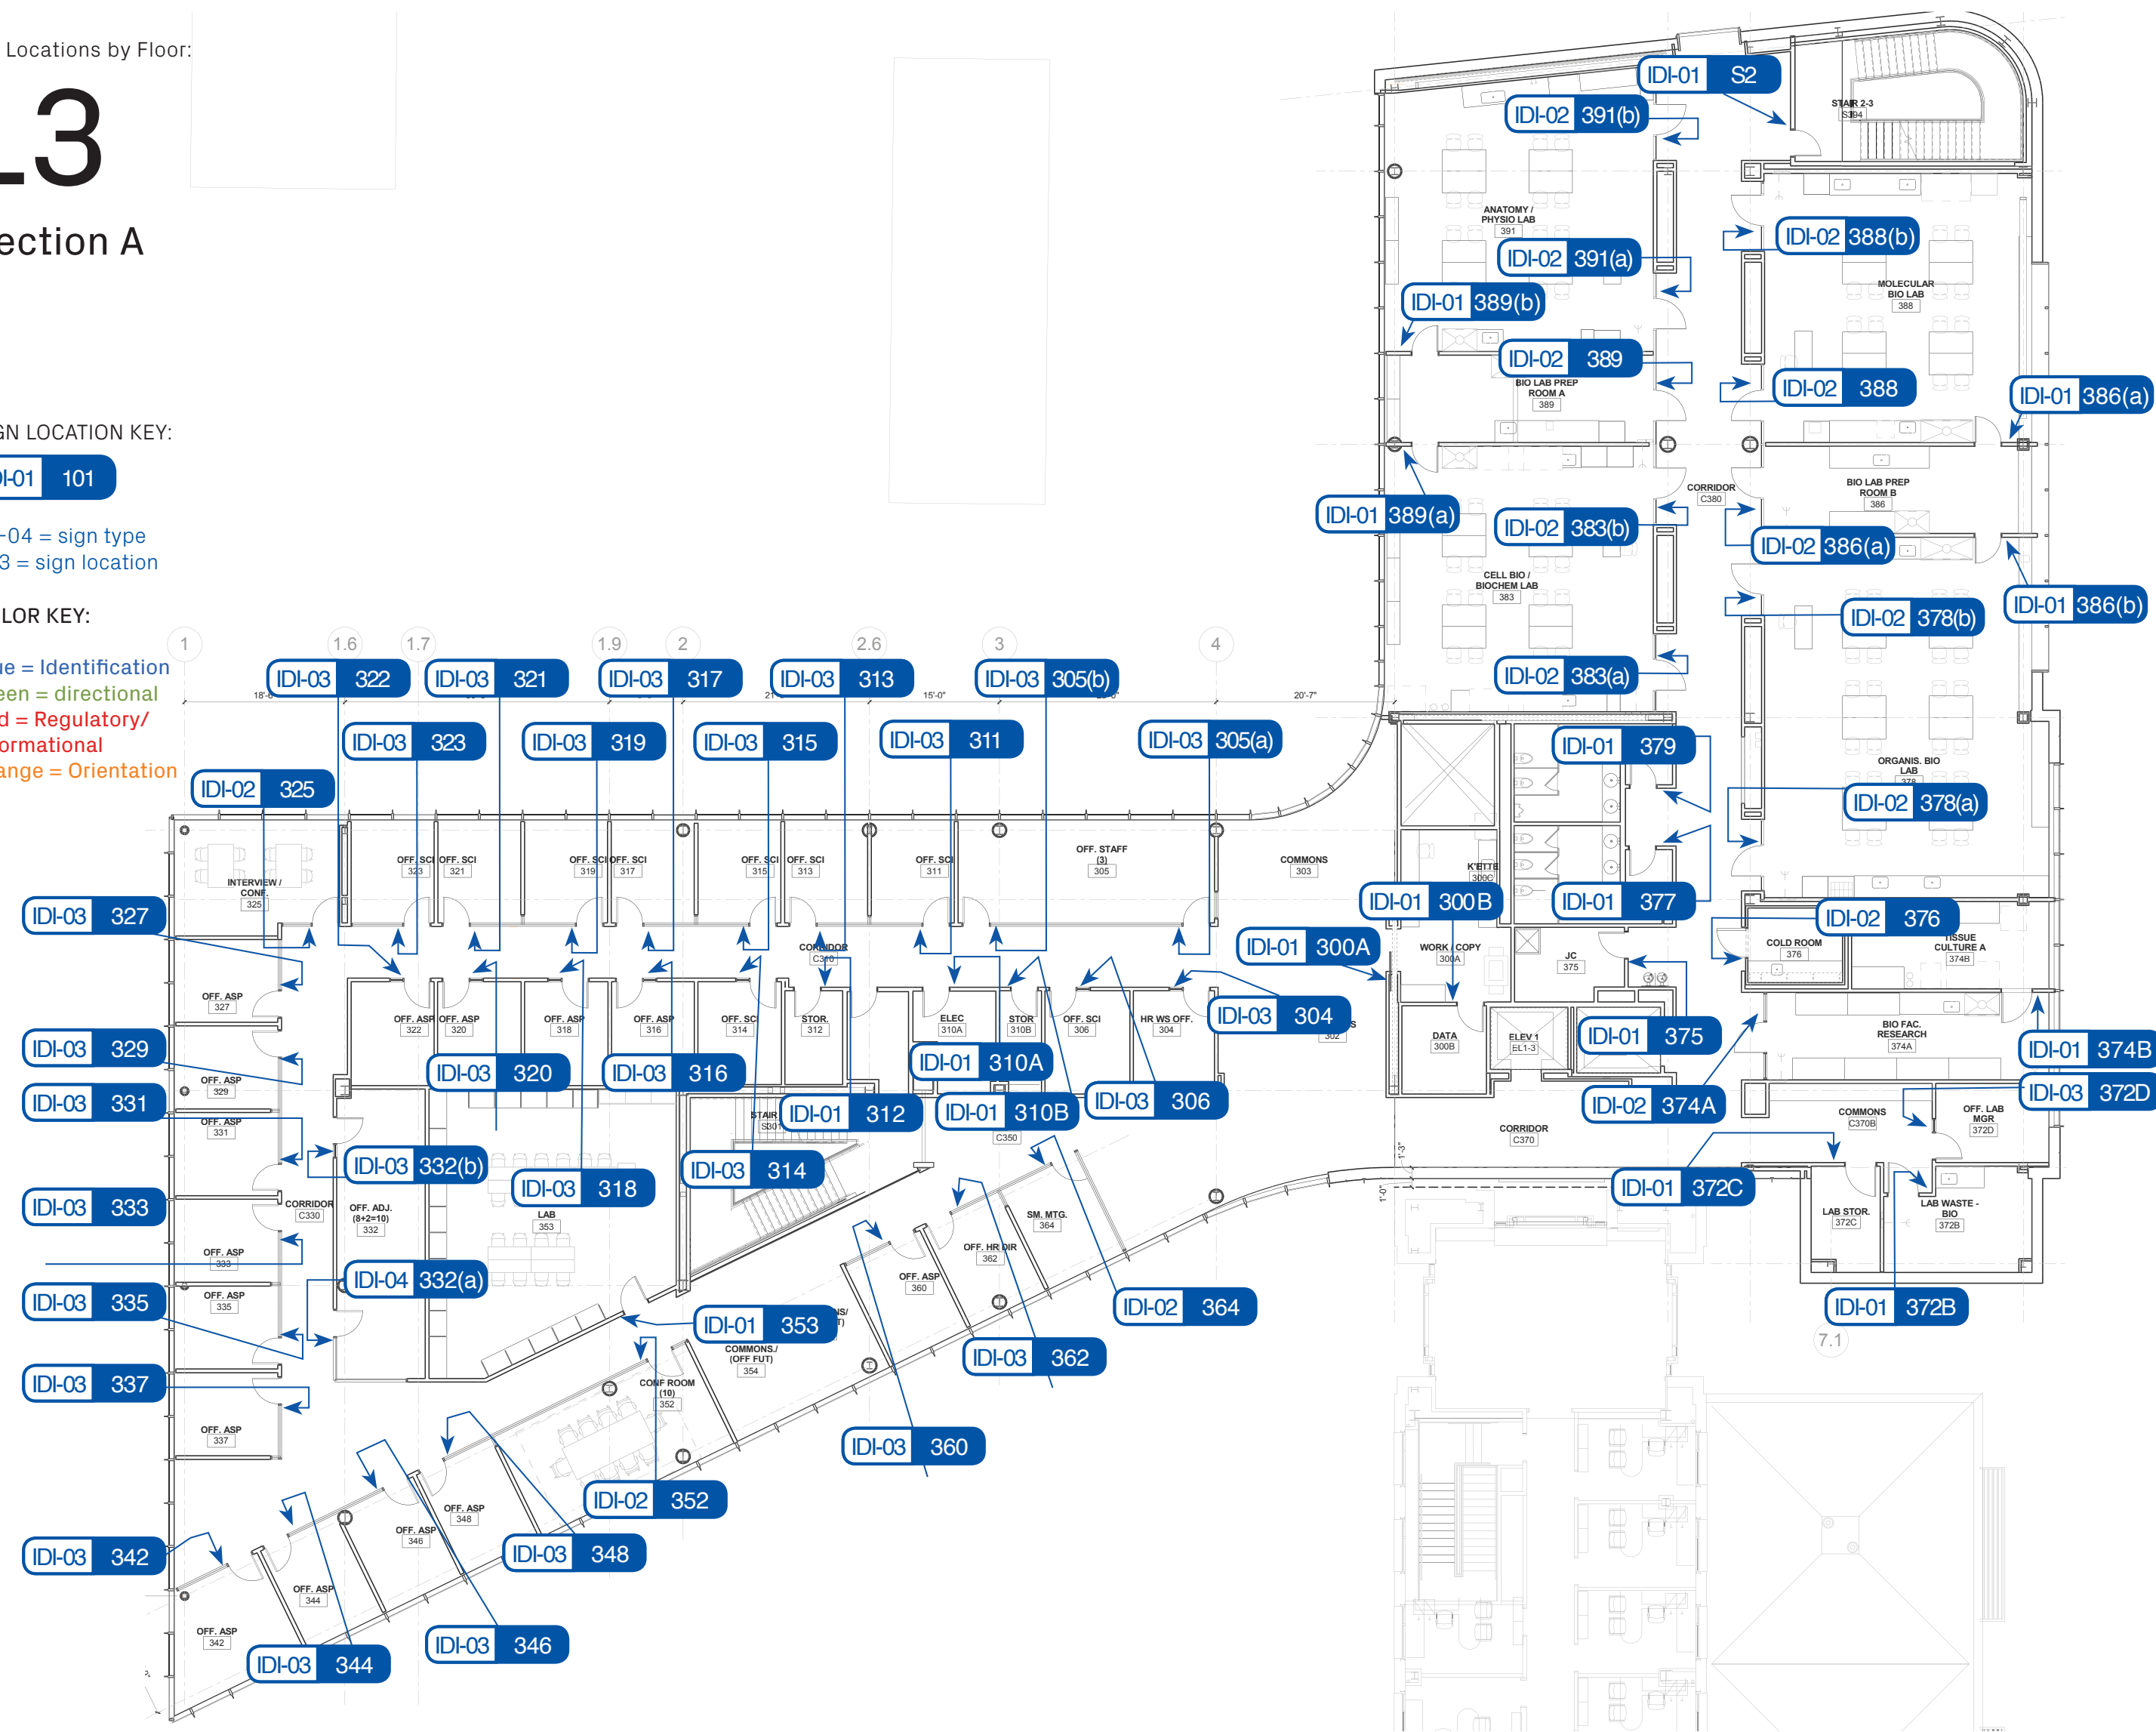

Sign Locations by Floor:

L3

Section B

SIGN LOCATION KEY:

ORI 302

ORI = sign type
302 = sign location

COLOR KEY:

Blue = Identification
Green = directional
Red = Regulatory/
Informational
Orange = Orientation



Sign Locations by Floor:

L4

Section A


SIGN LOCATION KEY:

IDI-01 404

IDI-01 = sign type
404 = sign location

COLOR KEY:

Blue = Identification
Green = directional
Red = Regulatory/
Informational
Orange = Orientation

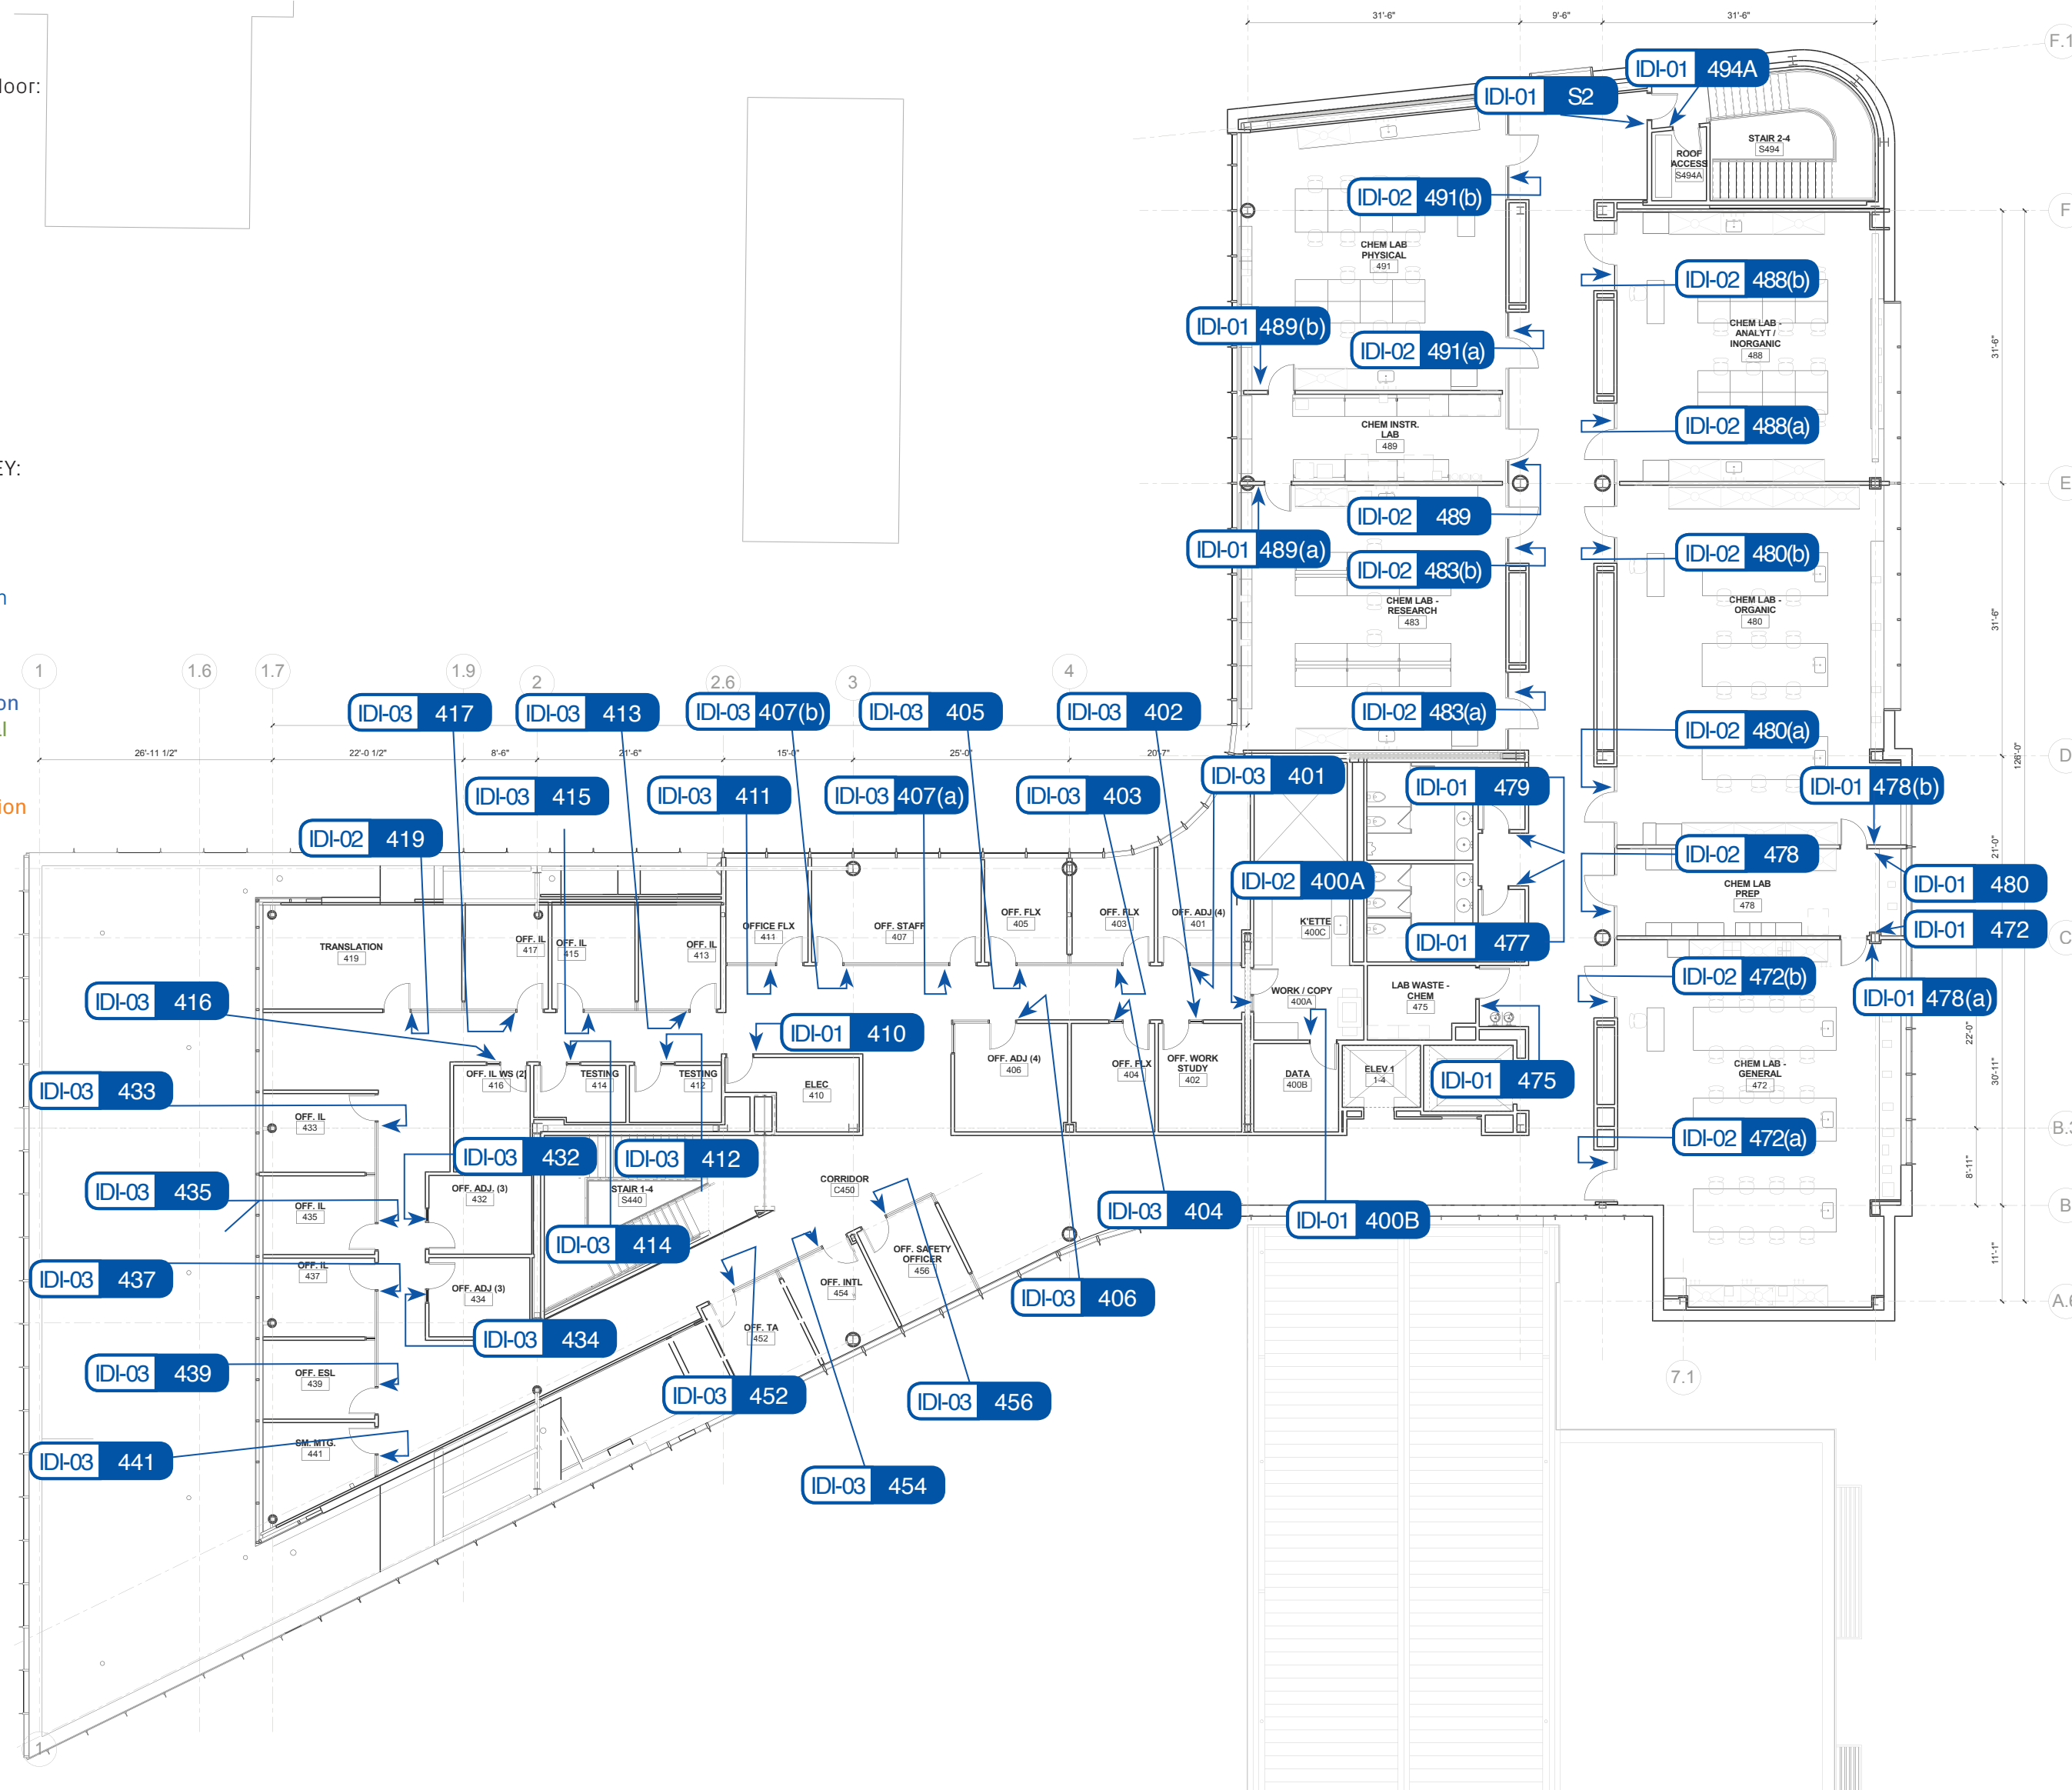

Sign Locations by Floor:

L4

Section B

SIGN LOCATION KEY:

ORI 409

ORI = sign type
409 = sign location

COLOR KEY:

Blue = Identification
Green = directional
Red = Regulatory/
Informational
Orange = Orientation

