

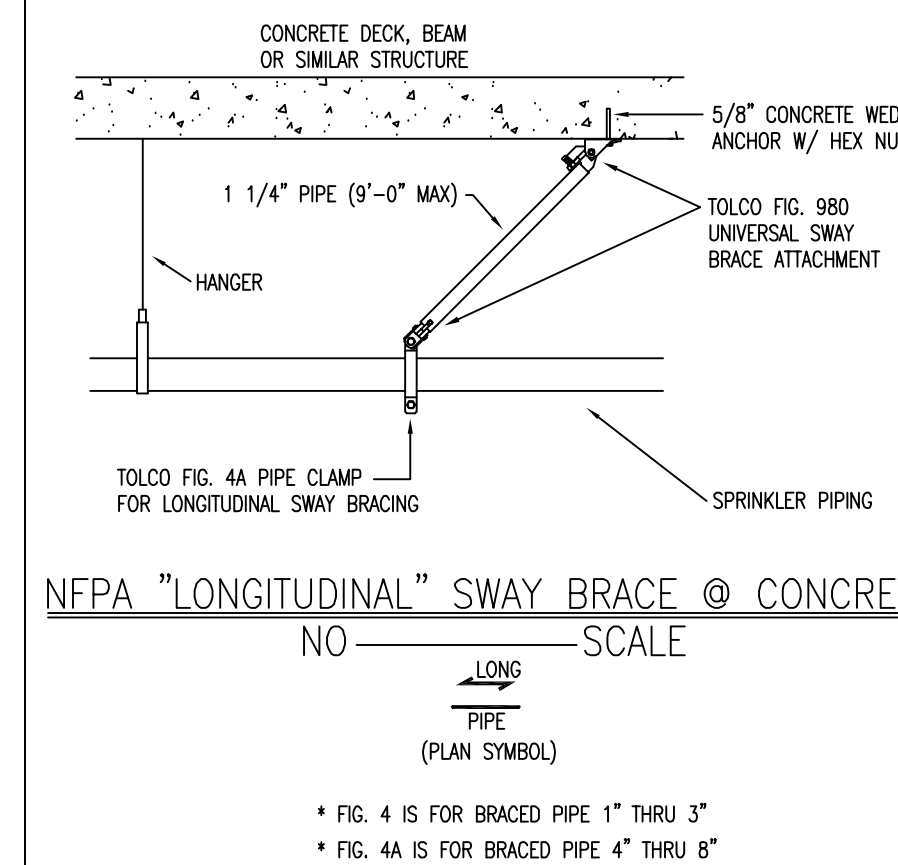


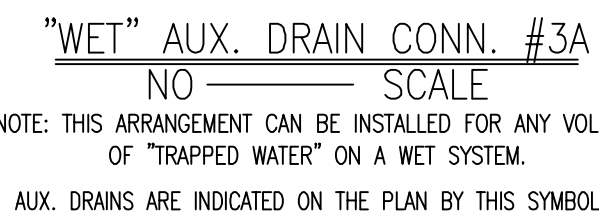

SPRINKLERS														
MAKE / VENDOR	MODEL	SIN	TYPE	RESPONSE TYPE	THREAD SIZE	NOM. "K"	GAU/G COVERAGE	DEFLECT. DISTANCE	TEMP.	FINISH	ESC.	ORFEN	SYMB.	QUANTITY
VINGO	M	VK300	UPR	KR	1/2"	5.6	225 SQ FT	1-1/2"	155°	BRZ	N/A	10899W/3		7
VINGO	M	VK350	UPR	KR	3/4"	8.0	130 SQ FT	1-1/2"	200°	BRZ	N/A	10899W/3		15
VINGO	EC	VK452	UPR	KR	3/4"	11.2	400 SQ FT	1-1/2"	200°	WHI	CONCLD	GS110W/3		14
VINGO	MIRAGE	WK642	PND	KR	1/2"	5.6	225 SQ FT	1-1/2"	155°	WHI	CONCLD	1047W/3		15
VINGO	MIRAGE	WK644	PND	KR	3/4"	8.0	130 SQ FT	1-1/2"	200°	WHI	CONCLD	1047W/3		17
VINGO	MIRAGE	EC	WK634	PND	3/4"	8.0	400 SQ FT	1-1/2"	155°	WHI	CONCLD	1047W/3		20
VINGO	DSY	WK634	PND	KR	1"	5.6	225 SQ FT	1-1/2"	155°	WHI	CONCLD	0755W/3		1
VINGO	M	VK305	HSW	KR	1/2"	5.6	196 SQ FT	4-6"	200°	BRZ	N/A	10899W/3		1
TOTAL SPRINKLERS ON THIS CONTRACT:												560		
TOTAL SPRINKLERS ON THIS SHEET:												80		


[illegible]

The design information and data contained on this electronic media is provided to you as an instrument of service, protected by copyright law, and intended for use and reference relative only to the specific project they describe. J. F. Ahern Co. explicitly assumes no responsibility or liability for any other use of these electronic files whatsoever. The electronic files may not be copied, modified or released to a third party without the direct written permission of J. F. Ahern Co. Further, because transmission errors and read/write errors can occur and because electronic media stored can be modified by other parties intentionally or otherwise without notice of said modification, J. F. Ahern Co. cannot guarantee the accuracy of these files.

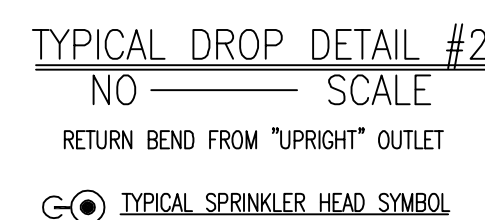



J. F. AHERN CO.
FIRE PROTECTION
CONTRACTORS
2675 Scott Ave., Suite C
St. Louis, MO 63103-3047
(314) 535-4544 p (314) 535-0144 f
www.jfahern.com

KEYPLAN

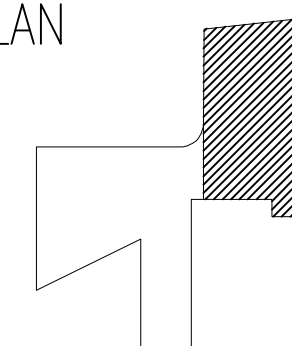

WEBSTER UNIV - INTER.
SCIENCE BUILDING
8274 BIG BEND BLVD.
WEBSTER GROVES, MO

**FIRE PROTECTION
PLAN - LEVEL 1 -
AREA A**

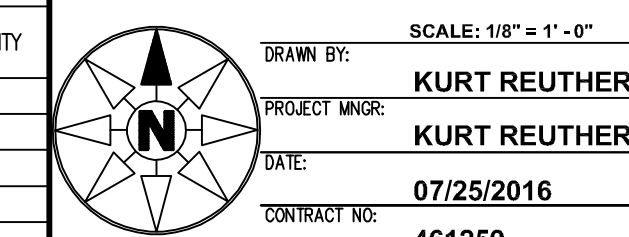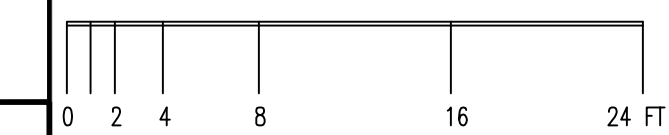

461239
CONSTRUCTION DOCUMENT

FP-101.A