

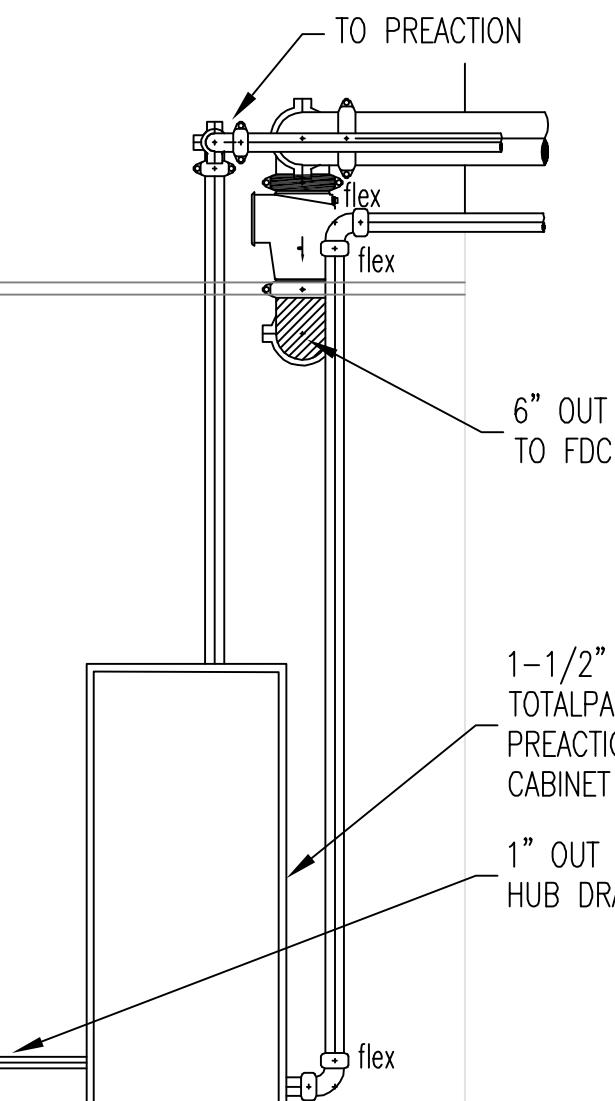
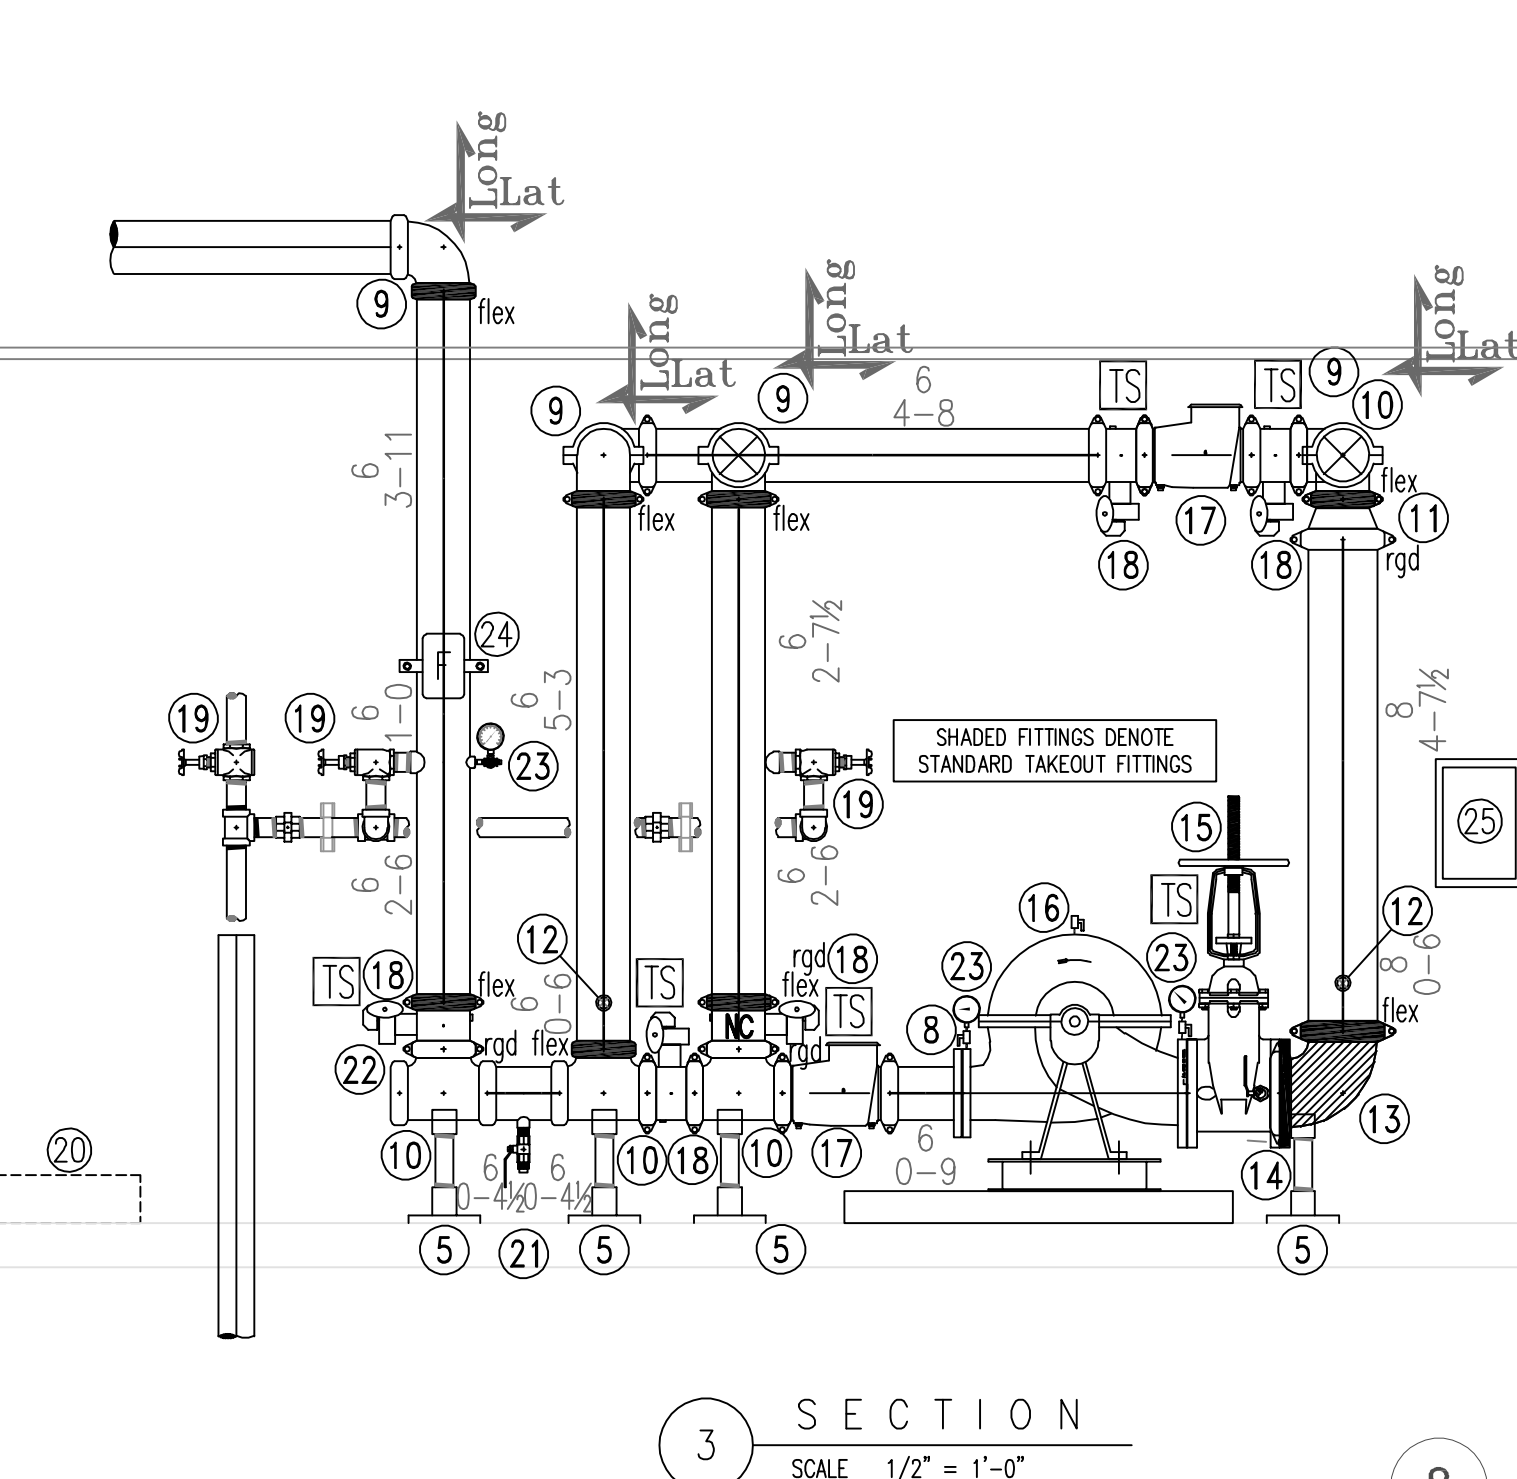
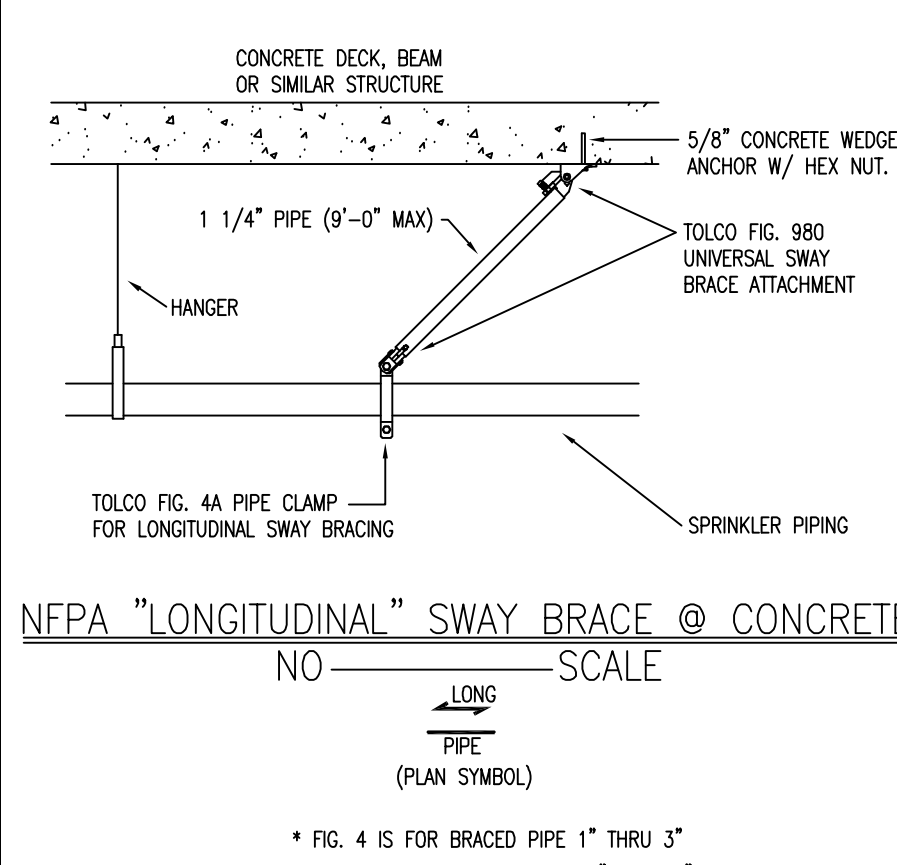


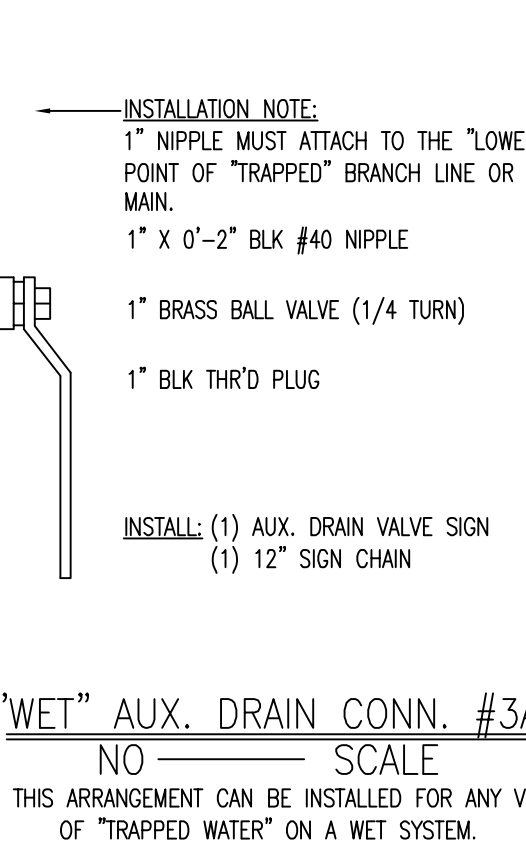

AUTOMATIC SPRINKLER SYSTEM PLAN
SCALE 1/8" = 1'-0"

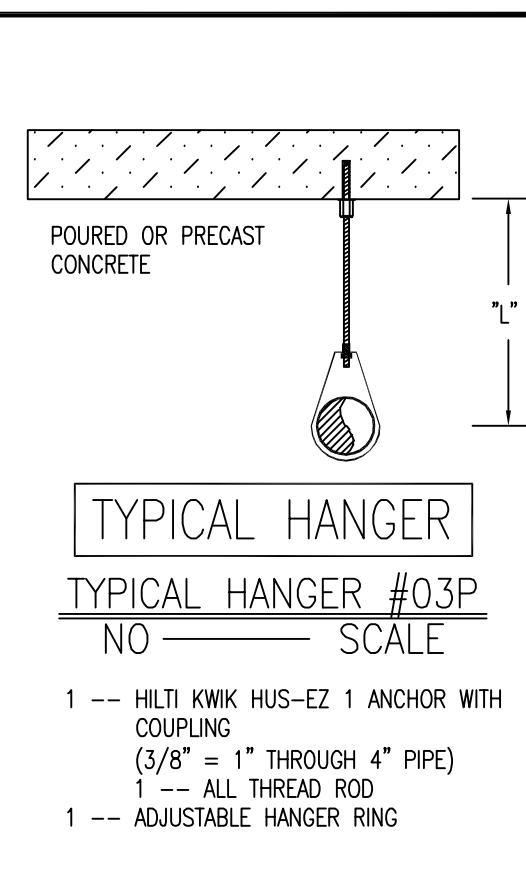

SPRINKLERS														
MAKE / VENDOR	MODEL	SIN	TYPE	RESPONSE TYPE	THREAD SIZE	NOM. "K"	CALCD COVERAGE	DEFLECT. DISTANCE	TEMP.	FINISH	ESC.	WRENCH	SYMB.	QUAN.
WIKING	M	VK300	UPR	QR	1/2"	5.6	225 SQ FT	1-12"	155	BRZ	N/A	10898/B		8
WIKING	M	VK350	UPR	QR	3/4"	8.0	130 SQ FT	1-12"	200	BRZ	N/A	10898/B		2
WIKING	EC	WK532	UPR	QR	3/4"	11.2	40 SQ FT	1-12"	200	BRZ	N/A	10898/B		2
WIKING	IRAC	WK462	PND	QR	1/2"	5.6	225 SQ FT	1-12"	155	WHI	CONCLD	14047/B		8
WIKING	IRAC	WK464	PND	QR	3/4"	8.0	130 SQ FT	1-12"	200	WHI	CONCLD	14047/B		2
WIKING	MIRAGE EC	WK164	PND	QR	3/4"	8.0	40 SQ FT	1-12"	155	WHI	CONCLD	14047/B		2
WIKING	DRT	WK164	PND	QR	3/4"	5.6	225 SQ FT	1-12"	155	WHI	DOME CONCLD	07568/B		2
WIKING	M	VK355	UPR	QR	1/2"	5.6	196 SQ FT	4-6"	200	WHI	CONCLD	10898/B		8
TOTAL SPRINKLERS ON THIS CONTRACT: 560													TOTAL SPRINKLERS ON THIS SHEET: 8	

PRESSURE REGULATION SETTINGS	
SMALL SYSTEM PRV'S	@ 175 PSI
JOCKEY PUMP OFF	@ 161 PSI
JOCKEY PUMP ON	@ 150 PSI
FIRE PUMP ON	@ 145 PSI

SPRINKLER POWER REQUIREMENTS	
<u>@ PUMP ROOM</u>	
FIRE PUMP	460 VAC, 3 PHASE, 40 HP
JOCKEY PUMP	460 VAC, 3 PHASE, .75 HP
HORN STROBE	120 VAC, SINGLE PHASE

STOCKLIST NOTES

PRELIST NUMBER: 1
SYSTEM MAIN LETTERS: S
STOCK LIST NUMBER: 0008
REQUEST FOR MAT'L NO.: N/A
LIST COLOR CODE: BROWN
BRANCH LINE NUMBERS: DRN

"AS-BUILTS"
08-01-2017


[illegible]

The design information and data contained on this electronic media is provided to you as an instrument of service, protected by copyright law and intended for use and reference relative only to the specific project they describe. J. F. Ahern Co. explicitly assumes no responsibility or liability for any other use of these electronic files whatsoever. The electronic files may not be copied, modified or released to a third party without the direct written permission of J. F. Ahern Co. Further, because transmission errors and read/write errors can occur and because electronic media stored can be modified by other parties intentionally or otherwise without notice of said modification, J. F. Ahern Co. cannot guarantee the accuracy of these files.





J. F. AHERN CO.
FIRE PROTECTION
CONTRACTORS
2675 Scott Ave., Suite C
St. Louis, MO 63103-3047
(314) 535-4544 p (314) 535-0144 f
www.jfahern.com

KEYPLAN

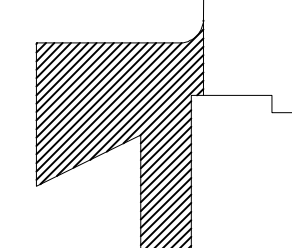

**WEBSTER UNIV - INTER.
SCIENCE BUILDING
8274 BIG BEND BLVD.
WEBSTER GROVES, MO**

**FIRE PROTECTION
PLAN - LEVEL 1 -
AREA B**

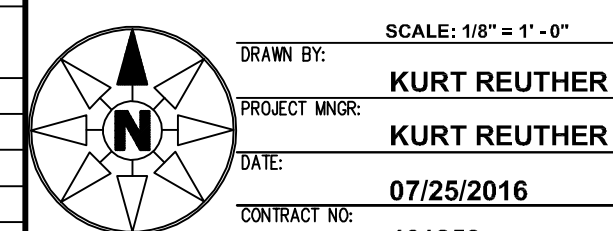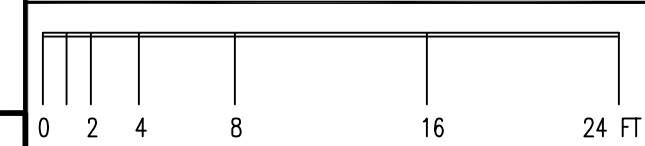46125
CONSTRUCTION DOCUMENTS**FP-101 R**