


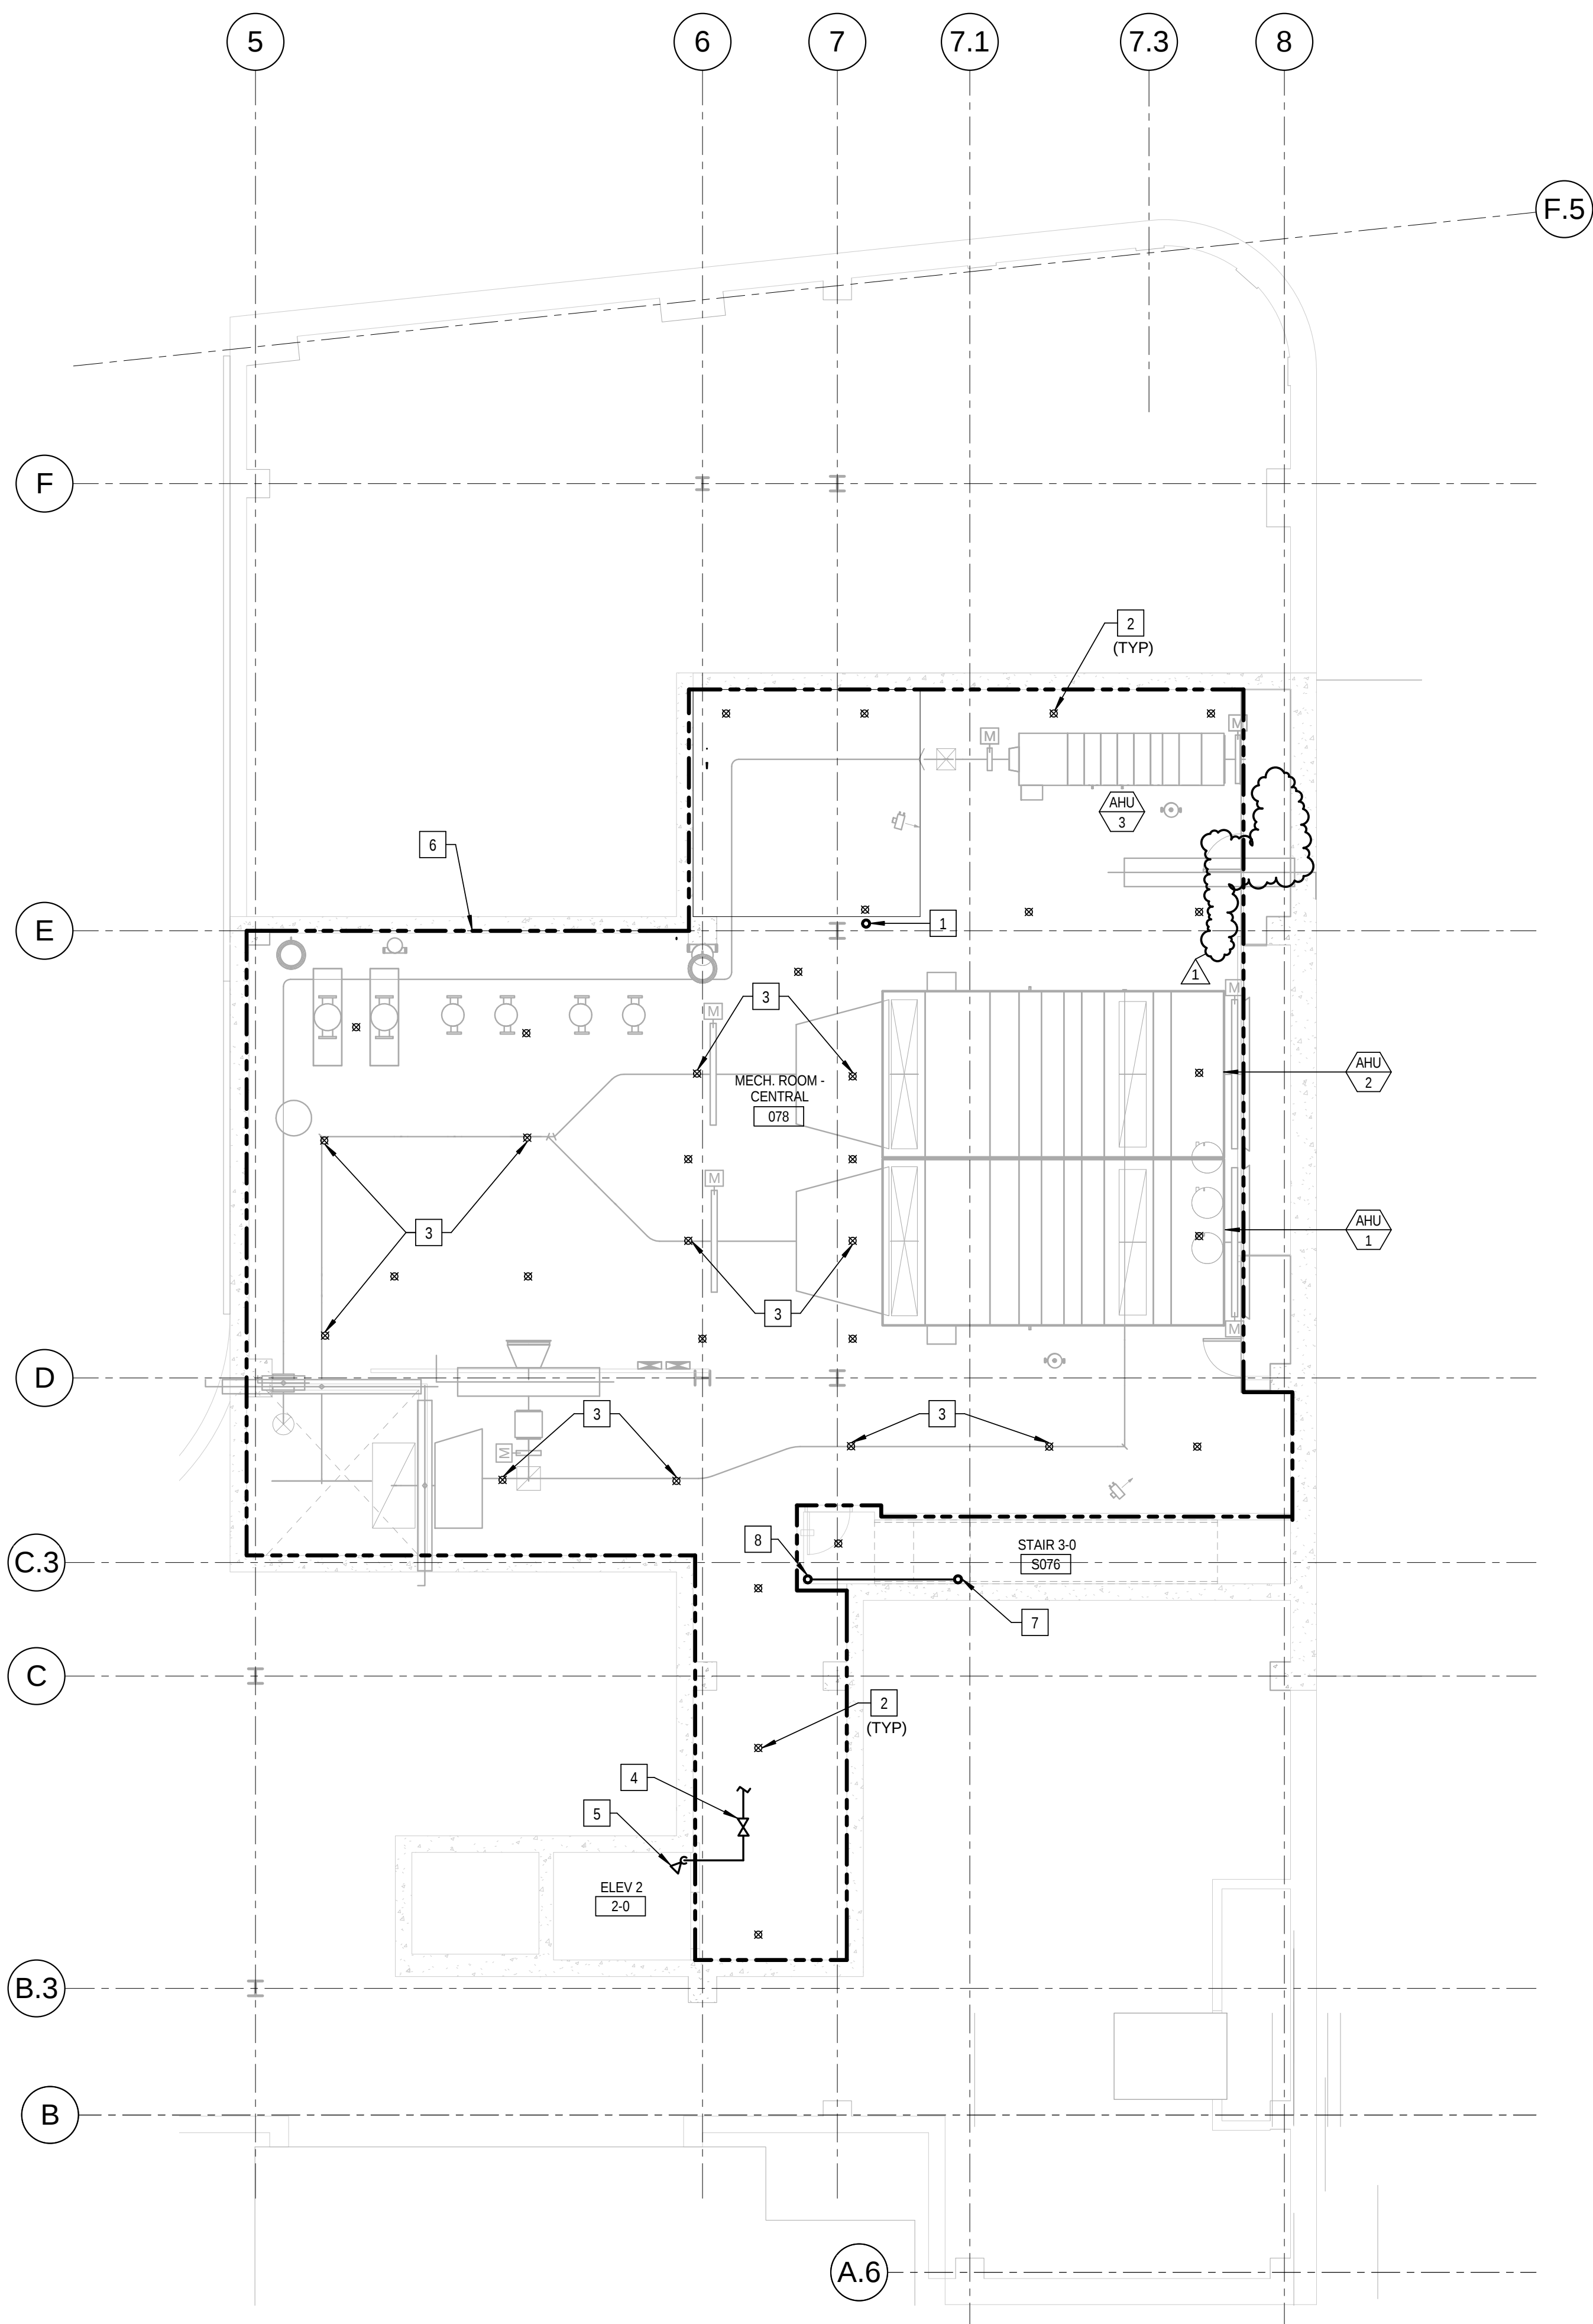


1 LEVEL 0 FLOOR PLAN - FIRE PROTECTION
1/8" = 1'-0"

KEYED NOTES: (THIS SHEET ONLY)

- 1 SPRINKLER SUPPLY PIPE UP THROUGH THE FLOOR TO THE FIRE PUMP ROOM ON LEVEL 1. REFER TO DRAWING FP0101.A FOR CONTINUATION.
- 2 SPRINKLER HEAD AT ABOVE STRUCTURE, PROVIDE WITH GUARD CAGE. COORDINATE WITH DUCTWORK, PIPING, PLUMBING AND ELECTRICAL RACEWAYS.
- 3 SPRINKLER HEAD LOCATED BELOW DUCTWORK, PROVIDE WITH GUARD CAGE. COORDINATE WITH DUCTWORK, PIPING, PLUMBING AND ELECTRICAL RACEWAYS.
- 4 MONITORED ISOLATION VALVE TO SERVE SPRINKLER HEAD IN HOISTWAY PIT.
- 5 PROVIDE SIDEWALL SPRINKLER HEAD WITH GUARD CAGE WITHIN ELEVATOR HOISTWAY. MOUNT SPRINKLER HEAD WITHIN 2'-0" OF THE HOIST WAY FLOOR. COORDINATE WITH THE GENERAL CONTRACTOR FOR THE LOCATION OF THE SPRINKLER HEAD, ROUTING OF PIPING AND PIPE PENETRATION IN THE HOISTWAY.
- 6 THIS AREA IS DESIGNATED AS ORDINARY HAZARD, GROUP 1.
- 7 SUPPLY PIPE UP TO STANDPIPE SYSTEM ON LEVEL 1, HOLD PIPING AS HIGH AS POSSIBLE IN STAIR.
- 8 EXPOSED 2.5 INCH FIRE DEPARTMENT HOSE VALVE WITH CAP AND CHAIN.
- 9 EQUIPMENT IS SHOWN FOR REFERENCE ONLY. CONTRACTOR SHALL REVIEW FINAL DOCUMENTS OF EACH DISCIPLINE FOR LOCATIONS AND LAYOUTS.

1	ADDENDUM 2-1	17 MAR 2016
1	ISSUED FOR CONSTRUCTION (BP2)	01 MAR 2016
No.	Description	Date

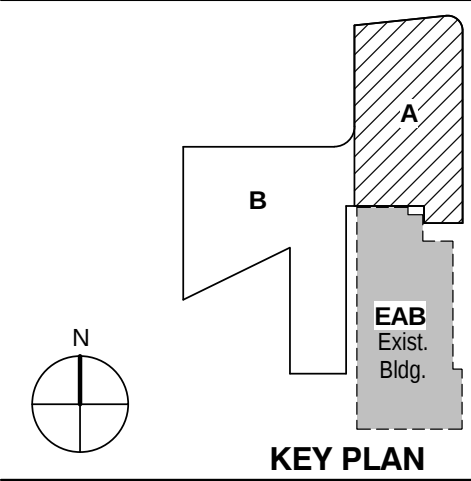

KEY PLAN

LEVEL 0 FLOOR PLAN -
FIRE PROTECTION

Project No.: 04561.01 Checked by:

FP0100.A