



KEYED NOTES: (THIS SHEET ONLY)

- COORDINATE LOCATION OF SPRINKLER HEADS WITH SUSPENDED LUMINARIES. REFER TO THE ARCHITECTURAL DRAWINGS FOR EXACT LOCATIONS.
- THIS AREA IS DESIGNATED AS ORDINARY HAZARD, GROUP 1.
- THIS AREA IS DESIGNATED AS ORDINARY HAZARD, GROUP 2.
- PIPE TO BE OFF-SET ABOVE THE CEILING ON THIS LEVEL TO LEVEL 4.
- RECESSED FIRE HOSE VALVE CABINET WITH 2.5 INCH ANGLE FIRE HOSE VALVE, CAP AND CHAIN. REFER TO ARCHITECTURAL DRAWINGS FOR EXACT LOCATION.
- CONTRACTOR TO REVIEW ARCHITECTURAL DRAWINGS FOR RECESSED OR ELEVATED CEILING POCKETS. PROVIDE PROTECTION AS REQUIRED.
- THIS PORTION OF THE CEILING SLOPES FROM THE LOW END ON THE WEST (APPROX. 12'-0" +/-) TO THE HIGH END ON THE EAST (APPROX. 22'-0" +/-). THE CEILINGS IN THE INDIVIDUAL OFFICES ARE SET AT 9'-6". THE CONTRACTOR IS TO CAREFULLY EVALUATE THE CONDITIONS AND PROVIDE SPRINKLER PROTECTION AS REQUIRED FOR THE APPLICATION. REFER TO THE ARCHITECTURAL DRAWINGS.
- THIS PORTION OF THE CEILING SLOPES FROM THE LOW END ON THE WEST (APPROX. 12'-0" +/-) TO THE HIGH END ON THE EAST (APPROX. 22'-0" +/-). THE CEILINGS IN THE INDIVIDUAL OFFICES ARE TO SLOPE AT THE SAME PITCH, AT A DIFFERENT ELEVATION. THE CONTRACTOR IS TO CAREFULLY EVALUATE THE CONDITIONS AND PROVIDE SPRINKLER PROTECTION AS REQUIRED FOR THE APPLICATION. REFER TO THE ARCHITECTURAL DRAWINGS.
- STAND PIPE SUPPLY RISER FROM LEVEL 2 TO SERVE FIRE HOSE VALVE ON THIS LEVEL.

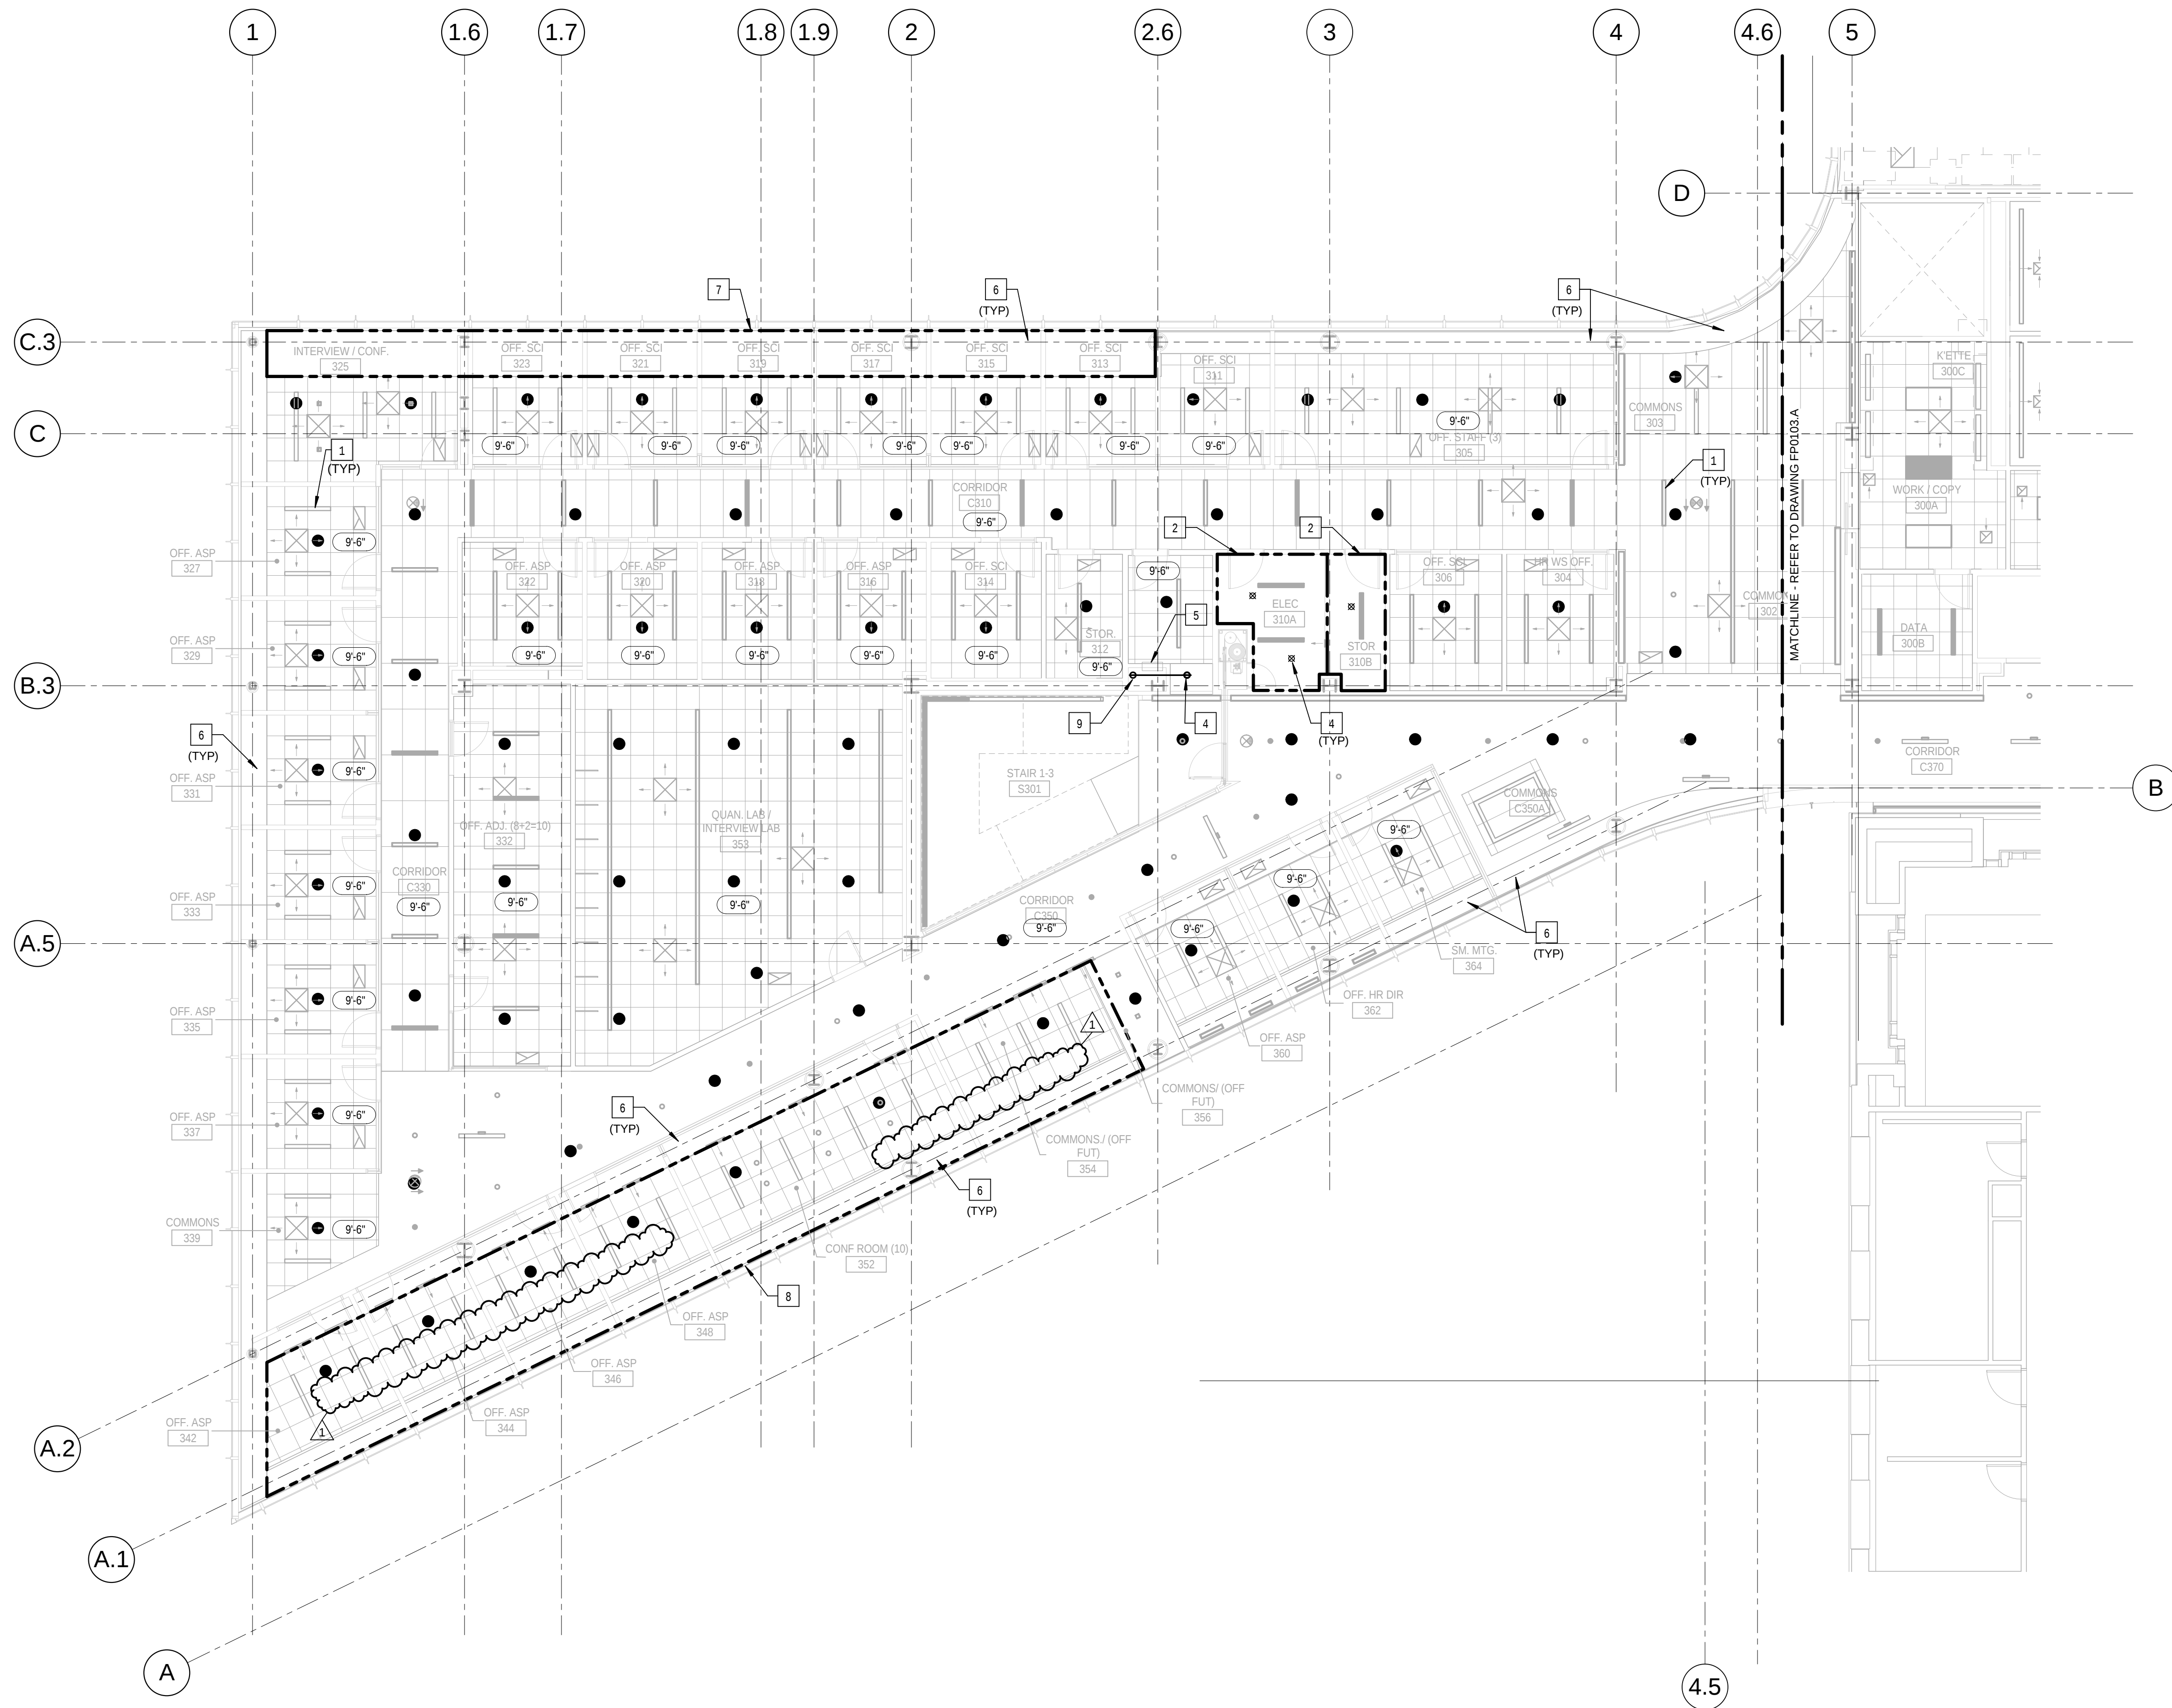

1 LEVEL 03 AREA B FLOOR PLAN - FIRE PROTECTION
1/8" = 1'-0"

1	ADDENDUM 2-1	17 MAR 2016
	ISSUED FOR CONSTRUCTION (BP2)	01 MAR 2016
No.	Description	Date

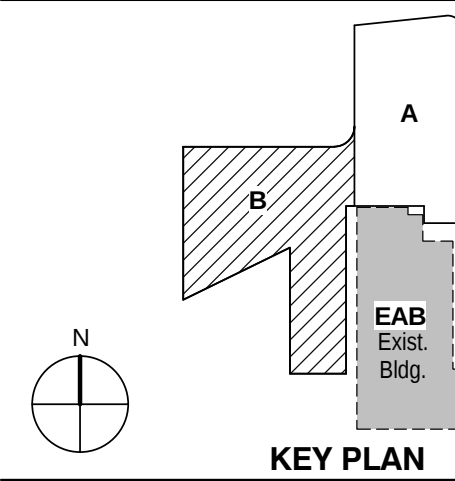

KEY PLAN

LEVEL 03 AREA B FLOOR
PLAN - FIRE PROTECTION

Project No.: 04561.01 Checked by:

FP0103.B