



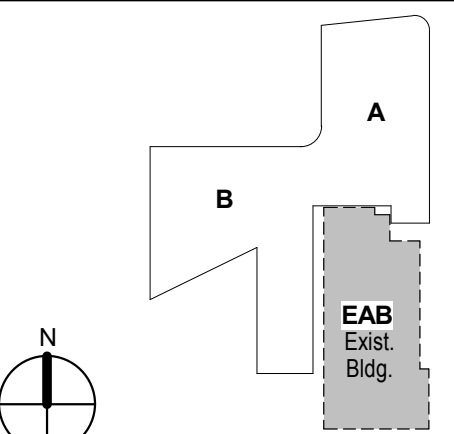


KEY PLAN

LEVEL 01 AND 02 CODE
COMPLIANCE PLAN

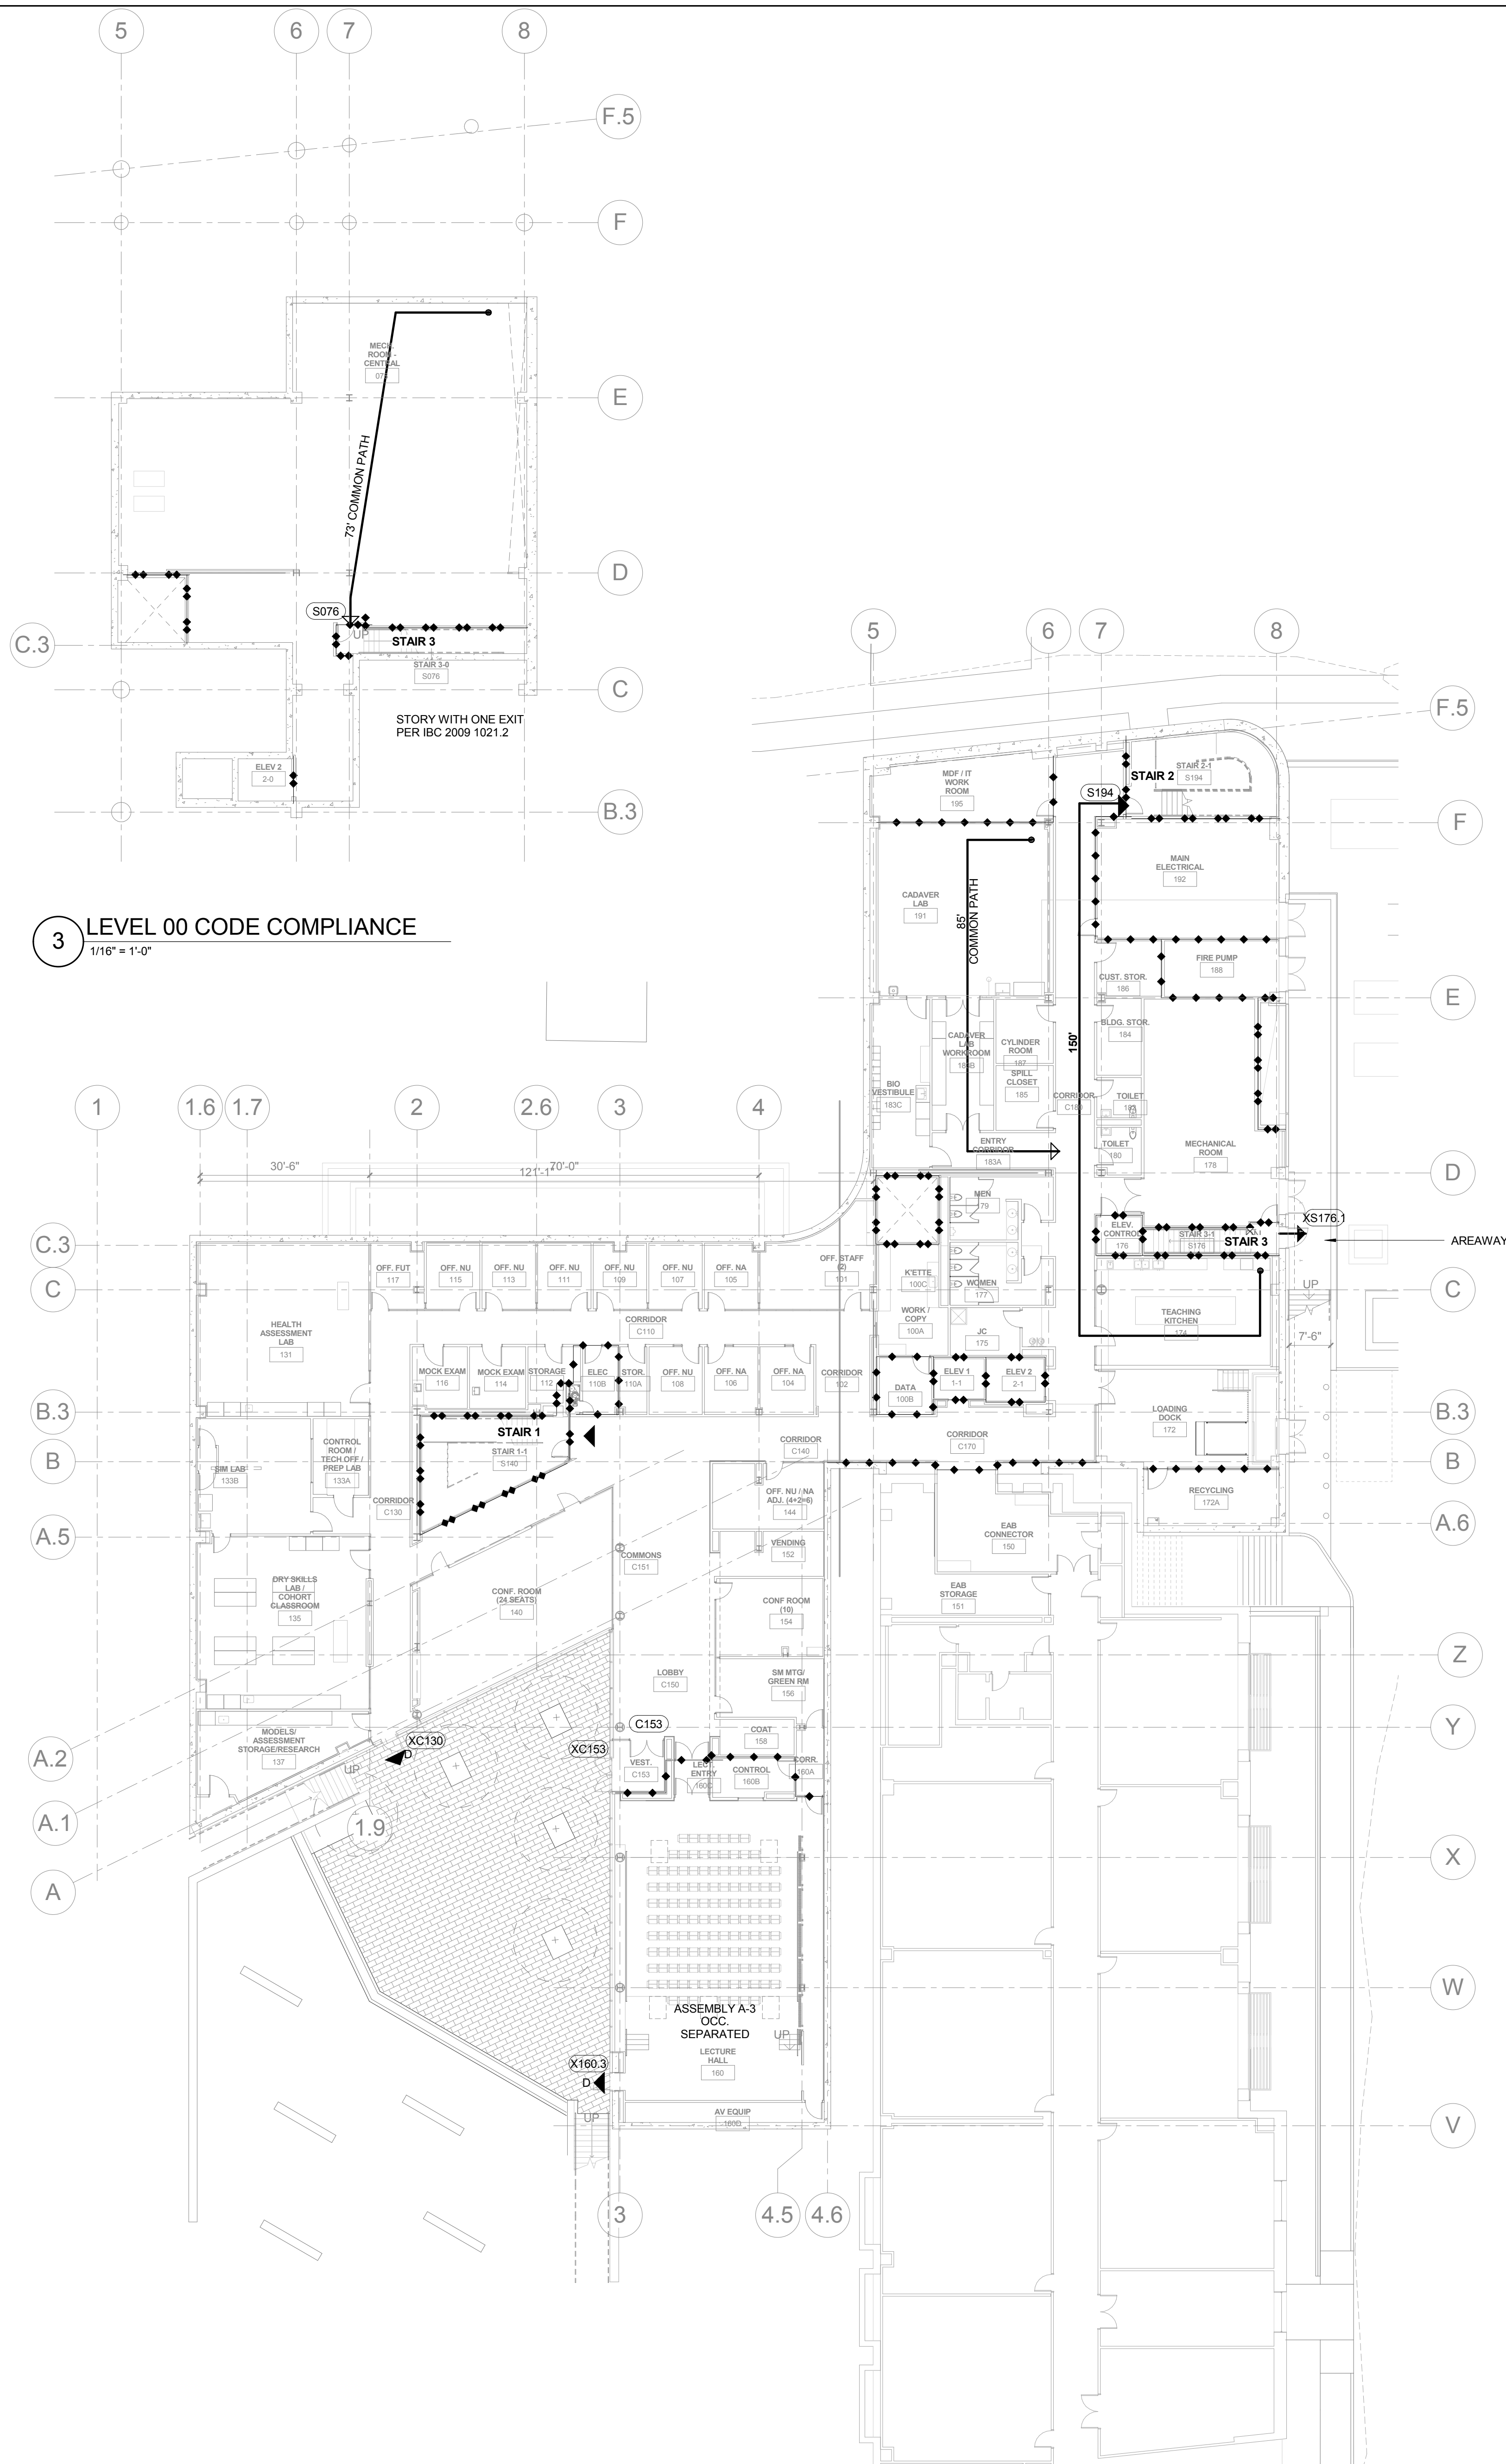

1 LEVEL 01 CODE COMPLIANCE PLAN
1/16" = 1'-0"

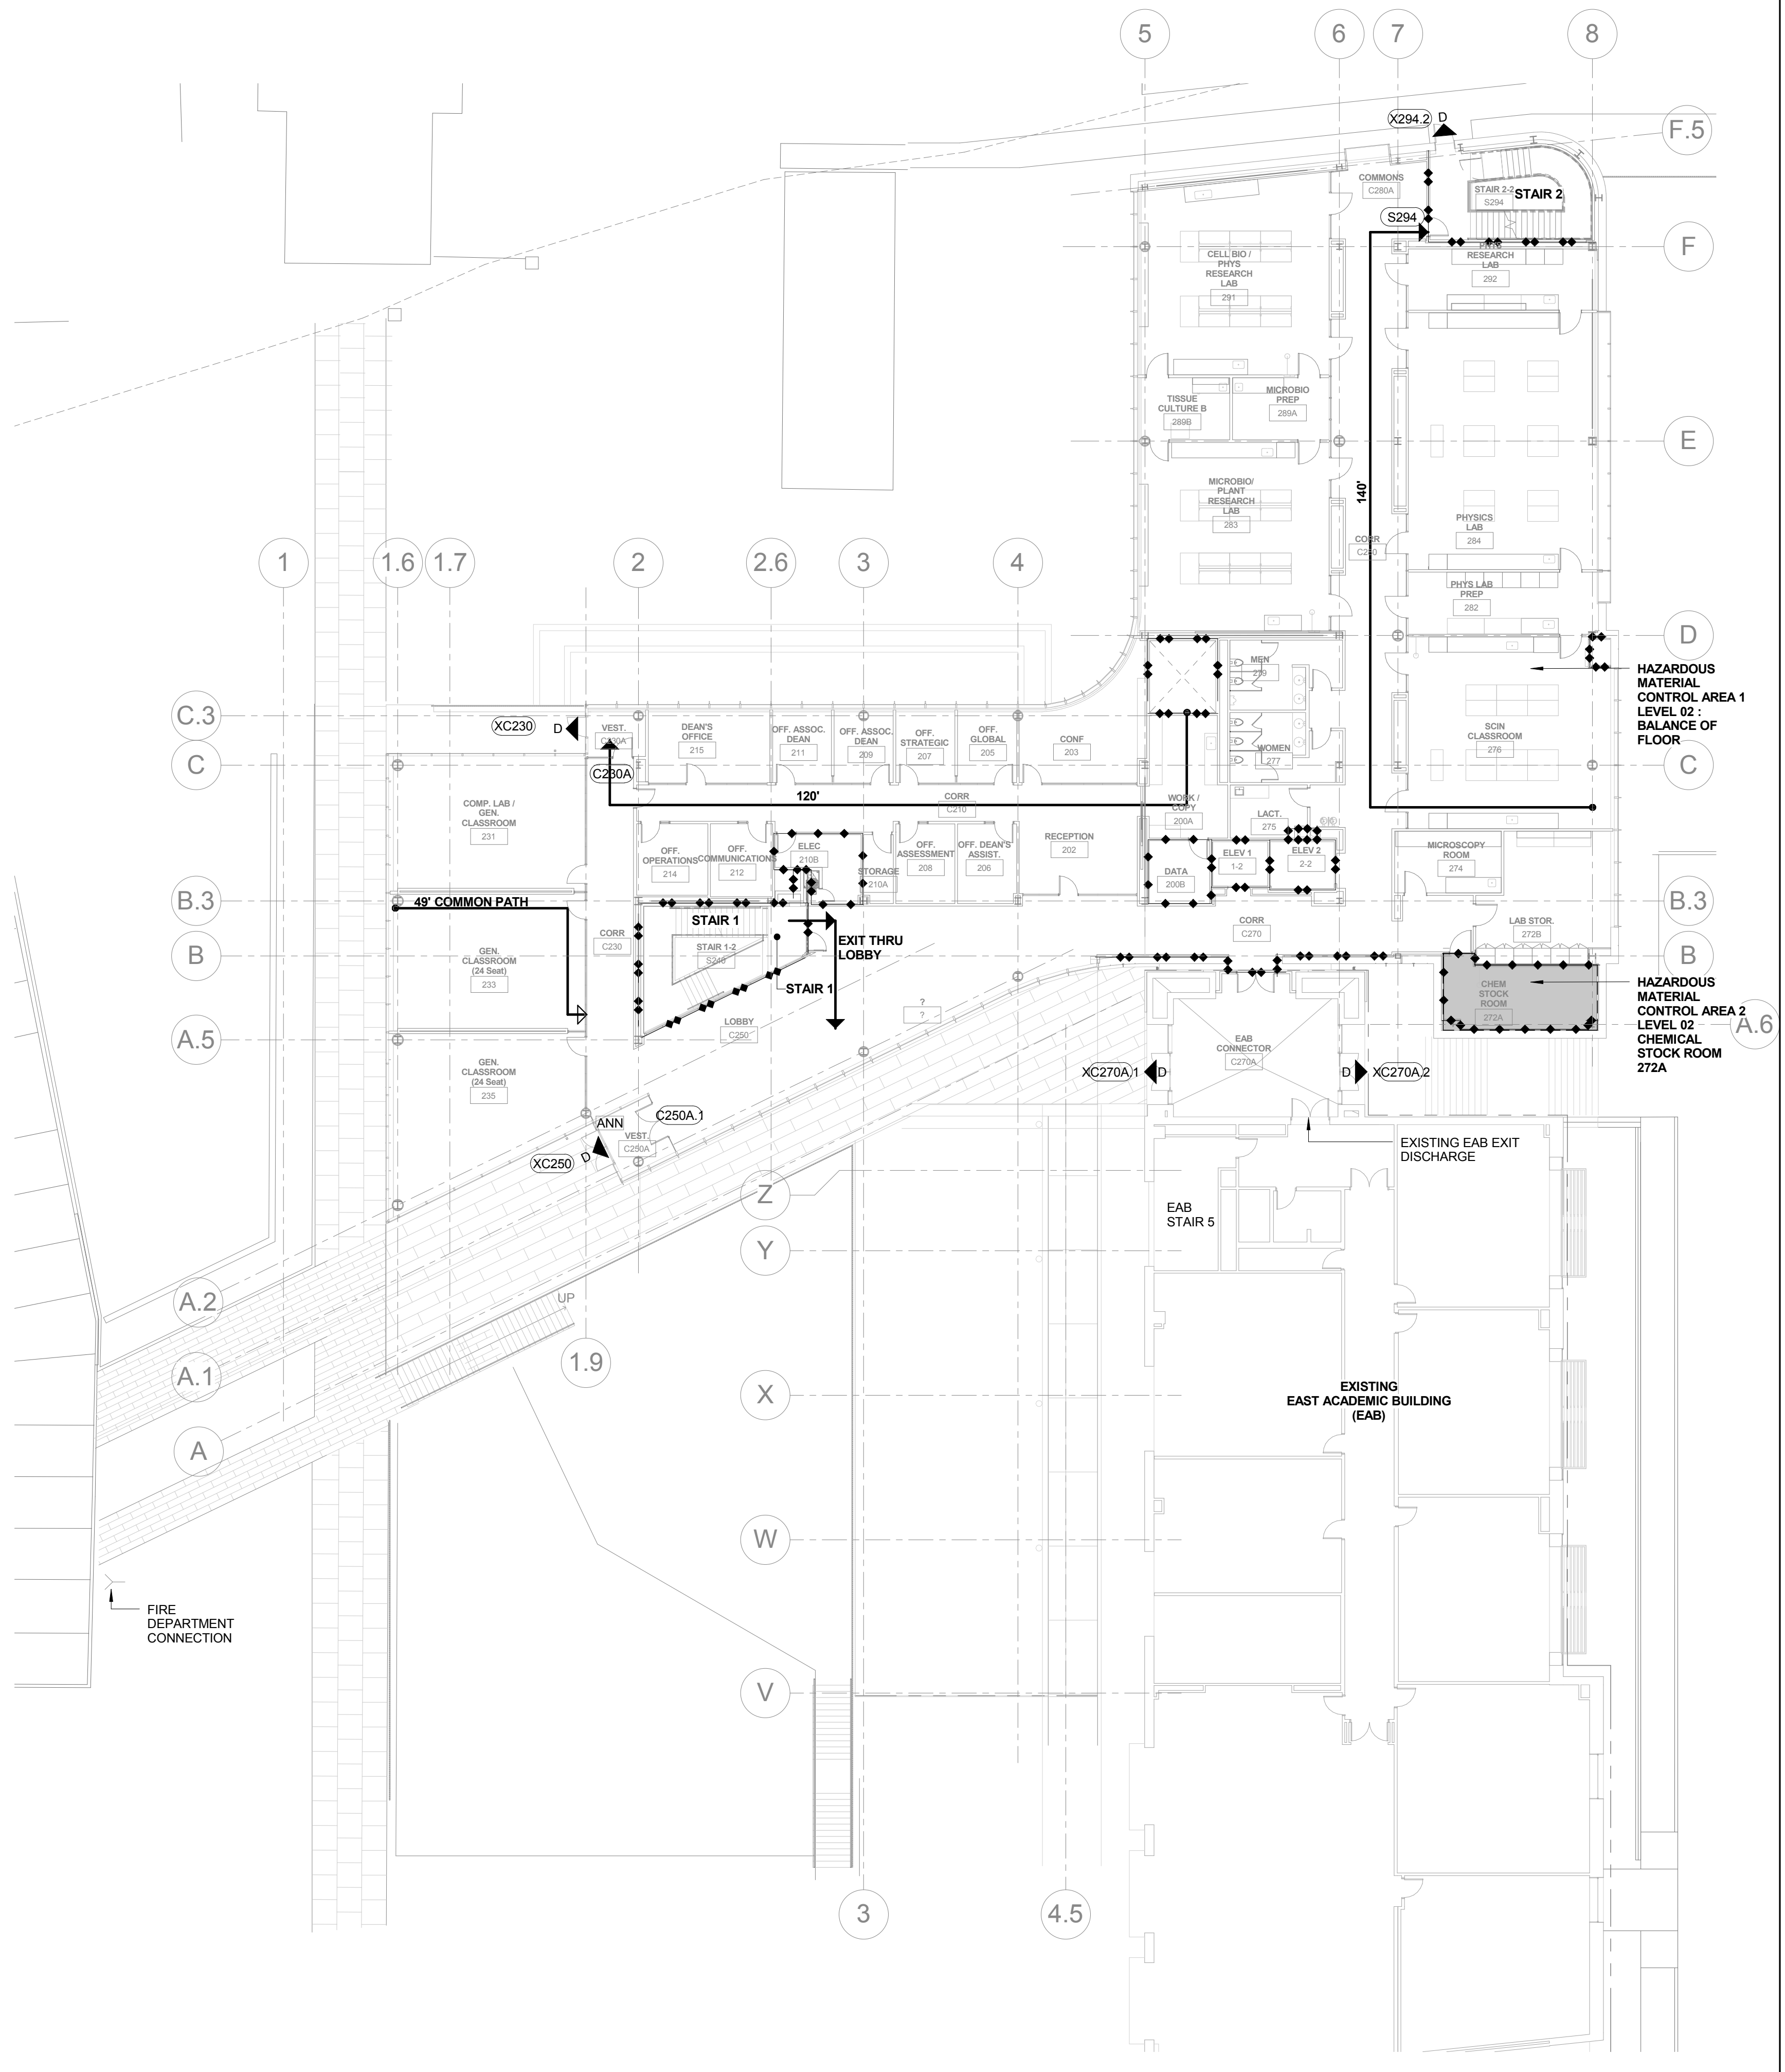

2 LEVEL 02 CODE COMPLIANCE PLAN
1/16" = 1'-0"