


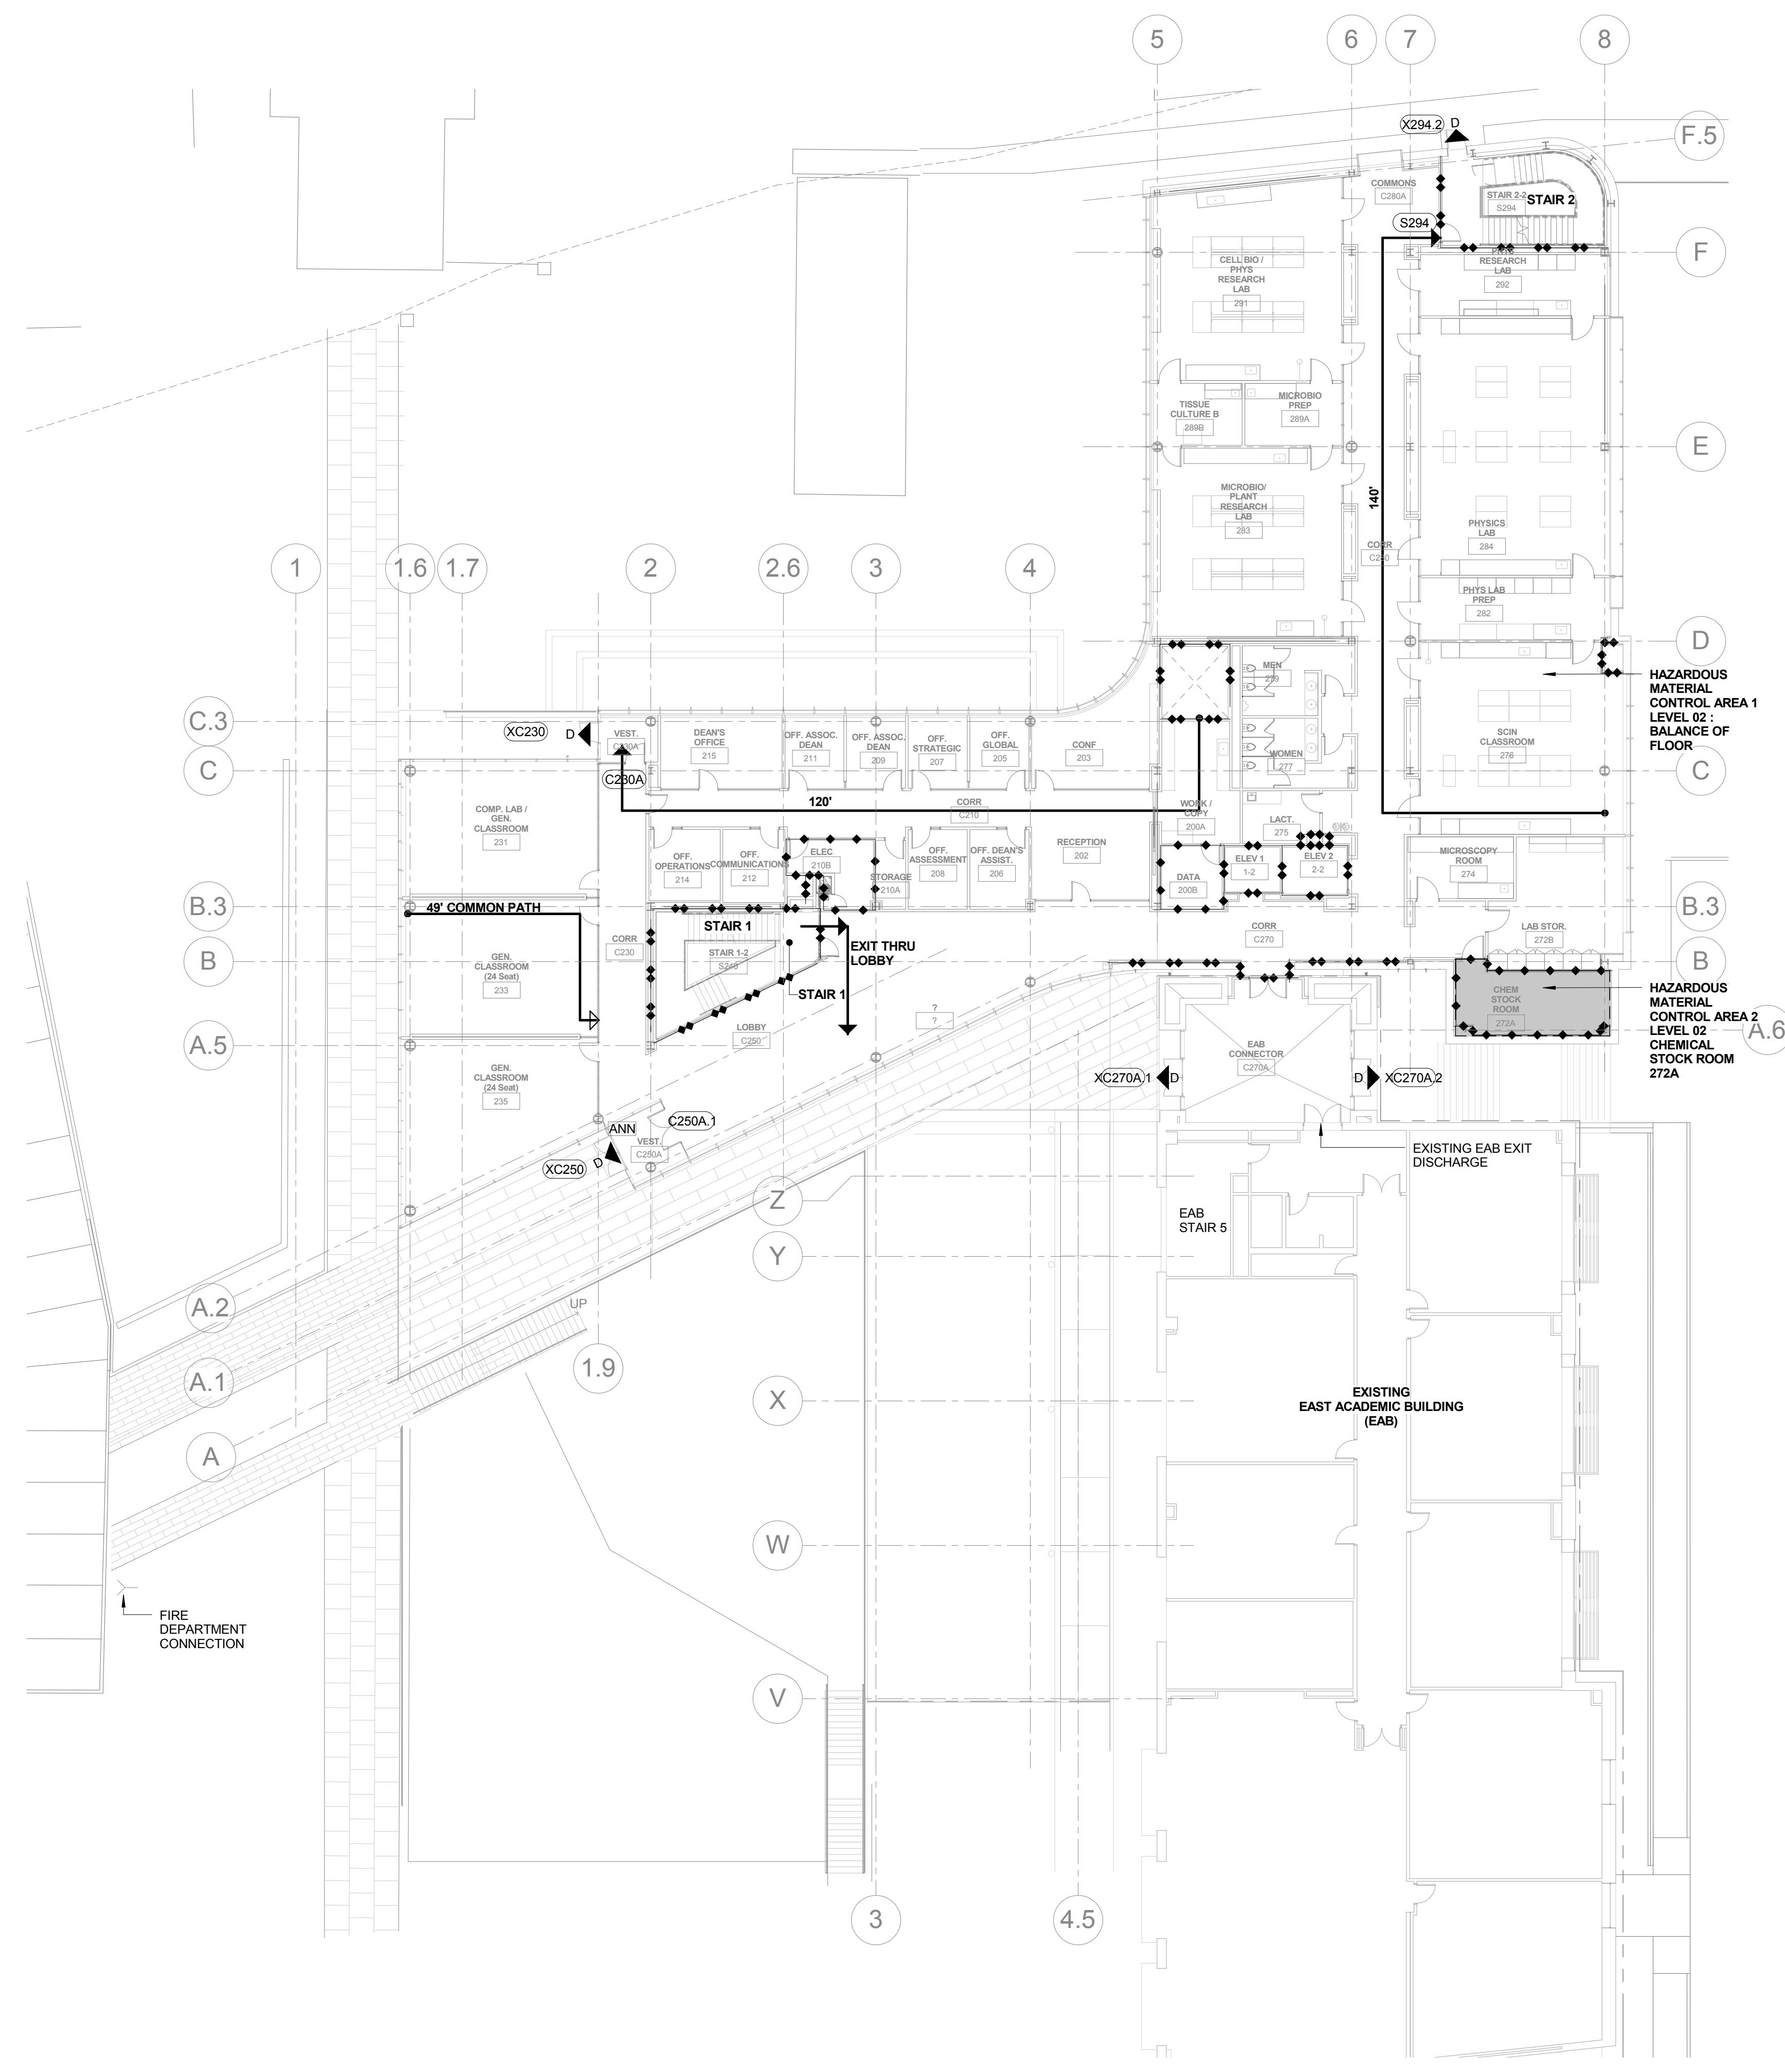

2 LEVEL 02 CODE COMPLIANCE PLAN
1/16" = 1'-0"

