



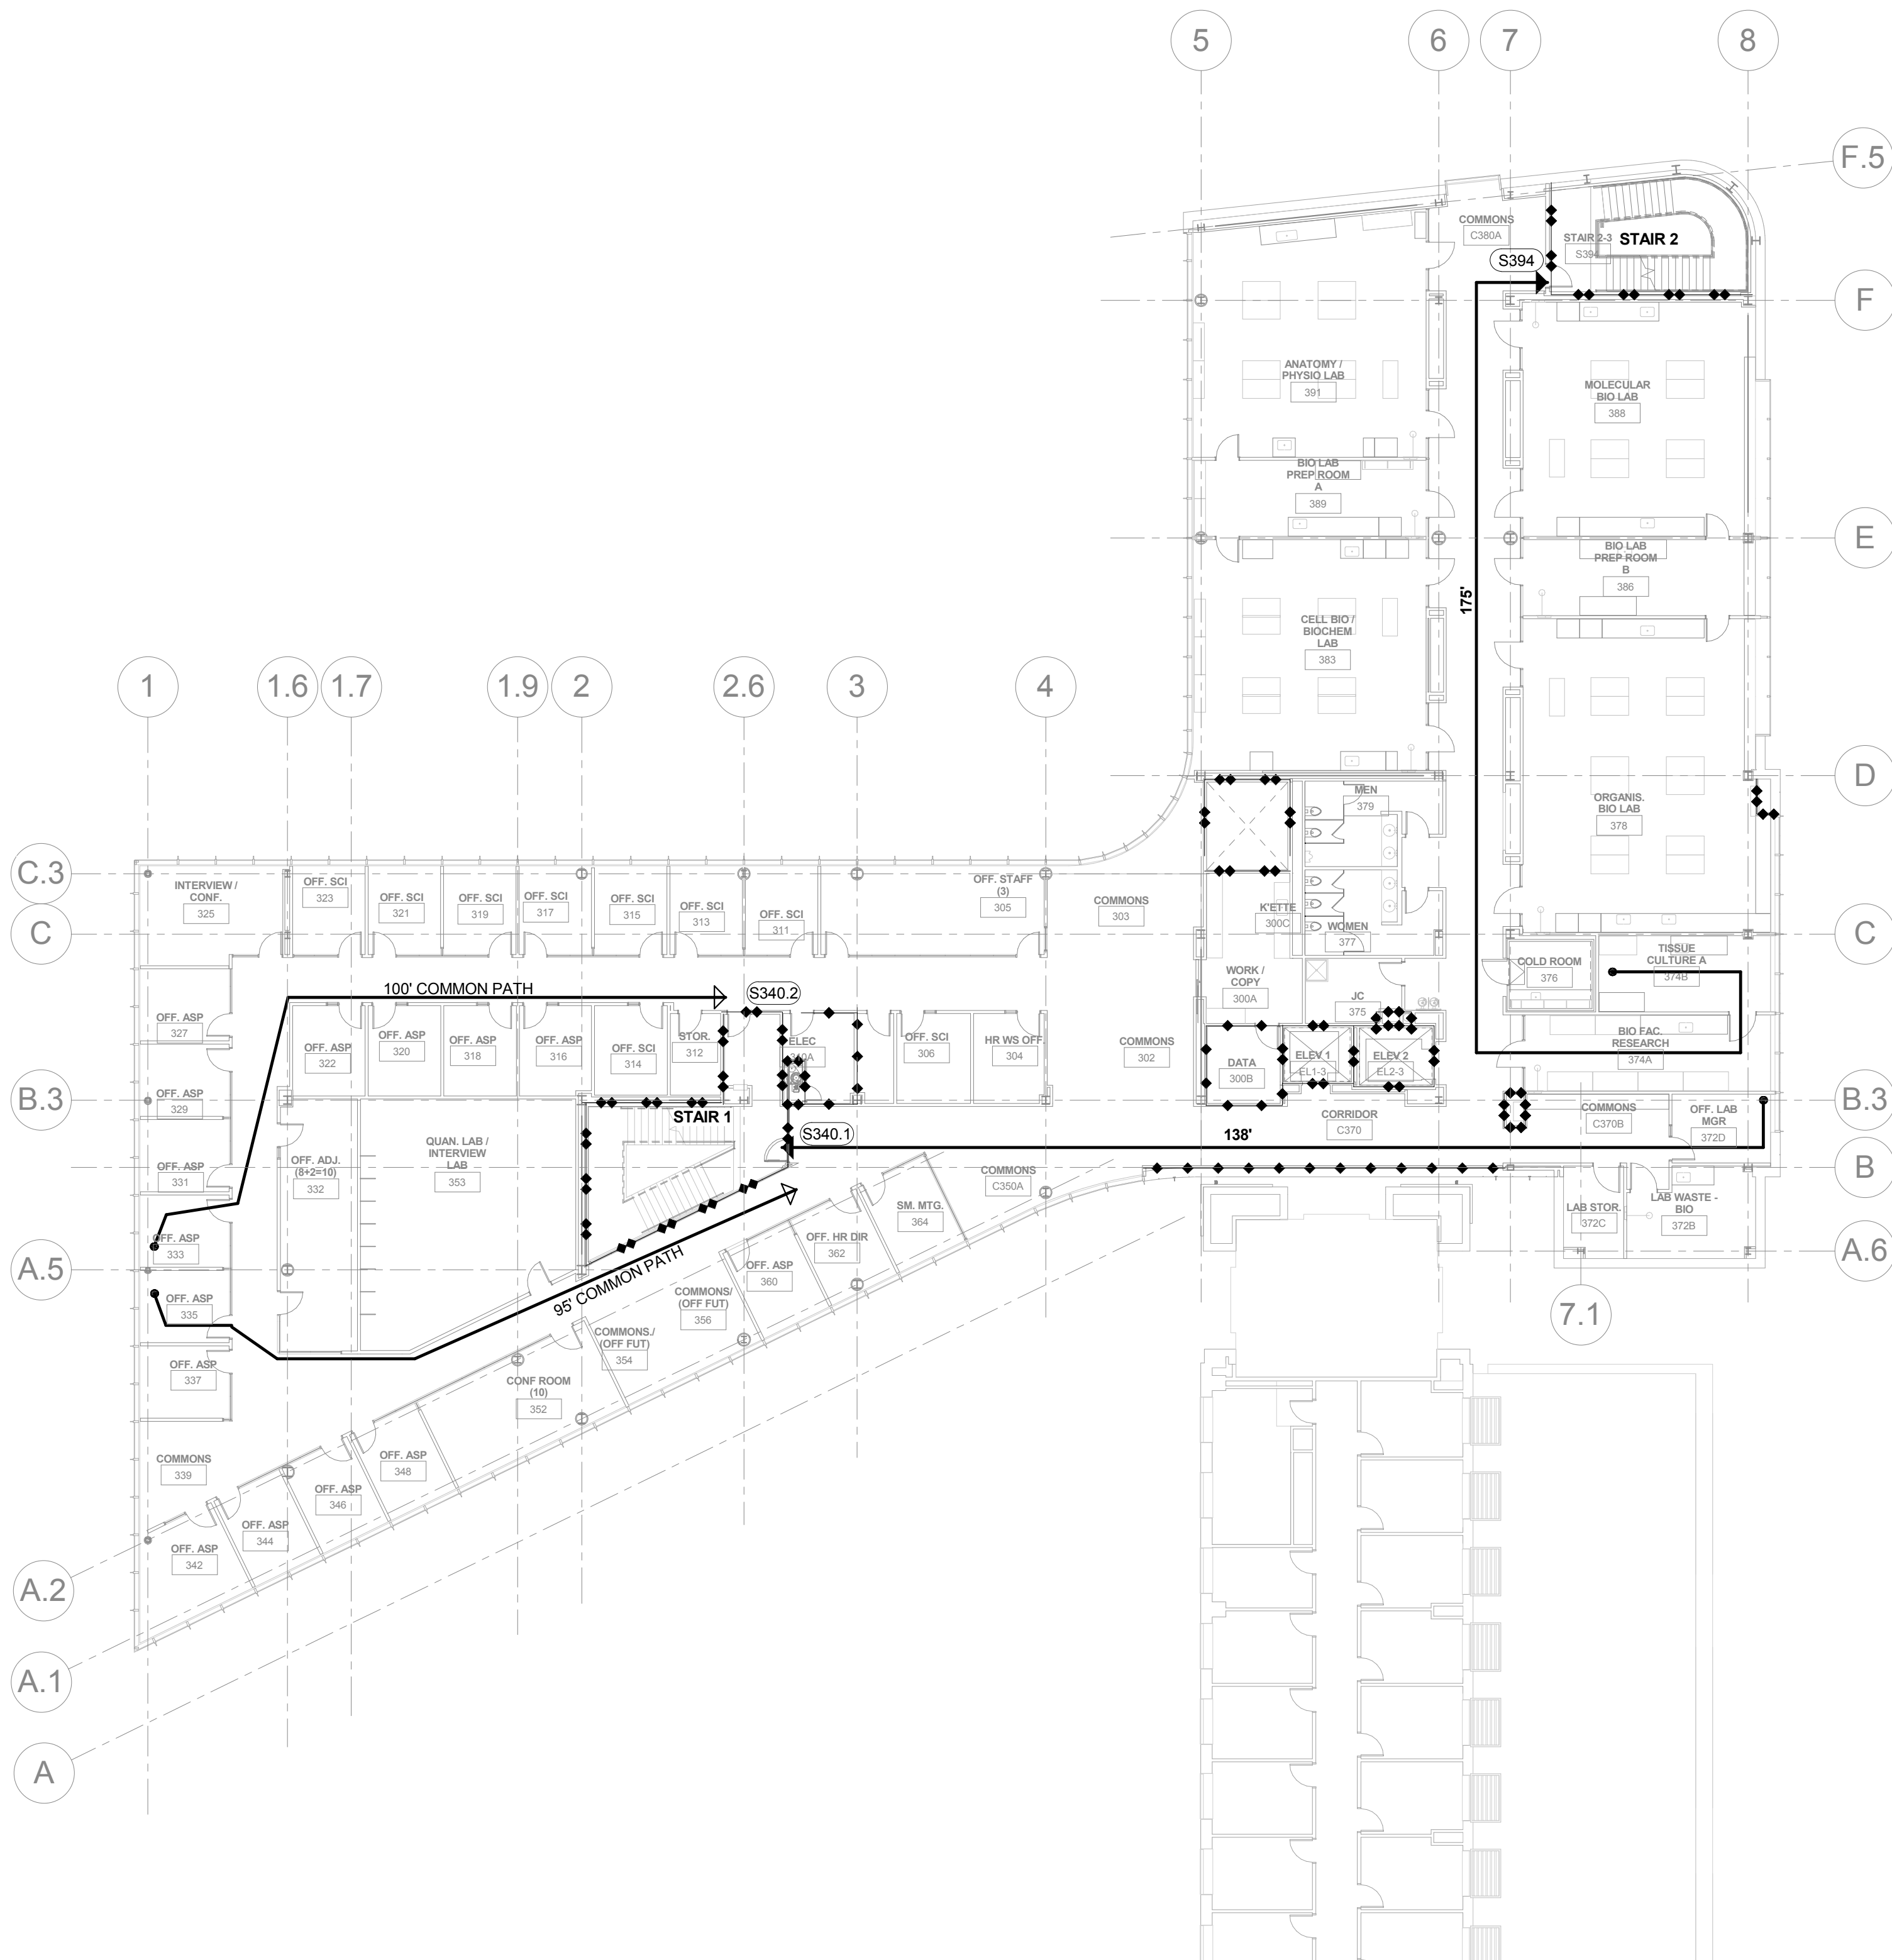


1 LEVEL 03 CODE COMPLIANCE PLAN
1/16" = 1'-0"

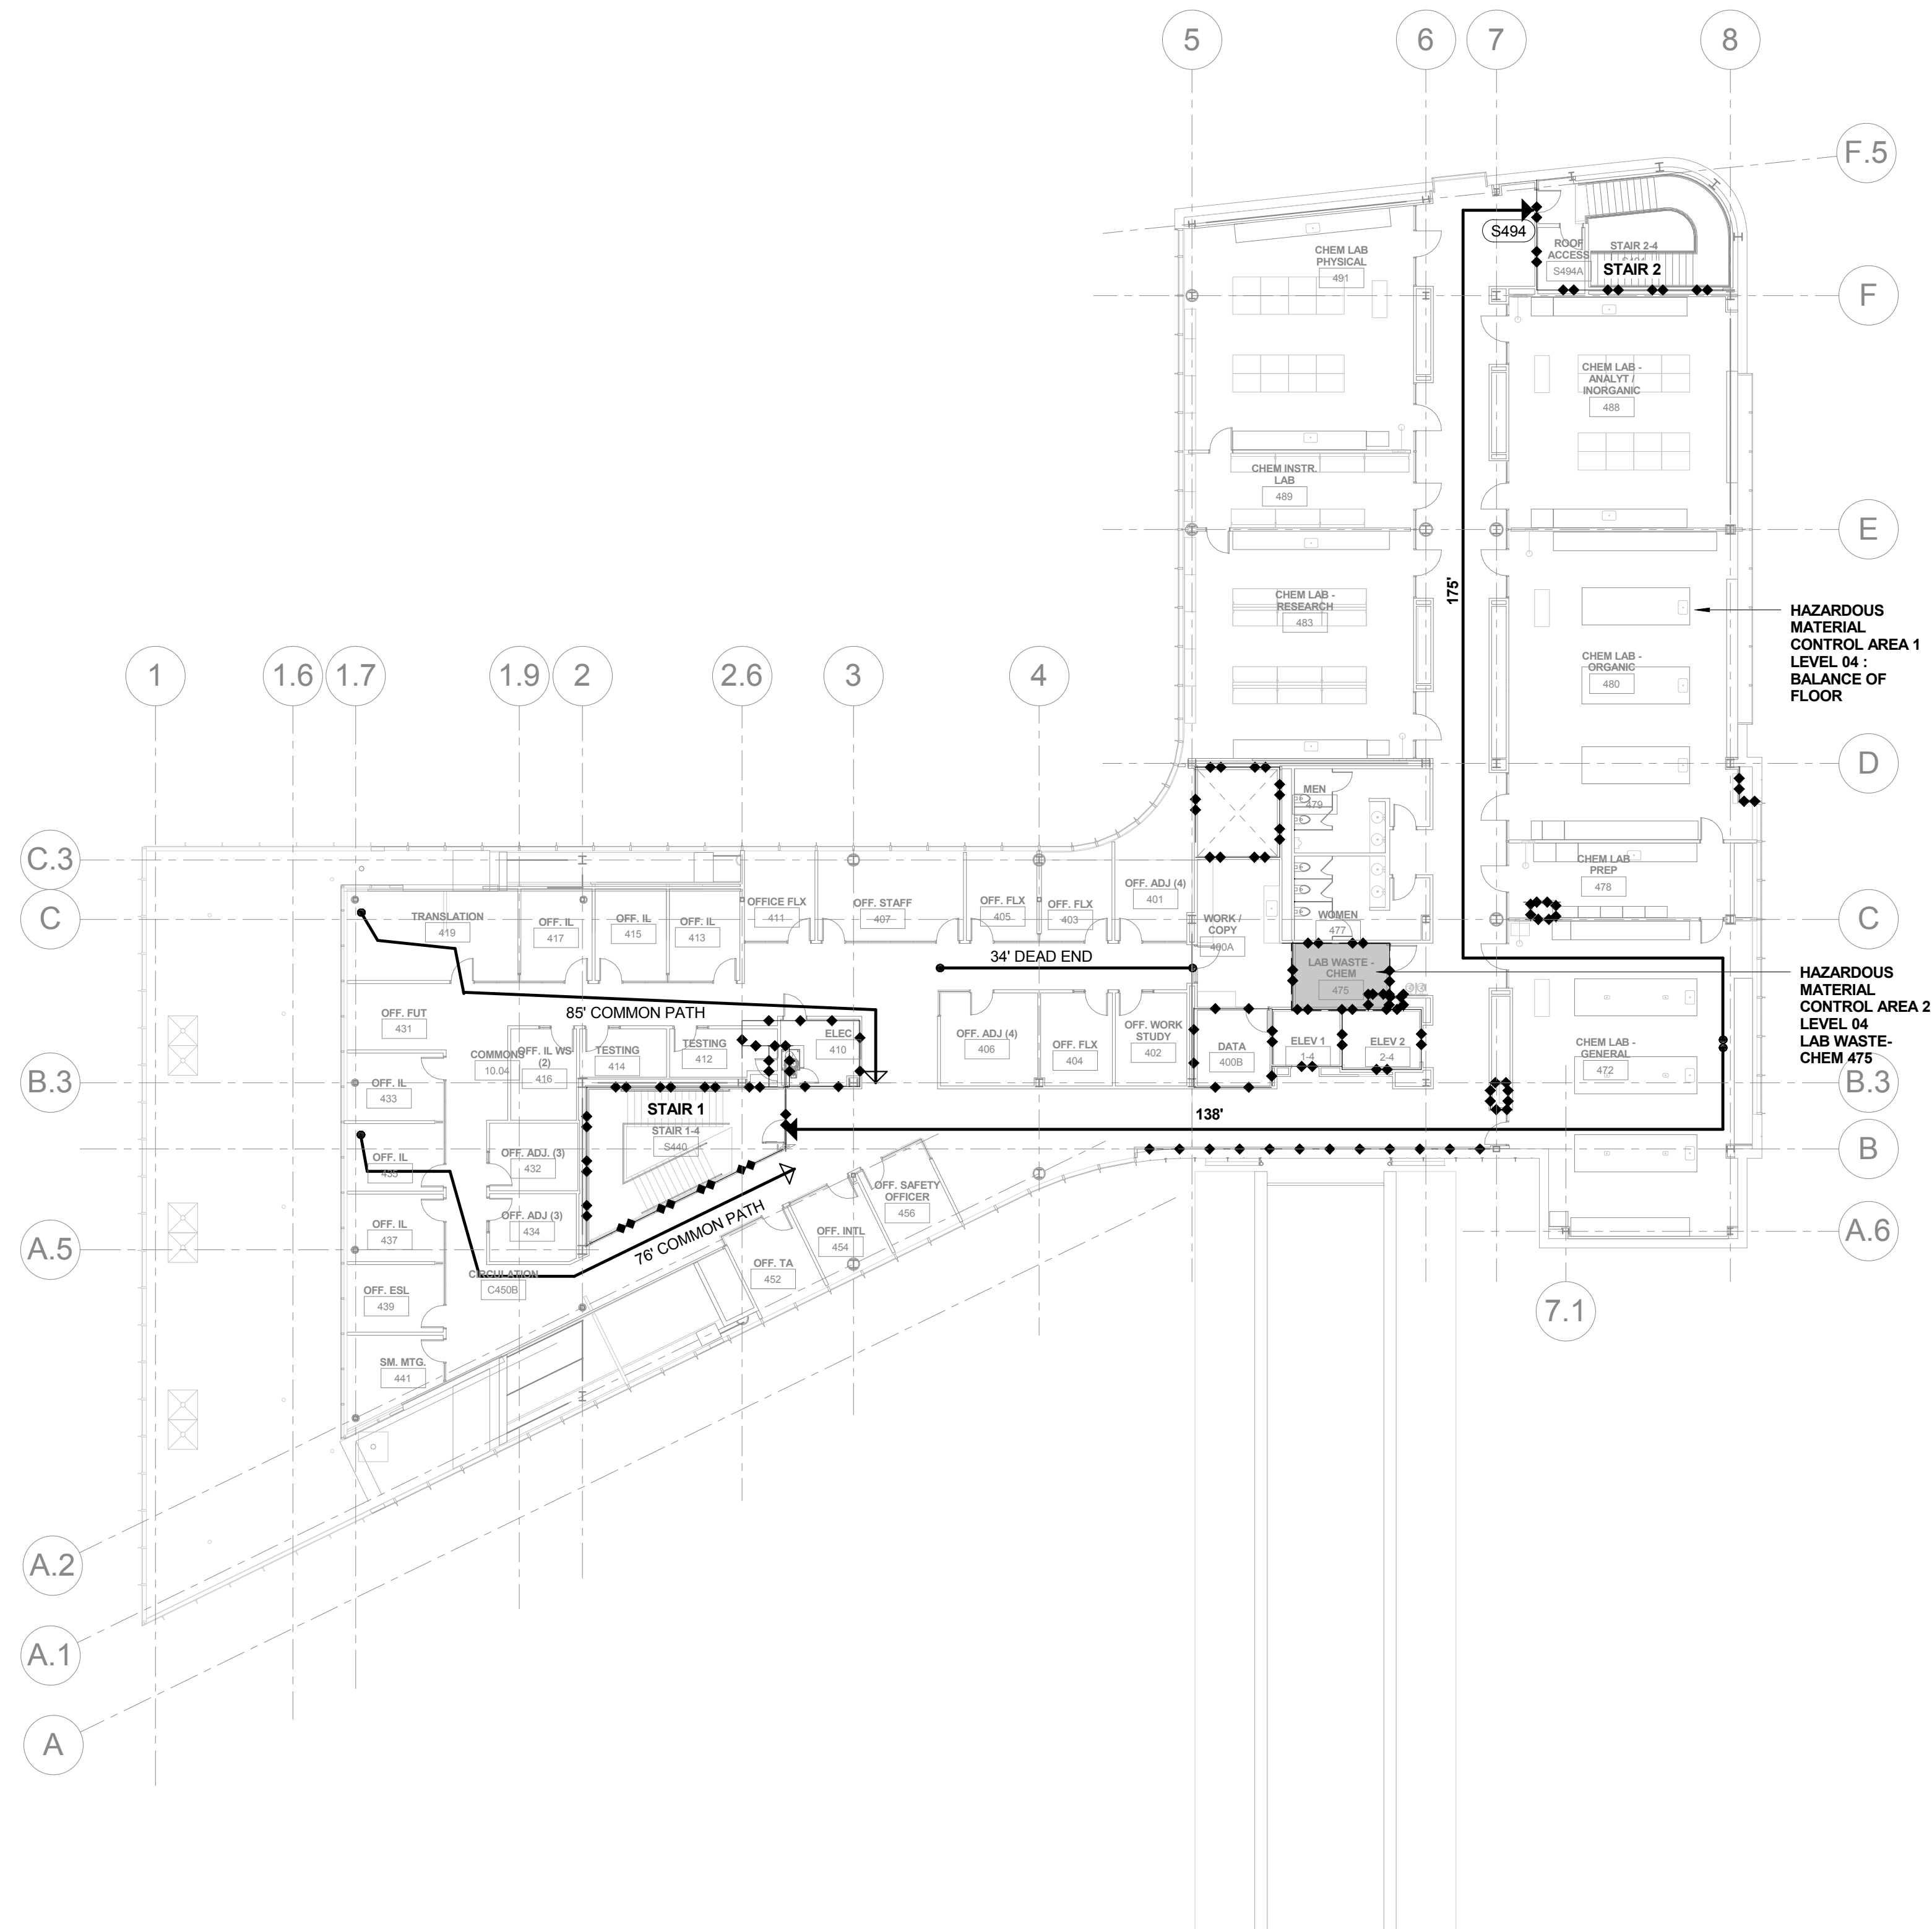

2 LEVEL 04 CODE COMPLIANCE PLAN
1/16" = 1'-0"

1	ADDENDUM 1-6	01 MAR 2016
2	ISSUED FOR CONSTRUCTION (BP1)	15 JAN 2016
No.	Description	Date

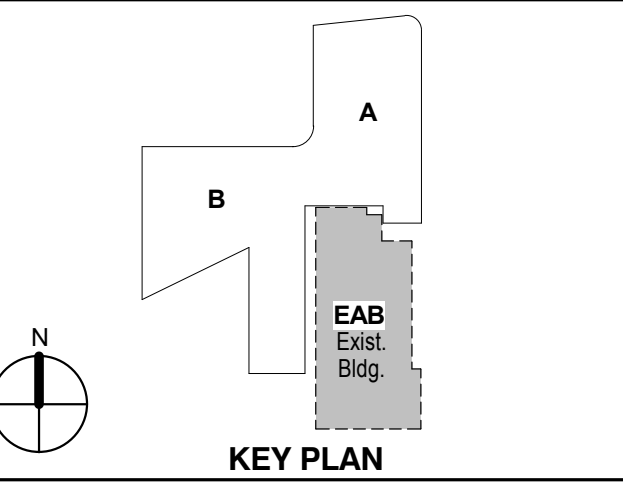

KEY PLAN

LEVEL 03 AND 04 CODE
COMPLIANCE PLAN

Project No.: 04561.01 Checked by:

G0203