


BOUNDARY & PARTIAL TOPOGRAPHIC SURVEY

A TRACT OF LAND BEING LOT 1 OF WEBSTER UNIVERSITY, PLAT 1,
AS RECORDED IN PLAT BOOK 358, PAGES 243 & 244,
LOCATED IN THE CITY OF WEBSTER GROVES, ST. LOUIS COUNTY, MISSOURI

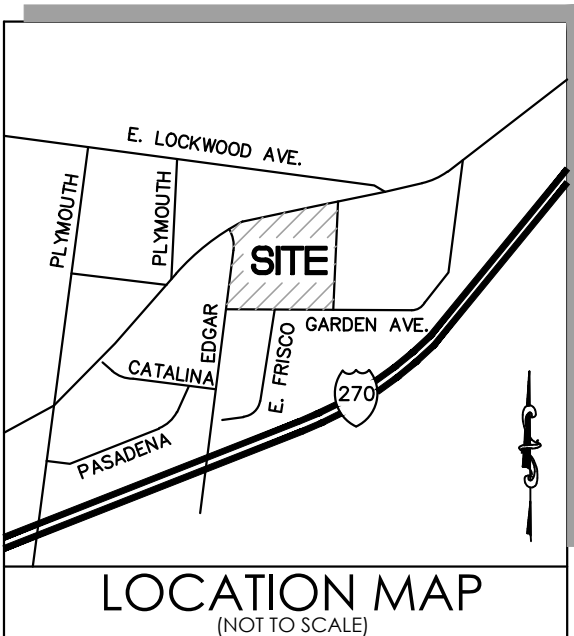


INTERDISCIPLINARY
SCIENCES BLDG.

WEBSTER
UNIVERSITY

PREPARED FOR:

WEBSTER UNIVERSITY
Attn: Mr. Craig A. Miller, Sr.
470 East Lockwood Ave.
Webster Groves, MO 63119
Phone: 314.246.7773

PREPARED BY:

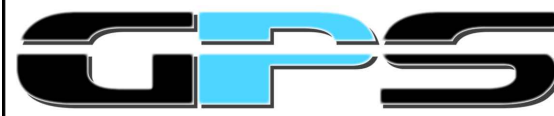

GLASPER PROFESSIONAL SERVICES, INC.
Engineering | Surveying

13100 Manchester Road | Suite 85
St. Louis, Missouri 63131
p: 314-966-9987 | f: 314-966-0329
http://www.glasperps.com

Missouri Engineering Corporation
Certificate of Authority No.: 2011027007

Missouri Land Surveying Corporation
Certificate of Authority No.: 2011027103

EXCELLENCE Every Project
On Target • On Time • On Budget



SIGNATURE

DATE: TIMOTHY E. BAUER, PLS
MISSOURI LICENSE NO. 2012018388

THE SEAL AND SIGNATURE APPLY ONLY TO THE DOCUMENT TO WHICH
THEY ARE AFFIXED. THE SIGNER OF THIS DOCUMENT EXPRESSLY
DISCLAIMS ANY AND ALL RESPONSIBILITY FOR DOCUMENTS THAT DO
NOT BEAR HIS SEAL AND SIGNATURE INCLUDING, BUT NOT NECESSARILY
LIMITED TO, DRAWINGS, SPECIFICATIONS, ESTIMATES, REPORTS AND
OTHER SIMILAR INSTRUMENTS OF SERVICES INTENDED TO BE USED FOR
THIS PROJECT.

DRAWING ISSUE

NO. 1 DATE: 1/7/2015

ORIGINAL ISSUE

NO. 2 DATE: 10/19/2015

ADDED ADDTL TOPOGRAPHY

NO. 3 DATE: 12/21/2015

UPDATE SEWER INFO

NO. 4 DATE: 4/25/2016

ADDITIONAL SURVEY AND FINISHED
FLOOR VERIFICATIONS

DRAWN BY: R.S.B.

CHECKED BY: T.E.B.

PROJECT NO. 14-142

MSD P - NUMBER -

MSD BASE MAP 23K

ST. LOUIS COUNTY NO. -

ZIP CODE 63119

SHEET TITLE
BOUNDARY & PARTIAL
TOPOGRAPHIC
SURVEY

SHEET

2 of 4

© Glasper Professional Services, Inc. 2016



GRAPHIC SCALE



(IN FEET)
1 inch = 30 ft.

BIG BEND (VARIABLE-WIDTH) BOULEVARD

S11° 42' 24"E
60.07'

S11° 42' 24"E
60.10'

10'w EASEMENT TO
MISSOURI-AMERICAN
WATER COMPANY
DB. 16855, PG. 2885
(ITEM No. 11)

10'w EASEMENT TO
MISSOURI-AMERICAN
WATER COMPANY
DB. 16855, PG. 2885
(ITEM No. 11)



10'w EASEMENT TO
MISSOURI-AMERICAN
WATER COMPANY
DB. 16855, PG. 2885
(ITEM No. 11)

10'w EASEMENT TO
MISSOURI-AMERICAN
WATER COMPANY
DB. 16855, PG. 2885
(ITEM No. 11)

10'w EASEMENT TO
MISSOURI-AMERICAN
WATER COMPANY
DB. 16855, PG. 2885
(ITEM No. 11)

10'w EASEMENT TO
MISSOURI-AMERICAN
WATER COMPANY
DB. 16855, PG.

A TRACT OF LAND BEING LOT 1 OF WEBSTER UNIVERSITY, PLAT 1,
AS RECORDED IN PLAT BOOK 358, PAGES 243 & 244,
LOCATED IN THE CITY OF WEBSTER GROVES, ST. LOUIS COUNTY, MISSOURI

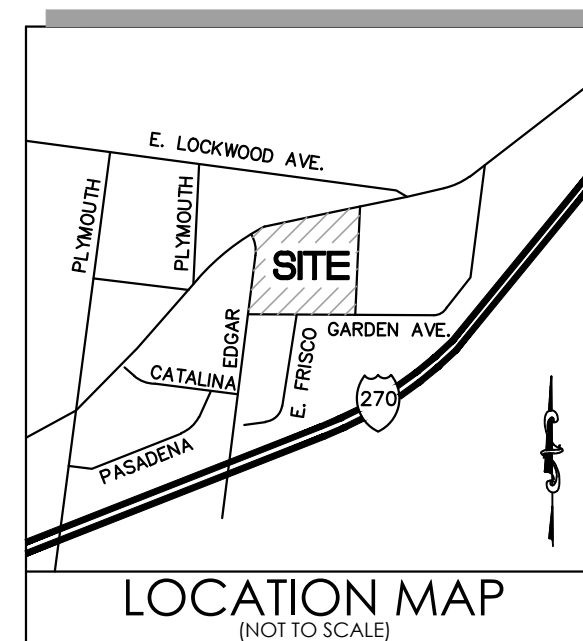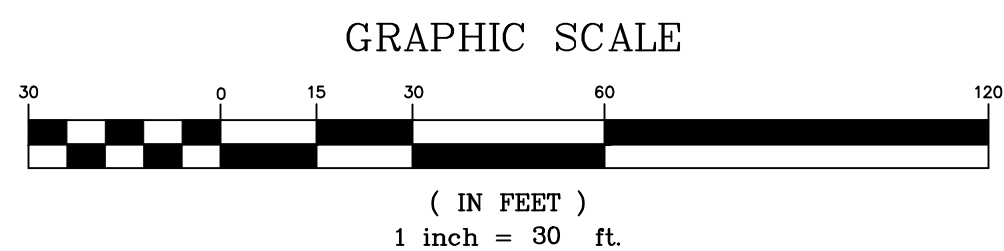


WEBSTER
UNIVERSITY

PREPARED FOR:

WEBSTER UNIVERSITY
Attn: Mr. Craig A. Miller, Sr.
470 East Lockwood Ave.
Webster Groves, MO 63119
Phone: 314.246.7773

PREPARED BY:

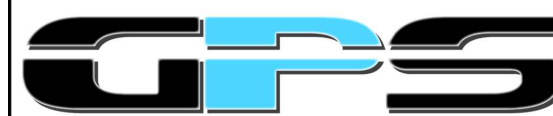

GLASPER PROFESSIONAL SERVICES, INC
Engineering | Surveying

13100 Manchester Road || Suite 85
St. Louis, Missouri 63131
p: 314-966-9987 || f: 314-966-0329
<http://www.glasperps.com>

Missouri Engineering Corporation
Certificate of Authority No.: 2011027007

Missouri Land Surveying Corporation
Certificate of Authority No.: 2011027103

EXCELLENCE *Every Project*
On Target • On Time • On Budget



SIGNATUR

DATE _____

TIMOTHY E. BAUER, PLS
MISSOURI LICENSE No. 2012018388

THE SEAL AND SIGNATURE APPLY ONLY TO THE DOCUMENT TO WHICH THEY ARE AFFIXED. THE SIGNER OF THIS DOCUMENT EXPRESSLY DISCLAIMS ANY AND ALL RESPONSIBILITY FOR DOCUMENTS THAT DO NOT BEAR HIS SEAL AND SIGNATURE INCLUDING, BUT NOT NECESSARILY LIMITED TO, DRAWINGS, SPECIFICATIONS, ESTIMATES, REPORTS AND OTHER SIMILAR INSTRUMENTS OF SERVICES INTENDED TO BE USED FOR THIS PROJECT.

DRAWING ISSUE

NO. 1 DATE: 1/7/2014

ORIGINAL ISSUE

NO. 2 DATE: 10/19/2015

ADDED ADDTL TOPOGRAPHY

NO. 3 DATE: 12/31/2019

UPDATE SEWER INFO

NO. 1 DATE: 4/05/2016

NO. 4 DATE: 4/25/2010
ADDITIONAL SURVEY AND FINISHED

FLOOR VERIFICATIONS

1. *Journal of the American Medical Association*, 2000; 283: 2639-2644.

DRAWN BY R.S.B.

CHECKED BY T.E.B.

PROJECT NO.	14-14
-------------	-------

MSD P - NUMBER

MSD BASE MAP 231

ST. LOUIS COUNTY NO.

ZIP CODE 63119


SHEET TITLE

BOUNDARY & PARTIAL
TOPOGRAPHIC
SURVEY


SHEET

3 of 4

© Glasper Professional Services, Inc. 2015

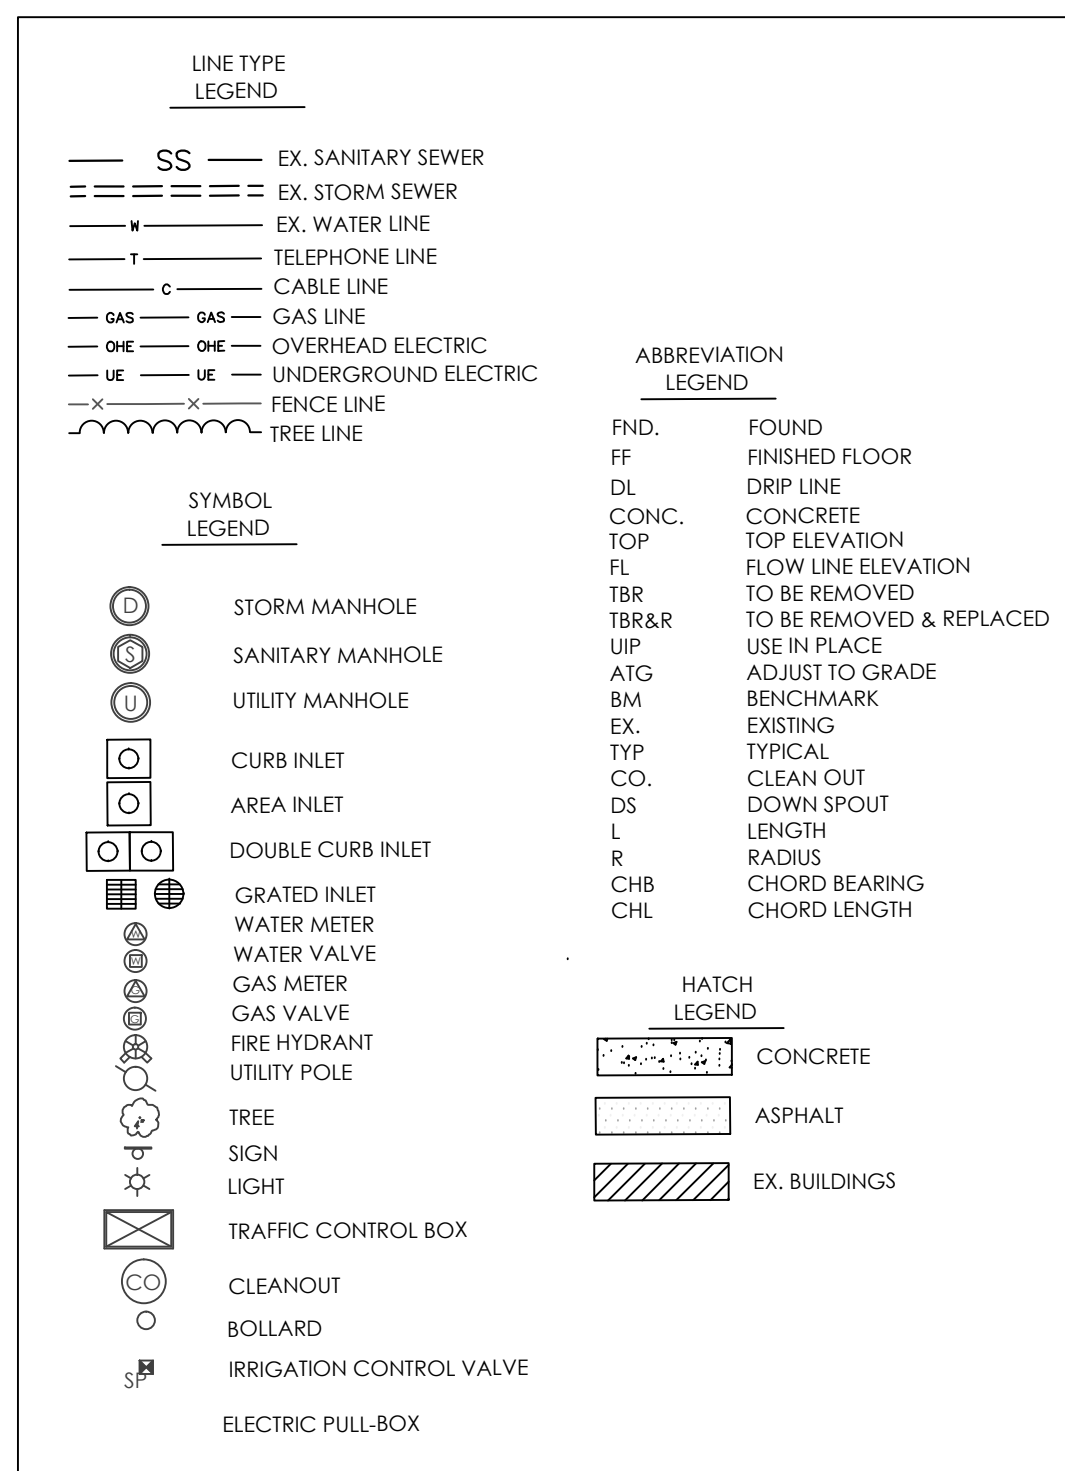

A TRACT OF LAND BEING LOT 1 OF WEBSTER UNIVERSITY, PLAT 1,
AS RECORDED IN PLAT BOOK 358, PAGES 243 & 244,
LOCATED IN THE CITY OF WEBSTER GROVES, ST. LOUIS COUNTY, MISSOURI

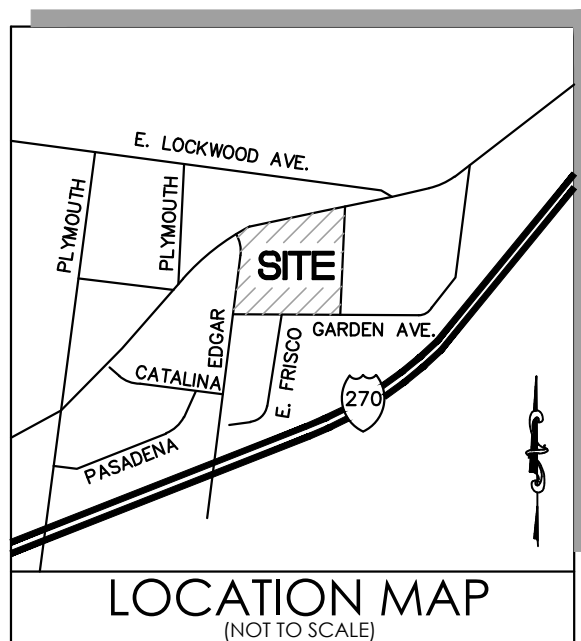

WEBSTER
UNIVERSITY

PREPARED FOR:

WEBSTER UNIVERSITY
Attn: Mr. Craig A. Miller, Sr.
470 East Lockwood Ave.
Webster Groves, MO 63119
Phone: 314.246.7773

PREPARED BY:



GLASPER PROFESSIONAL SERVICES, INC.
Engineering || Surveying

13100 Manchester Road || Suite 83
St. Louis, Missouri 63131
p: 314-966-9987 || f: 314-966-0329
<http://www.glasperps.com>

Missouri Engineering Corporation
Certificate of Authority No.: 2011027007

Missouri Land Surveying Corporation
Certificate of Authority No.: 2011027103

EXCELLENCE *Every Project*
On Target • On Time • On Budget



SIGNATUR

DATE _____
ROBERT STEPHEN BOYER, PLS
MISSOURI LICENSE No. 2013000040

THE SEAL AND SIGNATURE APPLY ONLY TO THE DOCUMENT TO WHICH THEY ARE AFFIXED. THE SIGNER OF THIS DOCUMENT EXPRESSLY DISCLAIMS ANY AND ALL RESPONSIBILITY FOR DOCUMENTS THAT DO NOT BEAR HIS SEAL AND SIGNATURE INCLUDING, BUT NOT NECESSARILY LIMITED TO, DRAWINGS, SPECIFICATIONS, ESTIMATES, REPORTS AND OTHER SIMILAR INSTRUMENTS OF SERVICES INTENDED TO BE USED FOR THIS PROJECT.

DRAWING ISSUE

NO. 1 DATE: 1/7/2015

NO. 2 DATE: 10/18/201

NO. 2 DATE: 10/01/2001

1 2 3 1040 1

NO. 4 DATE: 4/23/2016
ADDITIONAL SURVEY AND FINISHED
FLOOR VERIFICATIONS

DRAWN BY R.S.B.

CHECKED BY T.E.B.

PROJECT NO. 14-145

MSD P - NUMBER

MSD BASE MAP 231

ST. LOUIS COUNTY NO

ZIP CODE _____

SHEET TITLE
BOUNDARY & PARTIAL
TOPOGRAPHIC
SURVEY

SHEET

4 of 4

© Glasper Professional Services, Inc. 2015

