

SHADED AREAS ARE NOT INCLUDED IN SCOPE OF WORK FOR INTERIOR RENOVATION

1 KEYED NOTE

LVT-1 INSTALLATION DIRECTION.
INSTALL PARALLEL WITH DIRECTION OF SYMBOL

XX-#


LOCATION OF FLOORING MATERIAL TRANSITION

XX-#

SPECIFIED FINISH, REFERENCE FINISH SCHEDULE IF NOT NOTED.

INTERIORS SYMBOLS LEGEND
1/8" = 1'-0"

- 1 WWP-2 OPAQUE, WHITE (LAQUER FINISH) PANELS TO BE LOCATED FLOOR TO CEILING AT DESIGNATED LOCATIONS. SEE ELEVATIONS AND ENVIRONMENTAL GRAPHICS DRAWINGS FOR LAYOUT AND GRAPHIC INLAY.
- 2 WWP-1 TO BE USED ON FACES OF WALLS AND SOFFITS AT DESIGNATED LAB ENTRANCE RECESSES.
- 3 OPAQUE FINISH WOOD PERFORATED PANELS FOR ACOUSTICS WITH 1/2" FIBERGLASS ACOUSTICS WHITE BATTS BEHIND. TO BE PAINTED SCHEDULED WALL COLOR.
- 4 AP-1 FABRIC WRAPPED ACOUSTIC PANELS - FULL HEIGHT.
- 5 VERTICAL WOOD GRILLE SCREEN - REFER TO INTERIOR ELEVATIONS.
- 6 AWC-1 MARKER BOARD PAINT TO BE USED FULL HEIGHT.
- 7 CWC-1 CORK WALLCOVERING TO BE APPLIED 30" AFF TO CEILING.
- 8 EXTENTS OF WALL TILE. SEE SHEET ID0202 FOR FLOOR AND WALL PATTERN.
- 9 EXTENTS OF FAP-1 PANELS TO BE MOUNTED ABOVE WALL BASE.
- 10 WALL TO HAVE 3/16" SOUND COUSTIC PADS. PADS TO BE PAINTED SCHEDULED WALL COLOR.
- 11 COMBINATION AWC-1 MARKER BOARD PAINT AND CWC-1 CORK WALLCOVERING WALL TREATMENT. CWC-1 TO BE 40" WIDE SECTION ON NORTH SIDE OF WALL / REMAINDER OF WALL TO BE AWC-1. SEE ELEVATIONS ON ID0202 FOR TYPICAL.

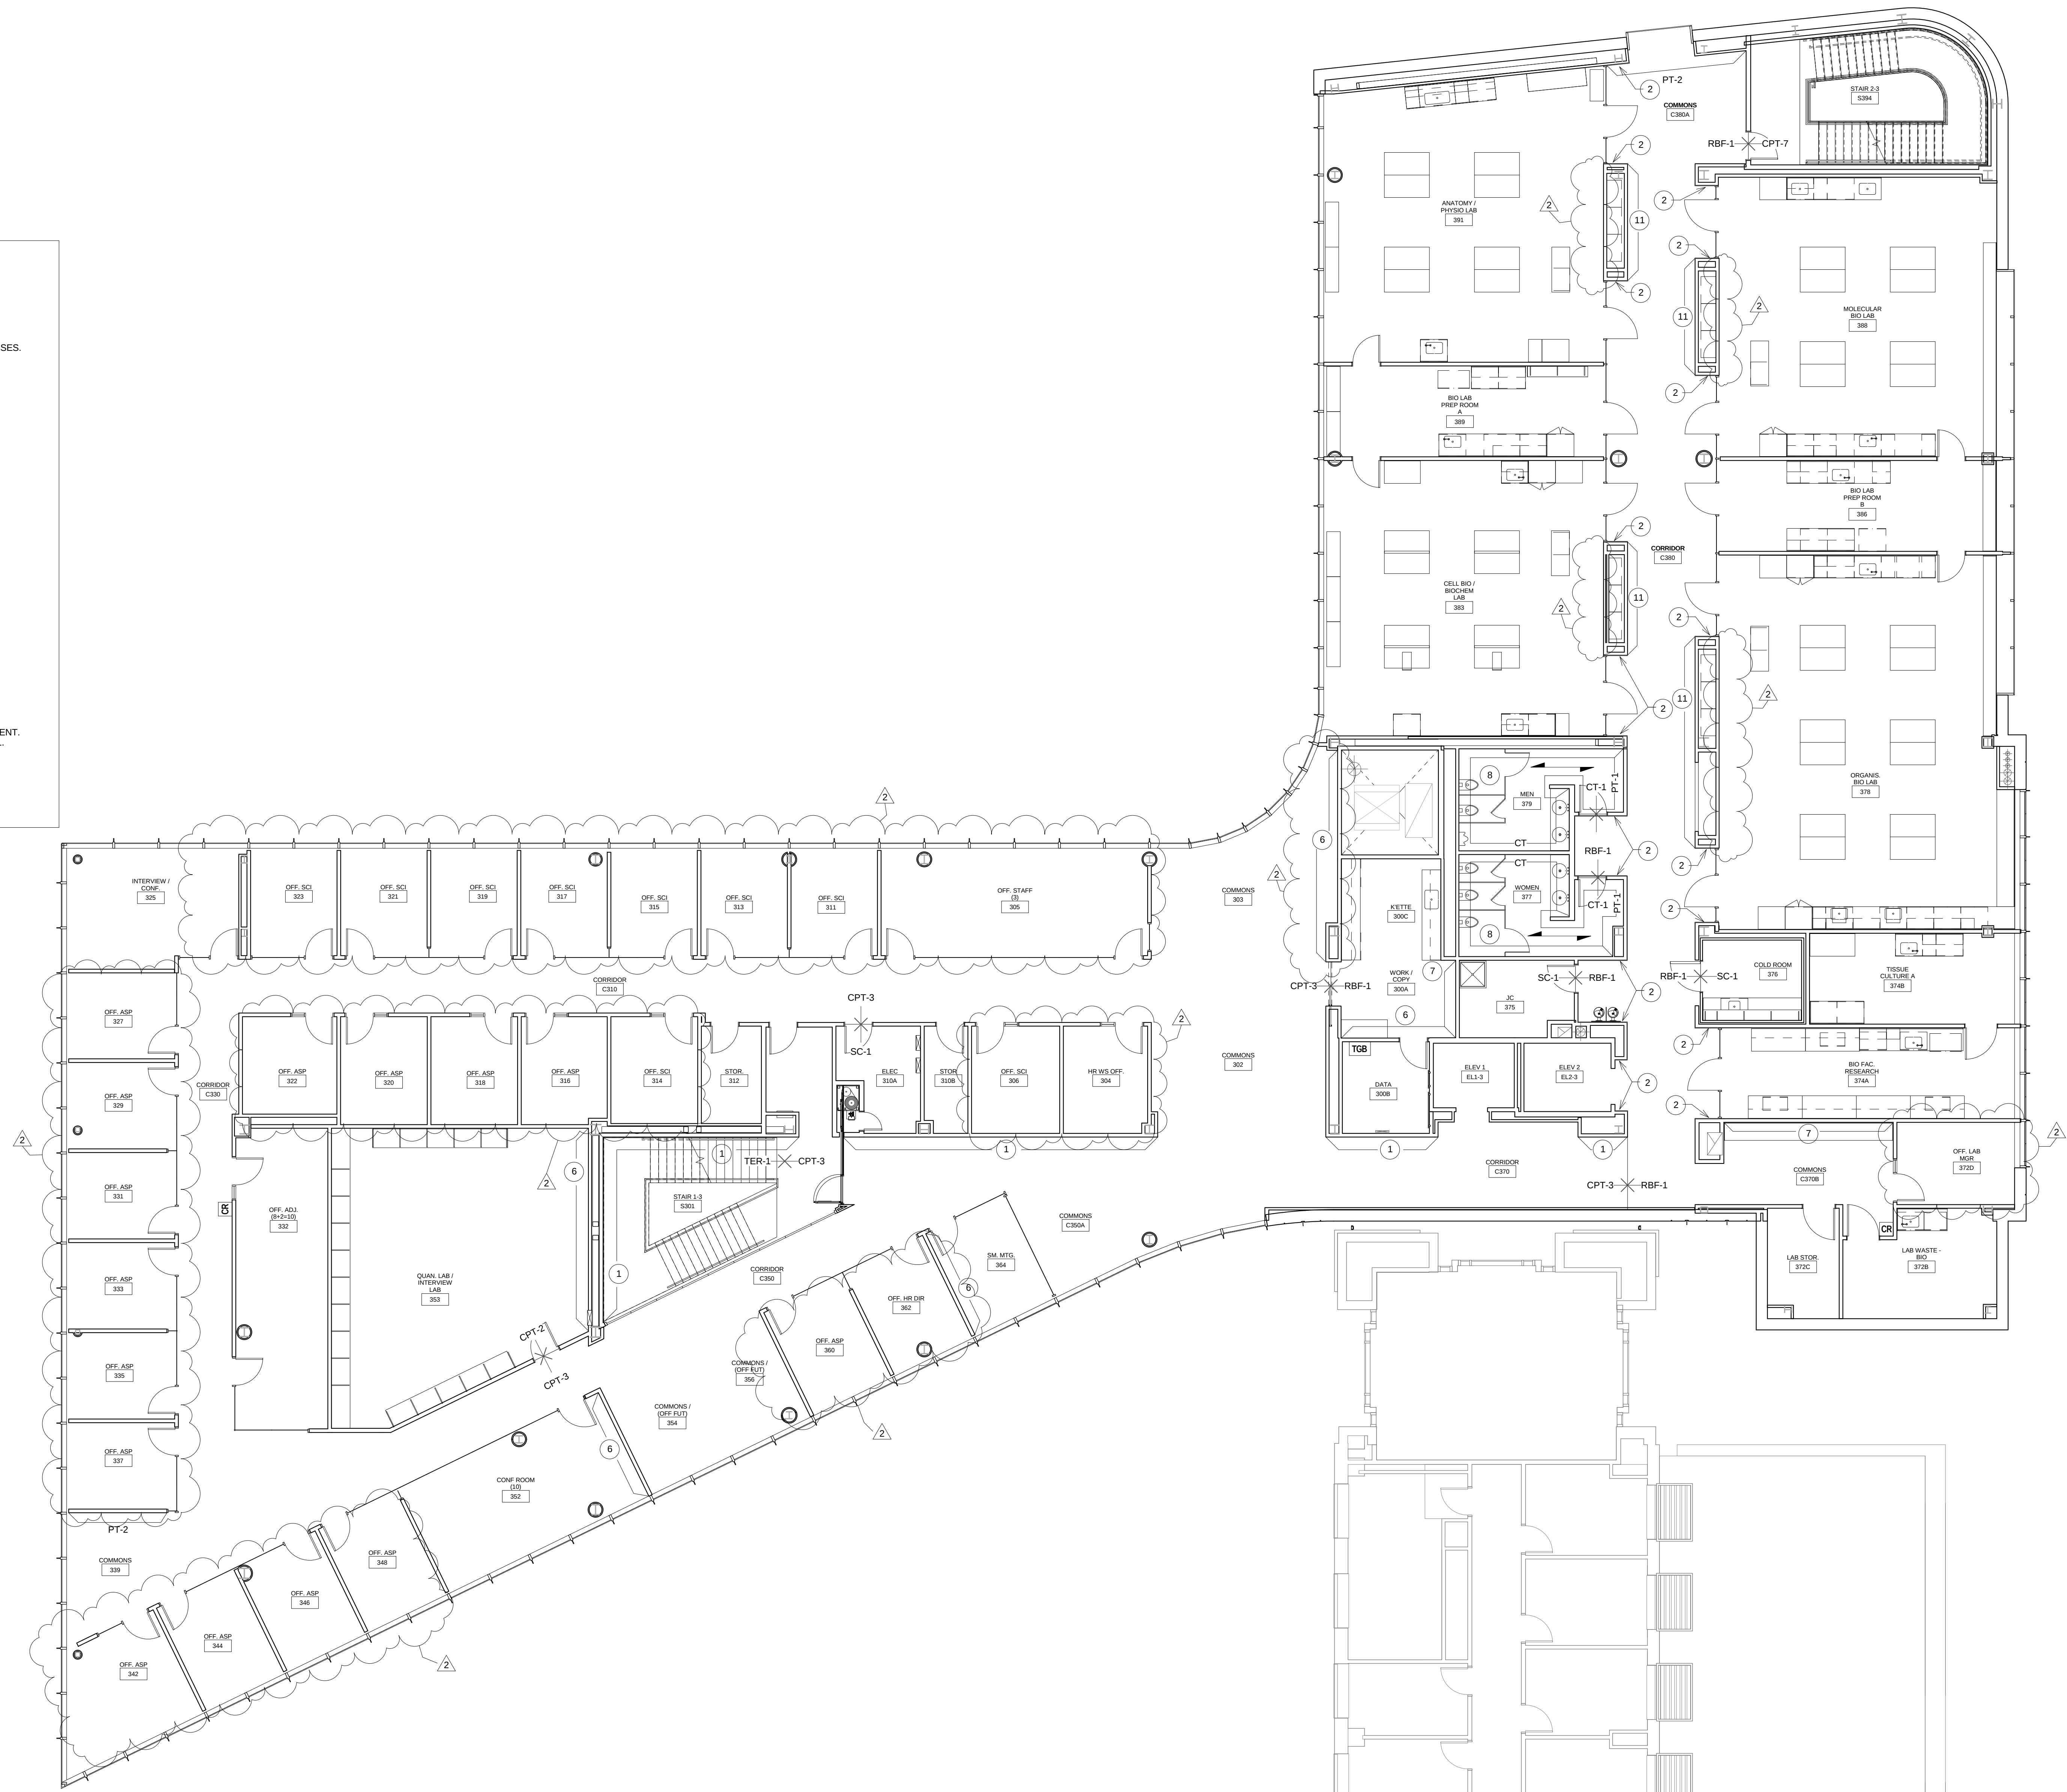

1 THIRD FLOOR TRANSITION PLAN
1/8" = 1'-0"



2	ASI-064	26 APR 2017
1	ADDENDUM 3-2	15 APR 2016
-	ISSUED FOR CONSTRUCTION (BP3)	15 MAR 2016
No.	Description	Date

Drawing Title:

THIRD FLOOR TRANSITION PLAN

Project No.: 04561.01

checked by:

ID0103