

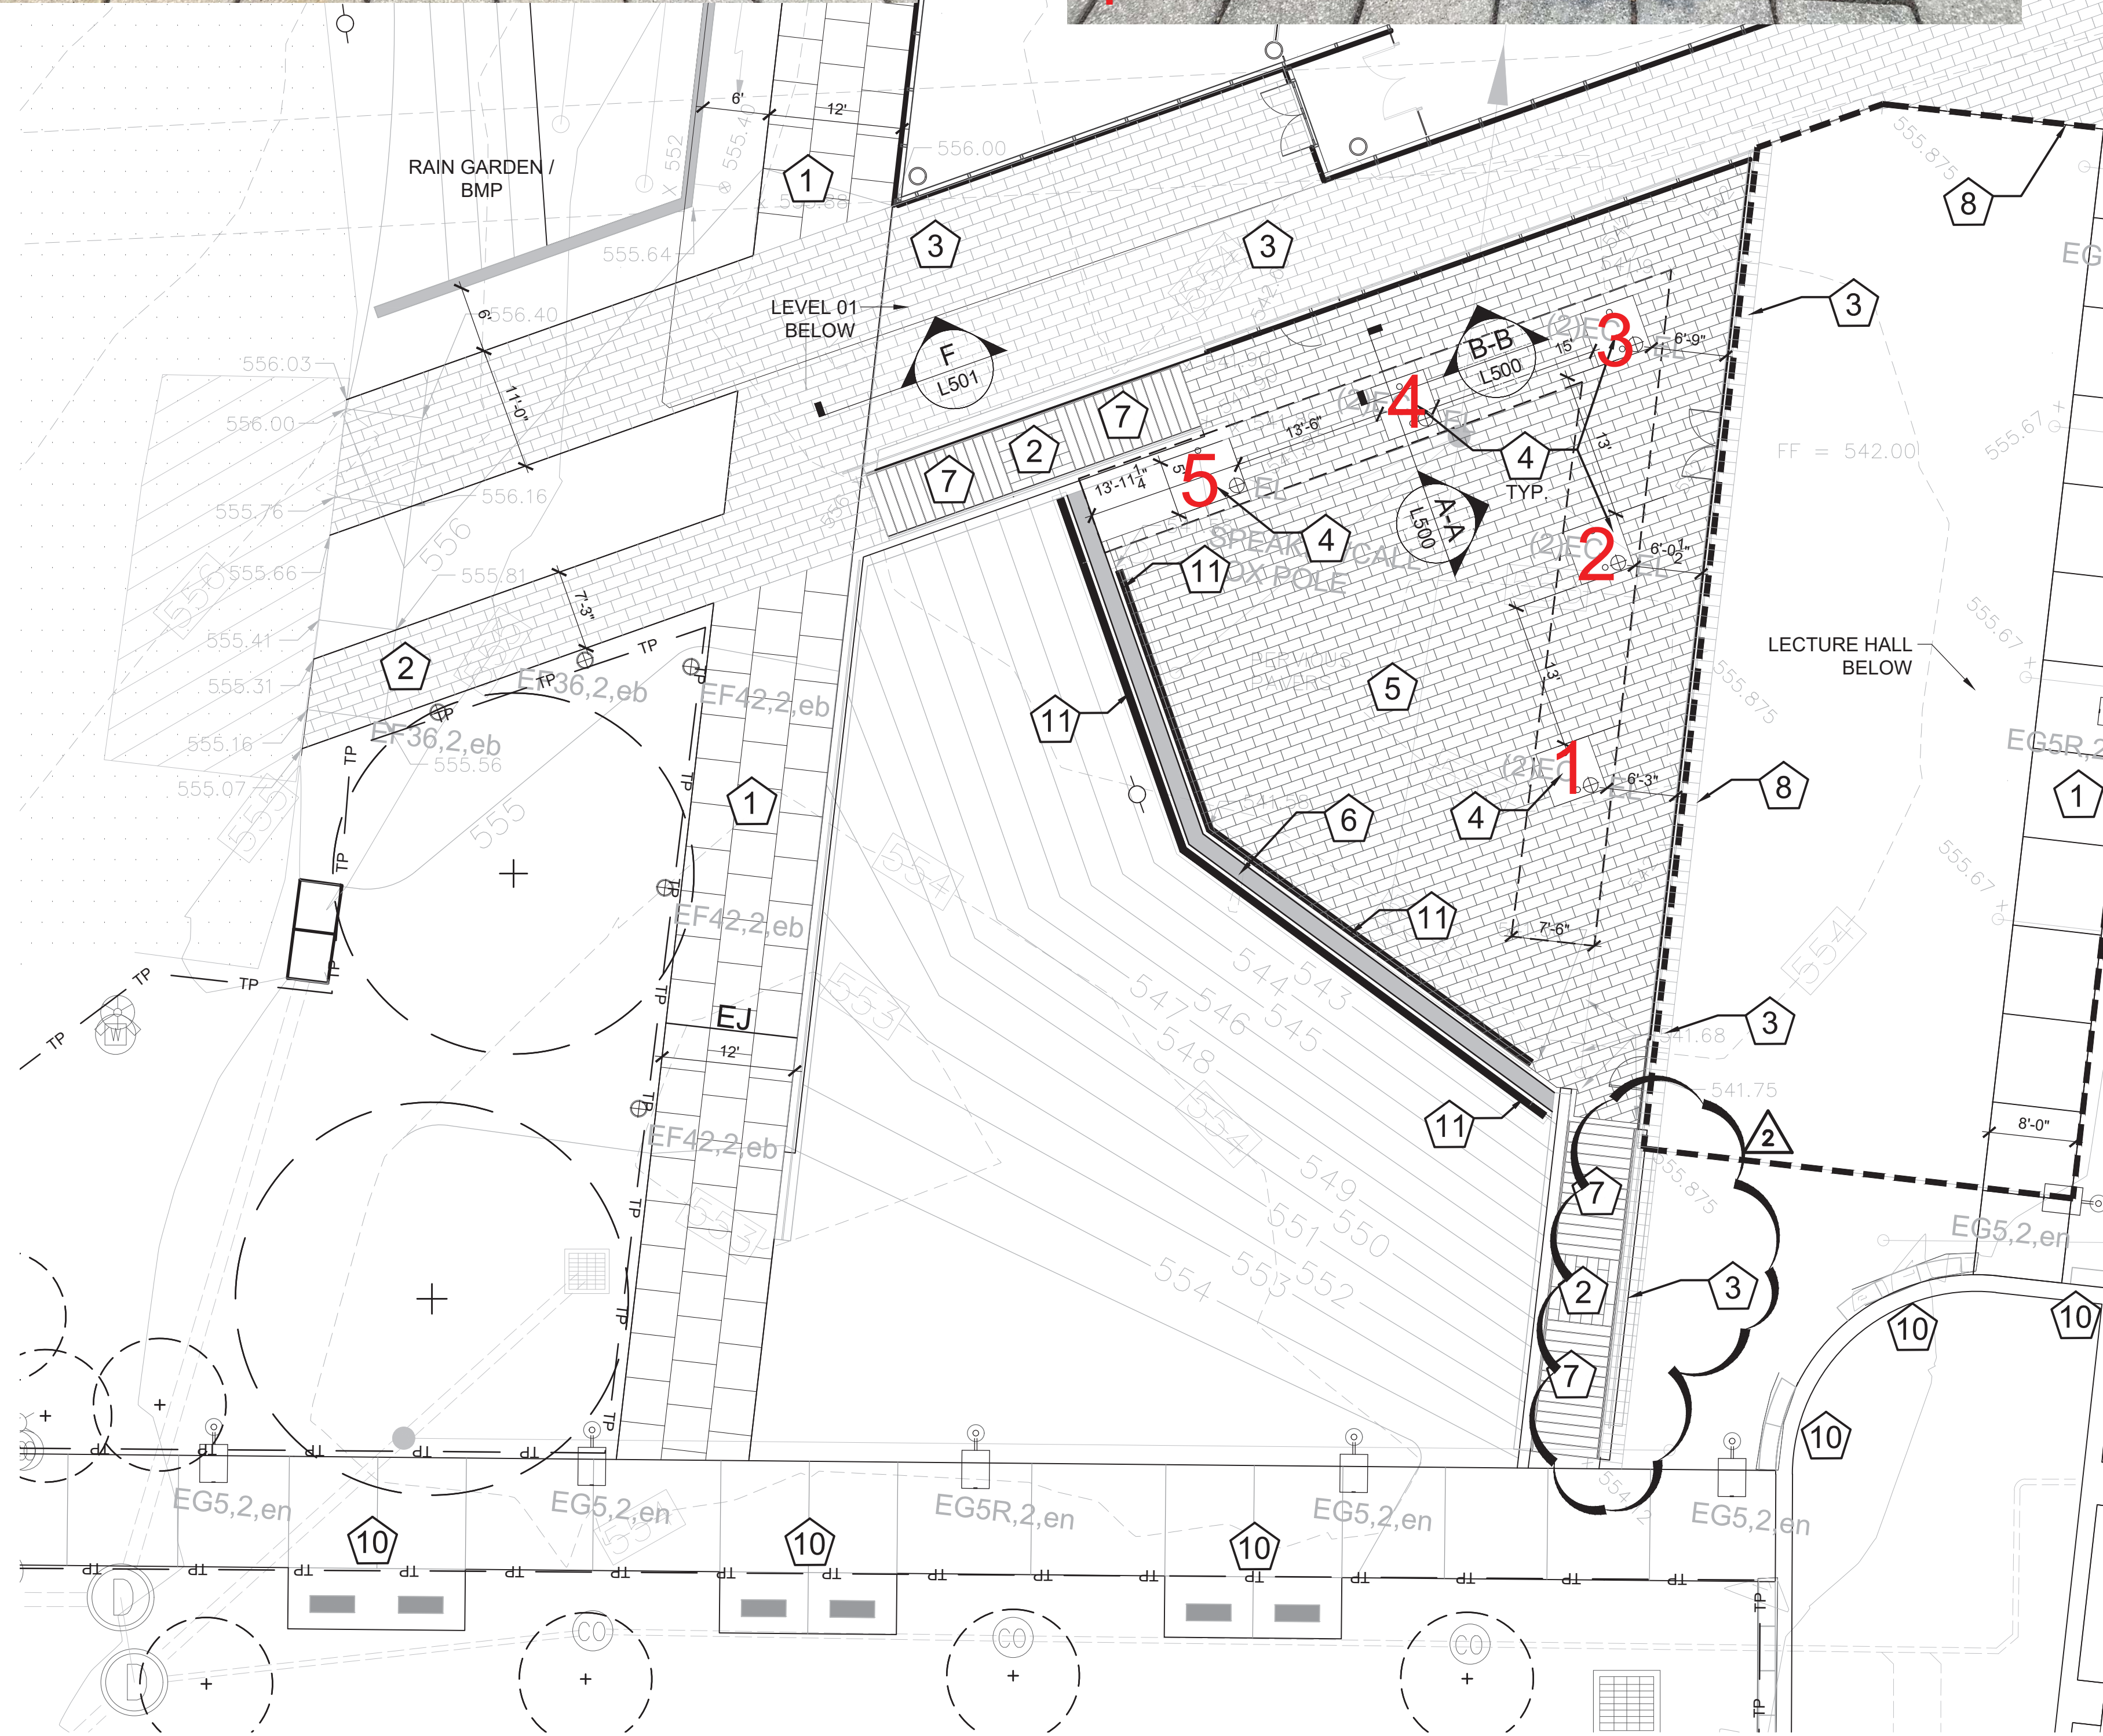
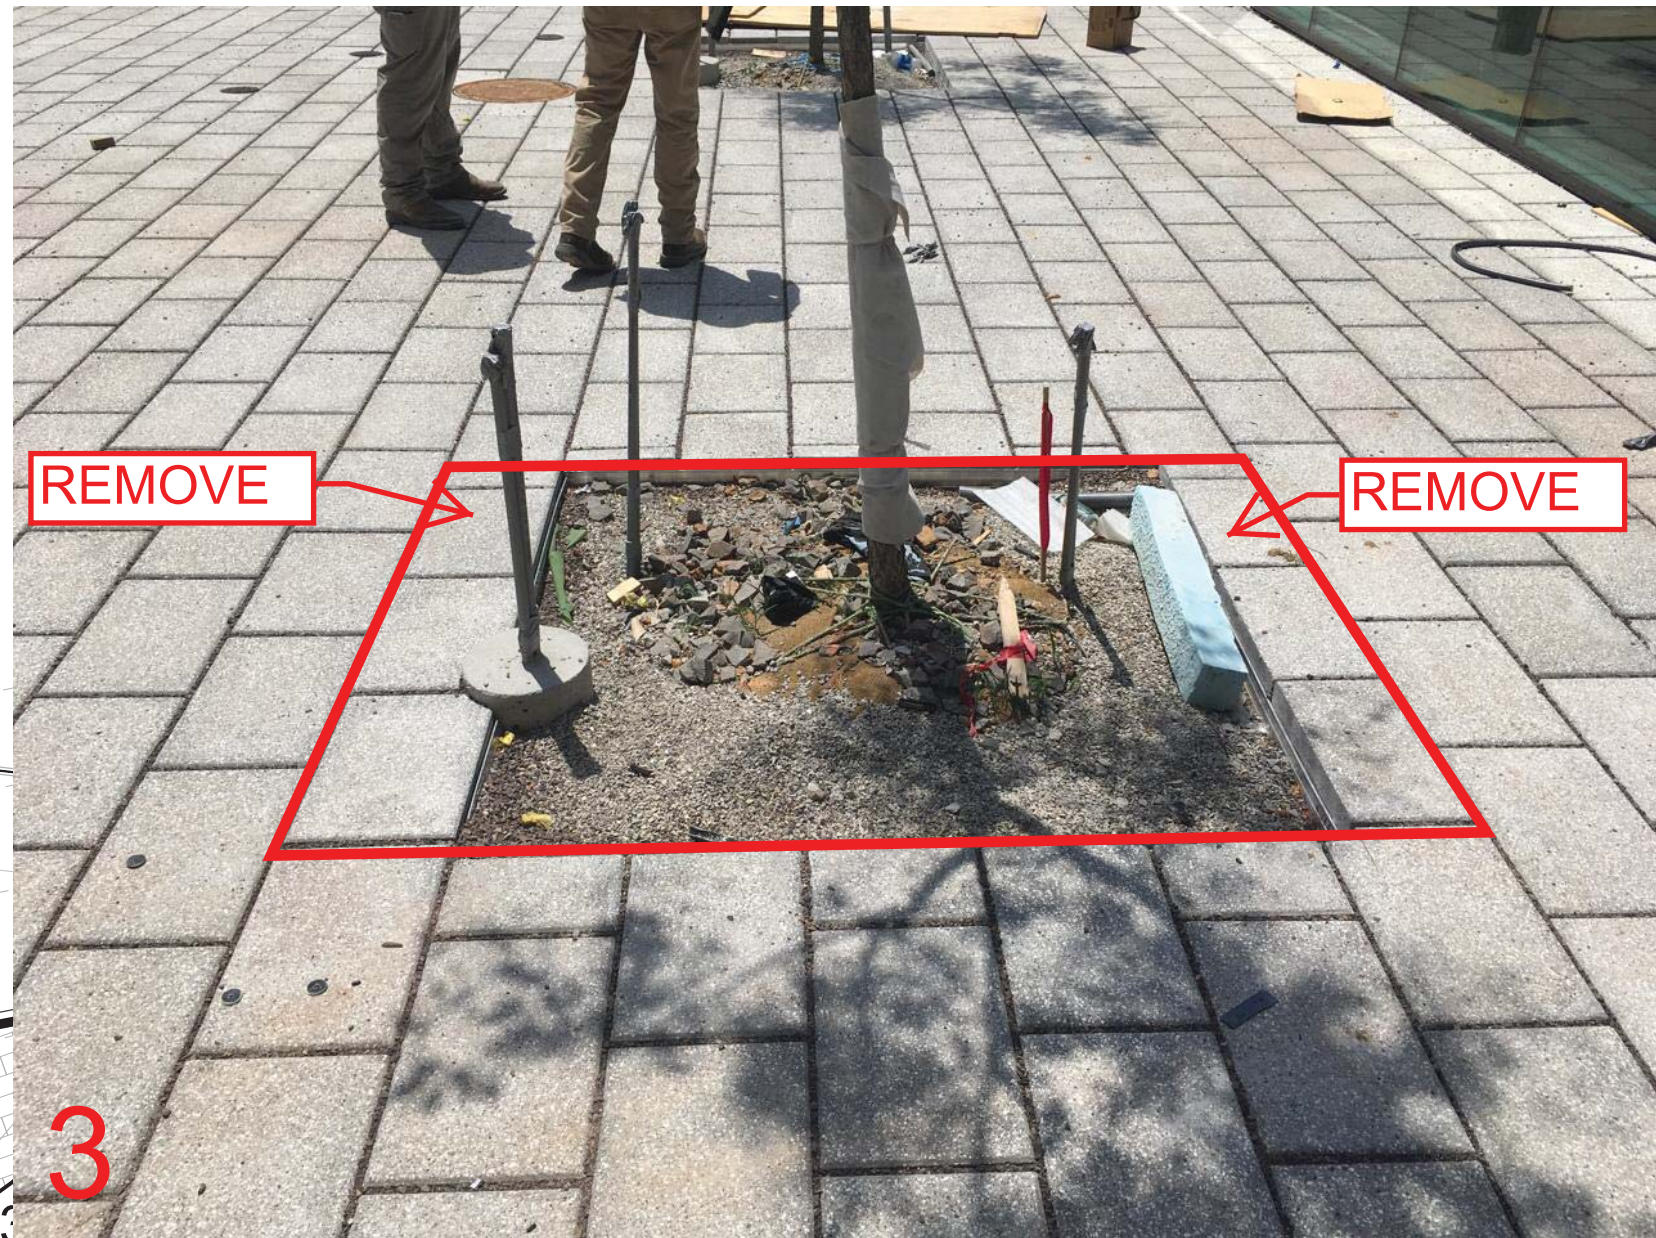
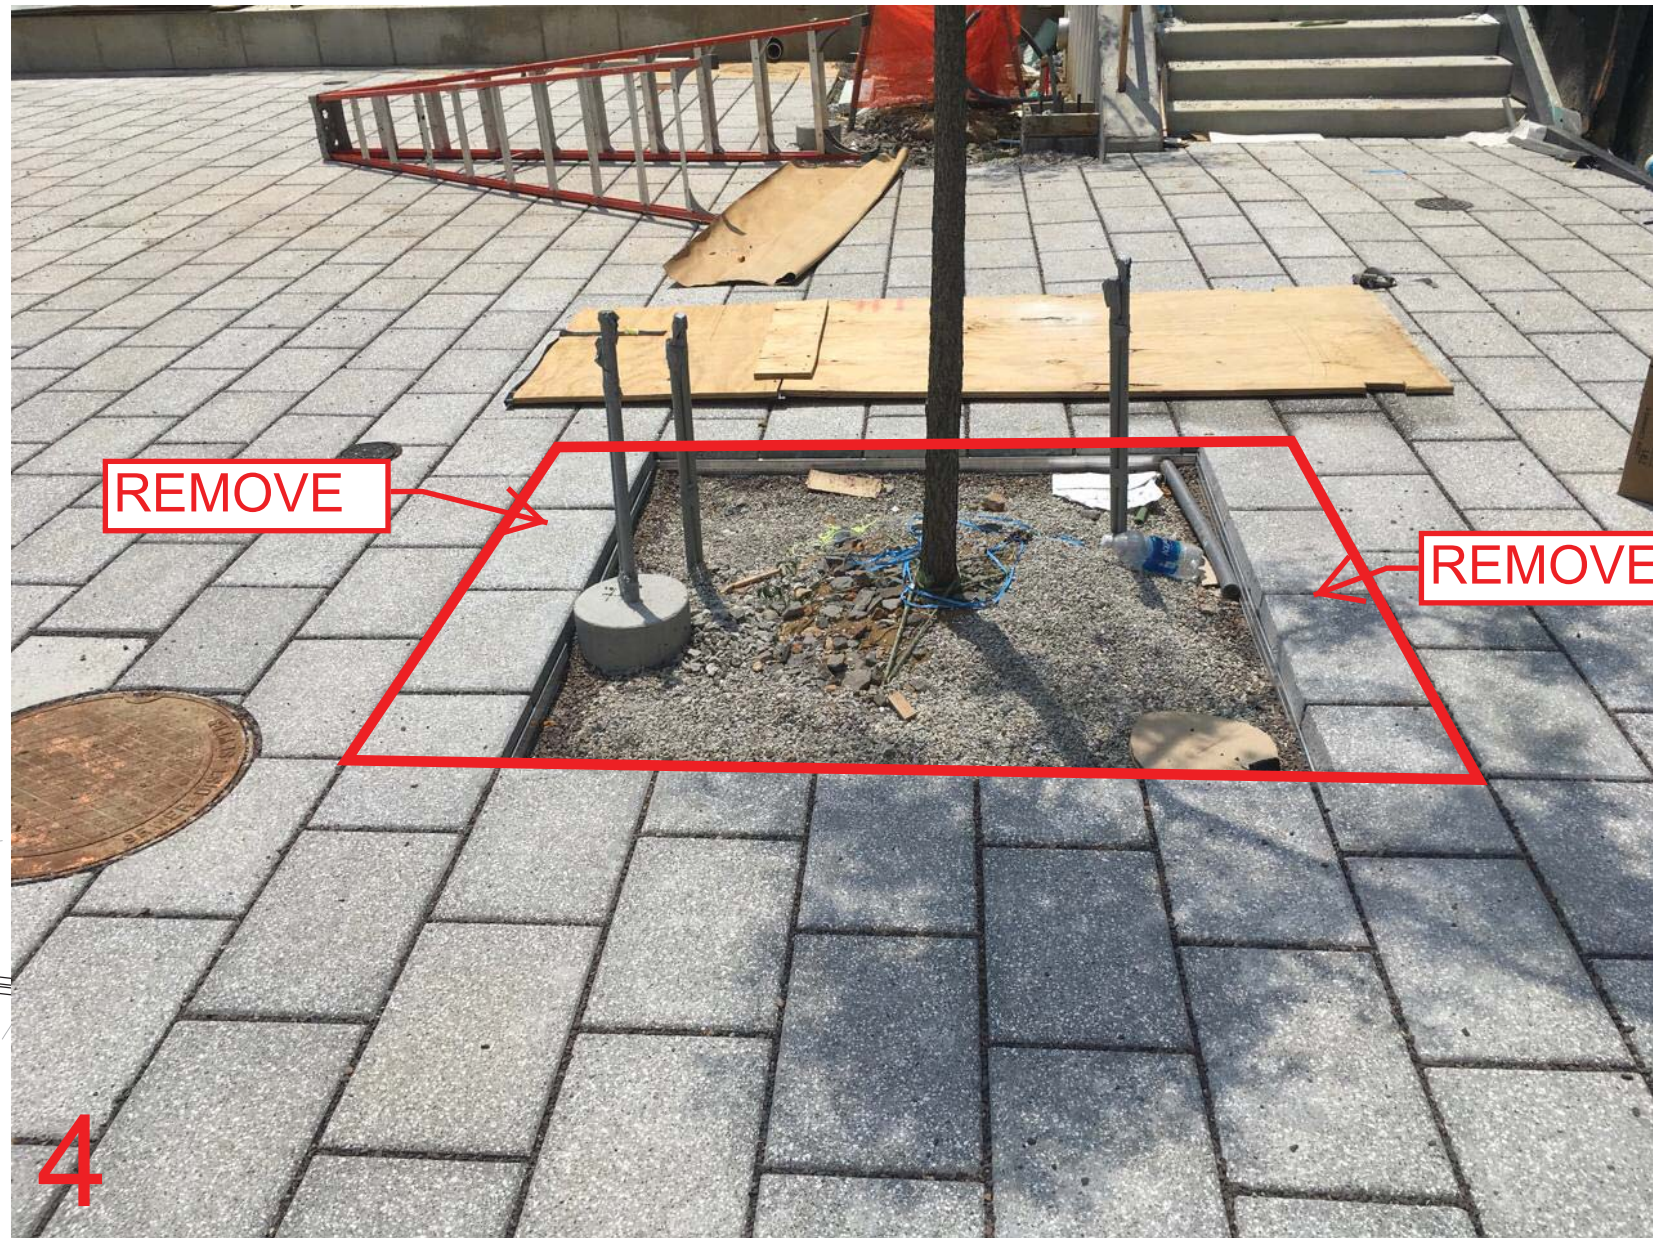
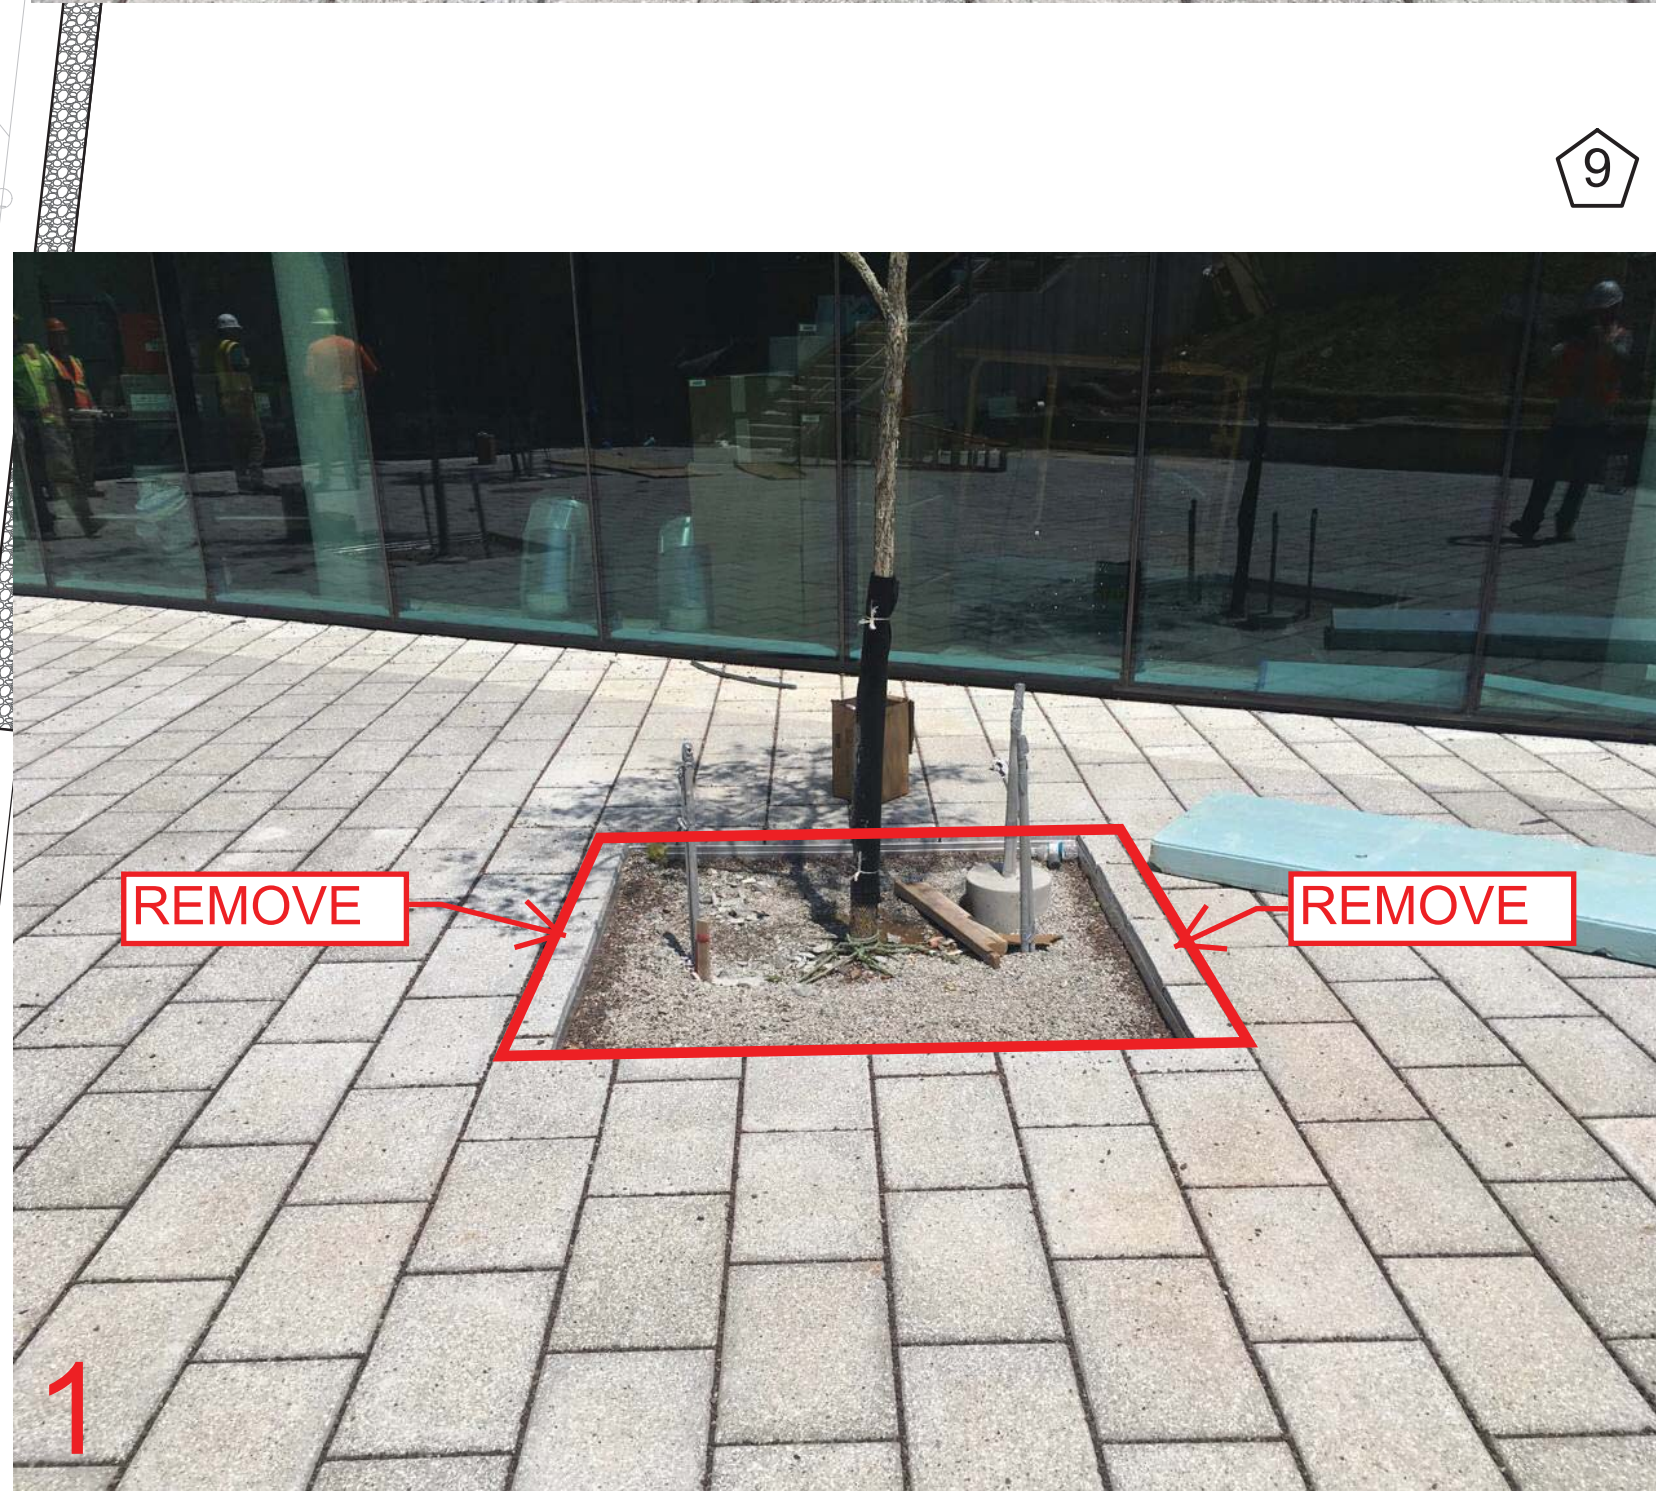


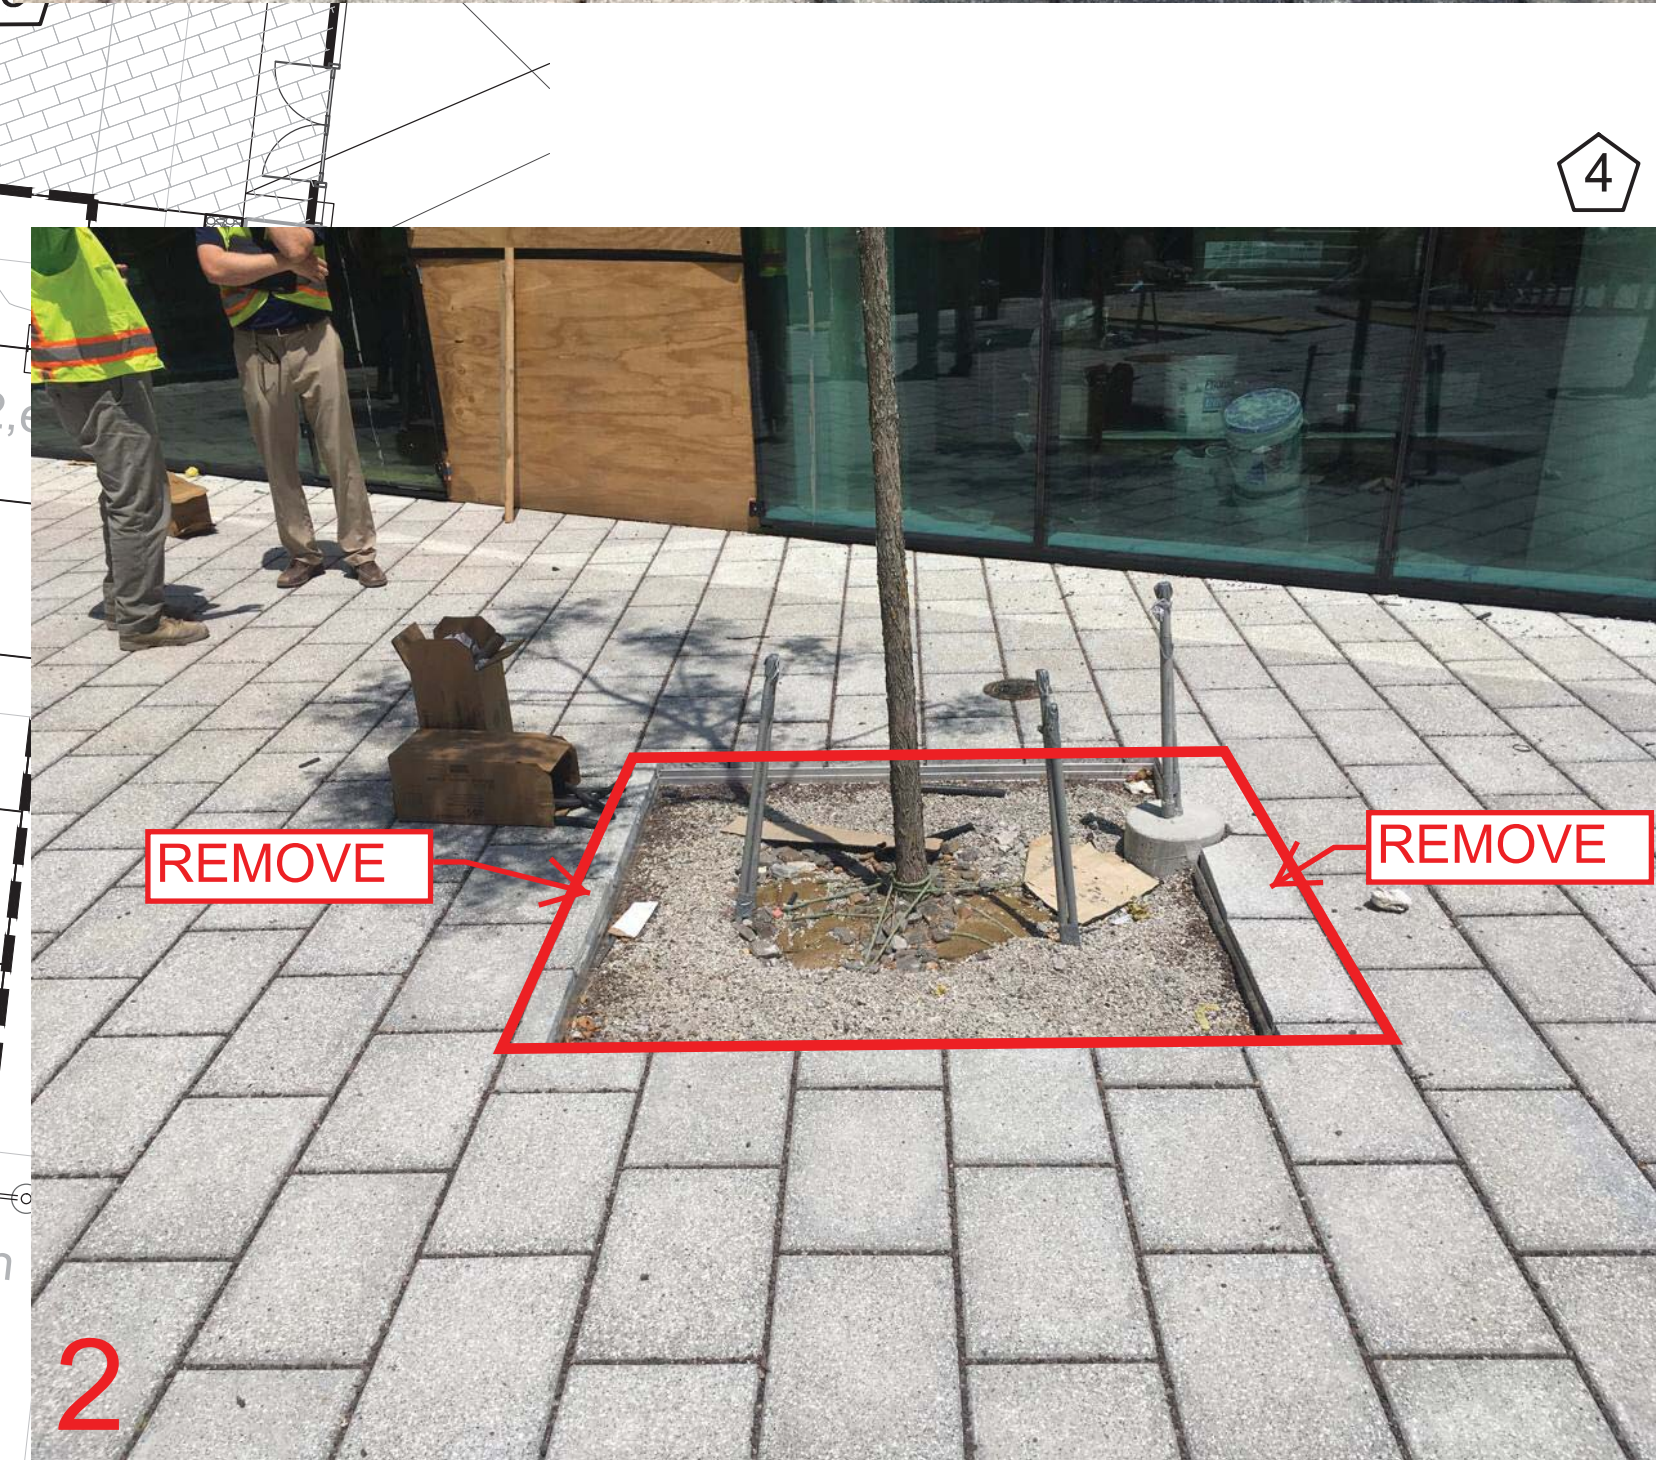

A ENLARGED COURTYARD PLAN
SCALE: 1" = 10'

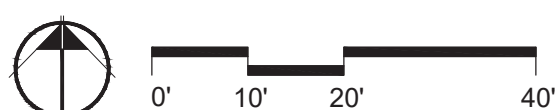

EXPANSION JOINTS
CONTROL JOINT

STANDARD CONCRETE PAVING
5" THICK CONCRETE PAVING, LIGHT BROOM FINISH.
EDGES TO BE 1/4" TOOLED RADIUS, SAW CUT JOINTS.
SEE CIVIL DRAWINGS FOR LAYOUT. CONTRACTOR
TO COORDINATE LOCATION OF ALL JOINTS WITH
LANDSCAPE ARCHITECT.

CONCRETE PAVERS
WAUSAU TILE
12" X 24", COLOR TO BE: XP-40
SAND SETTING BED ON CONCRETE BASE
SEE DETAIL A/L501

CONCRETE PAVERS
WAUSAU TILE
12" X 24", COLOR TO BE: XP-40 OR XP-120
OVERSIZED PAVERS PER DETAIL 'E' & 'F' L500
PEDESTAL SYSTEM
SEE DETAILS F, G/ L501

TREE PIT
CLEAN 3" TRAP ROCK MULCH AT TREE PITS.
INCLUDES (2) LED UPLIGHTS PER TREE:
HYDREL MODEL, M9440-SS-12LED-WHT53K-MVOLT-VWFL-FLC20-34S-IHL-LP
SEE DETAILS C, D/ L500

PERMEABLE CONCRETE PAVER
HANOVER ARCHITECTURAL PRODUCTS
12" x 18", COLOR TO BE DETERMINED
SEE DETAIL SHEETS C, D/ L500 & CIVIL DRAWING DETAIL 5/C700

CONCRETE SEATWALL
WITH IPE WOOD TOP.
SEE DETAIL D/L501

STAIRS
SEE ARCHITECTURAL DRAWINGS

GREENROOF EDGE RESTRAINT
HEIGHT OF EDGE VARIES. SEE ARCHITECTURAL
DRAWINGS

DECORATIVE GRAVEL MAINTENANCE STRIP
BLACK MOUNTAIN TRAP ROCK
SEE DETAIL B/L500

EXISTING STONE BENCHES TO REMAIN
PROTECT FROM DAMAGE

TRENCH DRAIN
6" WIDE W/ PERFORATED STAINLESS STEEL
GRATE, MODEL #DS-226 BY NDS. INSTALL PER
MANUFACTURER RECOMMENDATIONS. SEE
CIVIL DRAWINGS FOR DETAILS

BIKE RACK
LANDSCAPE FORMS
SEE DETAIL SHEET A/L500

CONCRETE RETAINING WALL
CAST IN PLACE CONCRETE WALL WITH FORM
LINER FINISH. FORM LINER PATTERN TO BE
DETERMINED. REFERENCE ARCHITECTURAL
WALL DETAILS