



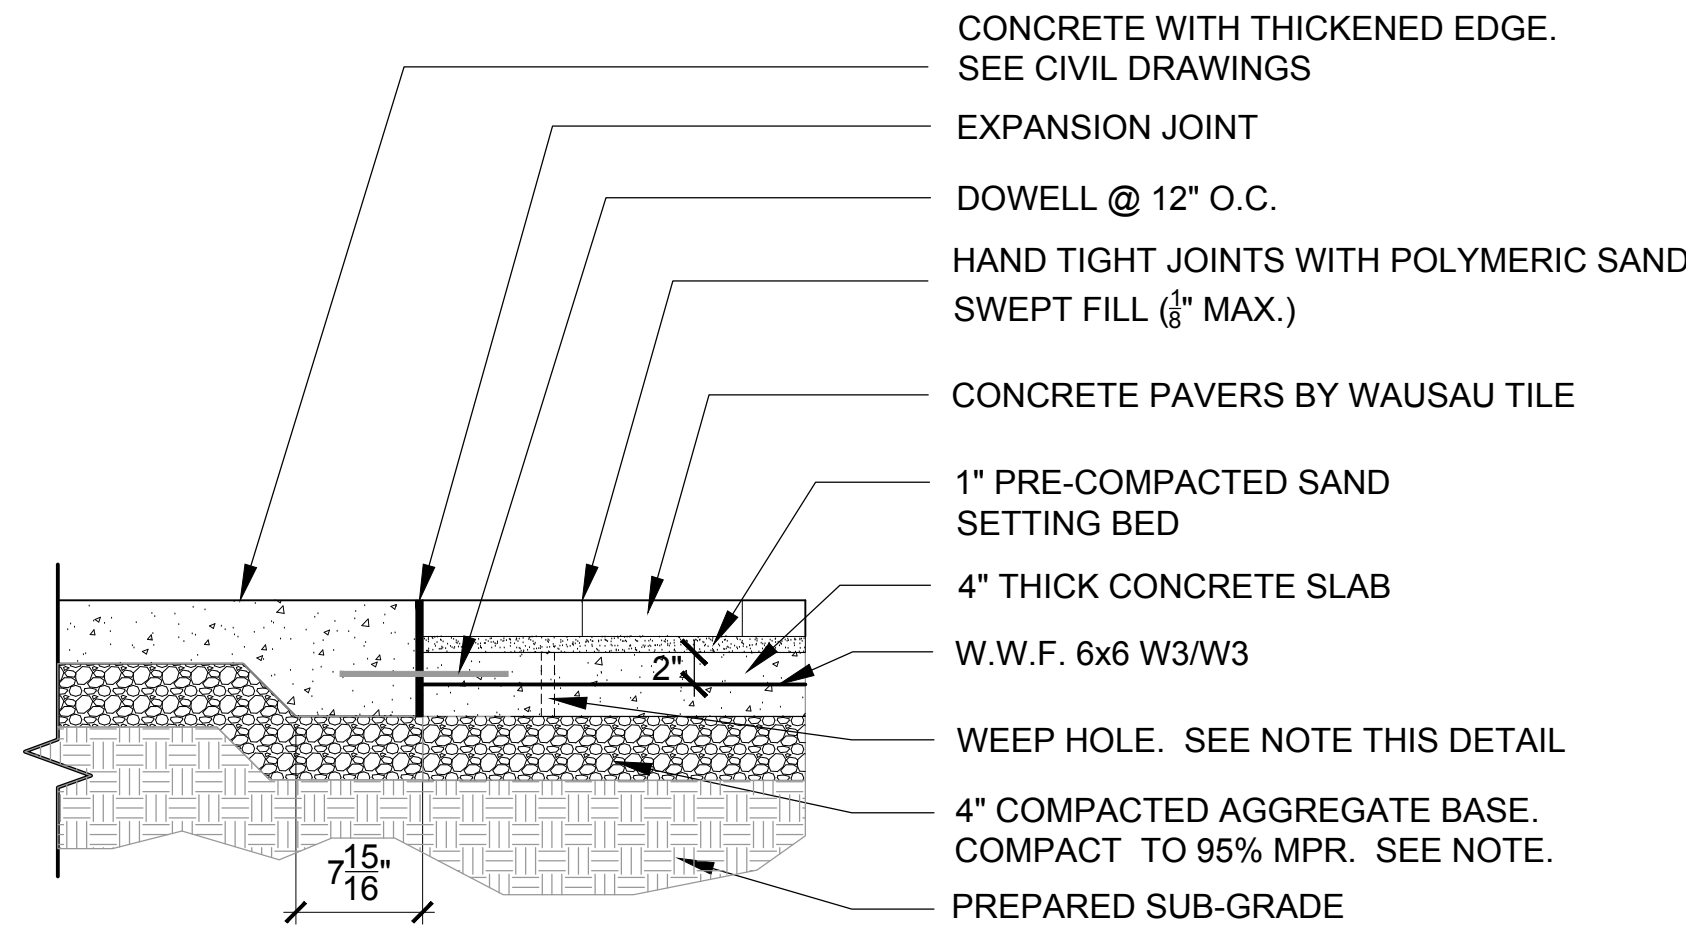

NOTES:


1. SLOPE TOP OF CONCRETE BASE IN ACCORDANCE WITH GRADING PLAN
2. PROVIDE 3/4\"/>

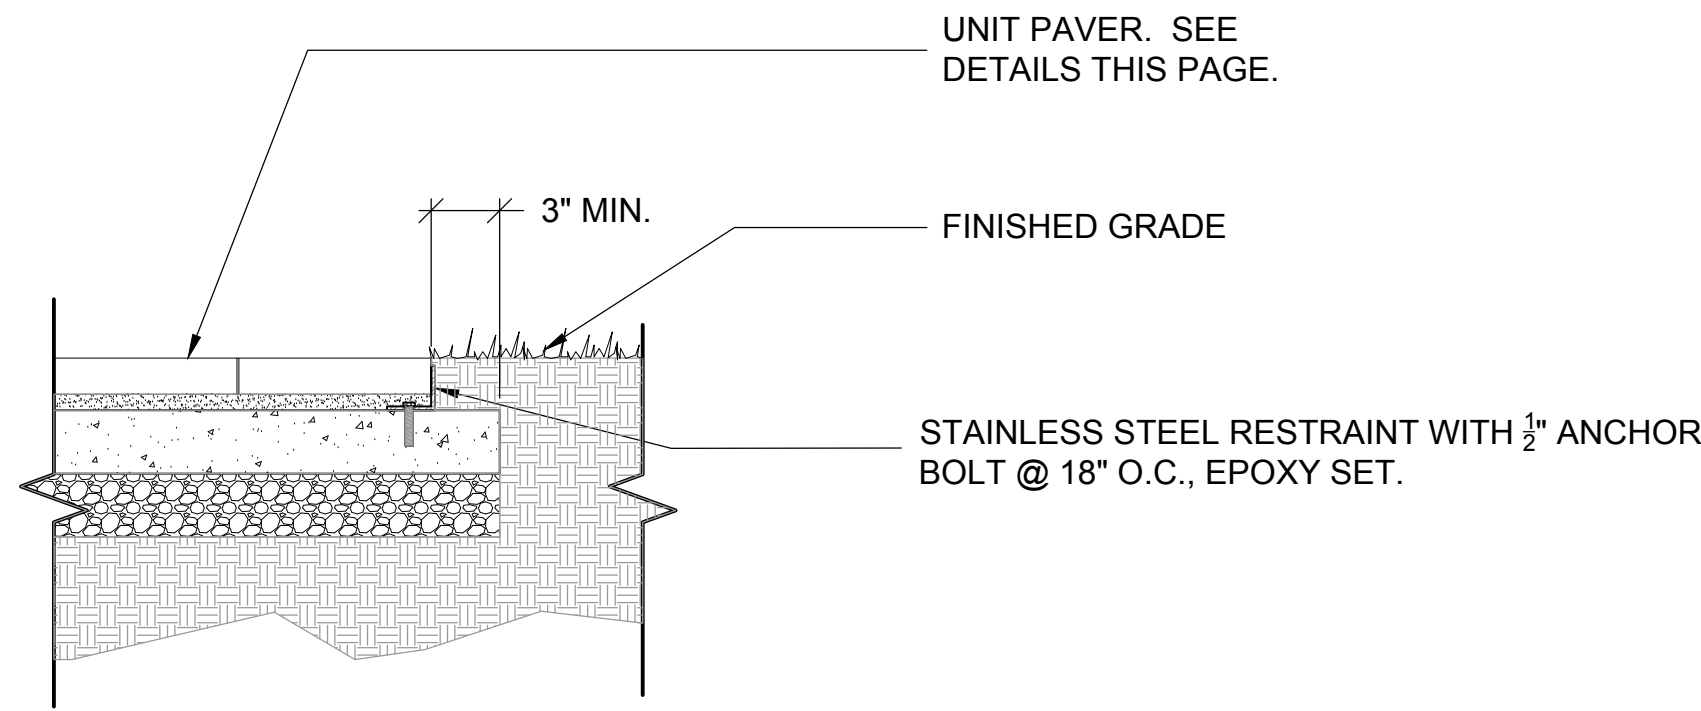

A PAVERS ON CONCRETE BASE
NTS


B PAVERS EDGE RESTRAINT
NTS

C PAVERS CHARACTER IMAGE (FOR REFERENCE ONLY)
NTS

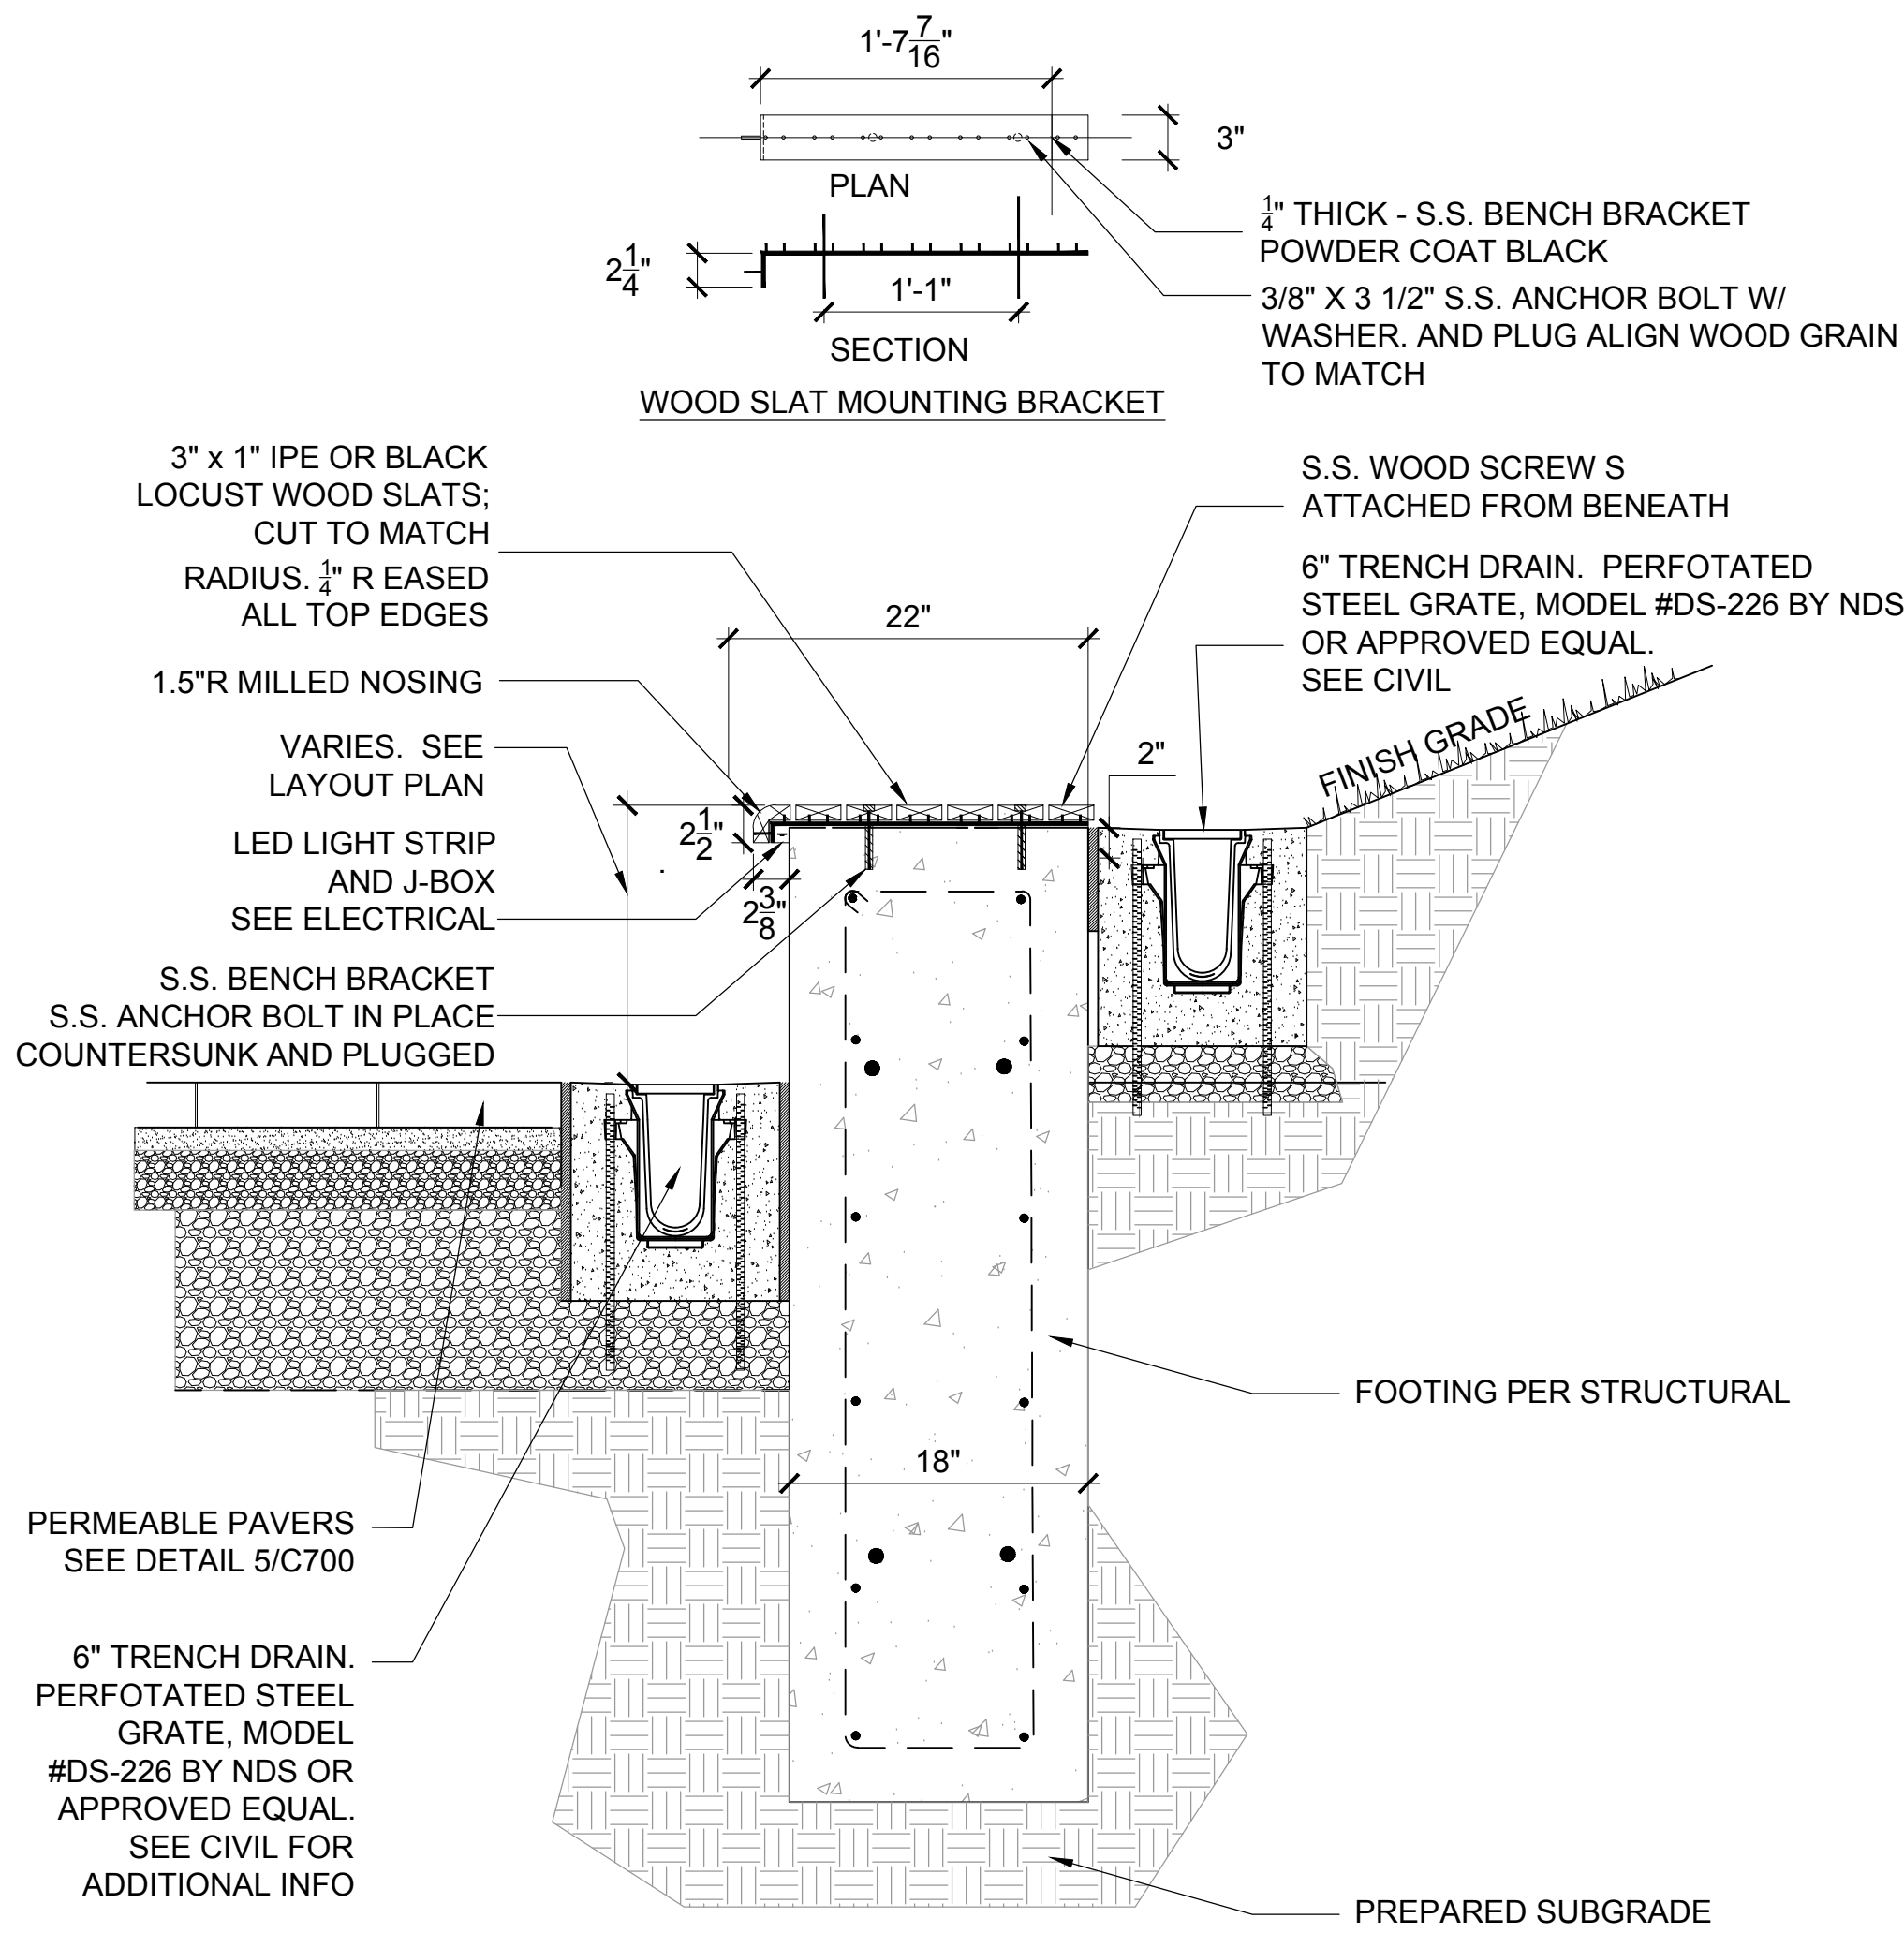


NOTES:


1. PROVIDE SHOP DRAWINGS.
2. PREPARED SUBGRADE IN ACCORDANCE WITH THE RECOMMENDATIONS OF THE GEOTECHNICAL ENGINEERING REPORT.
3. MPR = MATERIALS MODIFIED PROCTOR - ASTM D 1557 - MAXIMUM DRY DENSITY (TYP.)
4. ALL GLUE UPS FOR OUT DOOR INSTALLATIONS SHALL BE WATERPROOF GLUES.
5. ALL WOOD TO BE FURNISHED 4 SIDES.

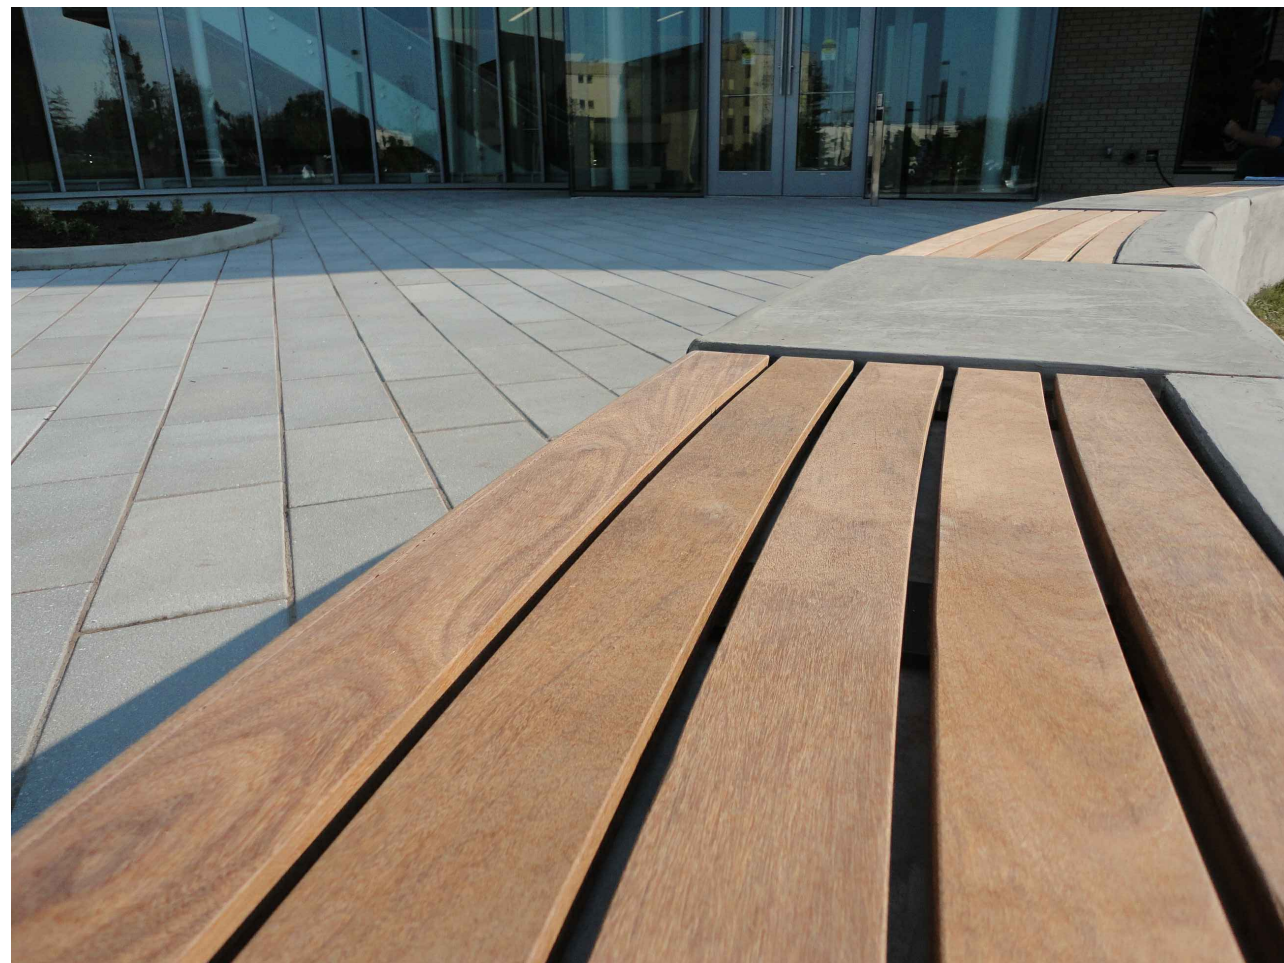

E SEATWALL CHARACTER IMAGES (FOR REFERENCE ONLY)
NTS

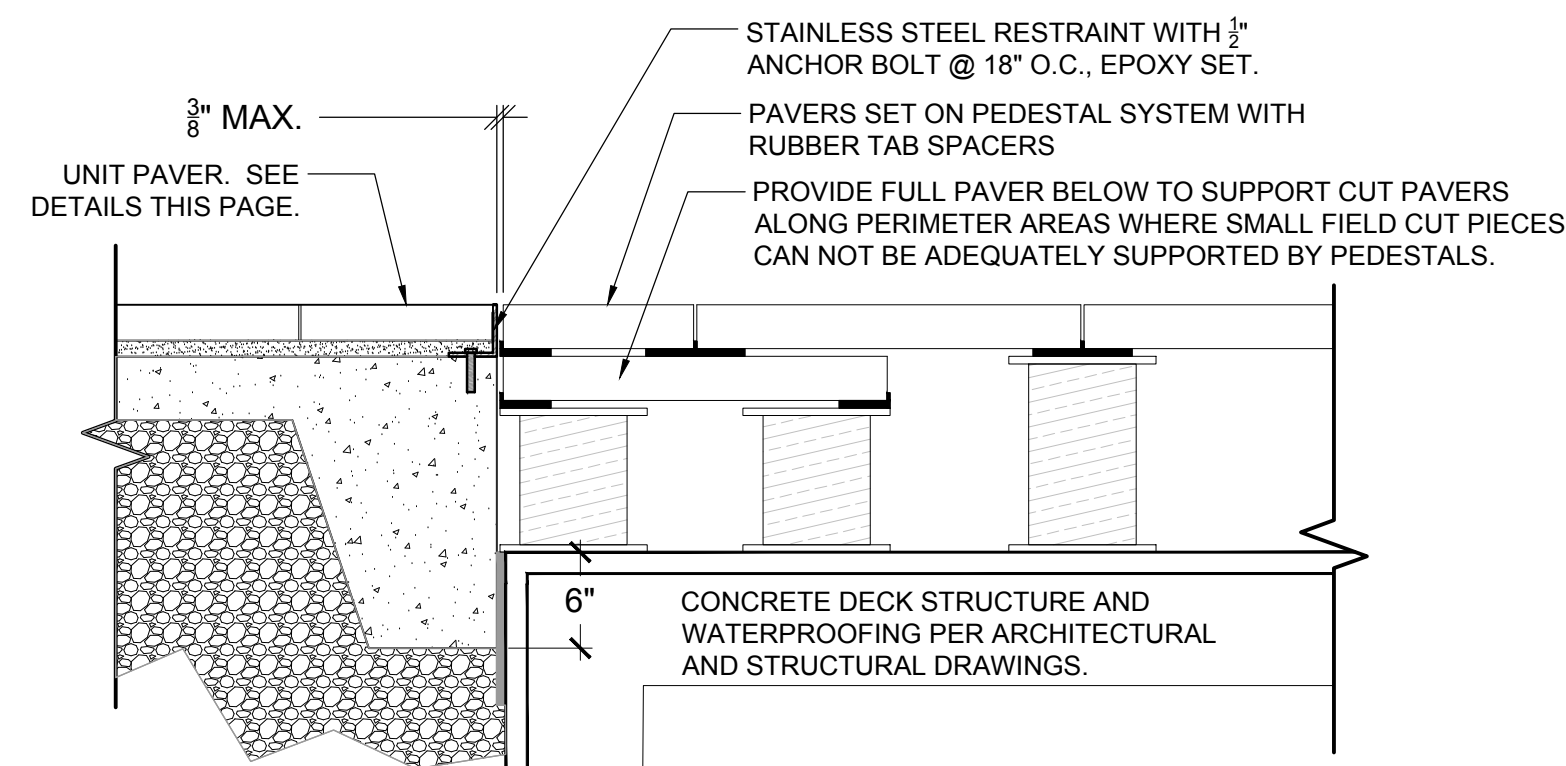

F PAVER JOINT AT BUILDING EDGE BELOW GRADE
NTS

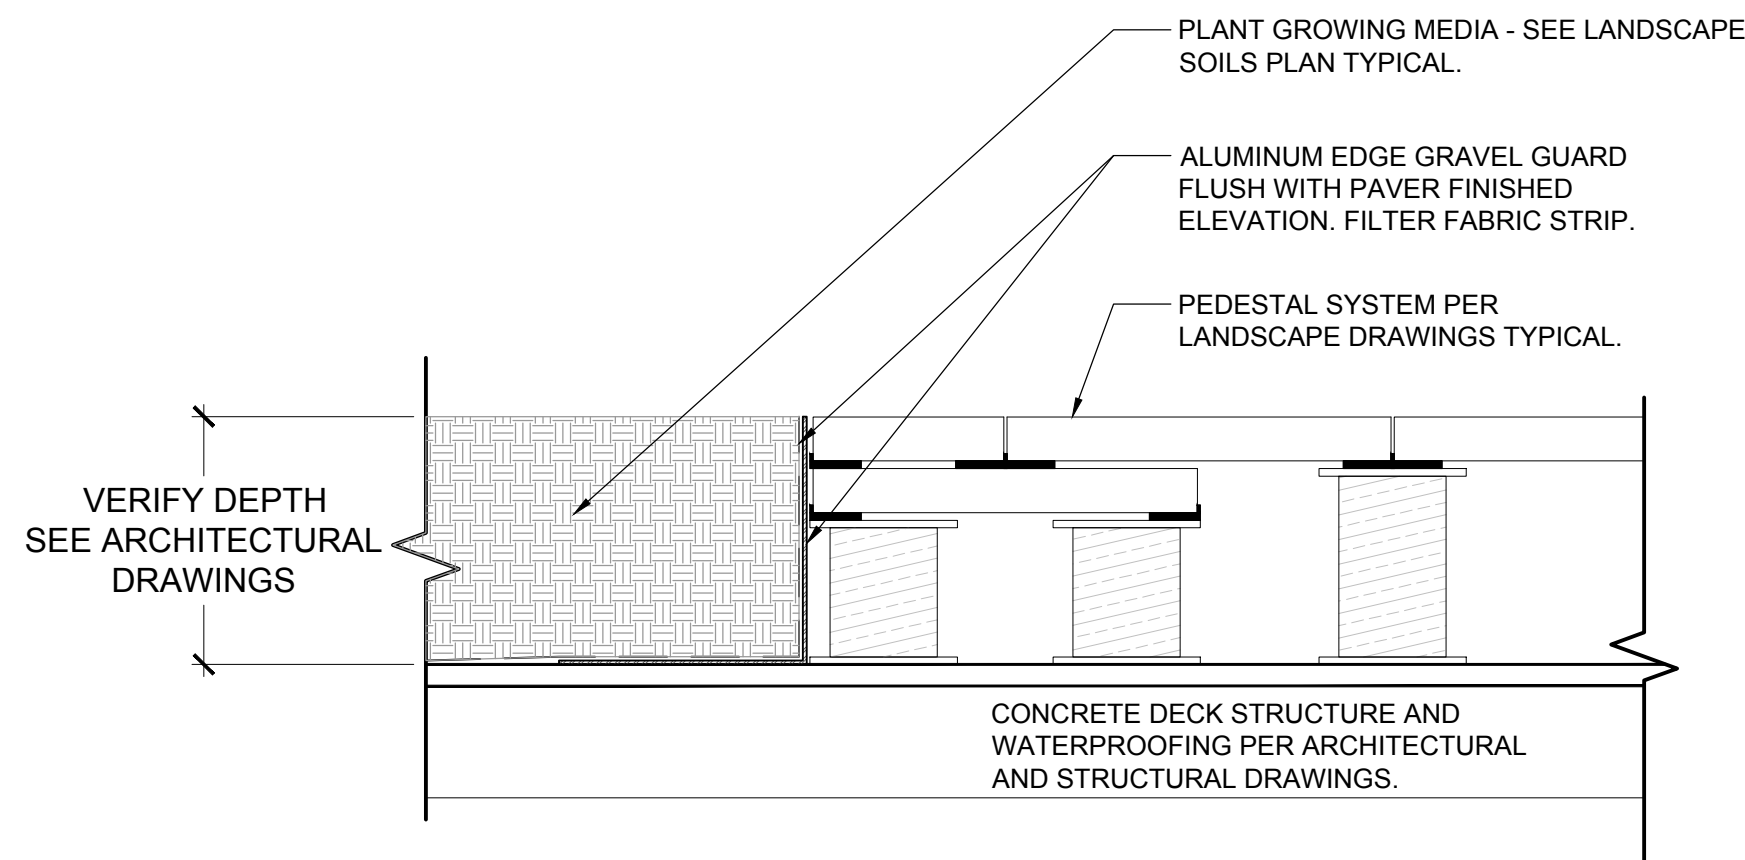

G PAVER JOINT AT BUILDING EDGE BELOW GRADE
NTS

D SEATWALL WITH WOOD TOP
NTS