


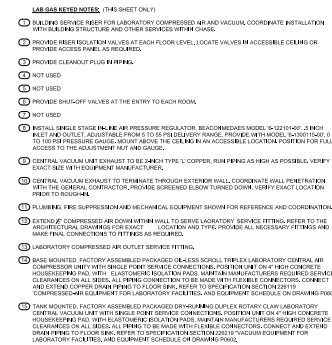

H1 TRIANGLE HANGER W/ 3/8" ROD

H2 TRAPEZE HANGER W/ 3/8" ROD

H3 CLEVIS HANGER W/ 3/8" ROD

H4 V-BOTTOM CLEVIS HANGER W/ 3/8" ROD

KEY PLAN

NOT VALID FOR PERMITS
UNLESS SEALED BY
ENGINEER

Revision: 

Issue Date
11 / 18 / 16

Sheet Title
LP101A1

Project Number
5768

Sheet Number
1 of 1

Revision: 

Issue Date: 11 / 18 / 16

Sheet Title: LP101A1

Project Number: 5768

Sheet Number: 1 of 1