




RECORD DRAWING
DATE: 6/30/17 DRAWN BY: J

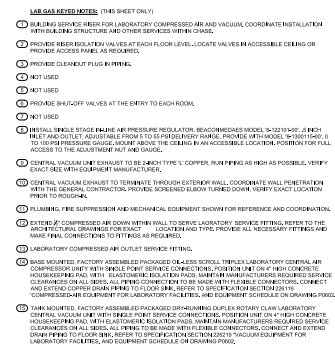

WEBSTER GROVES, MISSOURI

ICON MECHANICAL CONTRACTORS AND ENGINEERS

NOT VALID FOR PERMITS
UNLESS SEALED BY
ENGINEER

H1 TRIANGLE HANGER W/ 3/8" ROD

H2 TRAPEZE HANGER W/ 3/8" ROD

H3 CLEVIS HANGER W/ 3/8" ROD

H4 V-BOTTOM CLEVIS HANGER W/ 3/8" ROD

Division^a

Issue Date
11 / 18 / 16

LP101A2

Project Number

5768

1 of 1
