




- LAR GAS KEYED NOTES: (THIS SHEET ONLY)

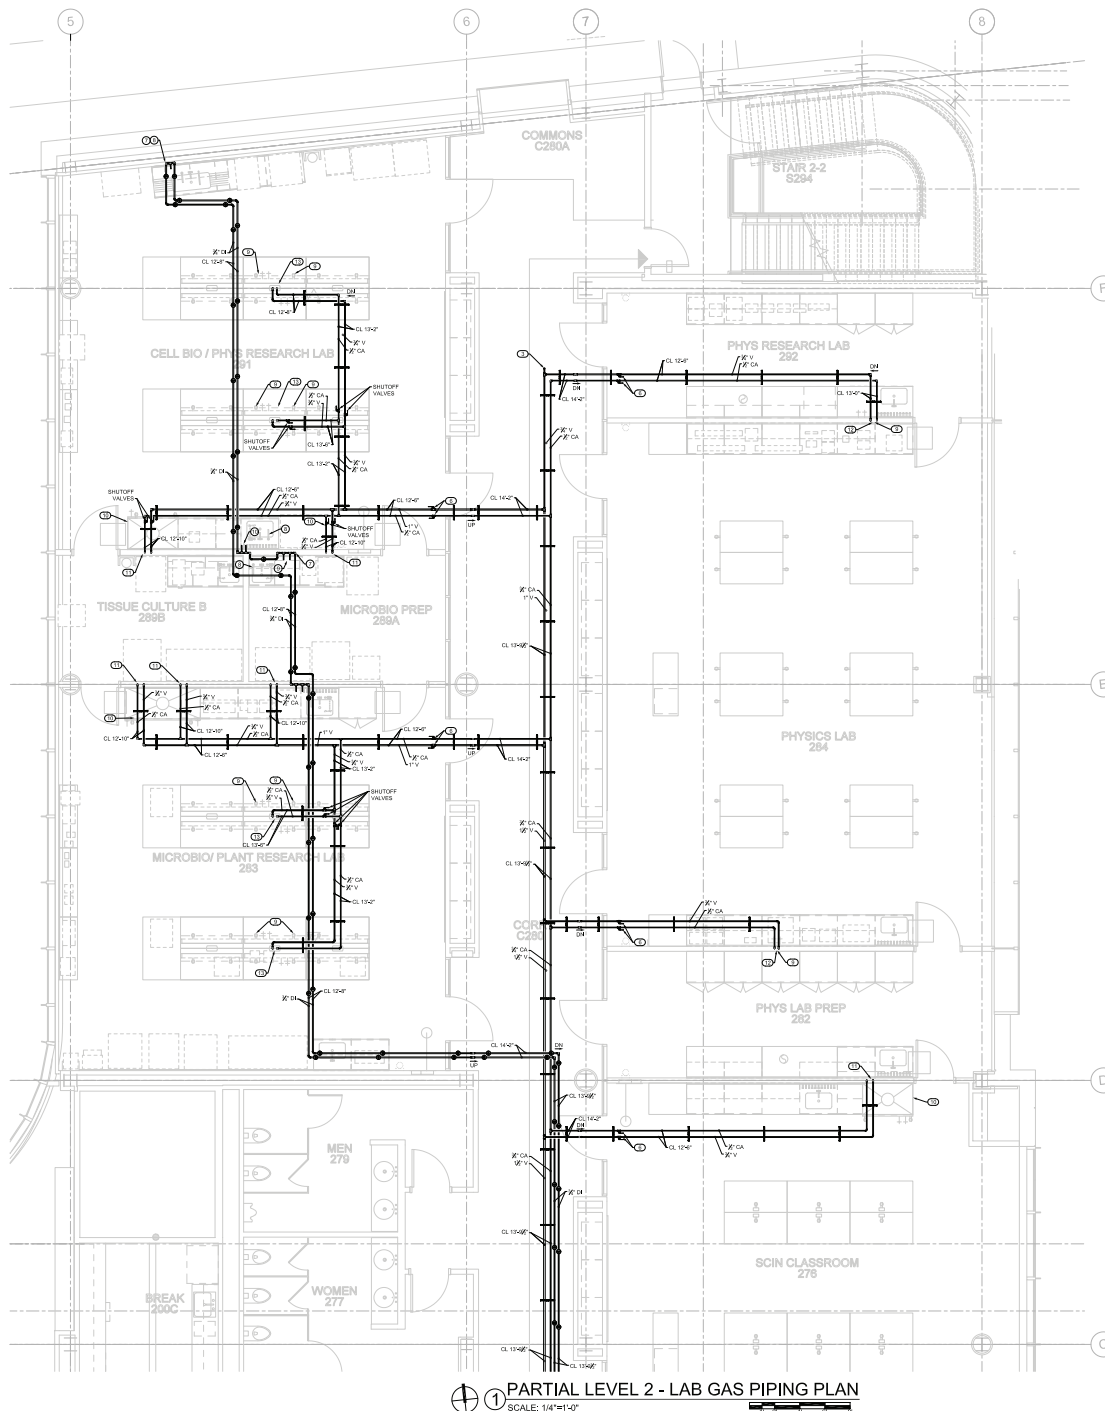