


- H1** TRIANGLE HANGER W/ 3/8" ROD
H2 TRAPEZE HANGER W/ 3/8" ROD
H3 CLEVIS HANGER W/ 3/8" ROD
H4 V-BOTTOM CLEVIS HANGER W/ 3/8" ROD

RECORD DRAWINGS
DATE: 6/30/17 DRAWN BY: ZS

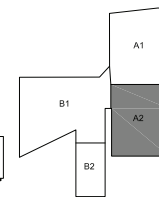

KEY PLAN

WEBSTER UNIVERSITY - ISB

WEBSTER GROVES, MISSOURI

ICON MECHANICAL CONTRACTORS AND ENGINEERS

NOT VALID FOR PERMITS
UNLESS SEALED BY
ENGINEER

Revision:     

Issue Date 12 / 1 / 16

Sheet Title

LP103A2

Project Number 5768

Sheet Number

1 of 1