

THE SEAL(S) AND SIGNATURE(S) APPLY ONLY TO THE DOCUMENT TO WHICH THEY ARE AFFIXED, AND EXPRESSLY DISCLAIM ANY RESPONSIBILITY FOR ALL OTHER PLANS, SPECIFICATIONS, ESTIMATES, REPORTS OR OTHER DOCUMENTS OR INSTRUMENTS RELATING TO OR INTENDED TO BE USED FOR ANY PART OR PARTS OF THE ARCHITECTURAL OR ENGINEERING PROJECT.

1100 Clark Avenue  
St. Louis, Missouri 63102  
T: 314.241.6250  
F: 314.241.2570

William Tao & Associates, Inc.  
MEP/FP Engineer  
7955 Manchester Road, Suite 125  
St. Louis, MO 63143  
314-884-7600

David Mason & Associates, Inc.  
Structural & Civil Engineer  
800 South Vandeventer Avenue  
St. Louis, MO 63110  
314.534.1053

Faith Group  
Technology  
3101 S. Hanley Rd, Suite 100  
St. Louis, MO 63143  
314.591.2229


Kuhmann Leavitt, Inc.  
Environmental Graphics & Signage  
7400 Pershing Ave  
St. Louis, MO 63130  
314.725.6616

KWA Architects  
Architecture  
8721 Litzinger Road  
St. Louis, MO 63124  
314.962.2560

Spellman Brady & Company  
Interior Designer  
8251 Maryland Avenue, Suite 300  
St. Louis, MO 63105  
314.862.0070


SWT Design  
Landscape Architect  
7722 Big Bend Blvd  
St. Louis, MO 63119  
314.644.5700

Webb Engineering Services, Inc.  
Plumbing & Fire Protection  
1400 S. 3rd Street, Suite 201  
St. Louis, MO 63104  
314.588.0600

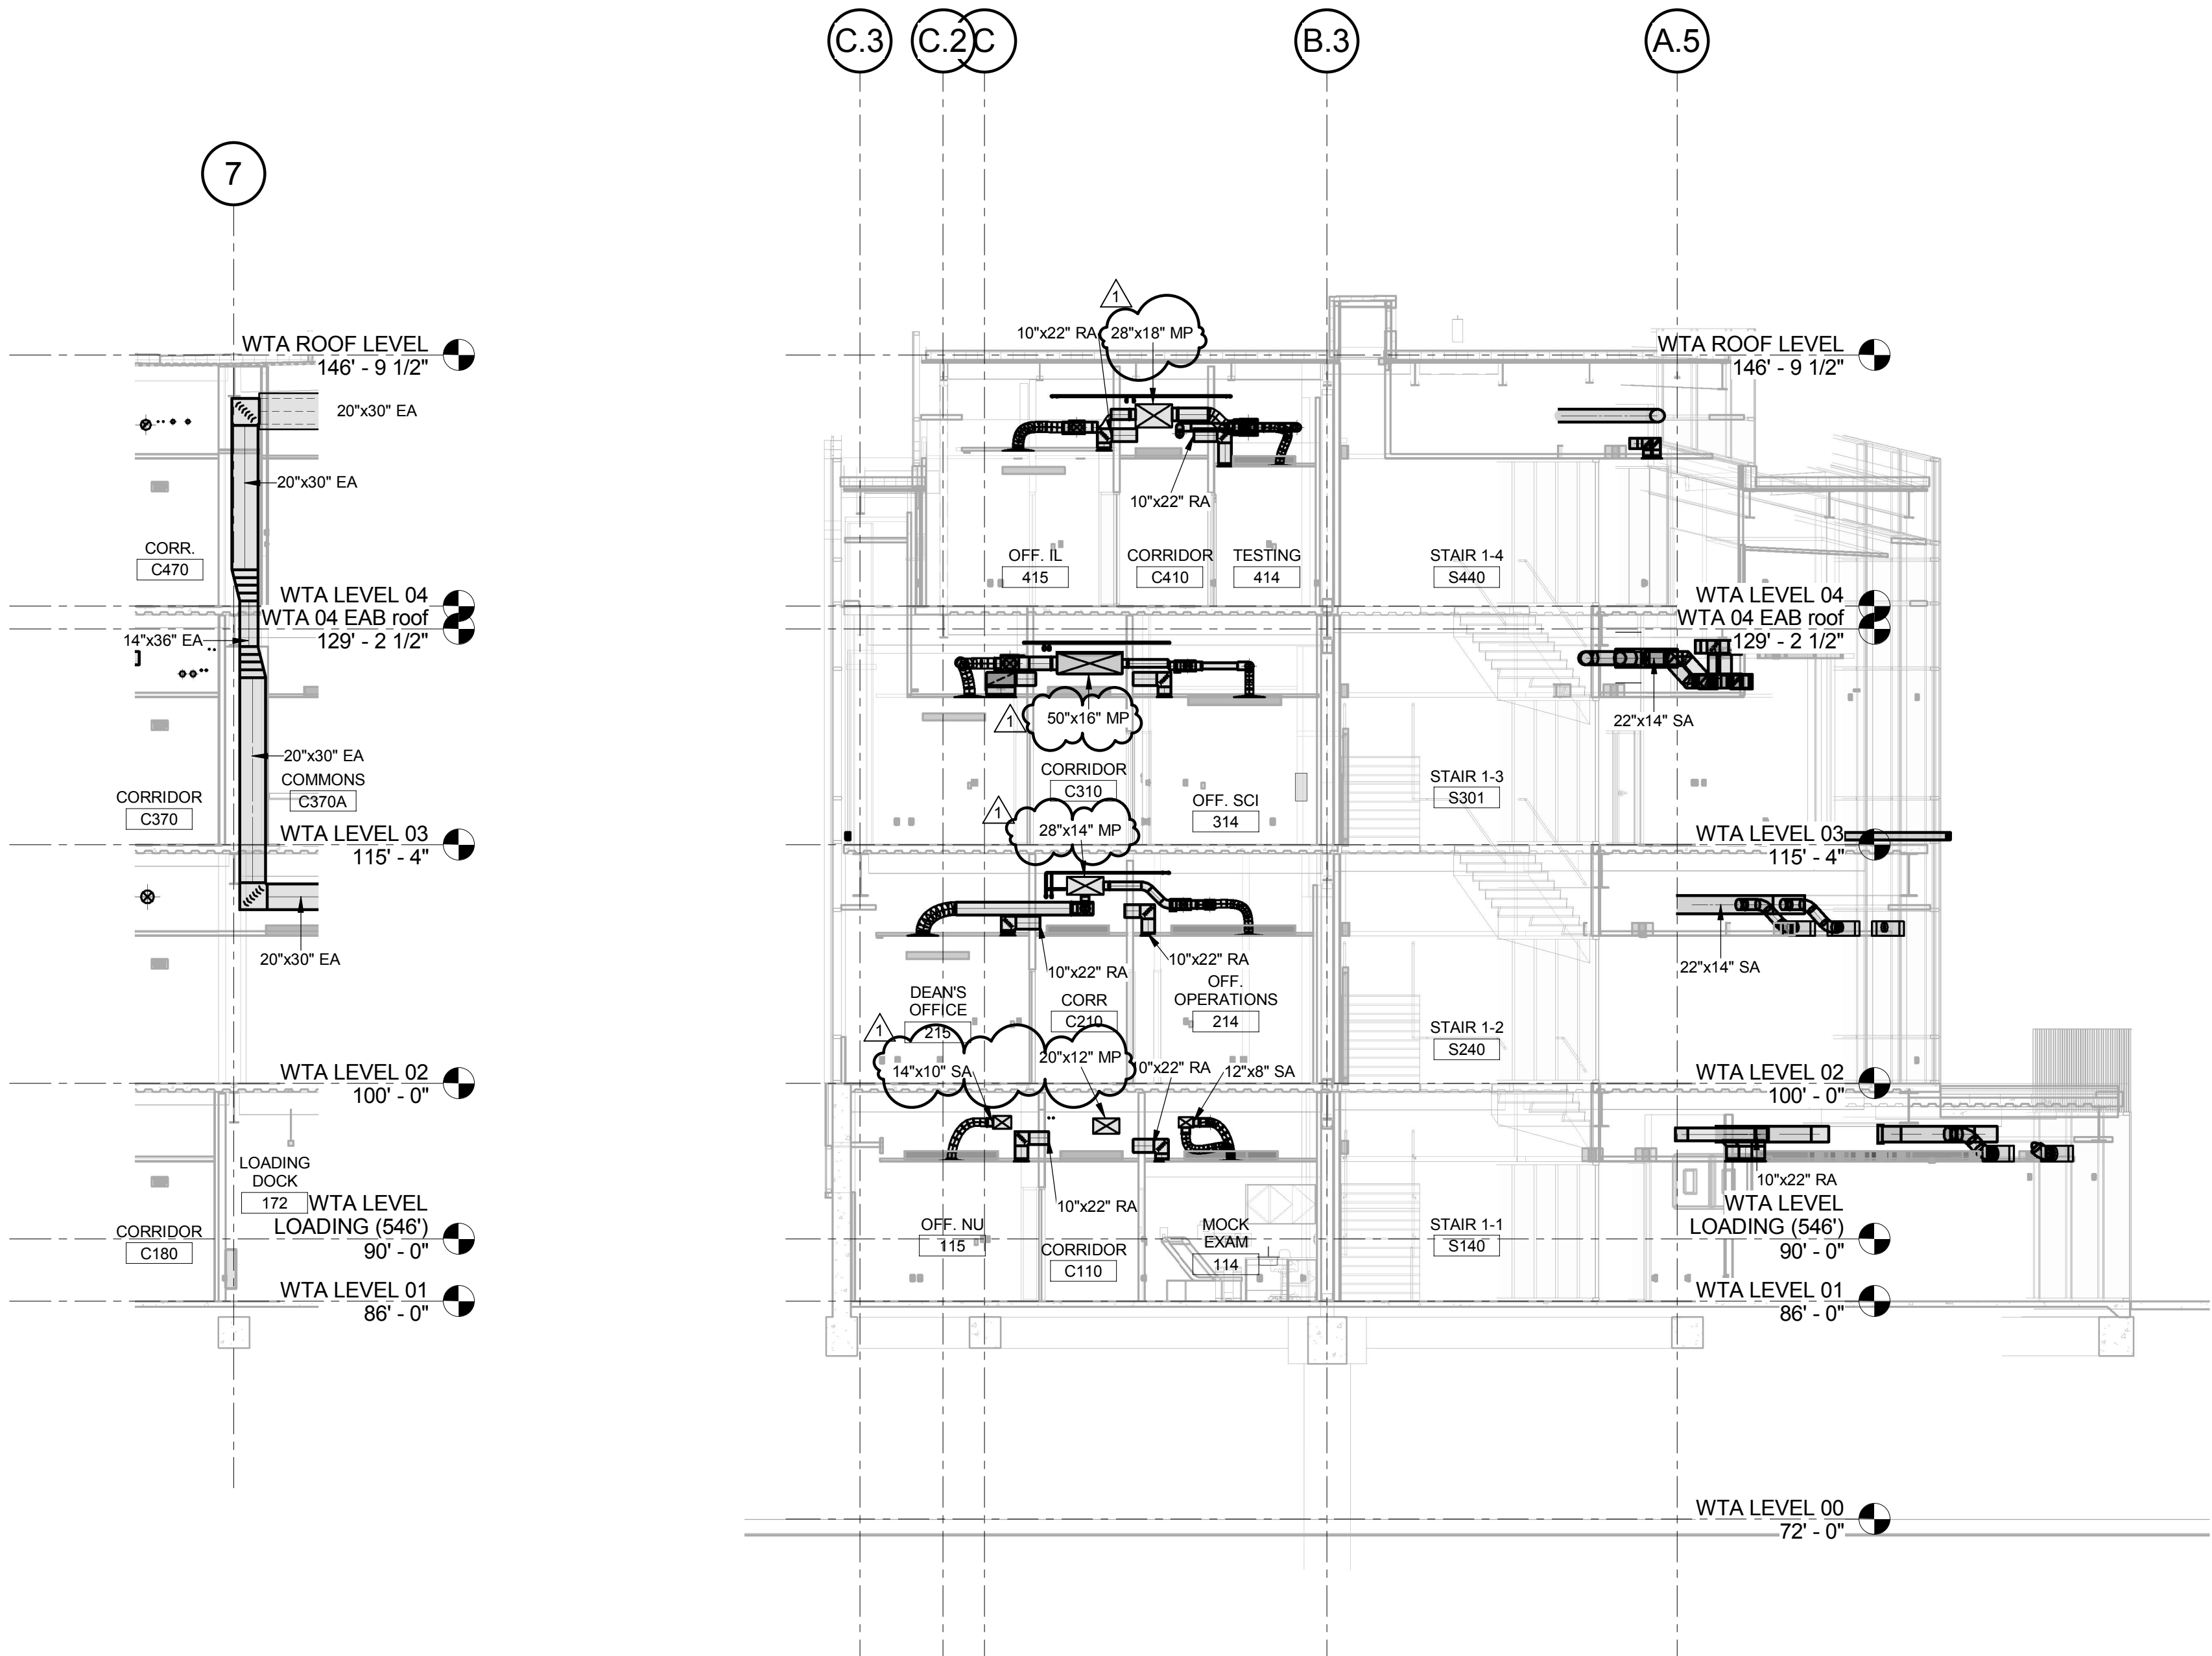

3 EXHAUST RISER LOOKING NORTH  
1/8" = 1'-0"

1 AREA B - (LOOKING EAST)  
1/8" = 1'-0"

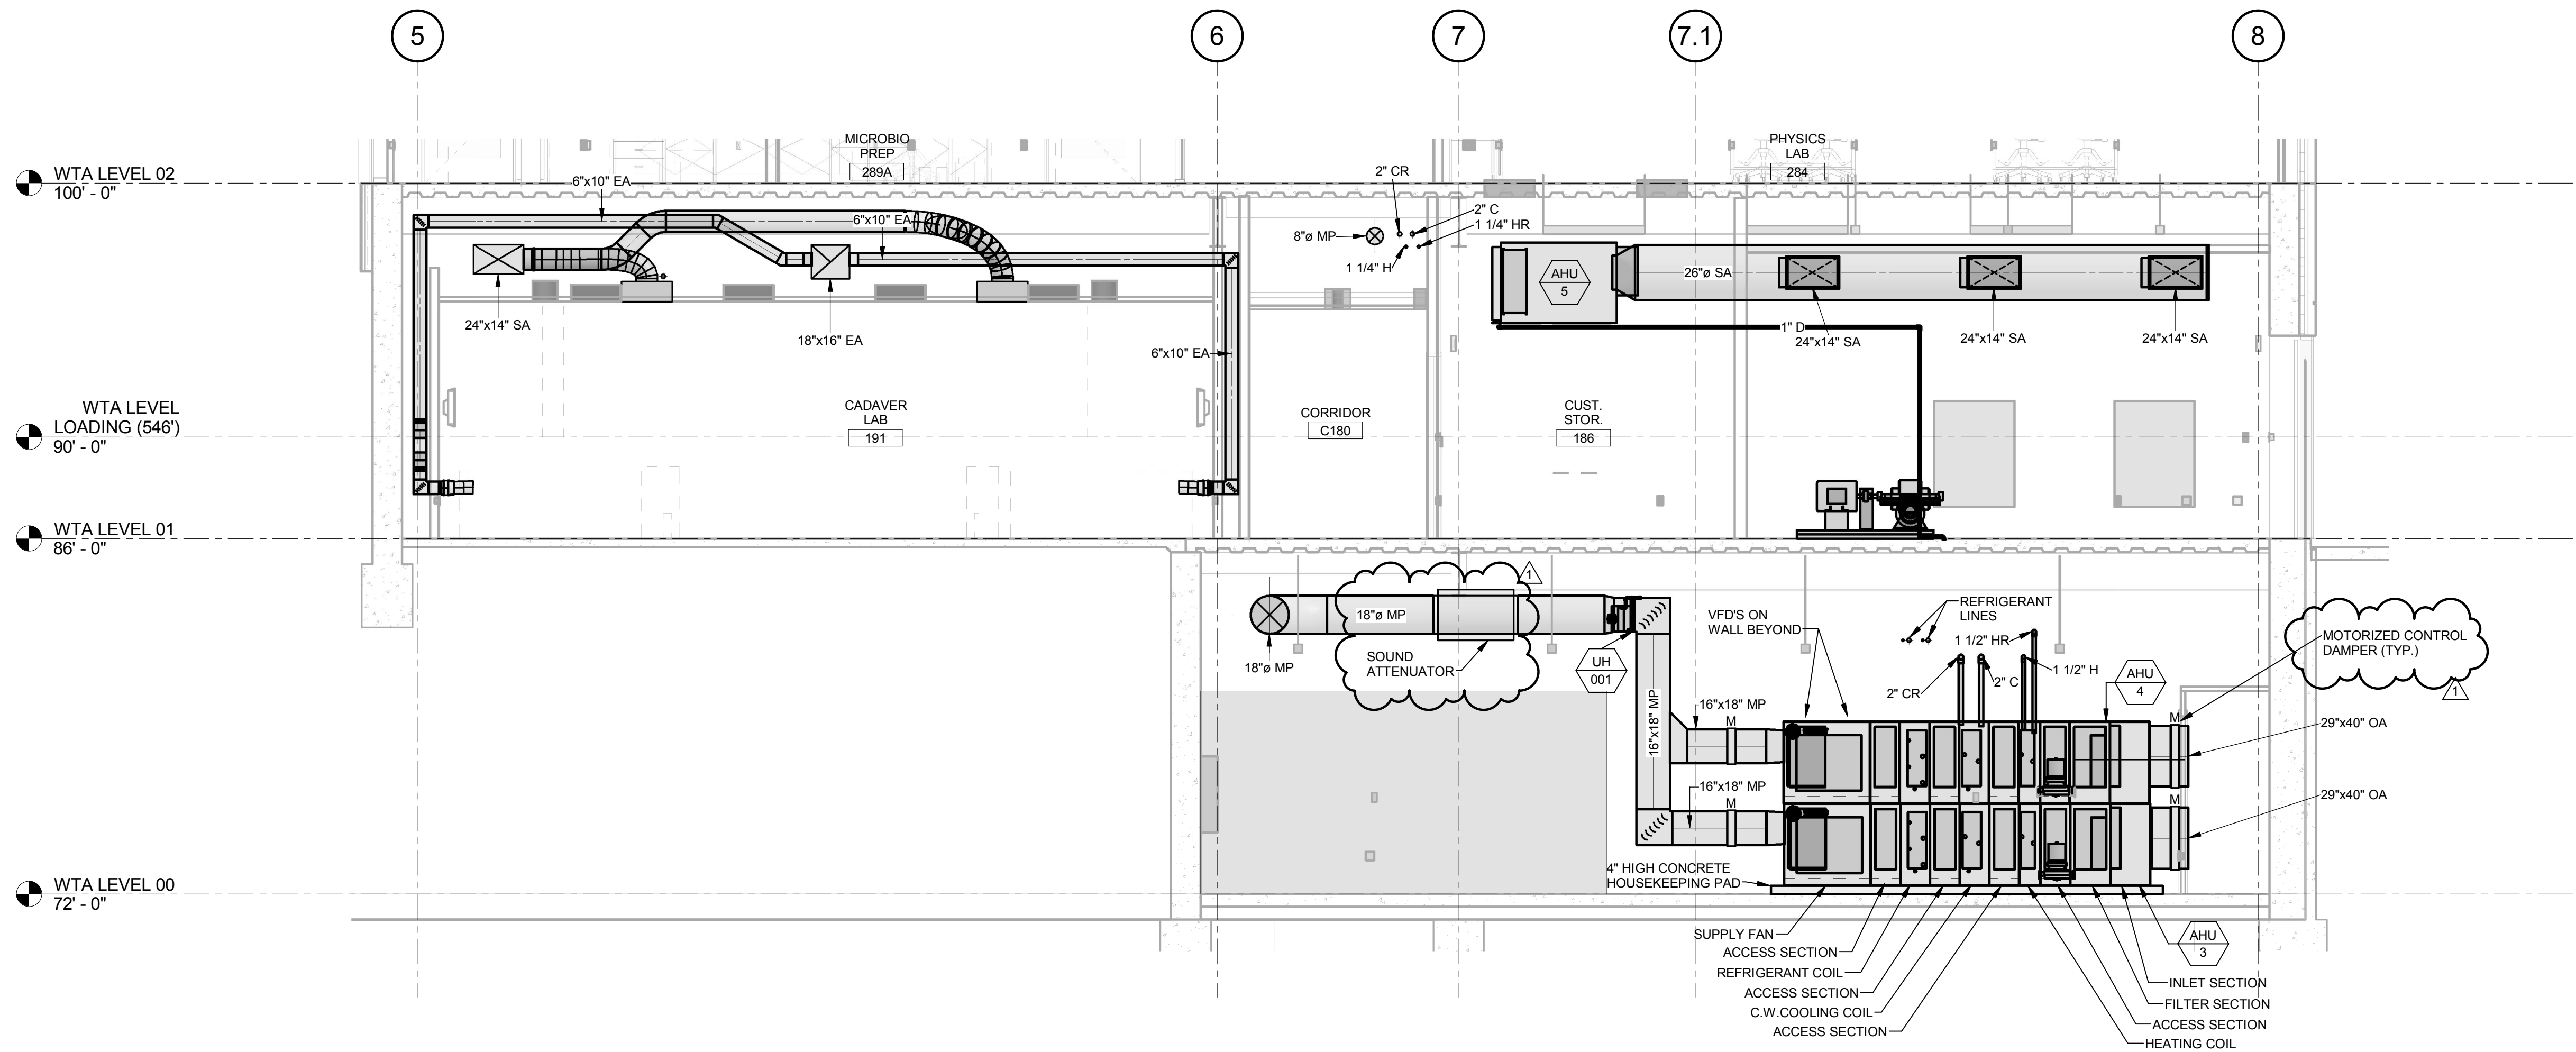

2 AHU-3 & 4 - (LOOKING NORTH)  
1/4" = 1'-0"

|     |                               |             |
|-----|-------------------------------|-------------|
| 1   | ADDENDUM 2-1                  | 17 MAR 2016 |
| 1   | ISSUED FOR CONSTRUCTION (BP2) | 01 MAR 2016 |
| No. | Description                   | Date        |

Drawing Title:

SECTIONS & ELEVATIONS

Project No.: 04561.01

Checked by:

M0302