

THE SEAL(S) AND SIGNATURE(S) APPLY ONLY TO THE DOCUMENT TO WHICH THEY ARE AFFIXED, AND EXPRESSLY DISCLAIM ANY RESPONSIBILITY FOR ALL OTHER PLANS, SPECIFICATIONS, ESTIMATES, REPORTS OR OTHER DOCUMENTS OR INSTRUMENTS RELATING TO OR INTENDED TO BE USED FOR ANY PART OR PARTS OF THE ARCHITECTURAL OR ENGINEERING PROJECT.


|     |                               |             |
|-----|-------------------------------|-------------|
| 2   | ASI-045                       | 19 JAN 2017 |
| 1   | ADDENDUM 2-1                  | 17 MAR 2016 |
| -   | ISSUED FOR CONSTRUCTION (BP2) | 01 MAR 2016 |
| No. | Description                   | Date        |

Drawing Title:

SECTIONS & ELEVATIONS


Project No.: 04561.01      Checked by:

M0303

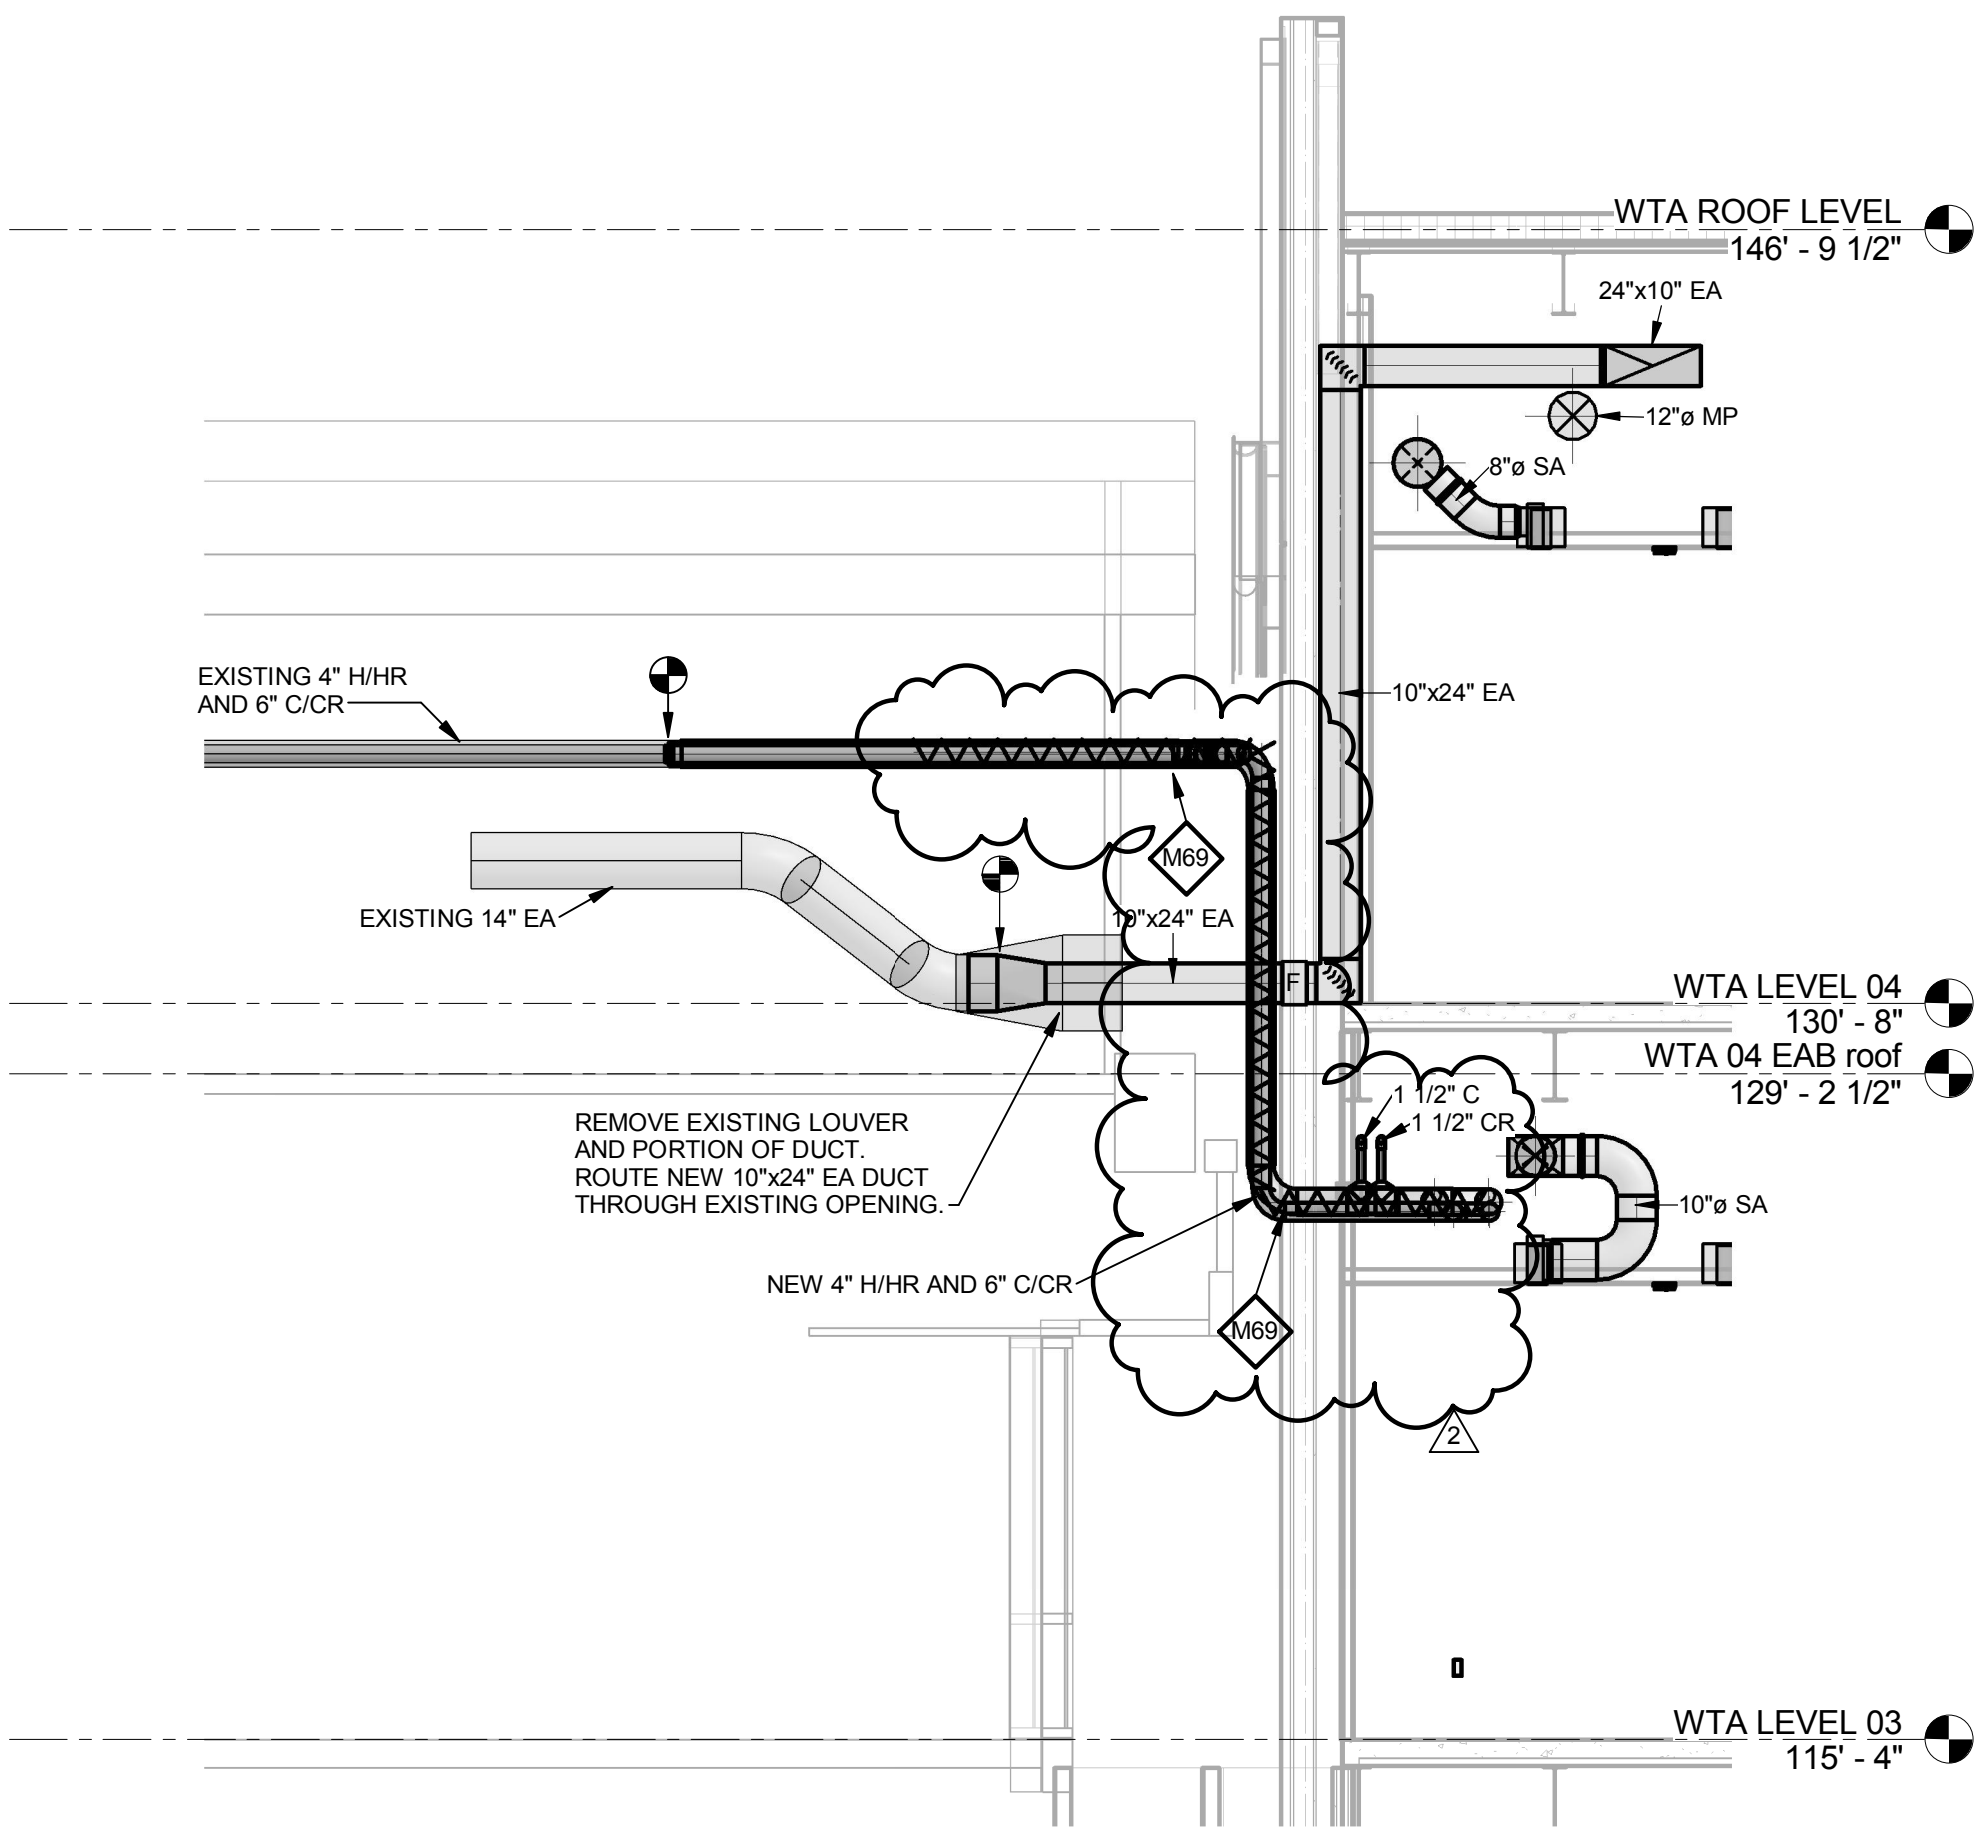

3 SECTION THROUGH EAB ATTIC

1/4" = 1'-0"

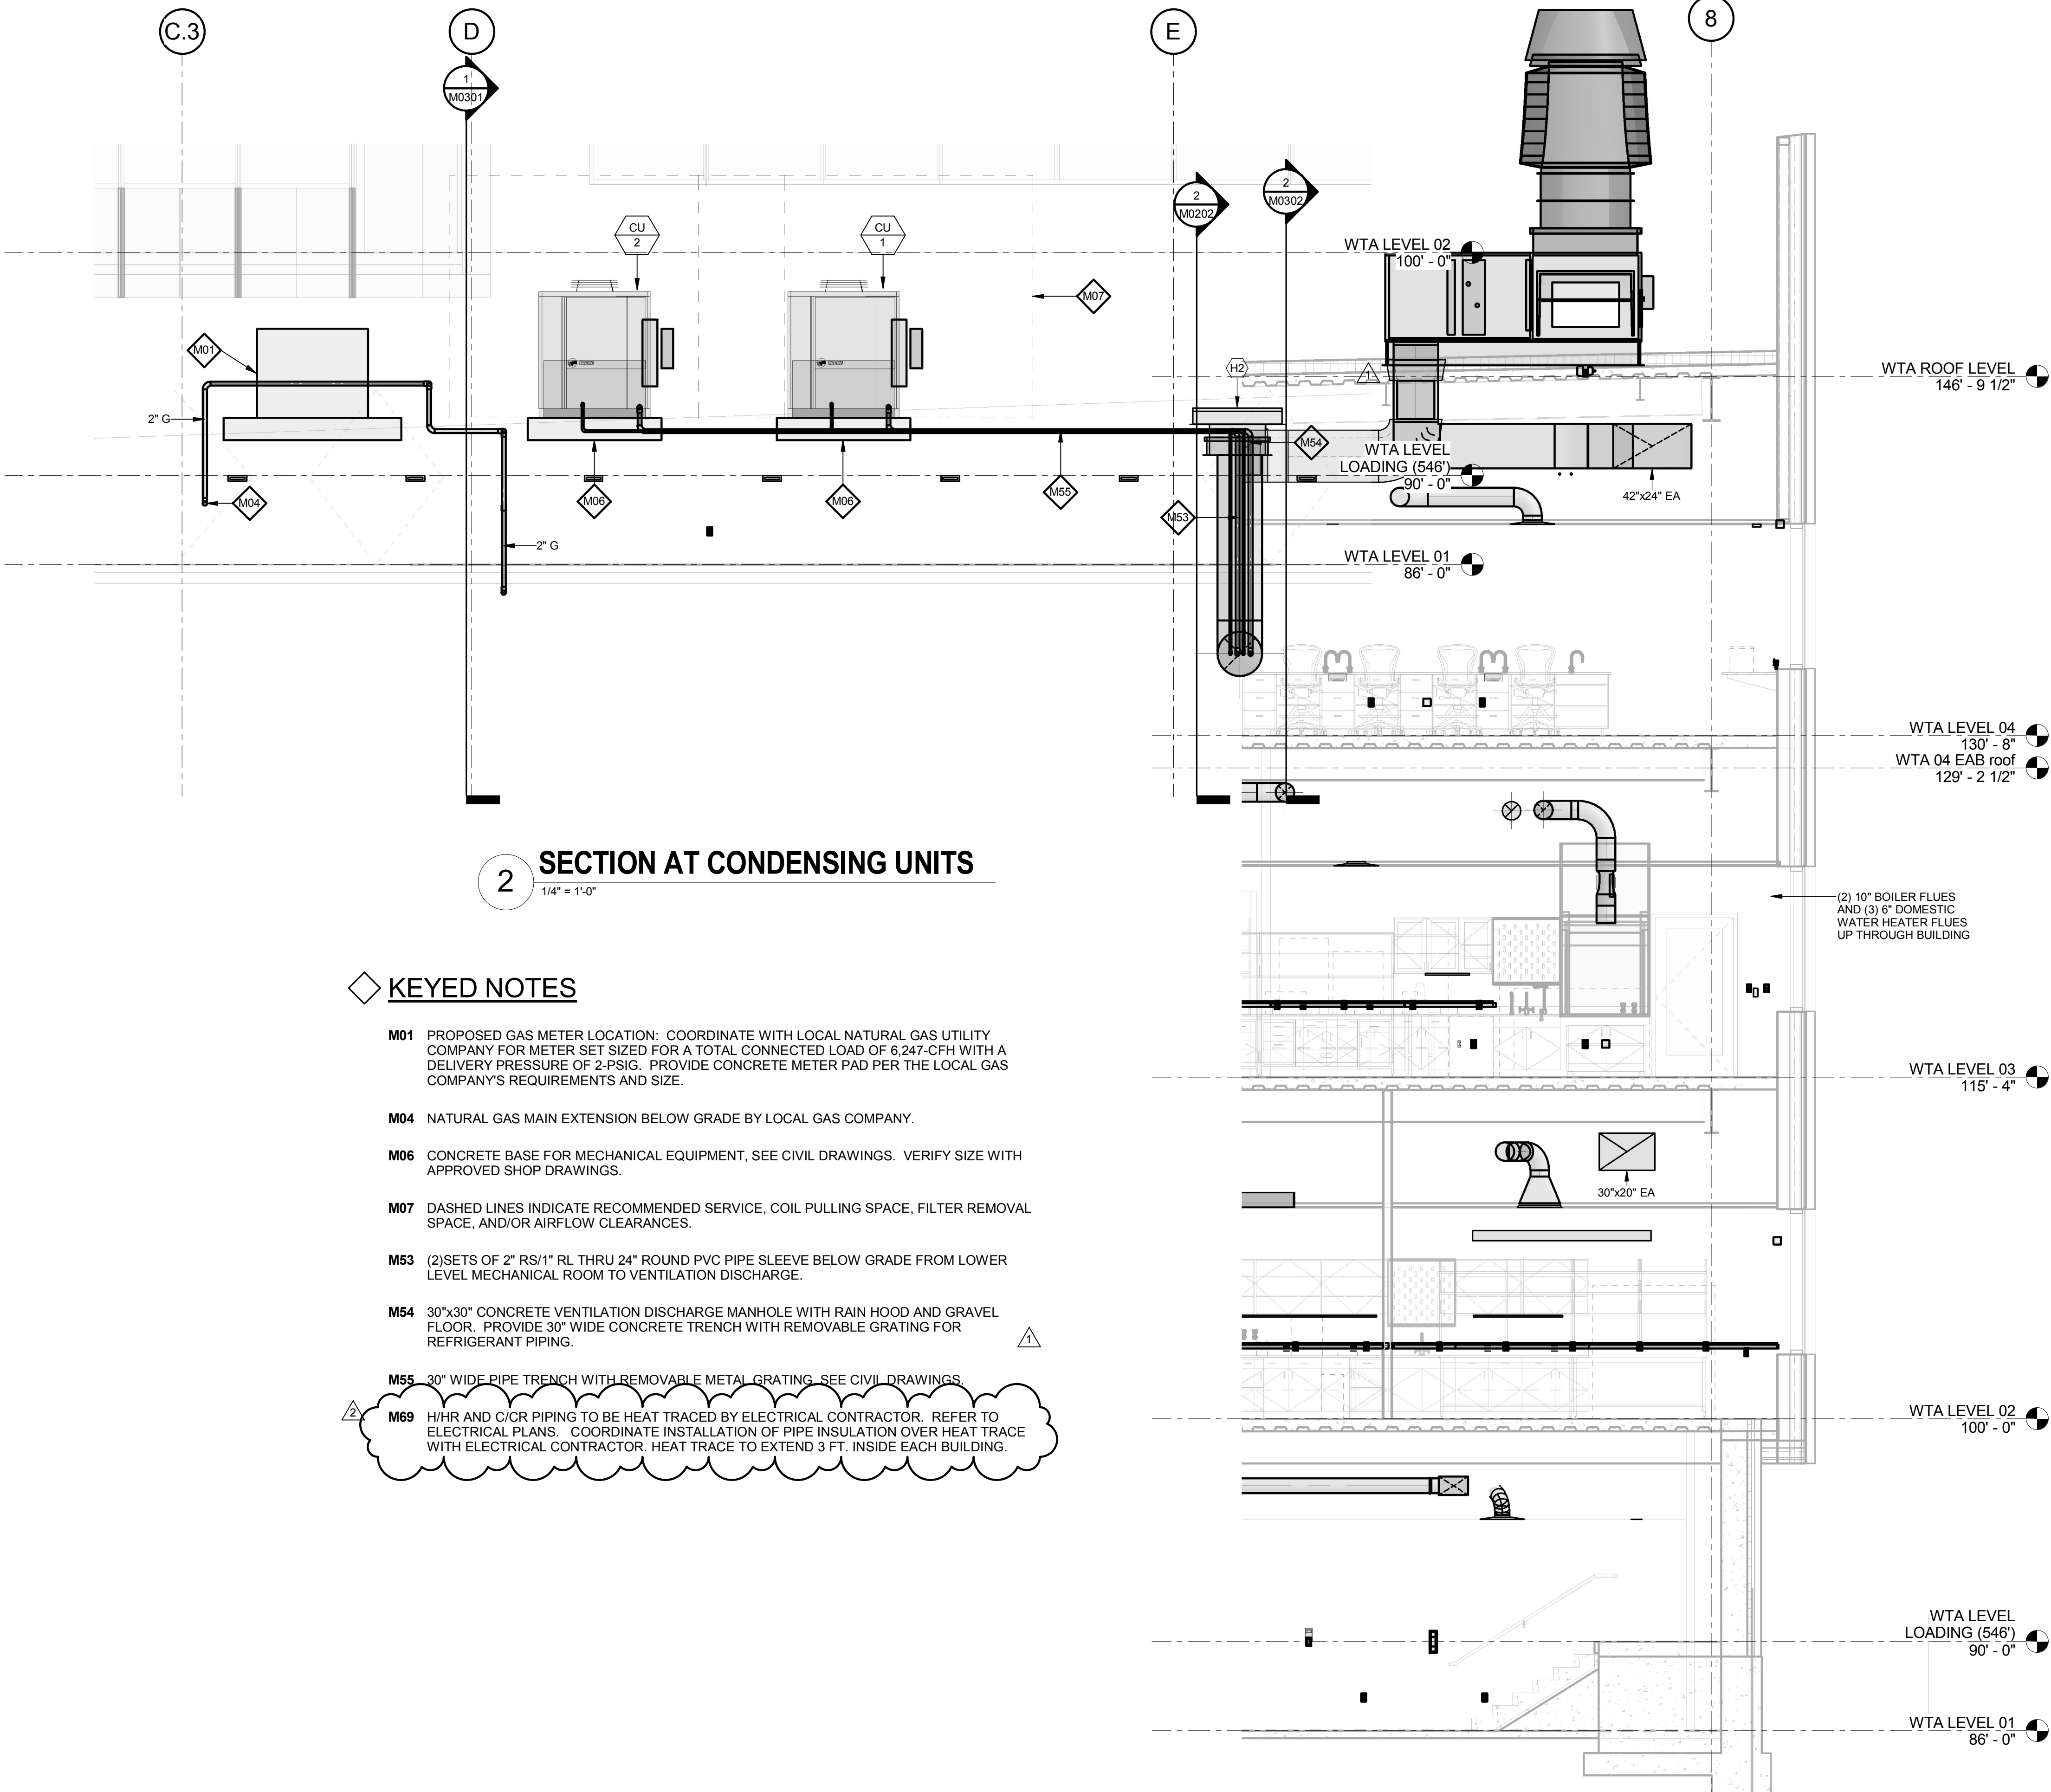

2 SECTION AT CONDENSING UNITS

1/4" = 1'-0"

KEYED NOTES

- M01 PROPOSED GAS METER LOCATION. COORDINATE WITH LOCAL NATURAL GAS UTILITY COMPANY FOR METER SET SIZED FOR A TOTAL CONNECTED LOAD OF 6,247-GPH WITH A DELIVERY PRESSURE OF 2-PSIG. PROVIDE CONCRETE METER PAD PER THE LOCAL GAS COMPANY'S REQUIREMENTS AND SIZE.
- M04 NATURAL GAS MAIN EXTENSION BELOW GRADE BY LOCAL GAS COMPANY.
- M06 CONCRETE BASE FOR MECHANICAL EQUIPMENT, SEE CIVIL DRAWINGS. VERIFY SIZE WITH APPROVED SHOP DRAWINGS.
- M07 DASHED LINES INDICATE RECOMMENDED SERVICE, COIL PULLING SPACE, FILTER REMOVAL SPACE, AND/OR AIRFLOW CLEARANCES.
- M53 (2)SETS OF 2" RS-1" RL THRU 24" ROUND PVC PIPE SLEEVE BELOW GRADE FROM LOWER LEVEL MECHANICAL ROOM TO VENTILATION DISCHARGE.
- M54 30"x30" CONCRETE VENTILATION DISCHARGE MANHOLE WITH RAIN HOOD AND GRAVEL FLOOR. PROVIDE 30" WIDE CONCRETE TRENCH WITH REMOVABLE GRATING FOR REFRIGERANT PIPING.
- M55 30" WIDE PIPE TRENCH WITH REMOVABLE METAL GRATING. SEE CIVIL DRAWINGS.
- M69 HHR AND C/C/R PIPING TO BE HEAT TRACED BY ELECTRICAL CONTRACTOR. REFER TO ELECTRICAL PLANS. COORDINATE INSTALLATION OF PIPE INSULATION OVER HEAT TRACE WITH ELECTRICAL CONTRACTOR. HEAT TRACE TO EXTEND 3 FT. INSIDE EACH BUILDING.

1 SECTION AT BOILER FLUES

1/4" = 1'-0"