


© Cannon Design 2015
All rights reserved. No part of this document may be reproduced or transmitted in any form or by any means, electronic or mechanical, including photocopying, recording, or by any information storage and retrieval system, without written authorization by The Cannon Corporation.
12/9/2016 11:45:59 AM

CONTROL DIAGRAM LEGEND										GENERAL NOTES FOR ALL SHEETS
SYMBOL	DESCRIPTION	SYMBOL	DESCRIPTION	SYMBOL	DESCRIPTION	SYMBOL	DESCRIPTION	SYMBOL	DESCRIPTION	GENERAL COORDINATE ALL CONTROLS WORK WITH CONTRACTORS ON ALL RELATED CONSTRUCTION PACKAGES. ALL POINTS DEFINED BELOW SHALL BE INDEPENDENT. ALL SET POINTS SHALL BE ADJUSTABLE. IN THE EVENT OF AN ABNORMAL OFF CONDITION, THE FAILED EQUIPMENT SHALL BE LOCKED OUT AND AN ALARM SHALL BE SENT TO THE OPERATOR'S WORK STATION. IF THE EQUIPMENT IN QUESTION IS PART OF AN N+1 REDUNDANT GROUP THE NEXT UNIT IN ROTATION SHALL START. POWER FAILURE MODE THE AUTOMATION SYSTEM SHALL MONITOR THE GENERATOR CONTROL SYSTEM FOR LOSS OF UTILITY POWER SIGNAL. OPERATING ON GENERATORS SIGNAL AND SYSTEM READY TO RETURN TO UTILITY POWER SIGNAL. ON A LOSS OF UTILITY POWER, THE AUTOMATION SYSTEM SHALL WAIT FOR ALL SPINNING LOADS TO COME TO A STOP 4 MINUTES (ADJ.). UPON RECEIPT OF THE OPERATING ON GENERATORS SIGNAL, THE AUTOMATION SYSTEM SHALL START THE BUILDING HVAC EQUIPMENT AS FOLLOWS. LAB EXHAUST FAN SYSTEM - ONE FAN AT 25% AIRFLOW BUILDING HEATING WATER PUMPS CADAVER LAB AIR HANDLING UNITS - AHU-3 OR AHU-4 CADAVER LAB CONDNSING UNITS - CU-3 OR CU-4 ON RECEIPT OF A SYSTEM READY TO RETURN TO UTILITY POWER SIGNAL ALL HVAC LOADS SHALL BE STOPPED. AFTER A FIVE MINUTE DELAY (ADJ.) THE EQUIPMENT SHALL BE STARTED IN ACCORDANCE WITH THE ABOVE SEQUENCE FOR STARTING ON GENERATOR POWER.
	SUPPLY OR EXHAUST AIR VALVE		VARIABLE FREQUENCY DRIVE		GRAVITY BACKDRAFT DAMPER		TEMPERATURE SENSOR		FILTER DIFFERENTIAL PRESSURE	
	MOTOR OPERATED CONTROL DAMPER		2-WAY CONTROL VALVE		HEAT EXCHANGER		HUMIDITY SENSOR		DIGITAL INPUT	
	FILTER		3-WAY CONTROL VALVE		HEAT EXCHANGER		CARBON MONOXIDE SENSOR		DIGITAL OUTPUT	
	COOLING COIL		FLOW MEASURING DEVICE		VARIABLE AIR VOLUME TERMINAL UNIT		CARBON DIOXIDE SENSOR		ANALOG INPUT	
	HEATING COIL		PUMP		FREEZE STAT		OUTSIDE RELATIVE HUMIDITY SENSOR		ANALOG OUTPUT	
	FAN		DIRECTION OF FLOW				BUILDING STATIC PRESSURE SENSOR		NORMALLY OPEN (CONTROLLED DEVICE POSITION WITHOUT POWER)	
							SMOKE DETECTOR		NORMALLY CLOSED (CONTROLLED DEVICE POSITION WITHOUT POWER)	

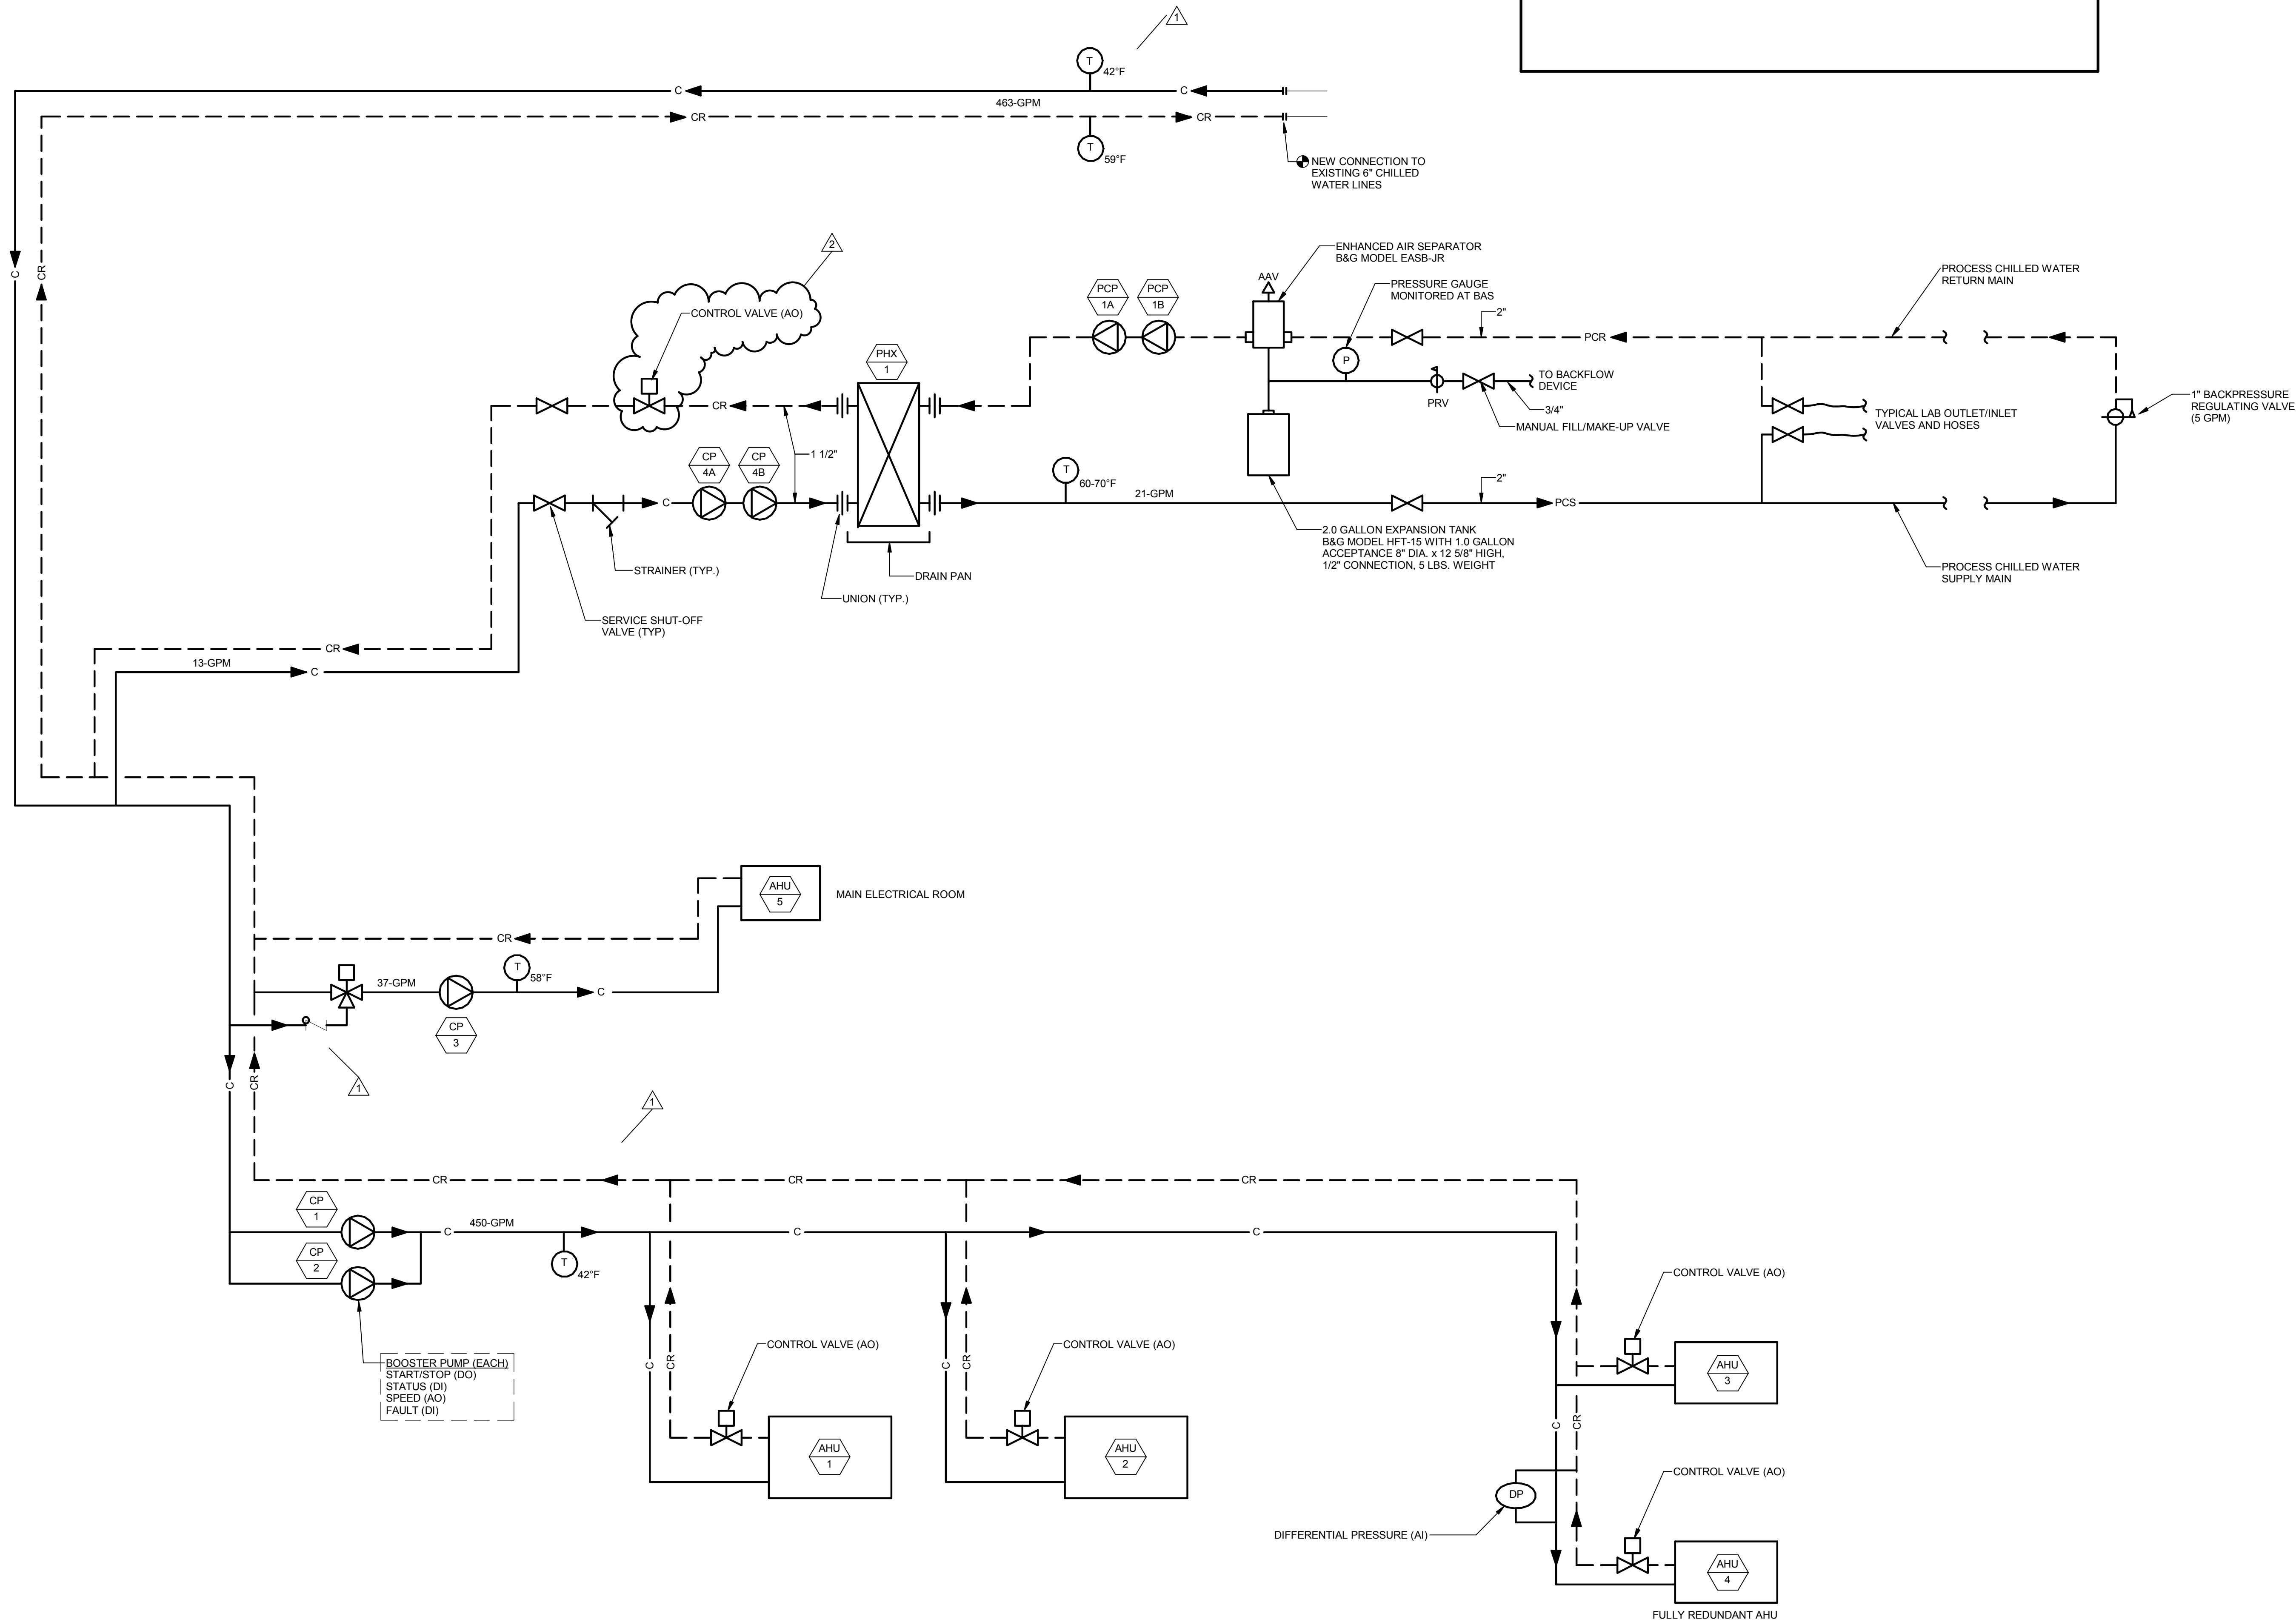

CHILLED WATER FLOW AND AUTOMATION DIAGRAM



Webster University
Interdisciplinary Science Building

CANNONDESIGN

1100 Clark Avenue
St. Louis, Missouri 63102
T: 314.241.6250
F: 314.241.2570

William Tao & Associates, Inc.
MEP/FP Engineer
7955 Manchester Road, Suite 125
St. Louis, MO 63143
314-884-7600

David Mason & Associates, Inc.
Structural & Civil Engineer
800 South Vandeventer Avenue
St. Louis, MO 63110
314.534.1053

Faith Group
Technology
3101 S. Hanley Rd., Suite 100
St. Louis, MO 63143
314.591.2225

Kuhmann Leavitt, Inc.
Environmental Graphics & Signage
7400 Pershing Ave.
St. Louis, MO 63130
314.725.6616

KWA Architects
Architecture
8721 Litzinger Road
St. Louis, MO 63124
314.962.2560

Spellman Brady & Company
Interior Designer
8251 Maryland Avenue, Suite 300
St. Louis, MO 63105
314.862.0070

SWT Design
Landscape Architect
7722 Big Bend Blvd.
St. Louis, MO 63119
314.644.5700

Webb Engineering Services, Inc.
Plumbing & Fire Protection
1400 S. 3rd Street, Suite 201
St. Louis, MO 63104
314.588.0600

2	ASI-040	09 DEC 2016
1	ASI-037	09 NOV 2016
-	ISSUED FOR CONSTRUCTION (BP2)	01 MAR 2016
No.	Description	Date

Drawing Title:

DIAGRAMS - MECHANICAL

Project No.: 04561.01 Checked by:

M0401