




© Cannon Design 2015
All rights reserved. No part of this document may be reproduced or transmitted in any form or by any means, electronic or mechanical, including photocopying, recording, or by any information storage and retrieval system, without written authorization by The Cannon Corporation.
3/17/2016 4:12:28 PM

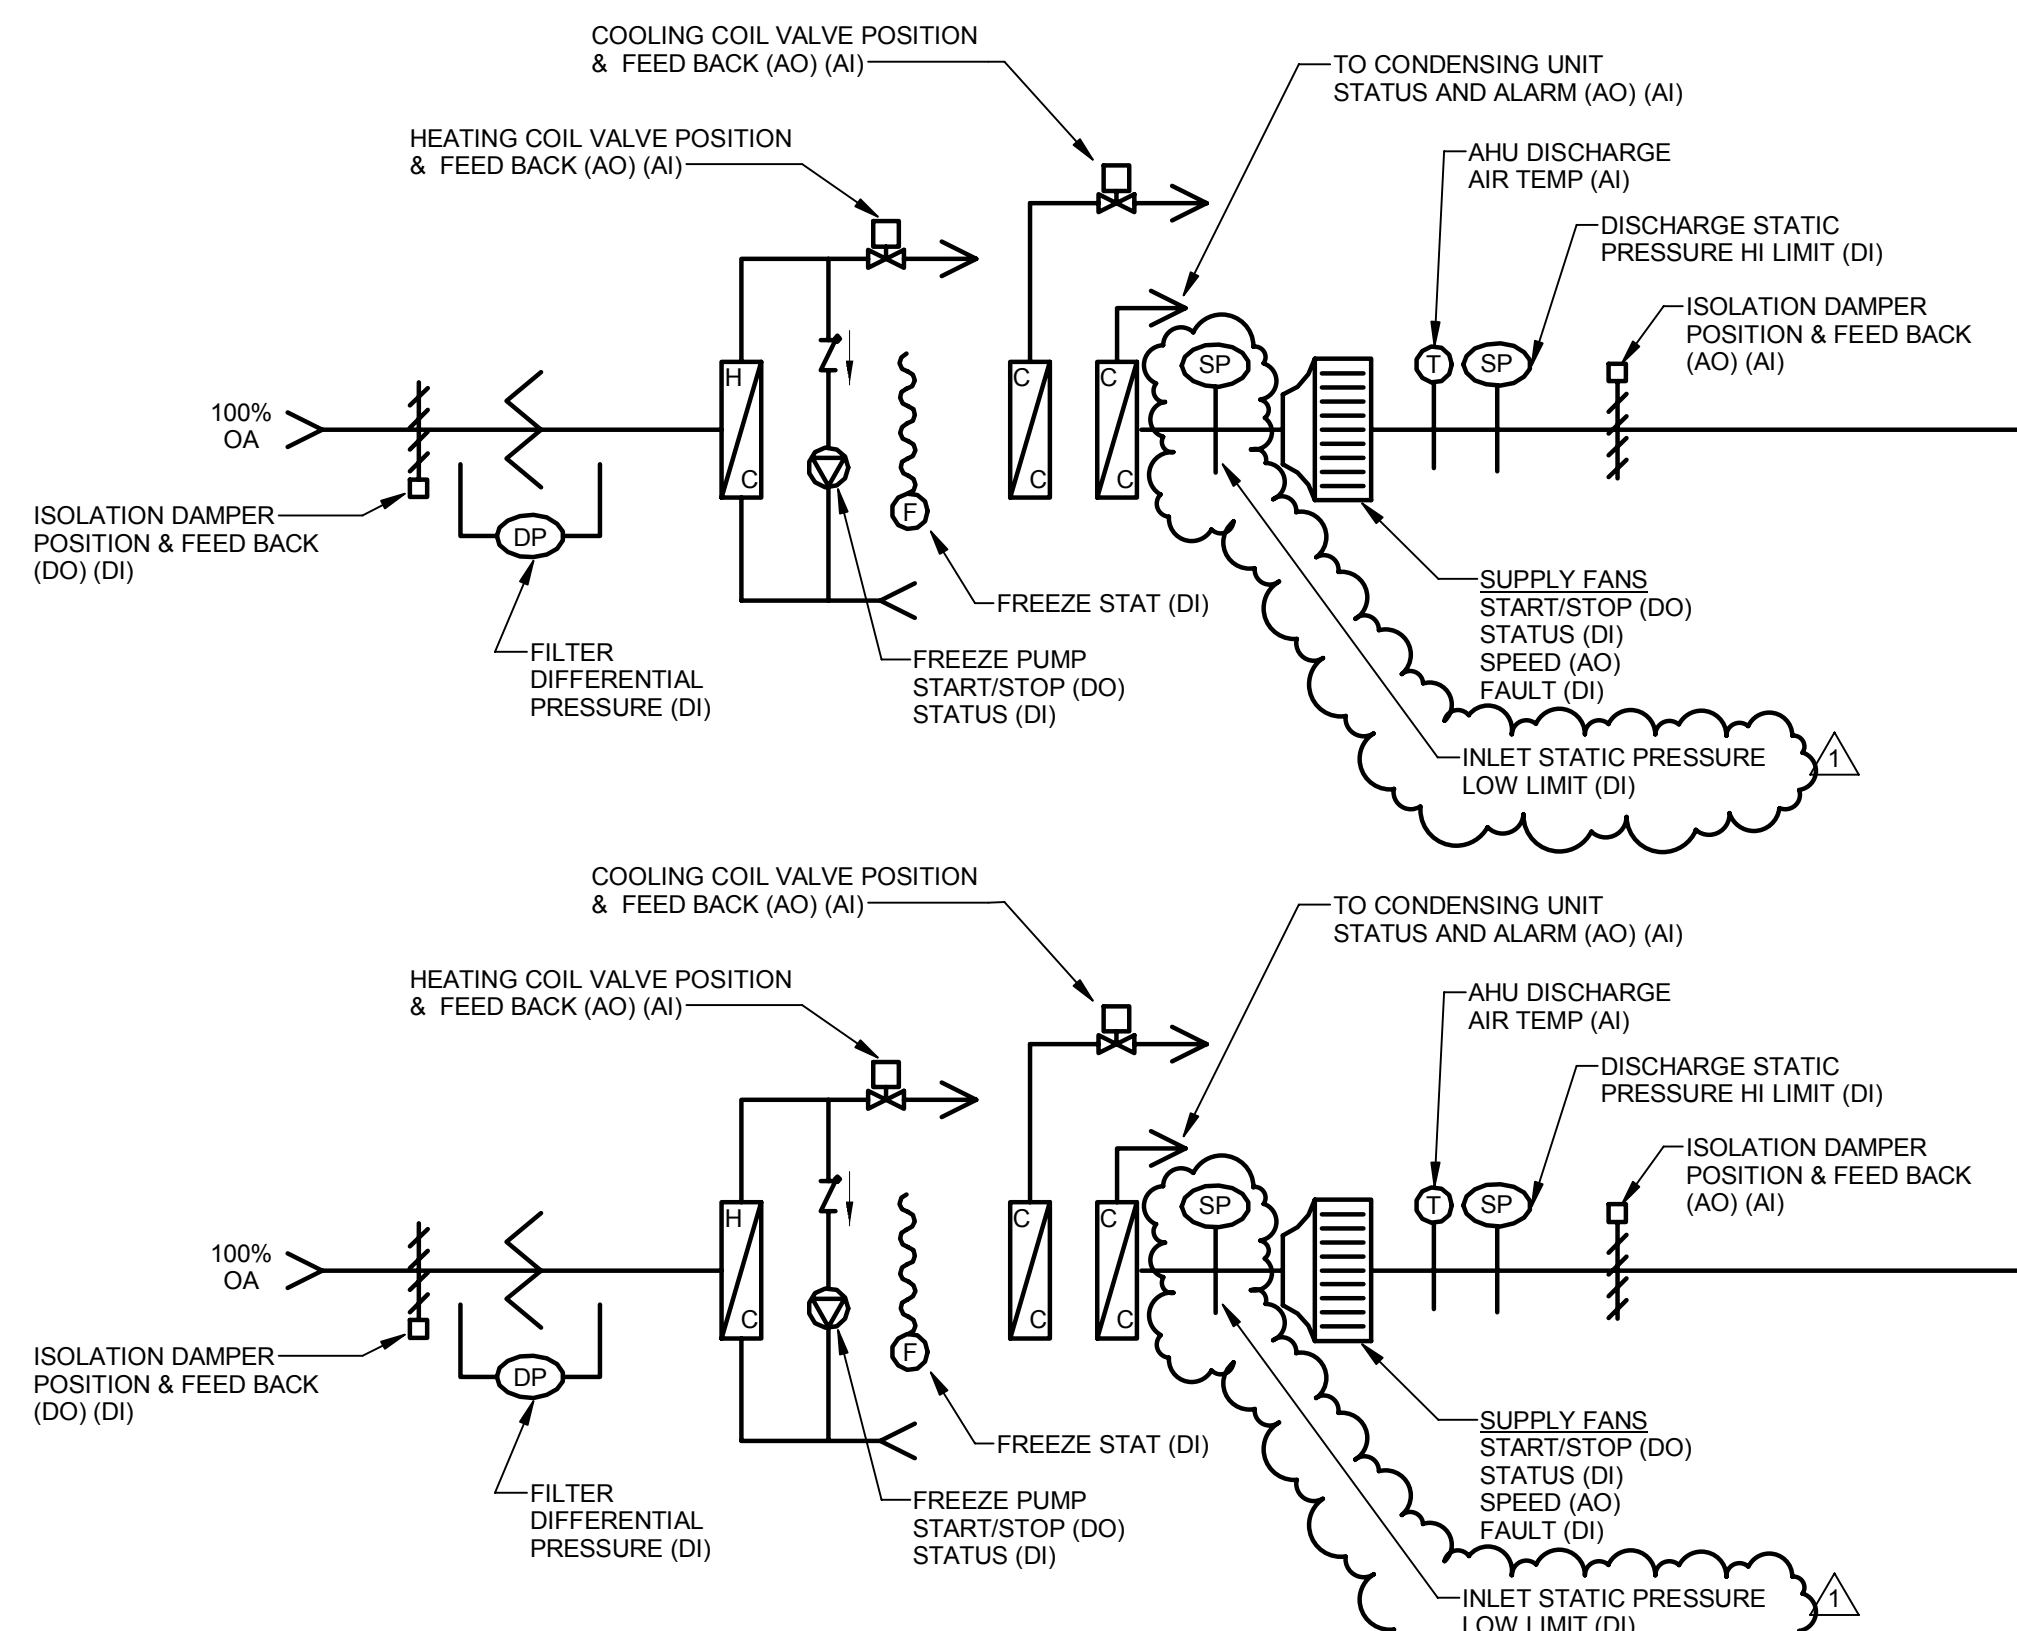


BUILDING AIR SYSTEM (AHU-3 AND AHU-4)
AHU-3 AND AHU-4 ARE FULLY REDUNDANT SYSTEM - ONLY ONE SYSTEM OPERATES AT A TIME

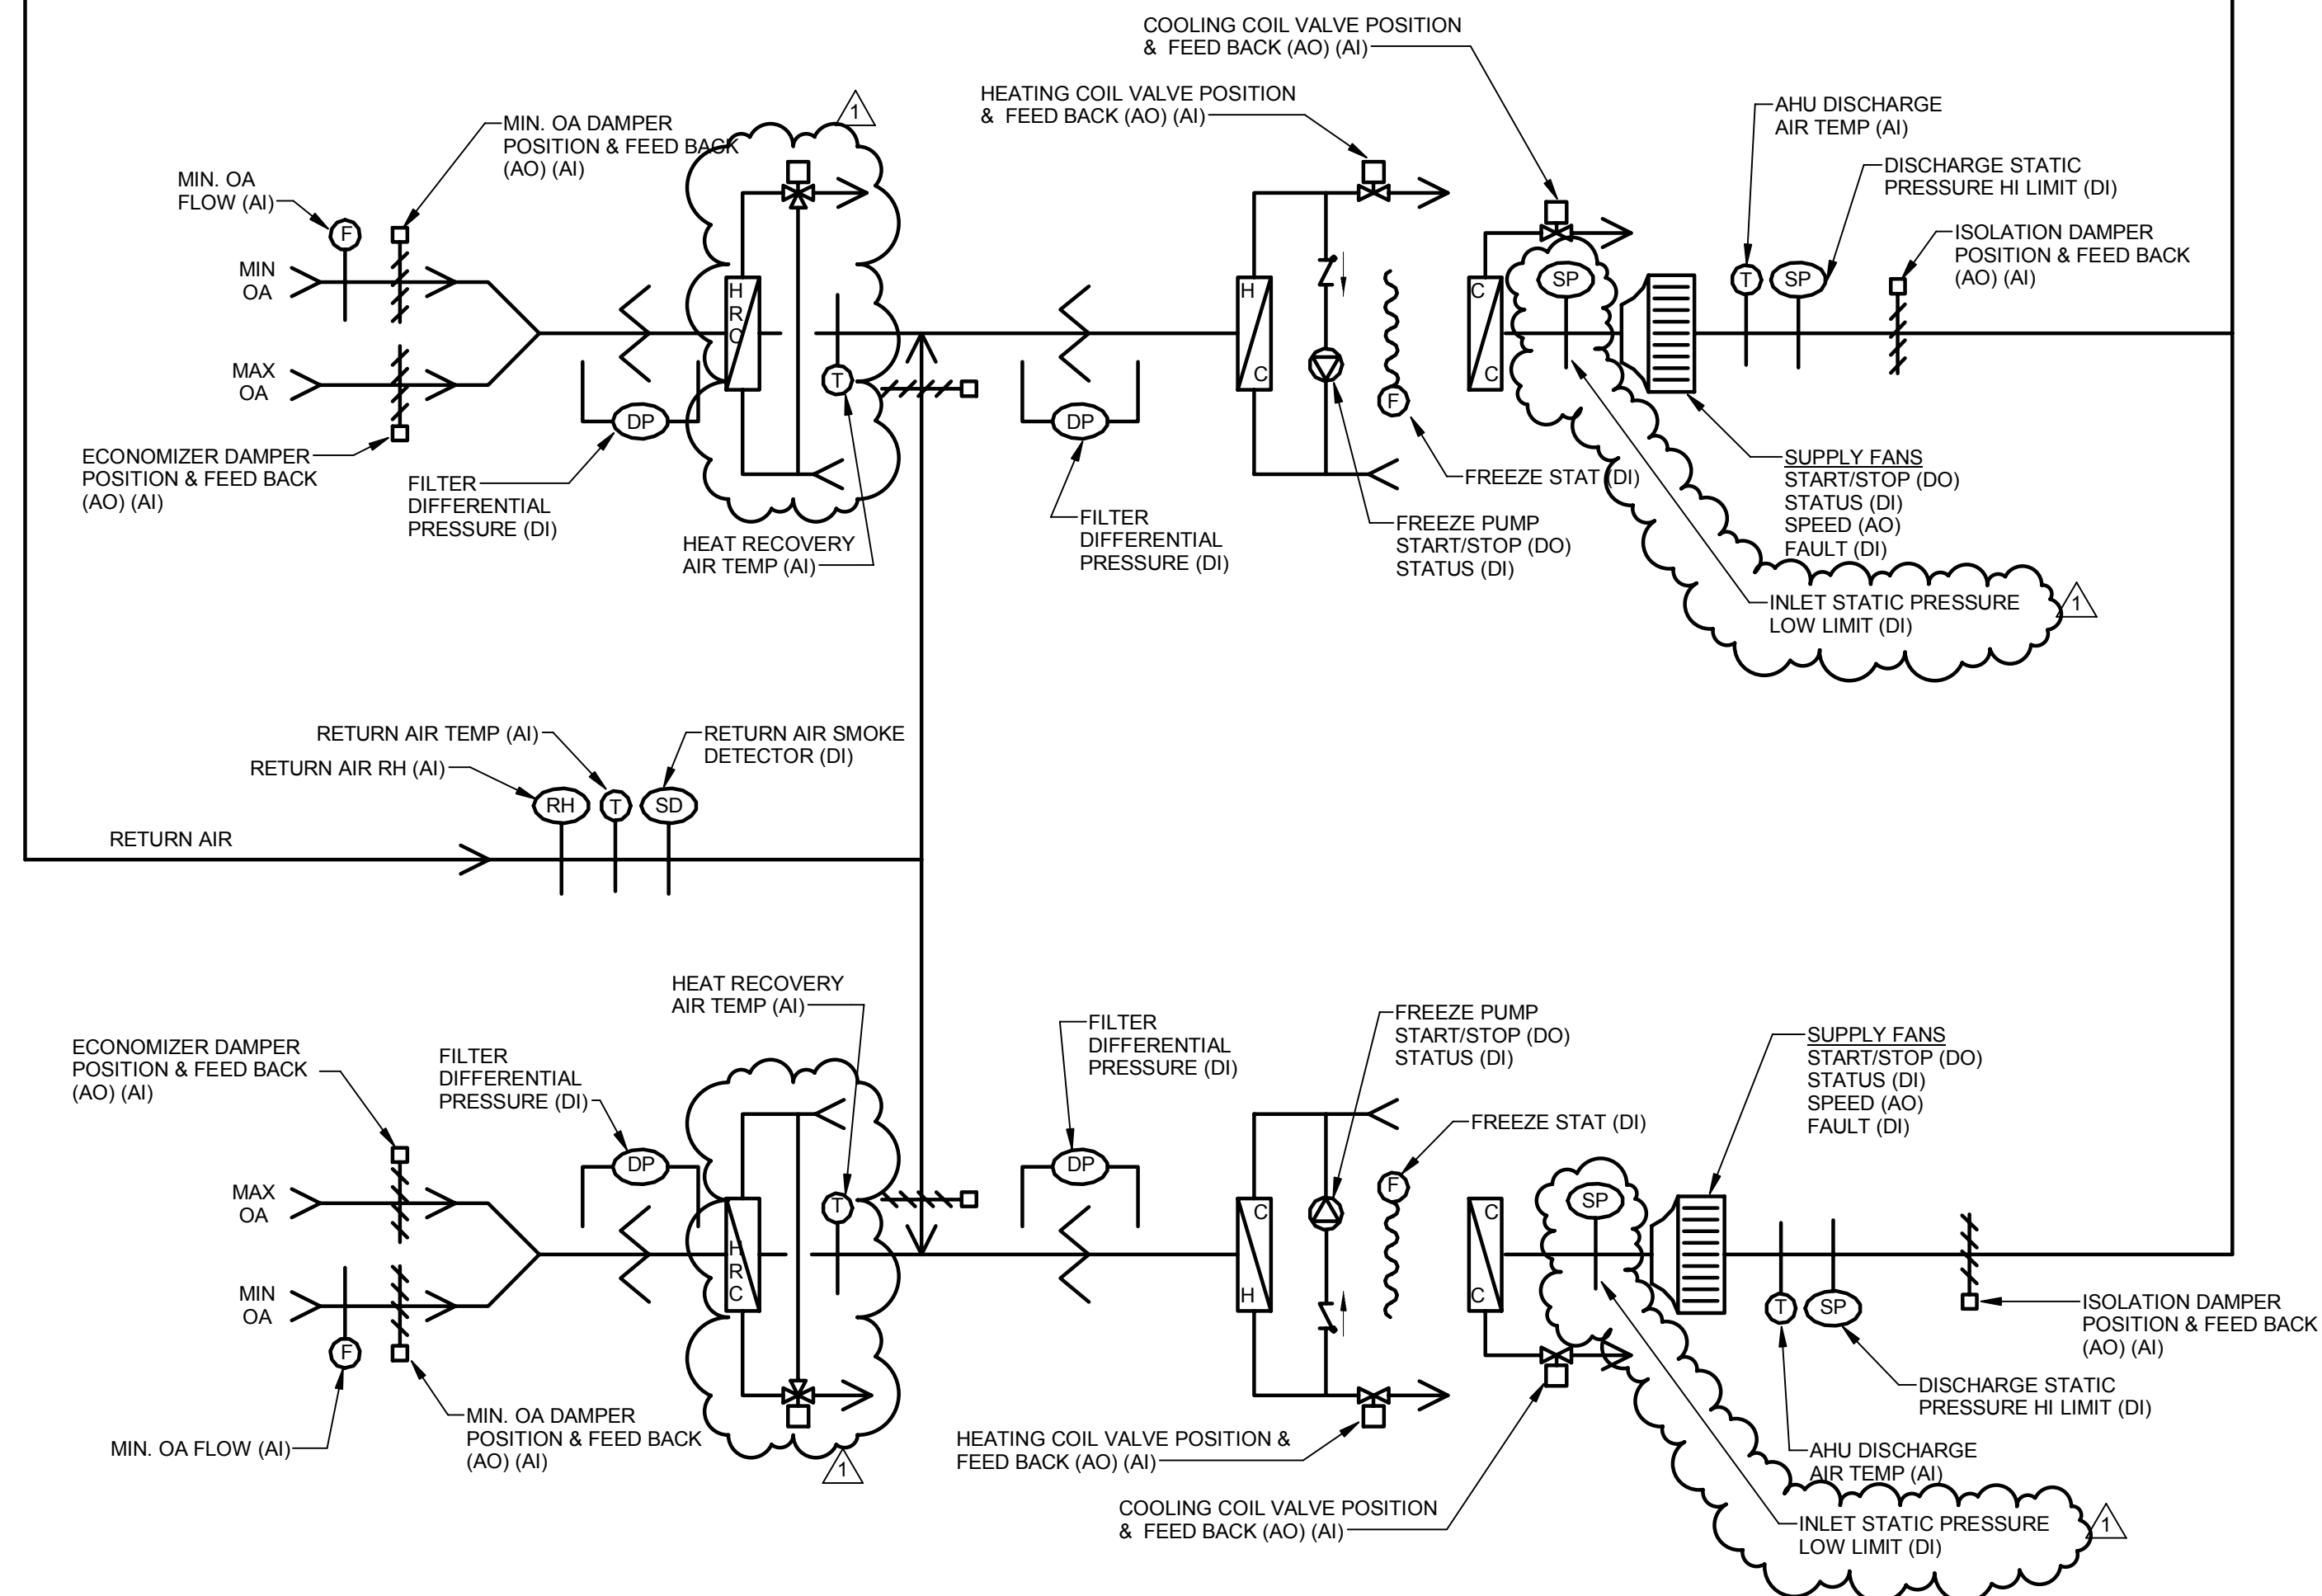

BUILDING AIR SYSTEM (AHU-1 AND AHU-2)

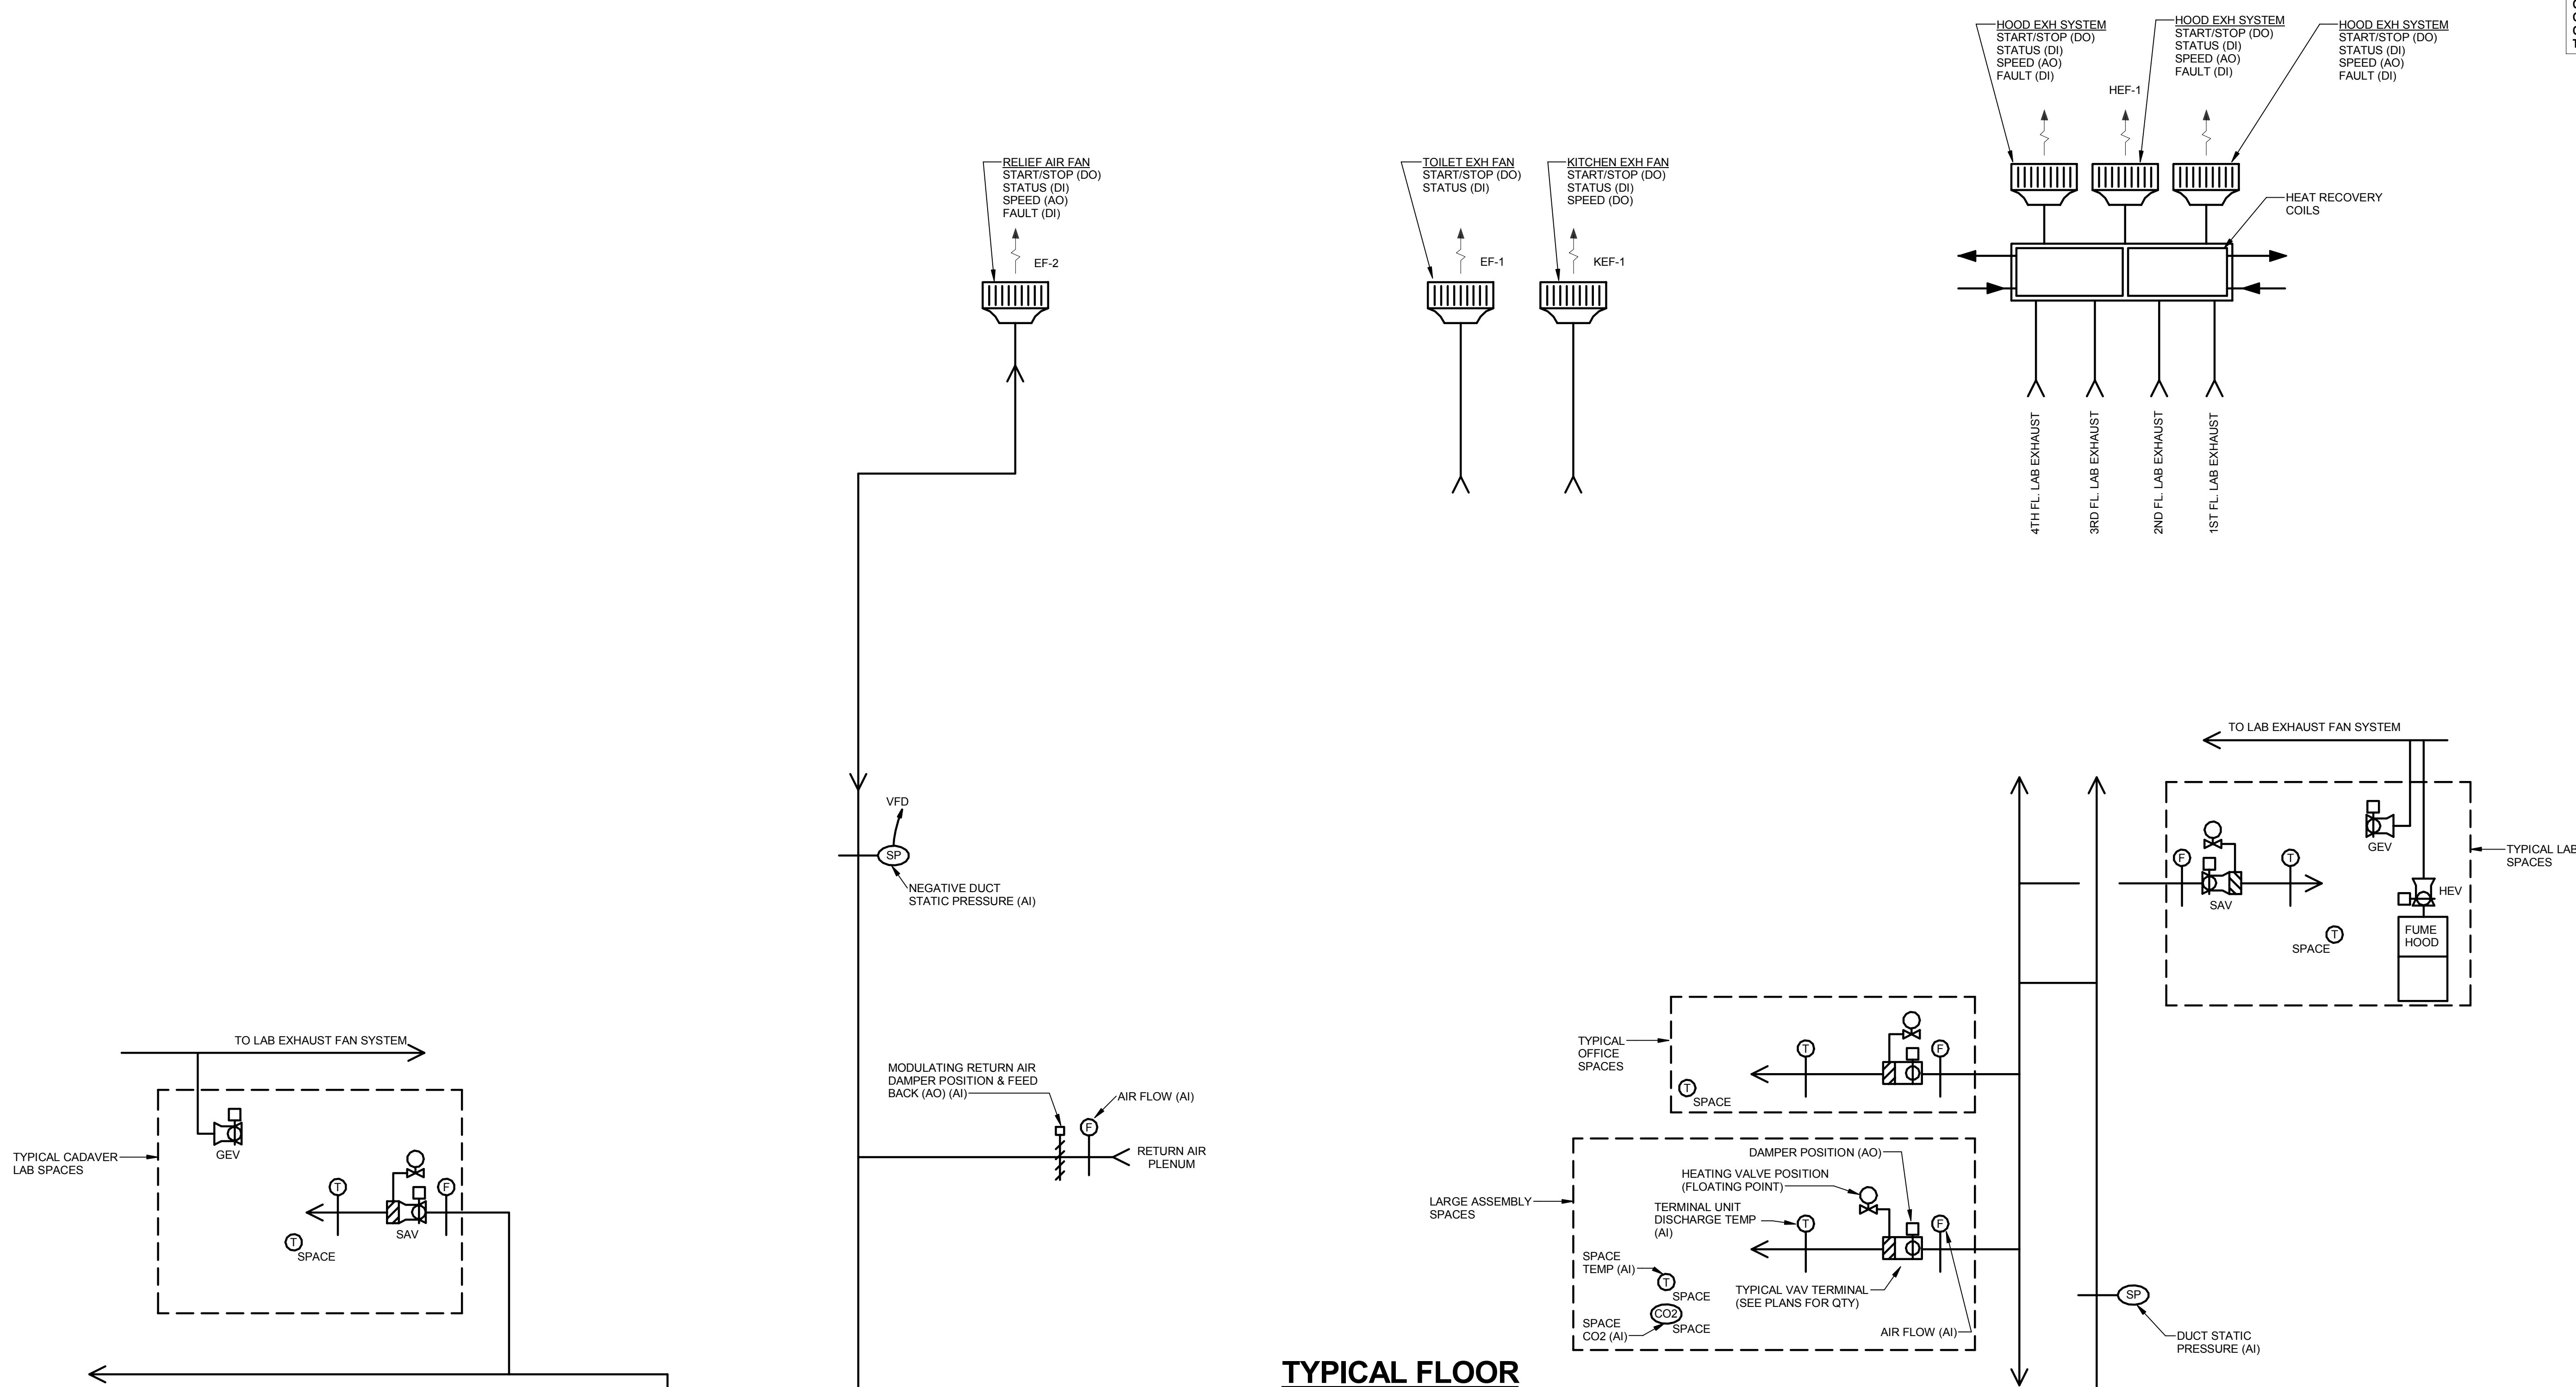

TYPICAL FLOOR

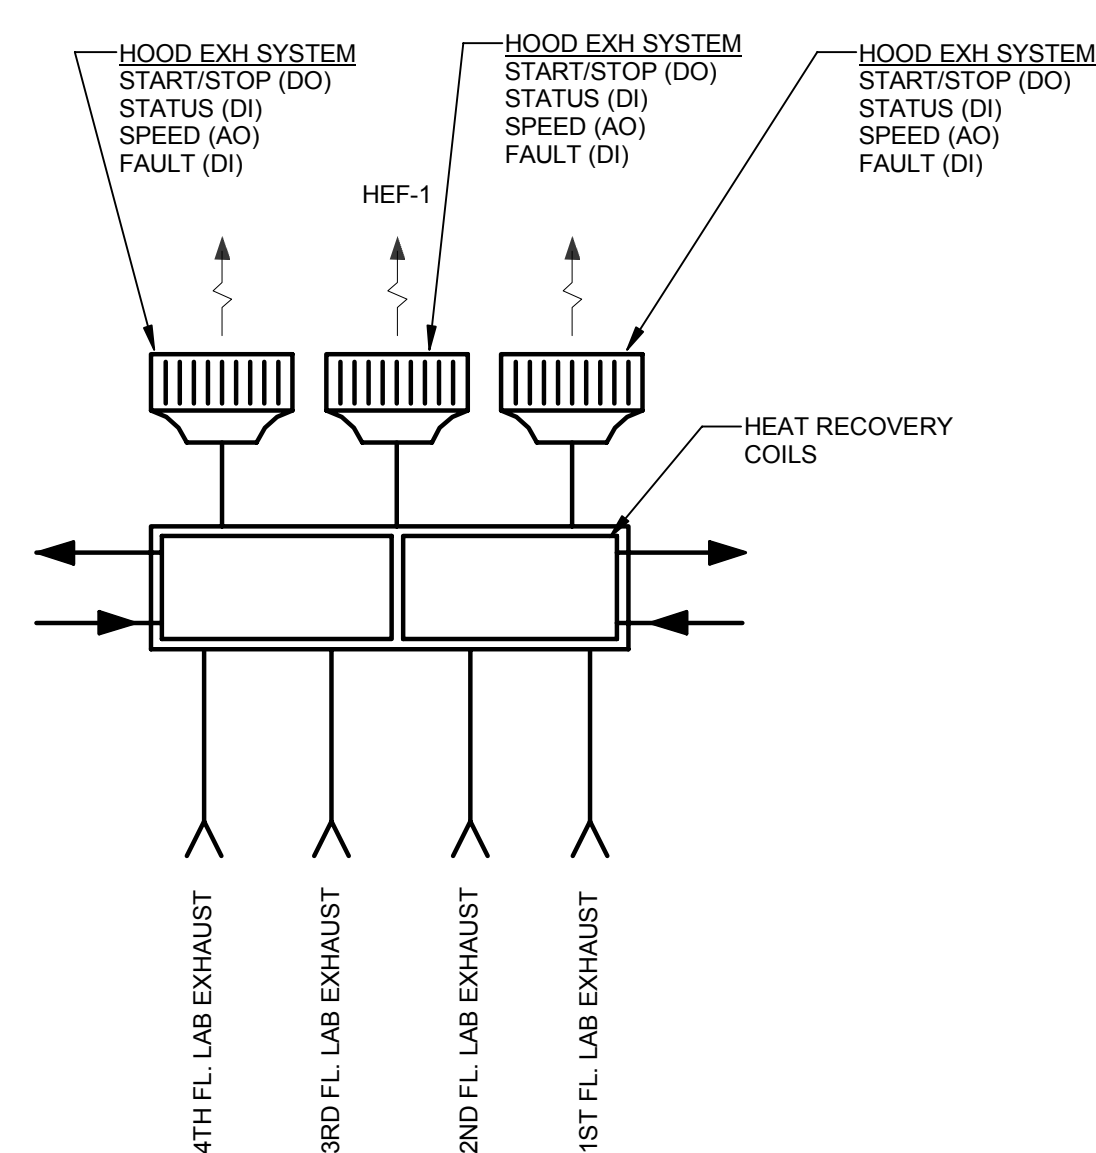

THE SEAL(S) AND SIGNATURE(S) APPLY ONLY TO THE DOCUMENT TO WHICH THEY ARE AFFIXED, AND EXPRESSLY DISCLAIM ANY RESPONSIBILITY FOR ALL OTHER PLANS, SPECIFICATIONS, ESTIMATES, REPORTS OR OTHER DOCUMENTS OR INSTRUMENTS RELATING TO OR INTENDED TO BE USED FOR ANY PART OR PARTS OF THE ARCHITECTURAL OR ENGINEERING PROJECT.

1	ADDENDUM 2-1	17 MAR 2016
-	ISSUED FOR CONSTRUCTION (BP2)	01 MAR 2016
No.	Description	Date

Drawing Title:

DIAGRAMS - MECHANICAL

Project No.: 04561.01 Checked by:

M0403