



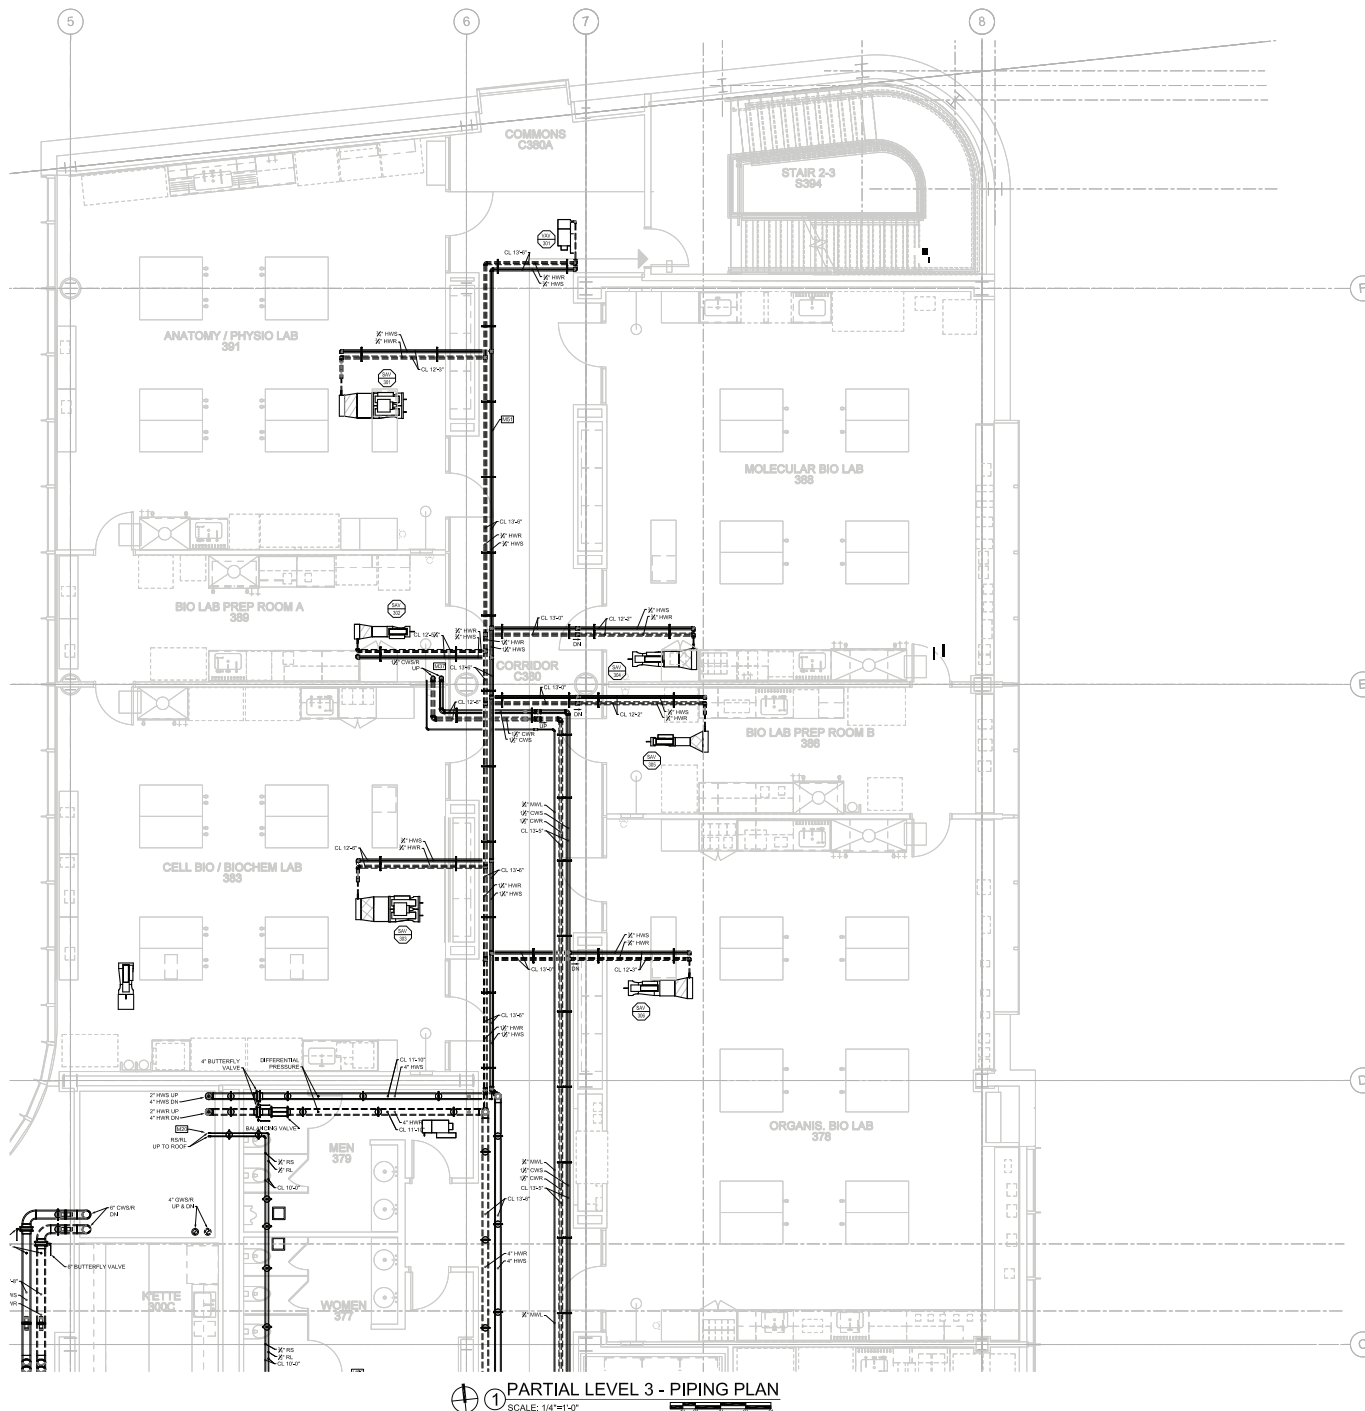

HANGER MAP KEYED NOTES:

RECORD DRAWINGS

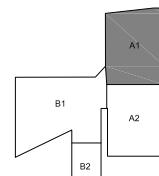

WEBSTER UNIVERSITY - ISB
WEBSTER GROVES, MISSOURI
ICON MECHANICAL CONTRACTORS AND ENGINEERS

NOT VALID FOR PERMITS
UNLESS SEALED BY
ENGINEER

Revision:	
Issue Date	12 / 1 / 16
Sheet Title	MP103A1
Project Number	5768
Sheet Number	1 of 1