


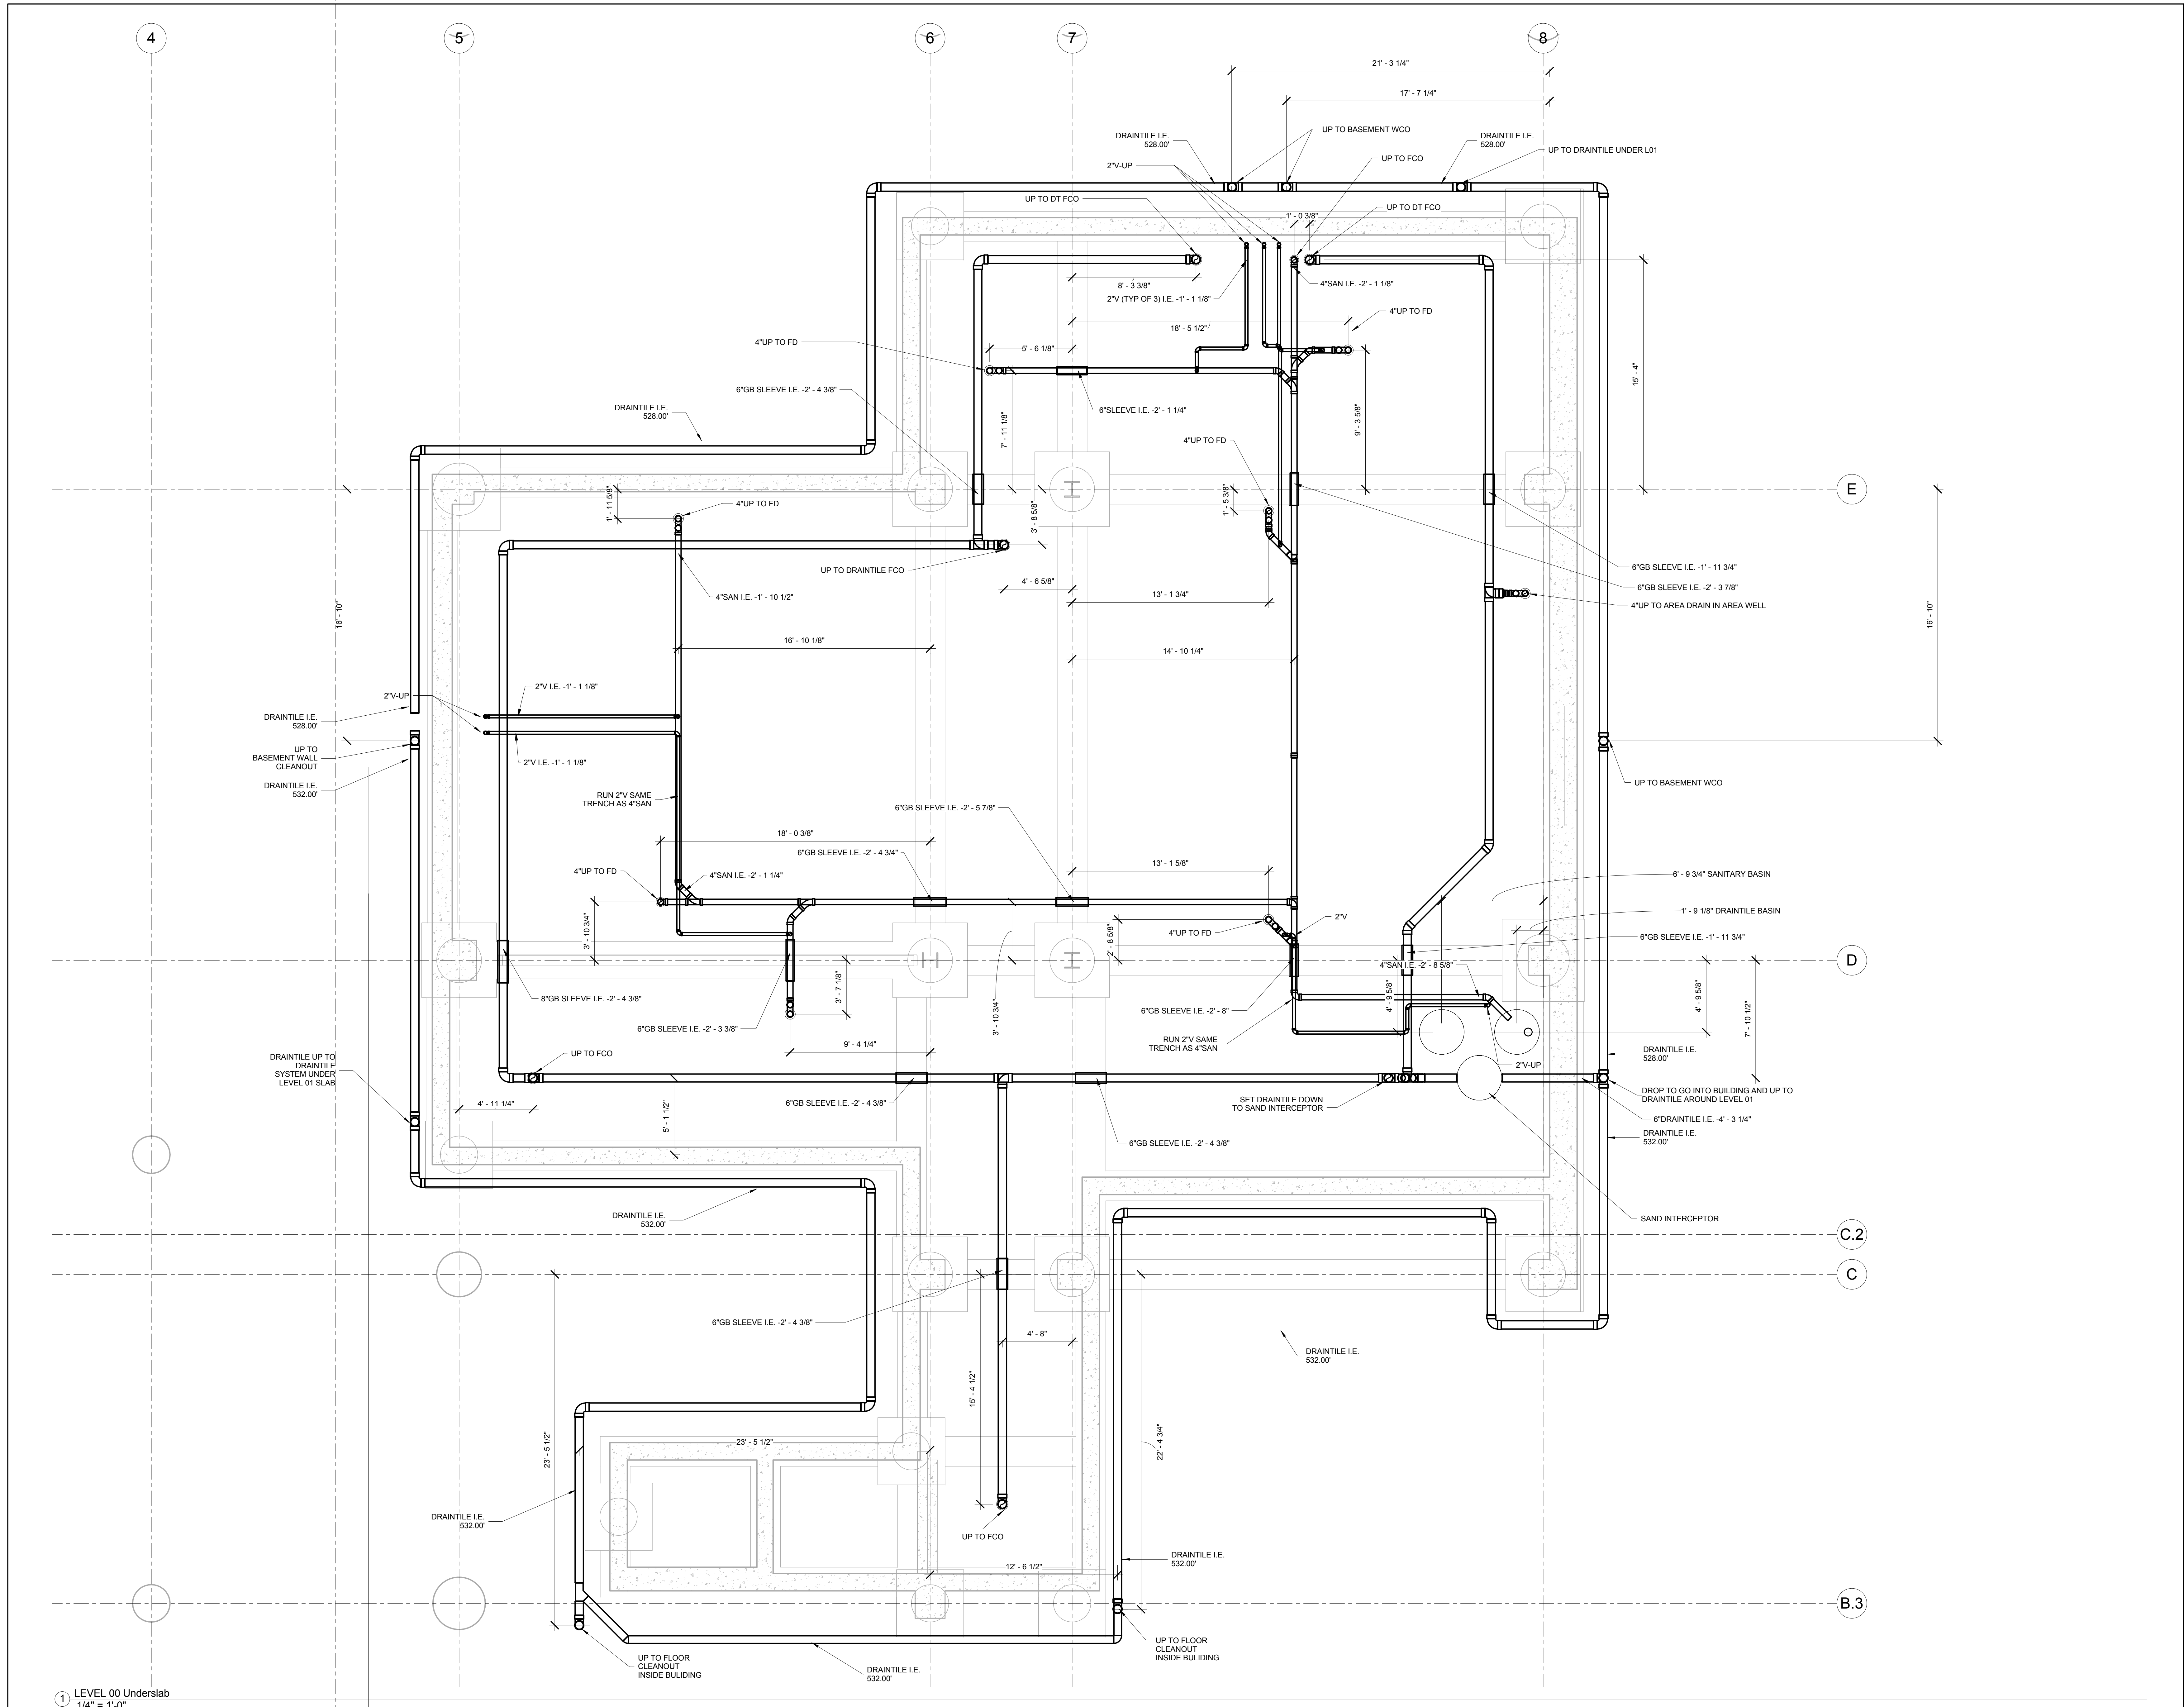

CANNONDESIGN

1100 Clark Avenue
St. Louis, Missouri 63102
T: 314.241.6250
F: 314.241.2570

CANNON DESIGN, Inc. - ARCHITECT
Missouri State Certificate of Authority #000051
Baltimore ■ Boston ■ Buffalo ■ Calgary ■ Chicago
Houston ■ Los Angeles ■ Mumbai ■ New York ■ Phoenix
St. Louis ■ San Francisco ■ Shanghai ■ Toronto
Vancouver ■ Victoria ■ Washington DC

CANNON DESIGN, Inc. - ENGINEER
Missouri State Certificate of Authority #000847

PARIC - Contractor
77 Westport Plaza, Suite 250
Saint Louis, MO
P: 636.561.9500

DE LUCA PLUMBING L.L.C.

A DESIGN / BUILD FAMILY TRADITION SINCE 1938
8465 DELPORT DRIVE ■ ST. LOUIS, MO 63114
314.427.5551 p ■ 314.427.1137 f
www.delucaplbg.com

Project: WEBSTER UNIVERSITY ISB

No.	Issue Description:	Date:
1	FIELD ISSUE	2016.06.15
2	AS-BUILT	2017.07.24

Drawn by: PCD

Checked by:

Facility Index No.:

Sheet Title: PLUMBING OVERALL - UNDERGROUND

Sheet Number: P01-00

© Cannon Design 2014