


No.	Issue Description:	Date:
1	FIELD ISSUE	2016.11.10
2	FIELD ISSUE	2016.12.12
3	AS-BUILT	2017.07.24

Drawn by: PCD


Facility Index No.:

Sheet Title:
LEVEL 01 - AREA A - DWV

Sheet Number:

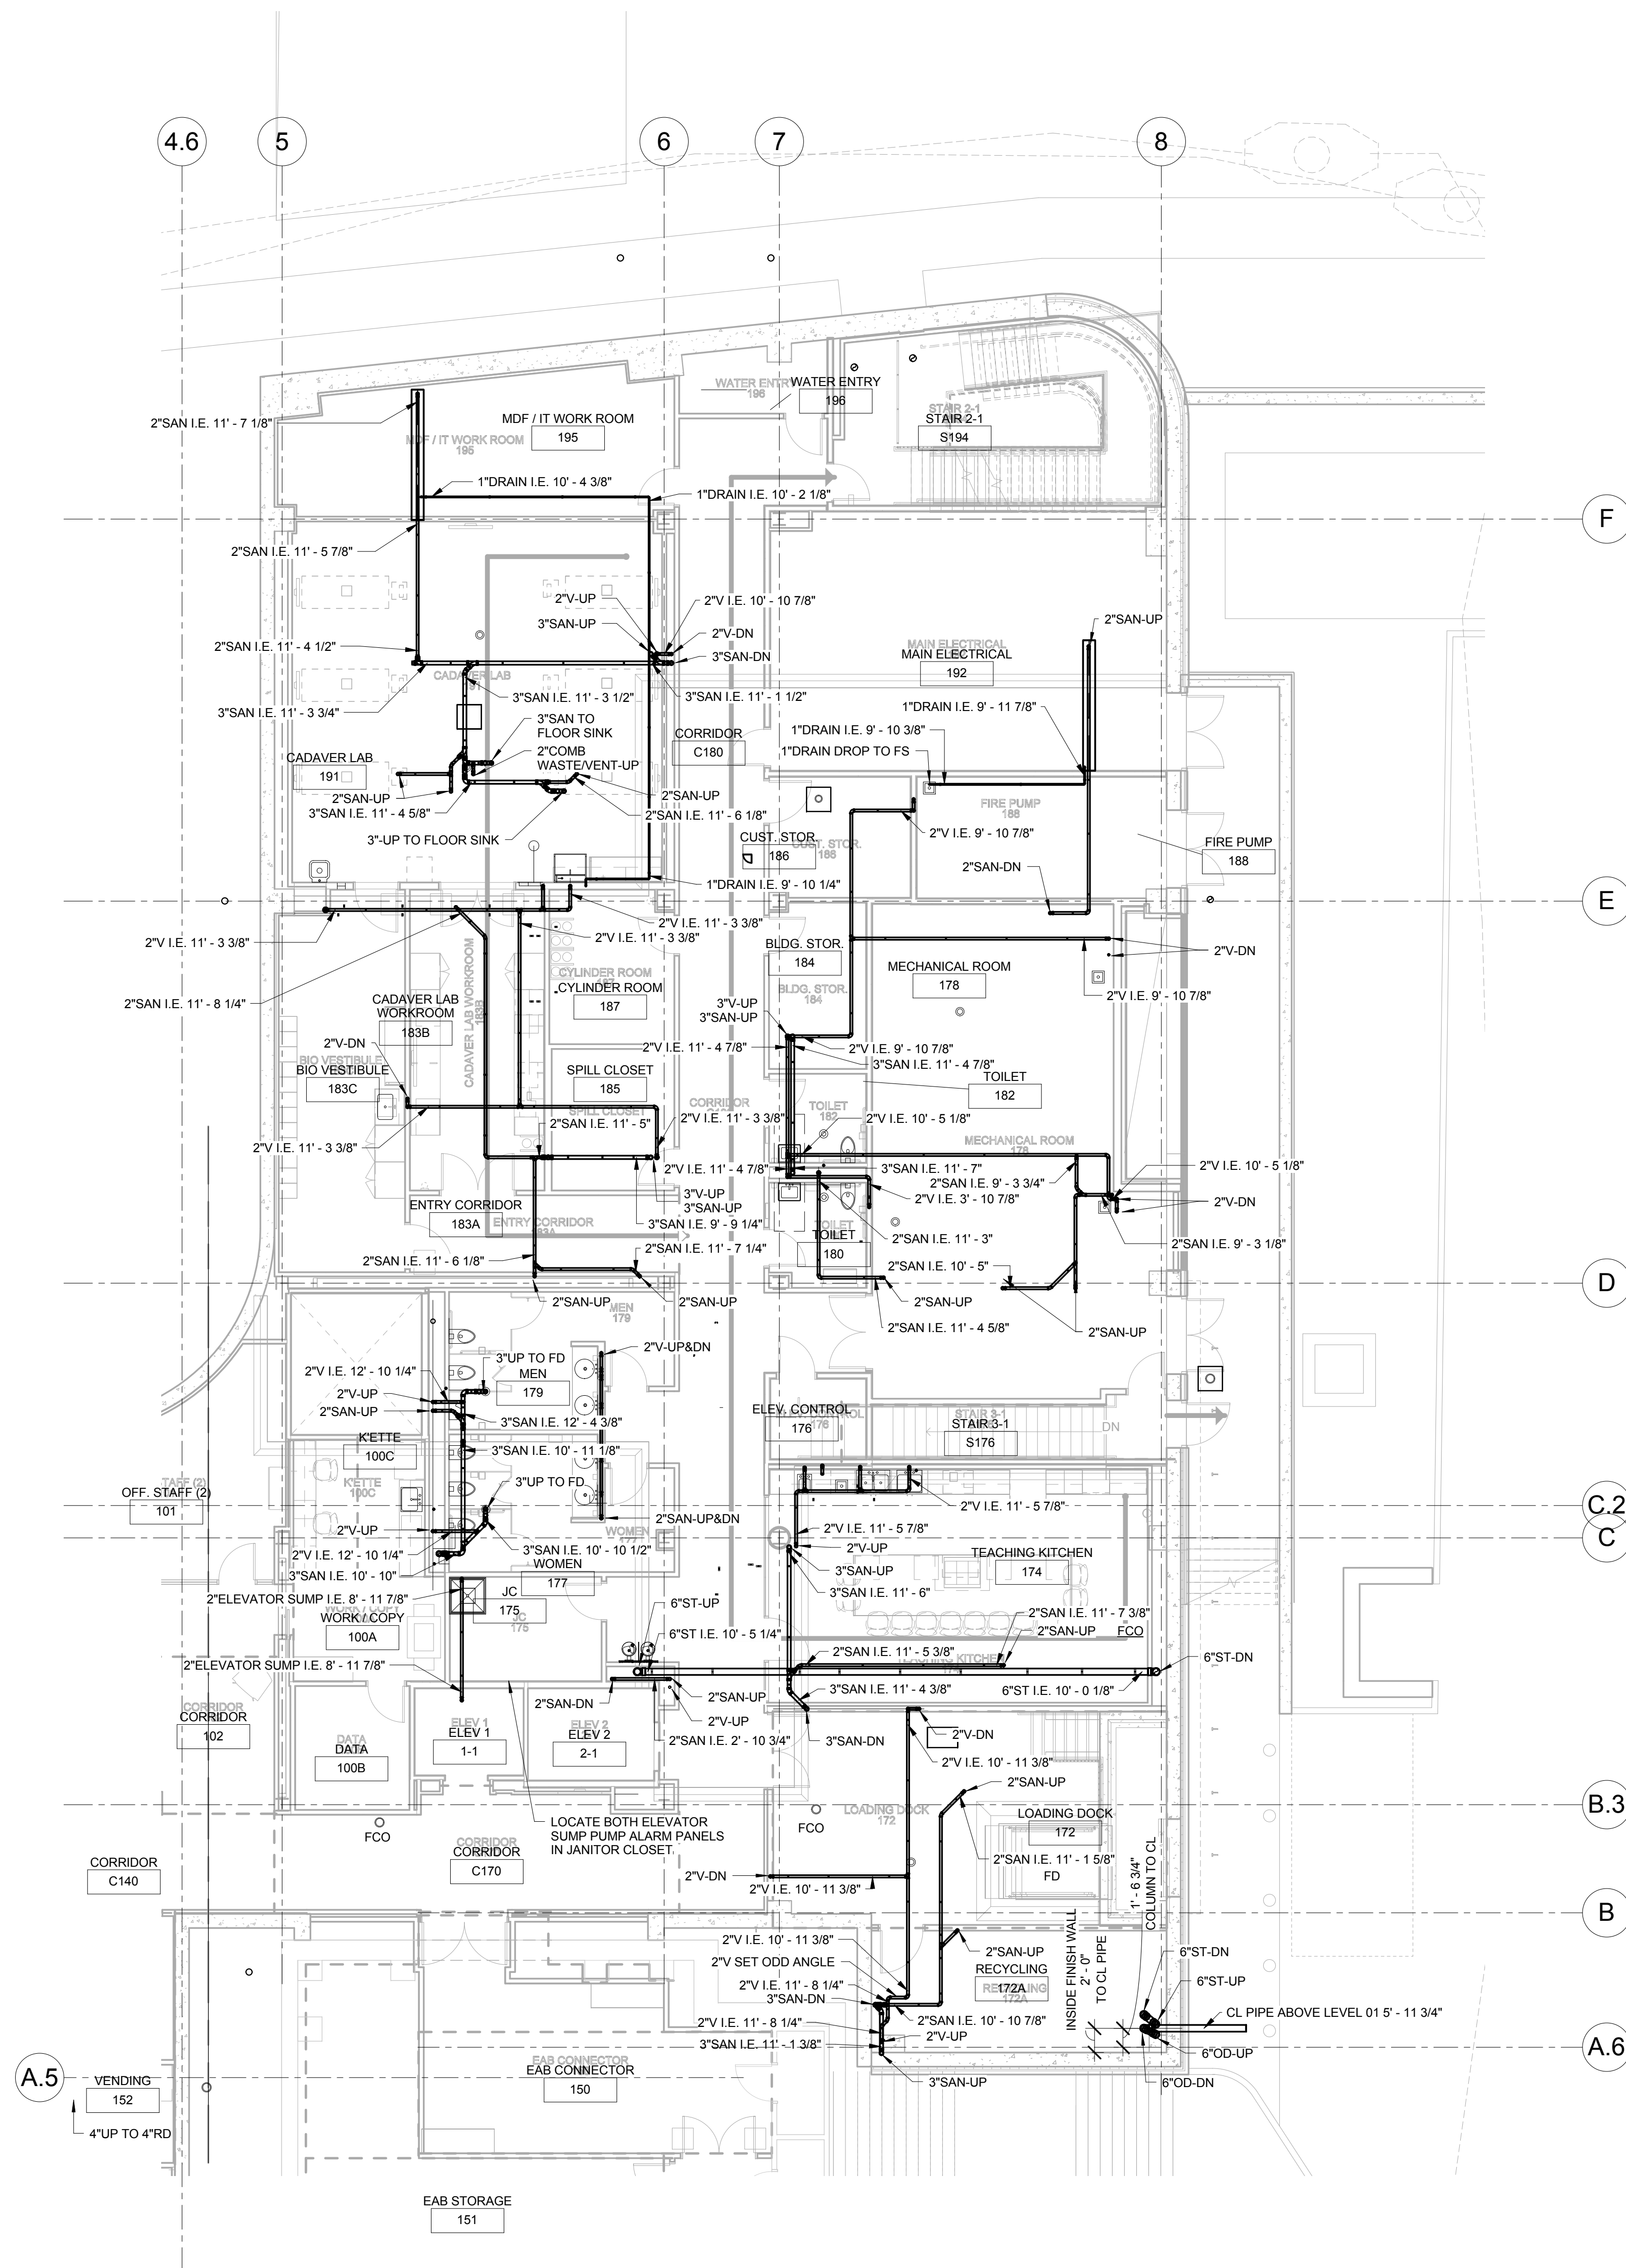

① LEVEL 01 Field - DWV - AREA A
1/8" = 1'-0"

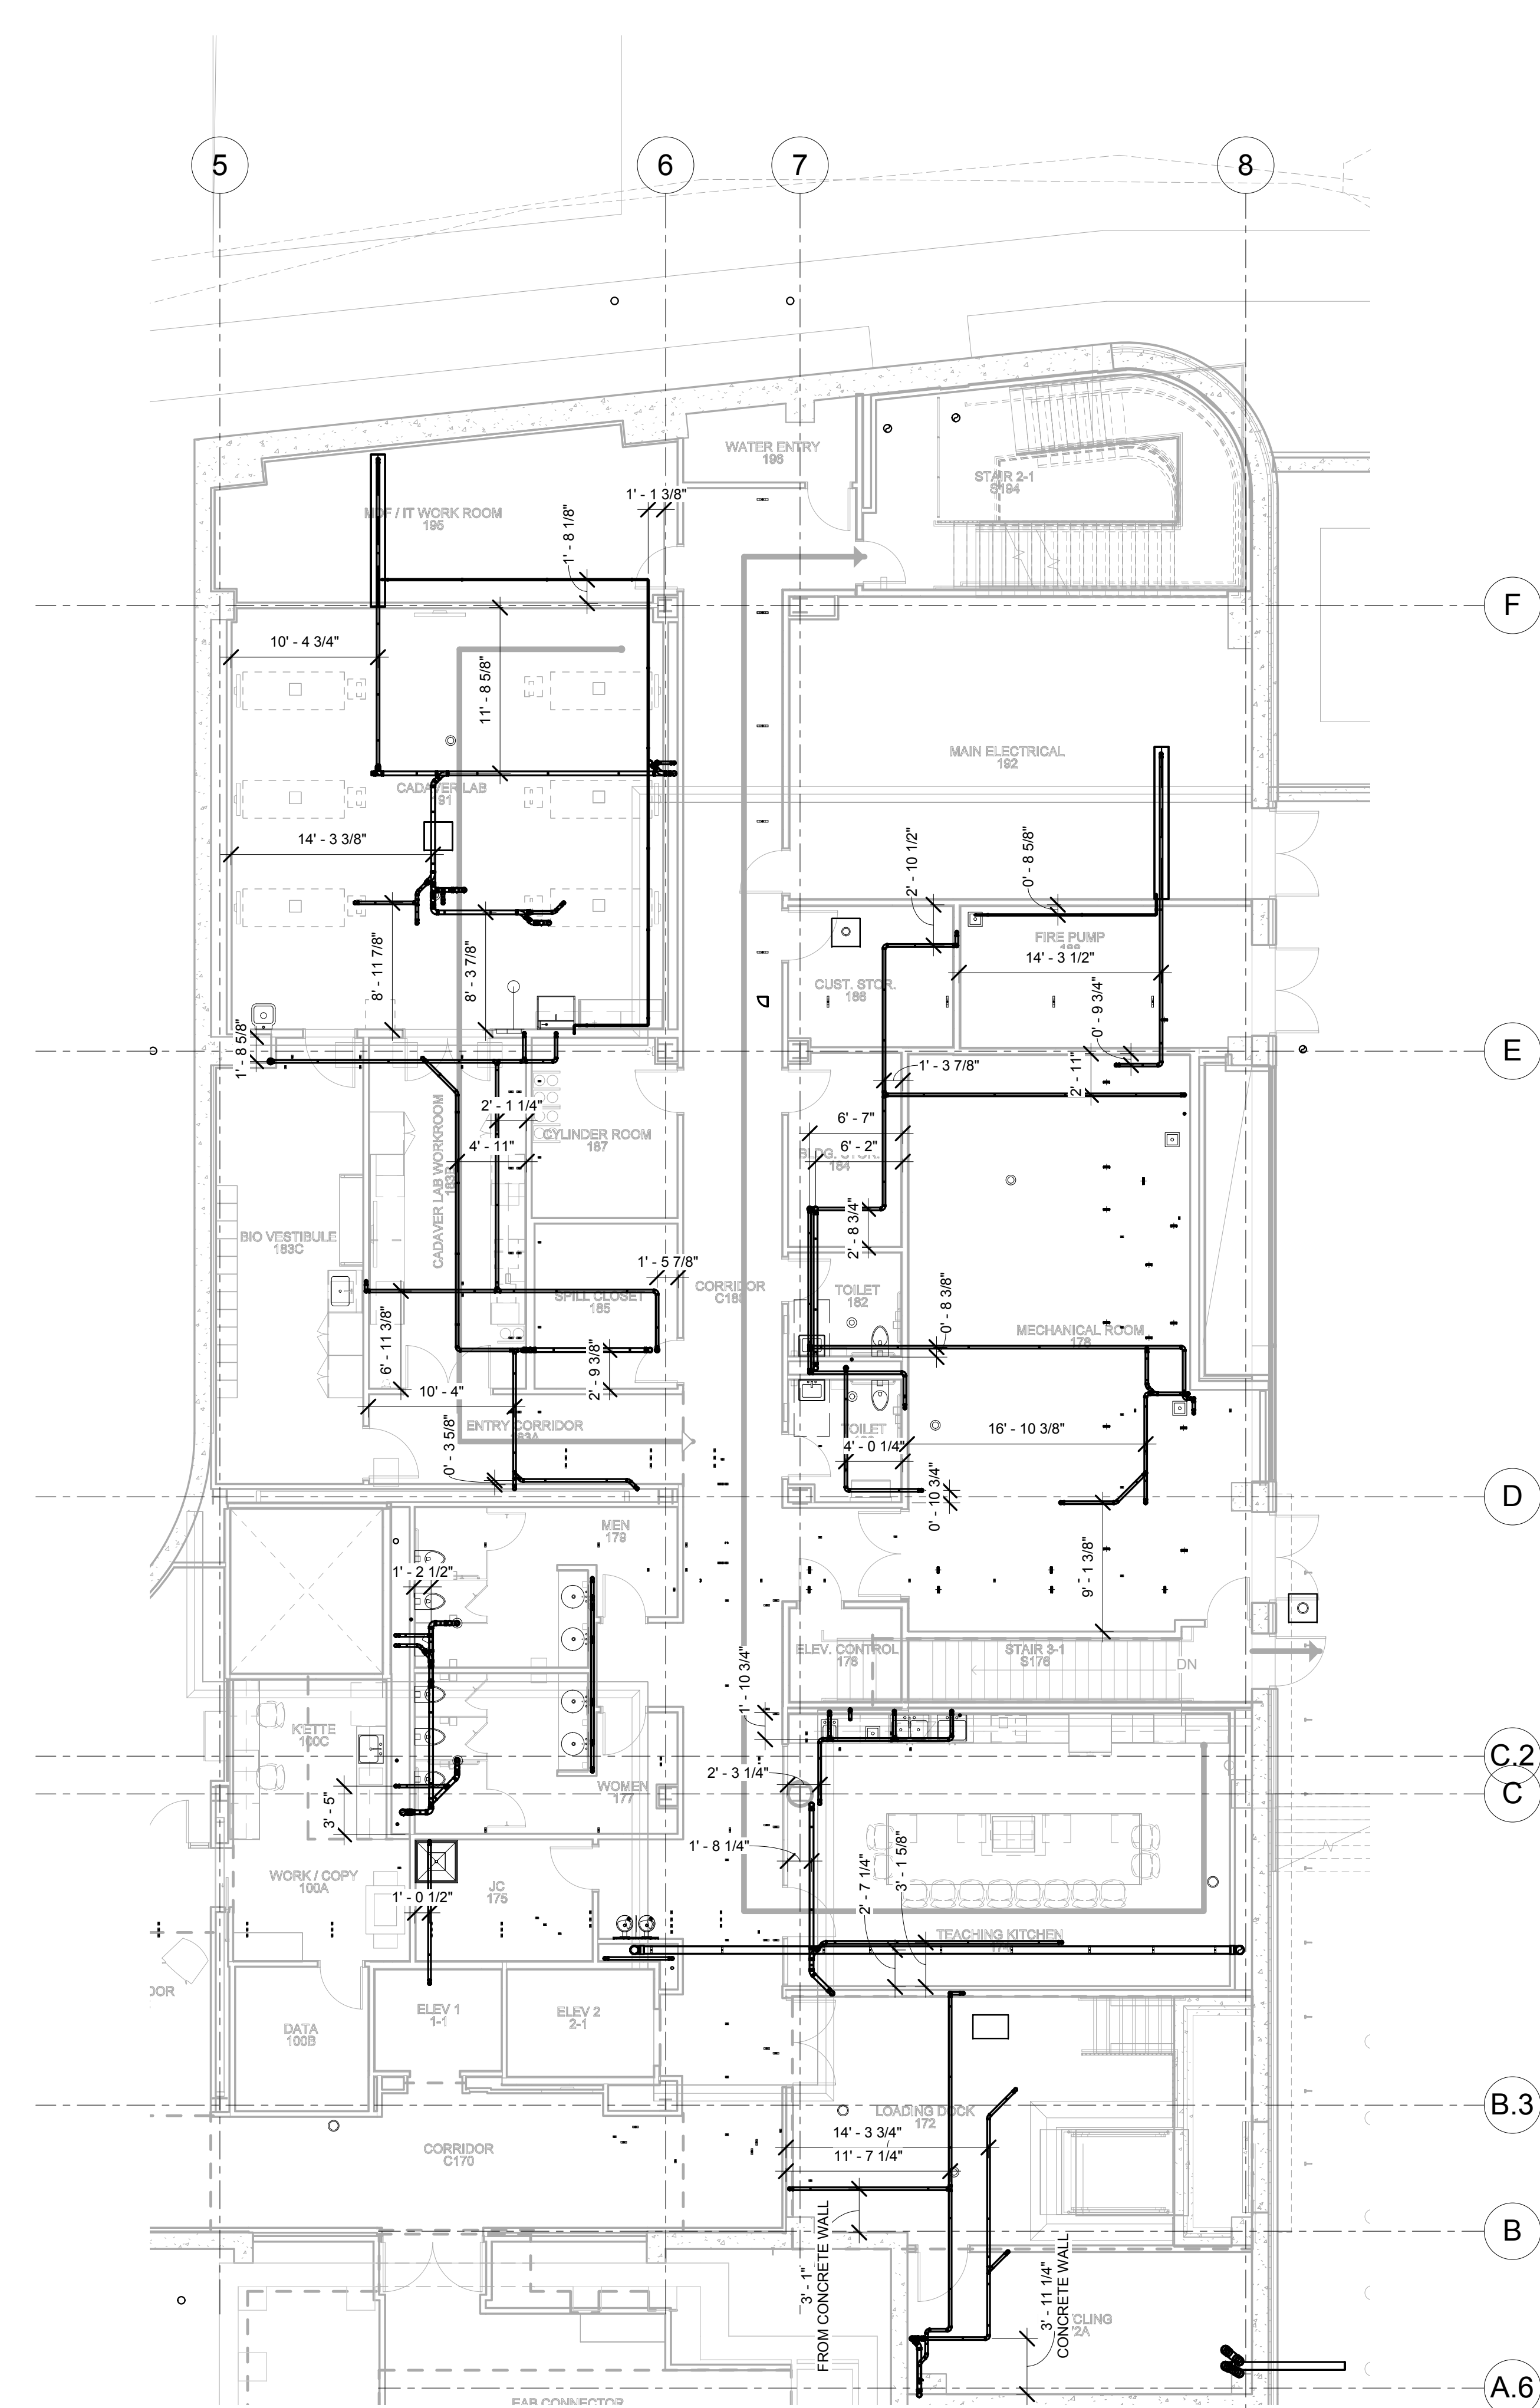

2 LEVEL 01 Field-dwv Dimensions
1/8" = 1'-0"