

No.	Issue Description:	Date:
1	FIELD ISSUE	2016.12.13
2	FIELD ISSUE-GLAZING ADJUST	2017.01.19
3	AS-BUILT	2017.07.24

Drawn by: PCD


Facility Index No.:

Sheet Title:
**LEVEL 02 - AREA A -
DOMESTIC WATER**


Sheet Number: _____

P01-02ADOM

© Canyon Design 2014

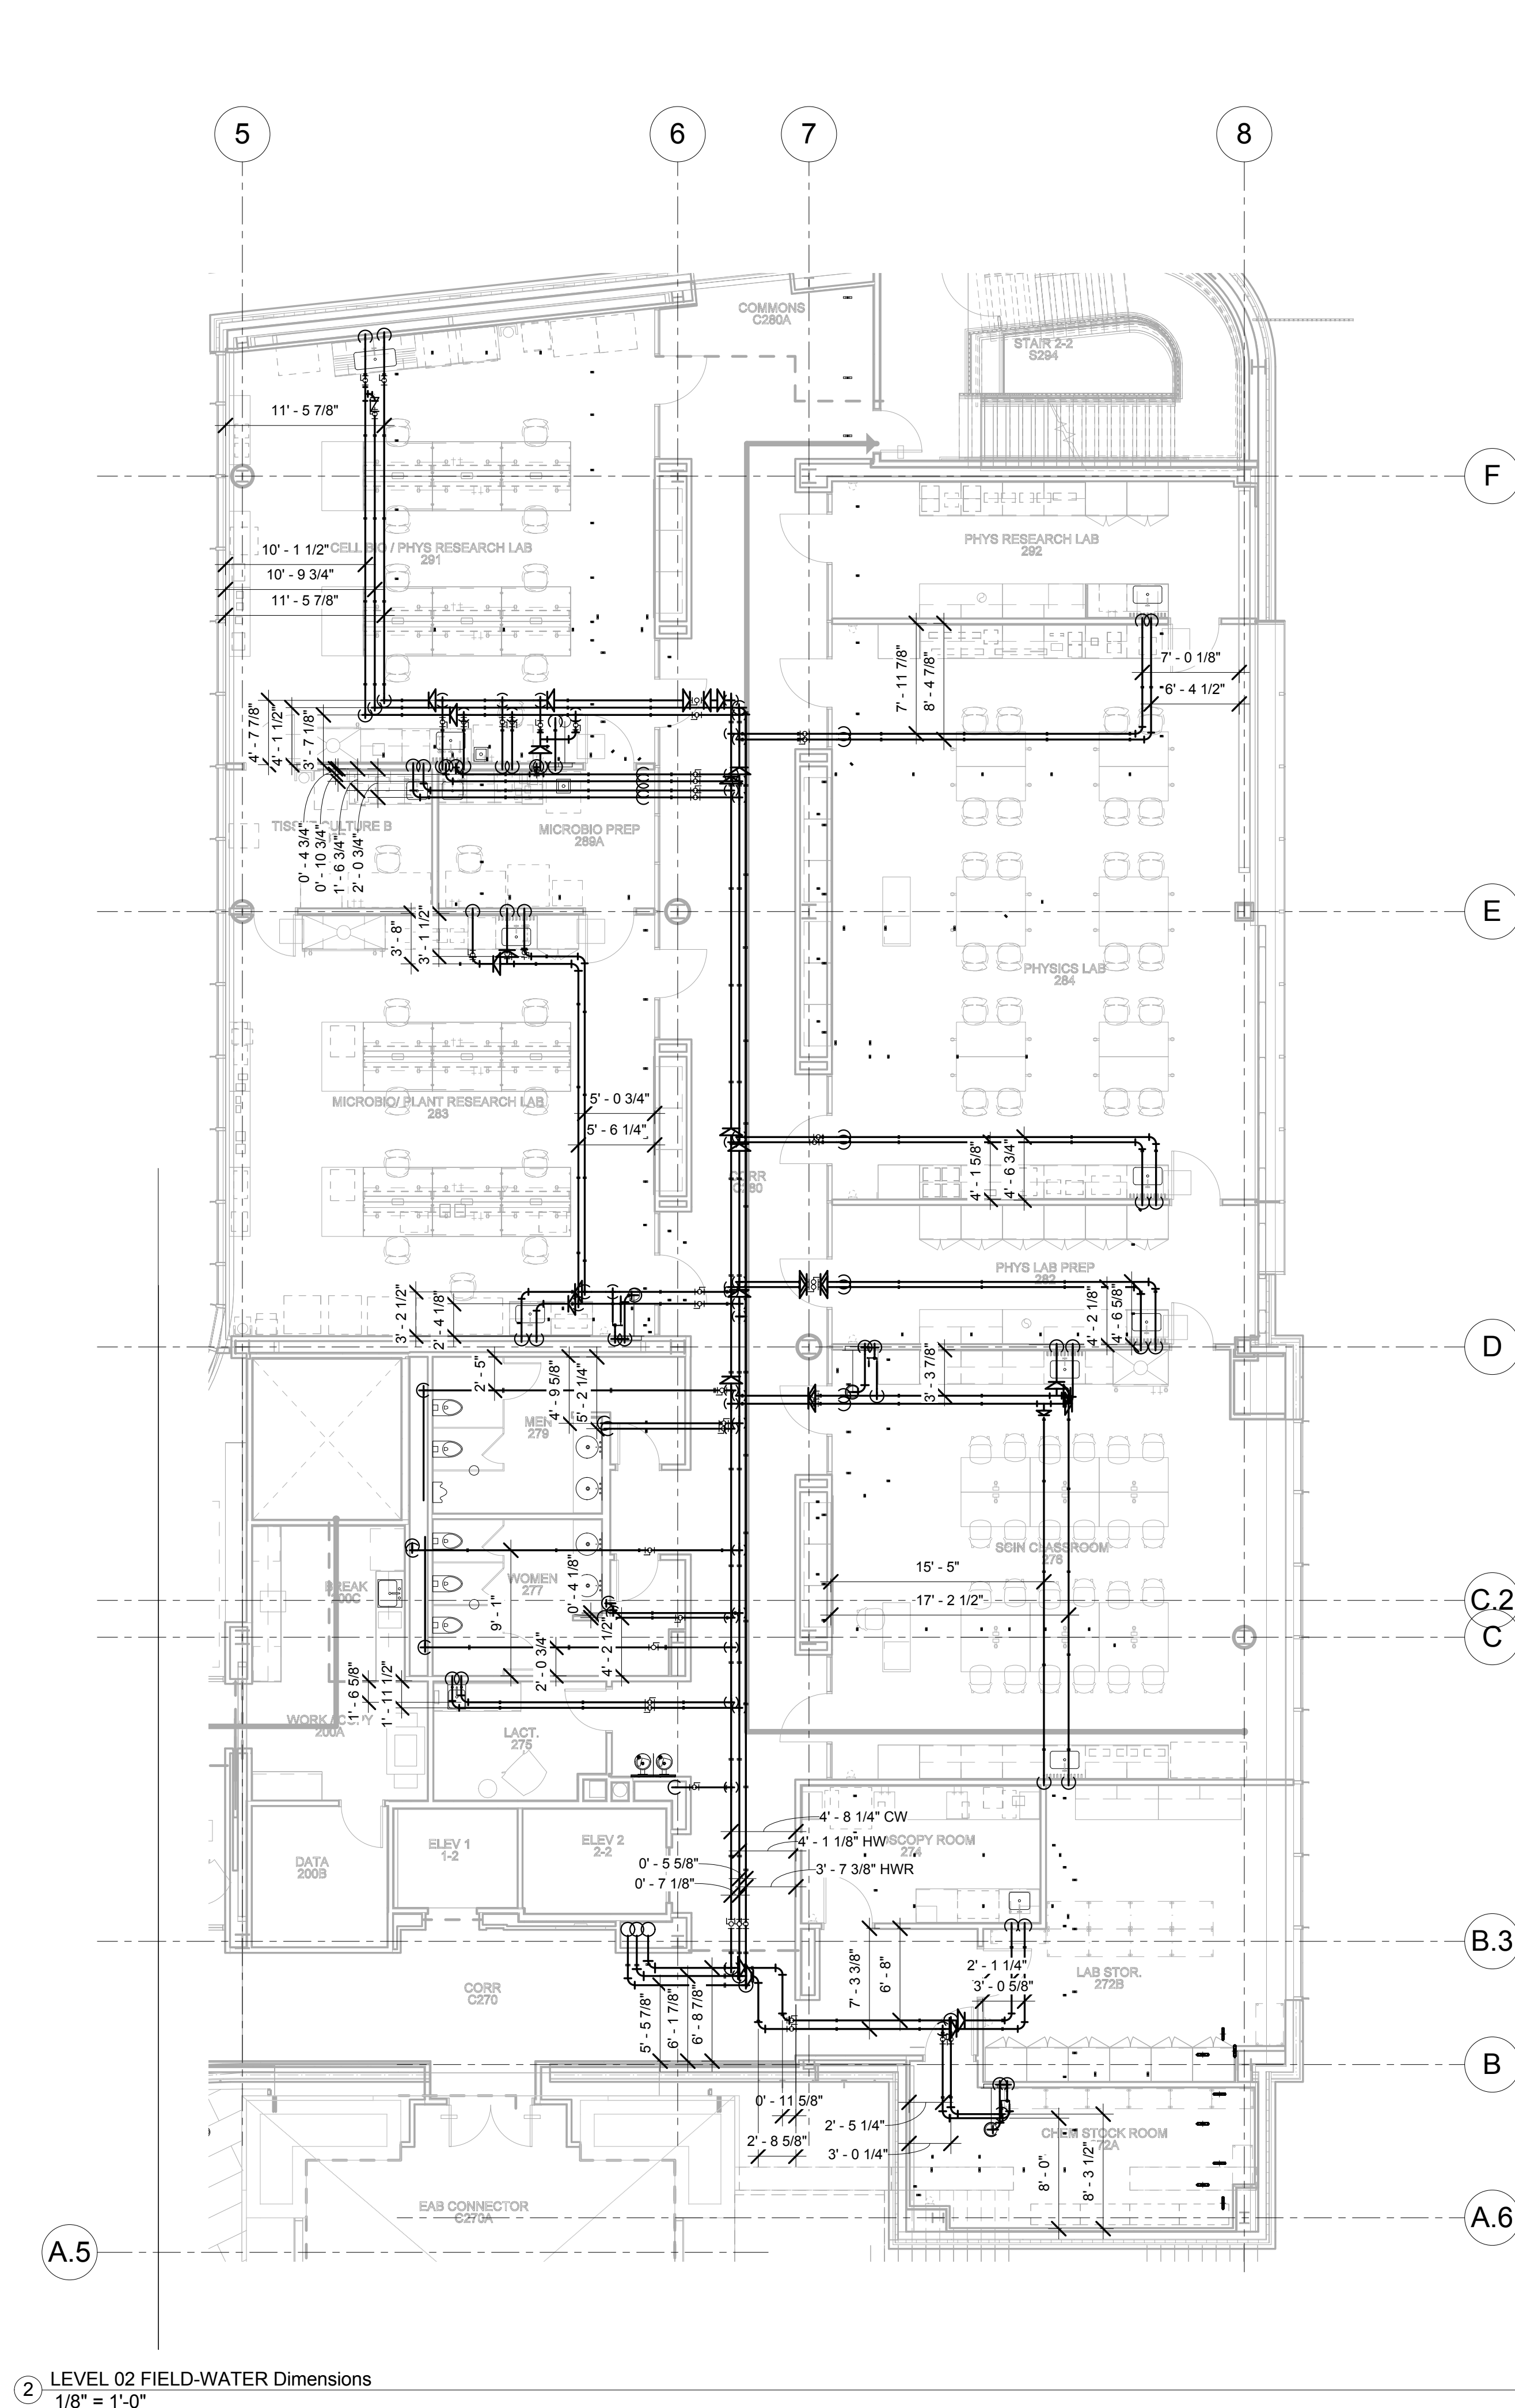

② LEVEL 02 FIELD-WATER Dimensions
1/8" = 1'-0"

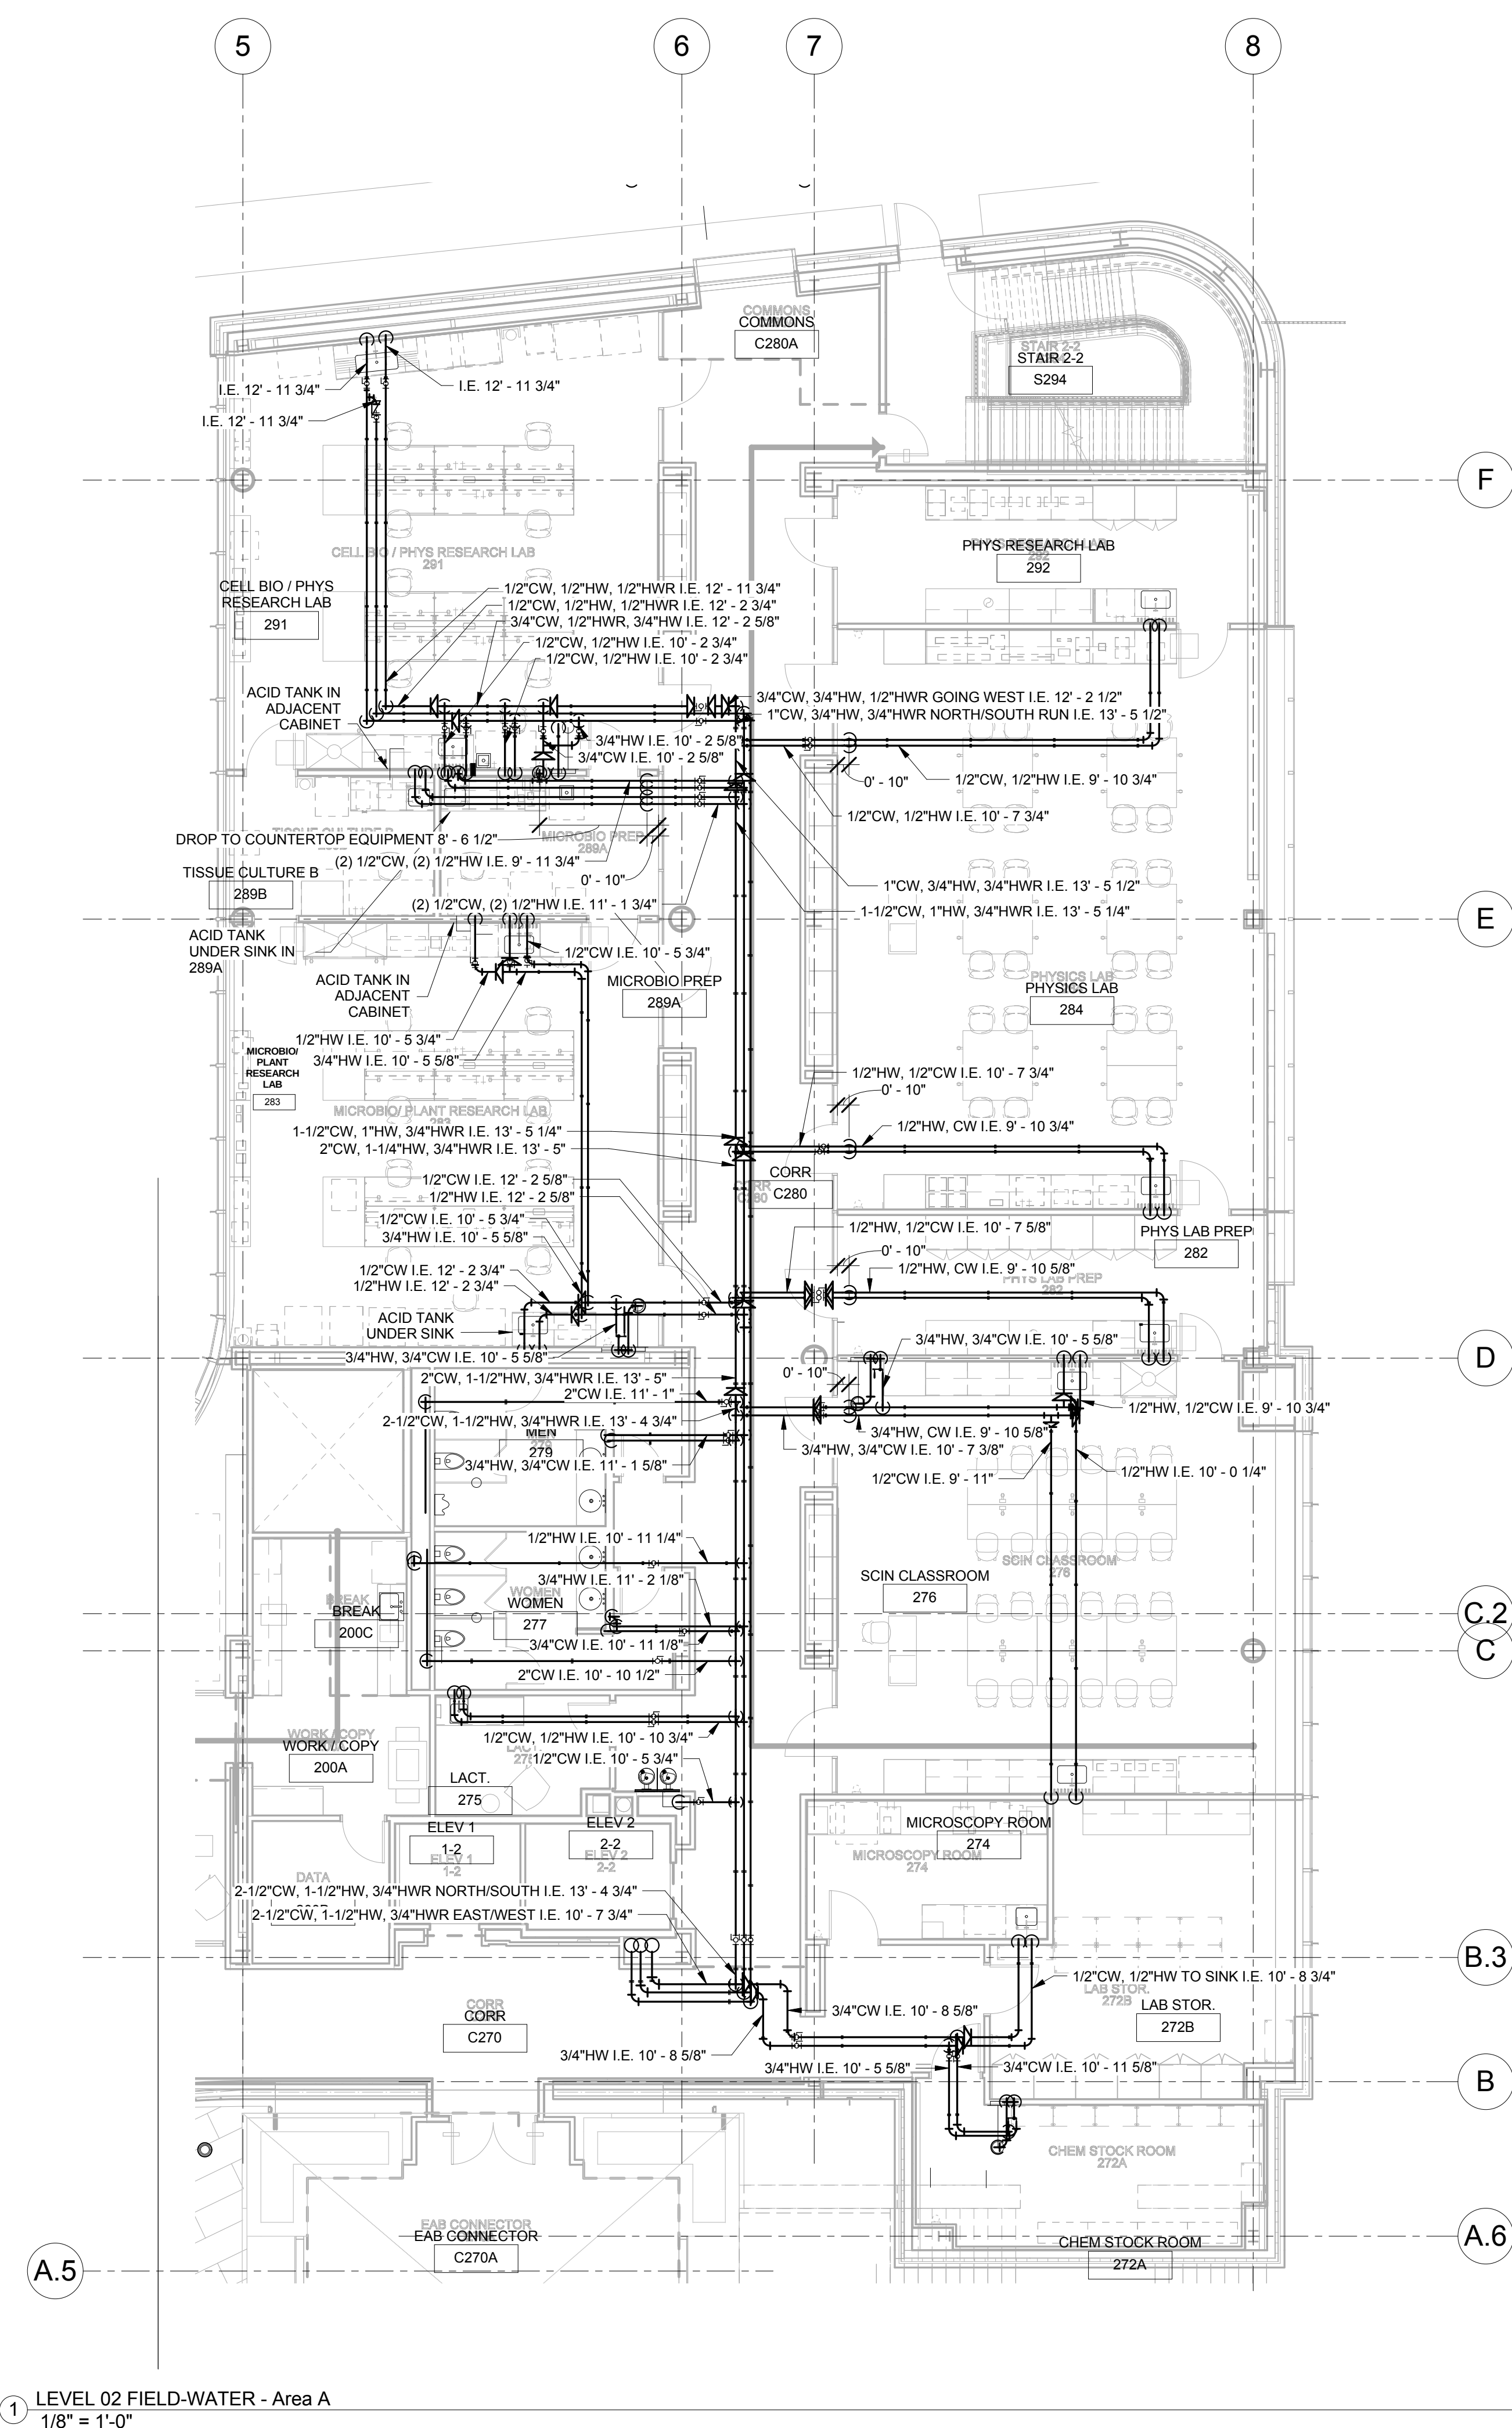

① LEVEL 02 FIELD-WATER - Area A
1/8" = 1'-0"