

| No. | Issue Description: | Date:      |
|-----|--------------------|------------|
| 1   | FIELD ISSUE        | 2016.11.22 |
| 2   | FIELD ISSUE        | 2016.12.13 |
| 3   | AS-BUILT           | 2017.07.24 |


Drawn by:PCD Checked by:

Facility Index No.:


Sheet Title:  
LEVEL 03 - AREA A - DWV

Sheet Number:

P01-03ADWV

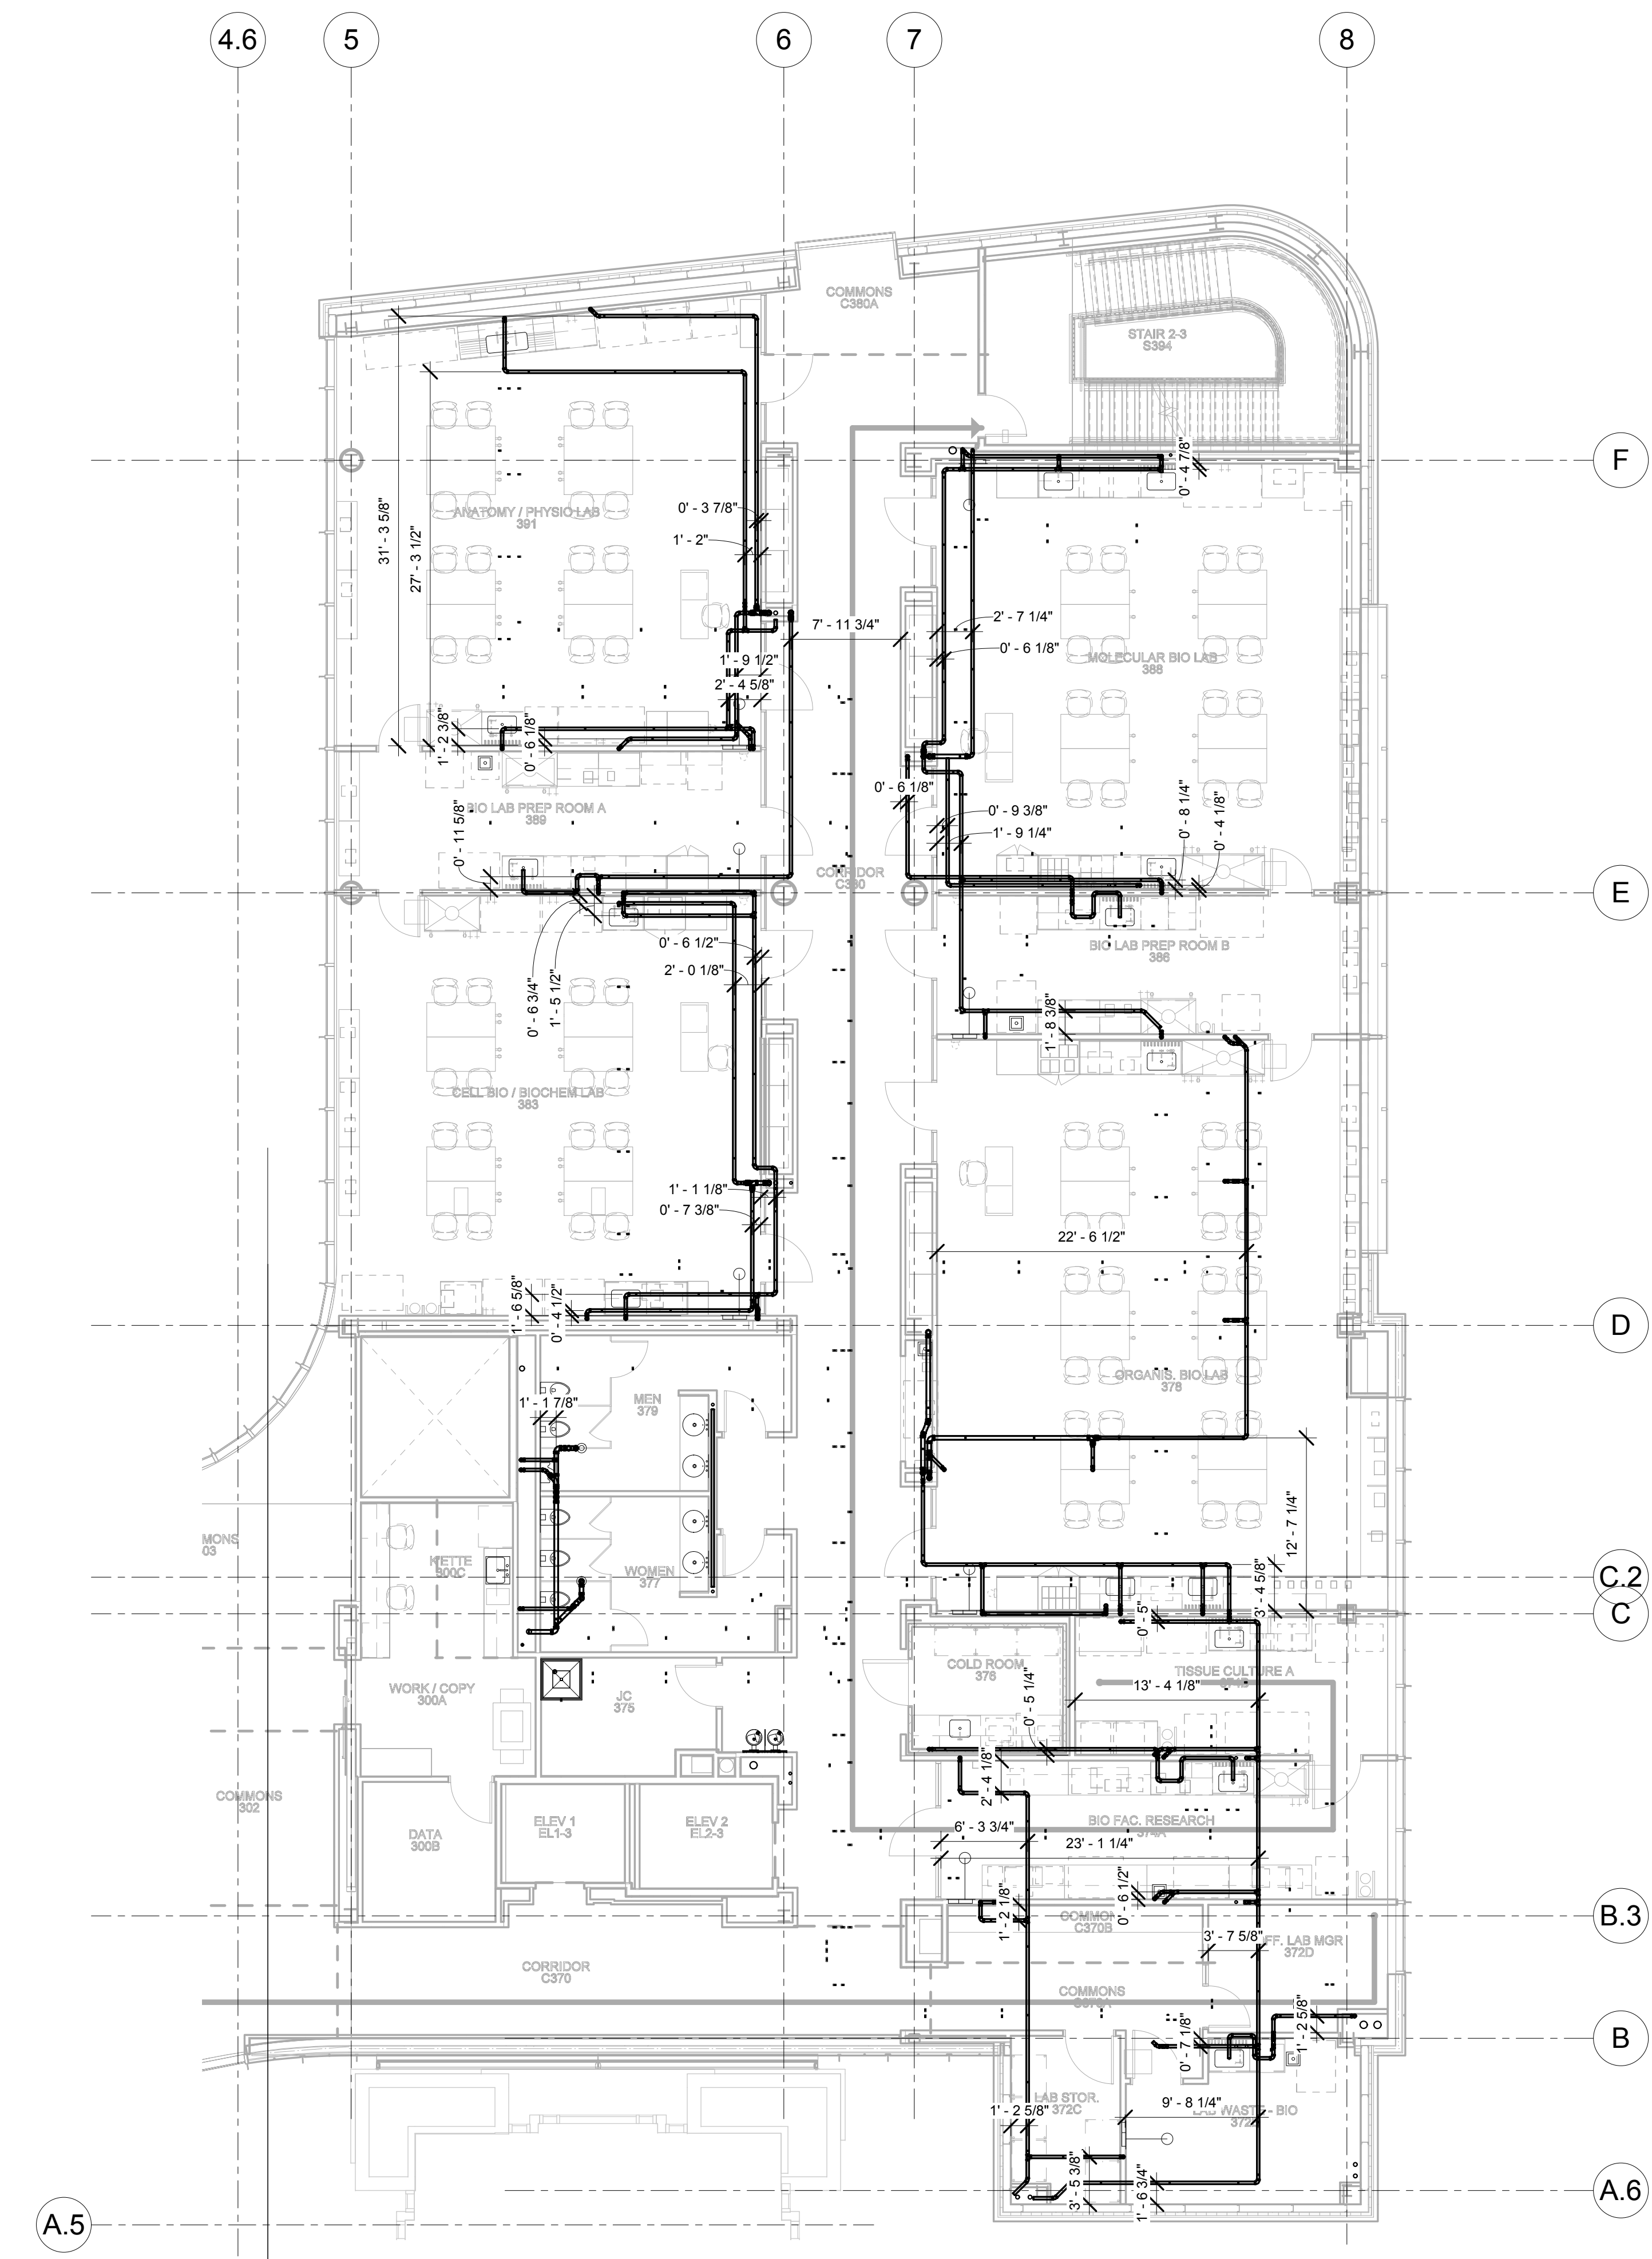

2 LEVEL 03 Field-DWV Dimensions  
1/8" = 1'-0"

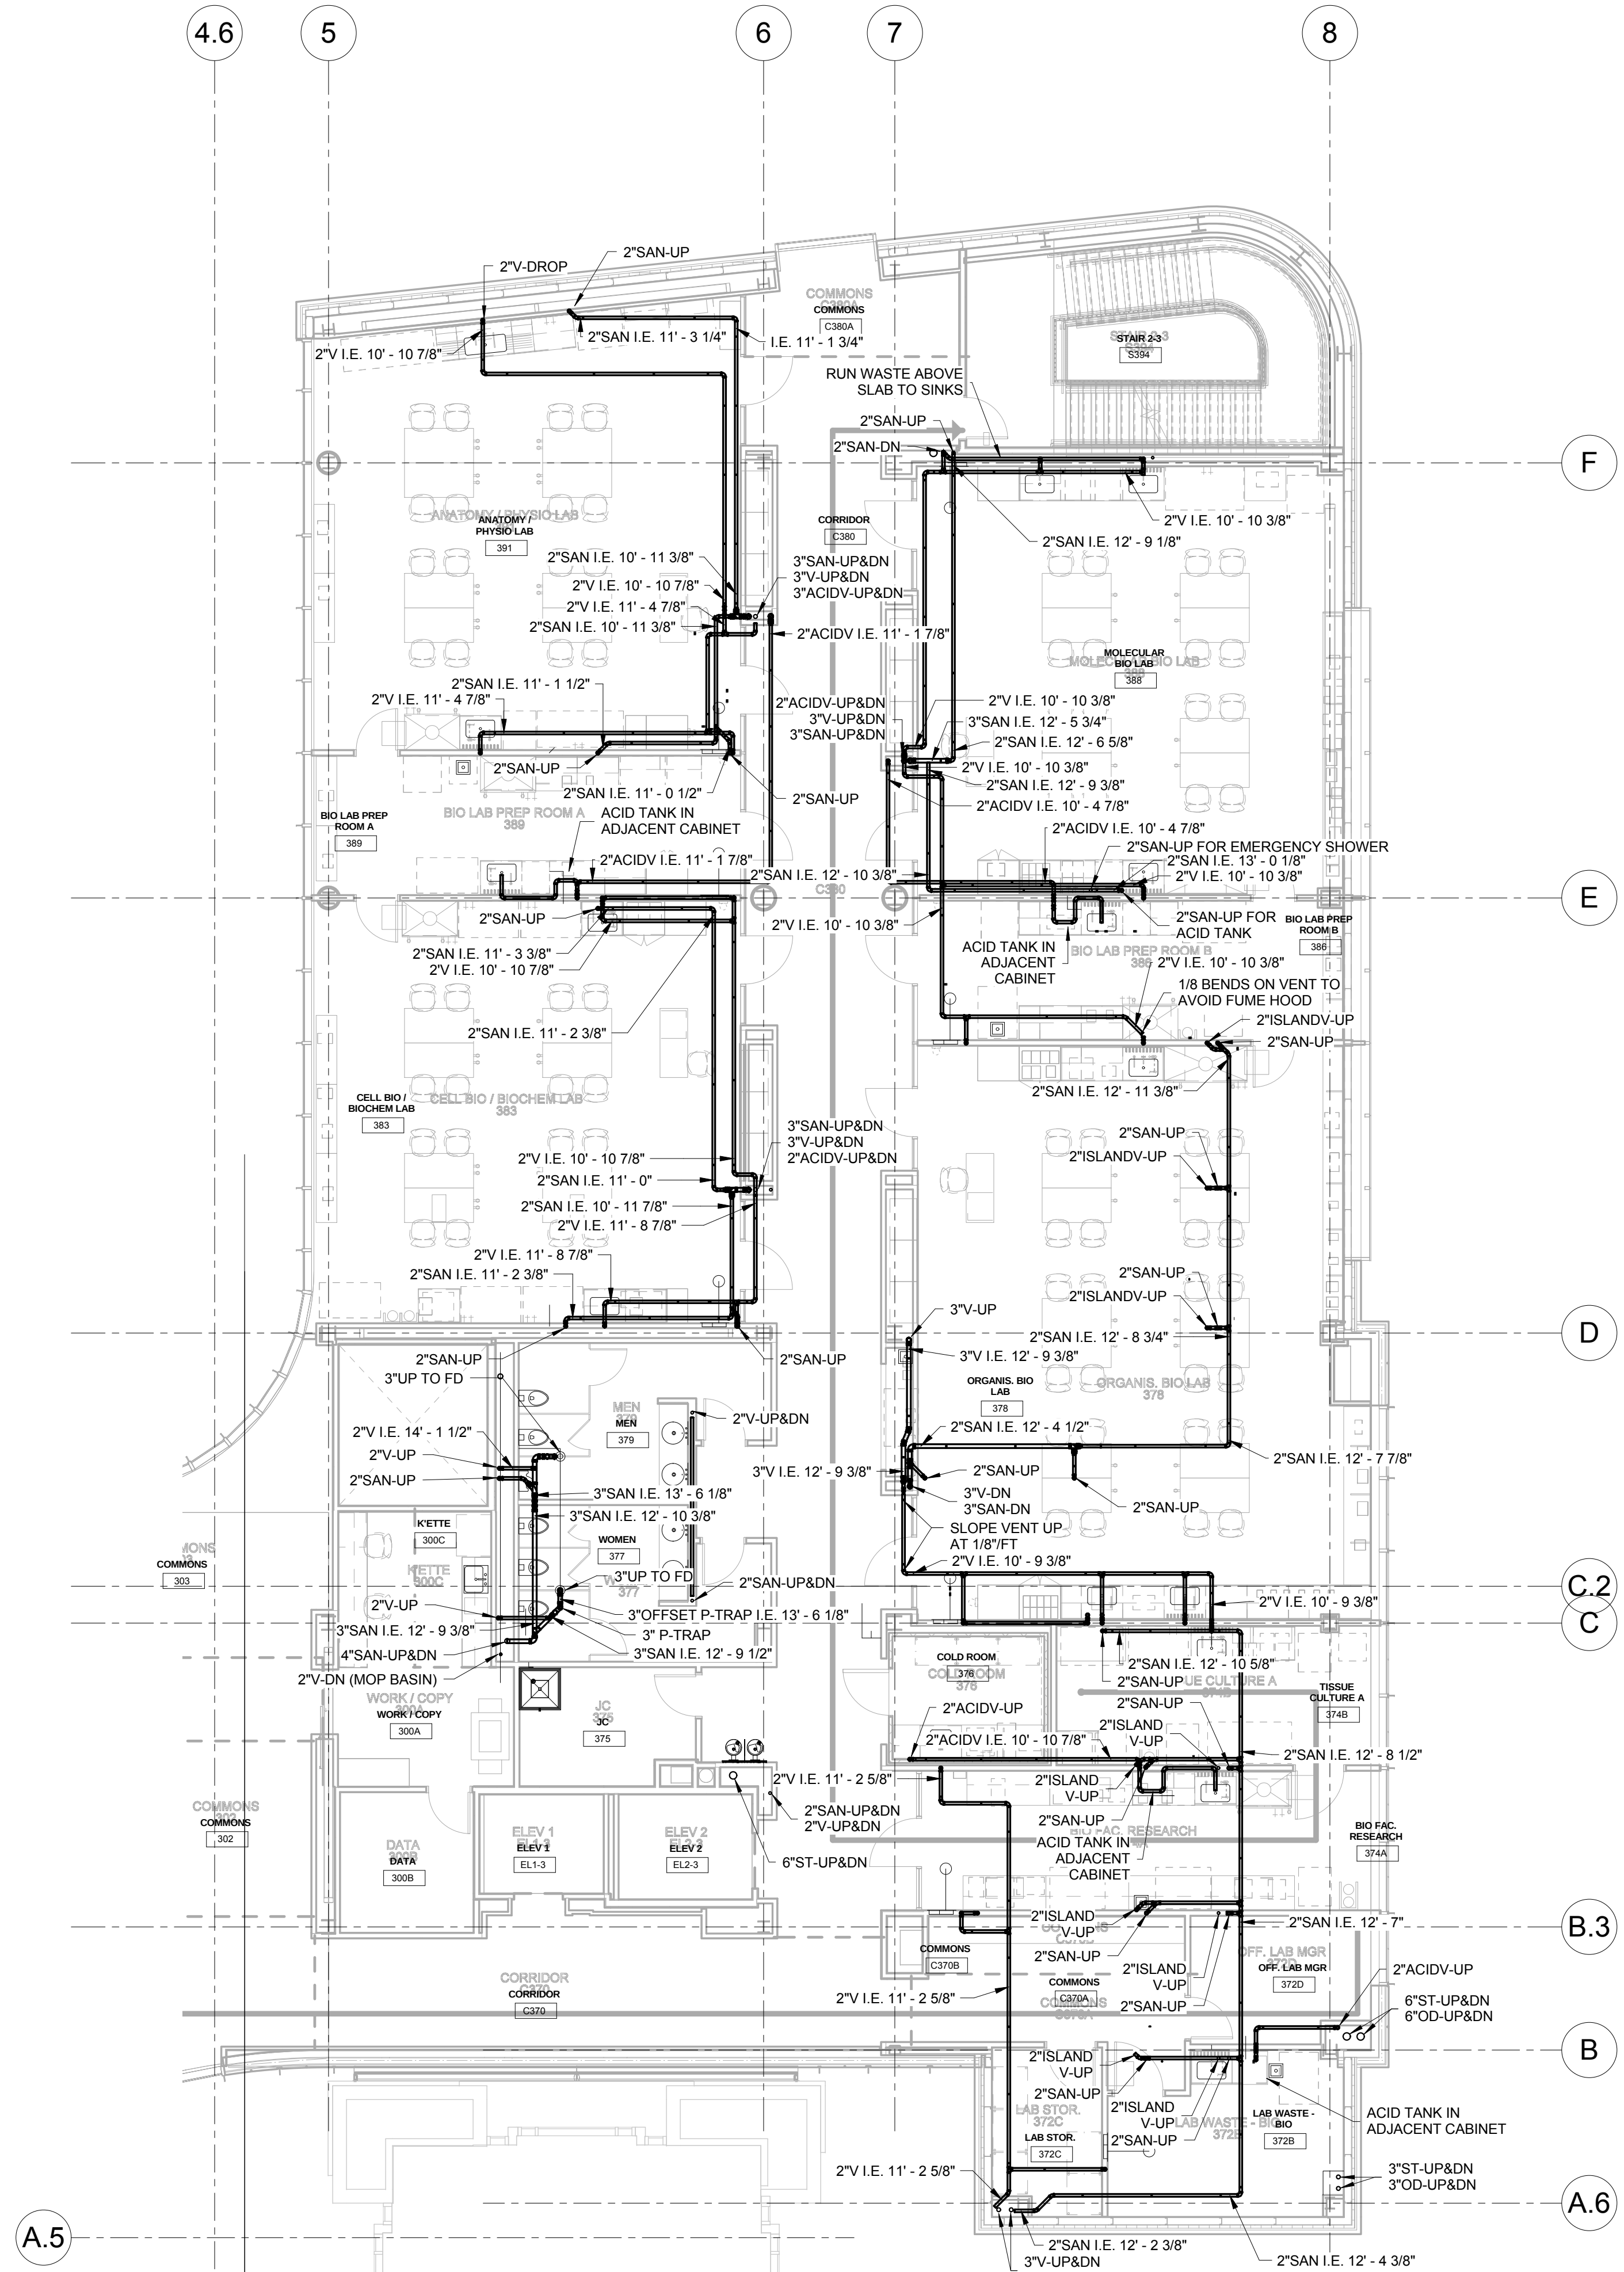

1 LEVEL 03 Field-DWV - Area A  
1/8" = 1'-0"