

| No. | Issue Description:           | Date:      |
|-----|------------------------------|------------|
| 1   | FIELD ISSUE                  | 2016.09.29 |
| 2   | FIELD ISSUE-REVISED STORM    | 2016.11.10 |
| 3   | FIELD ISSUE-REVISED STORM #2 | 2016.12.08 |
| 4   | AS-BUILT                     | 2017.07.24 |


Drawn by:PCD Checked by:

Facility Index No.:

Sheet Title:  
LEVEL 03 & 04 - AREA B -  
DWV

Sheet Number:

P01-03B

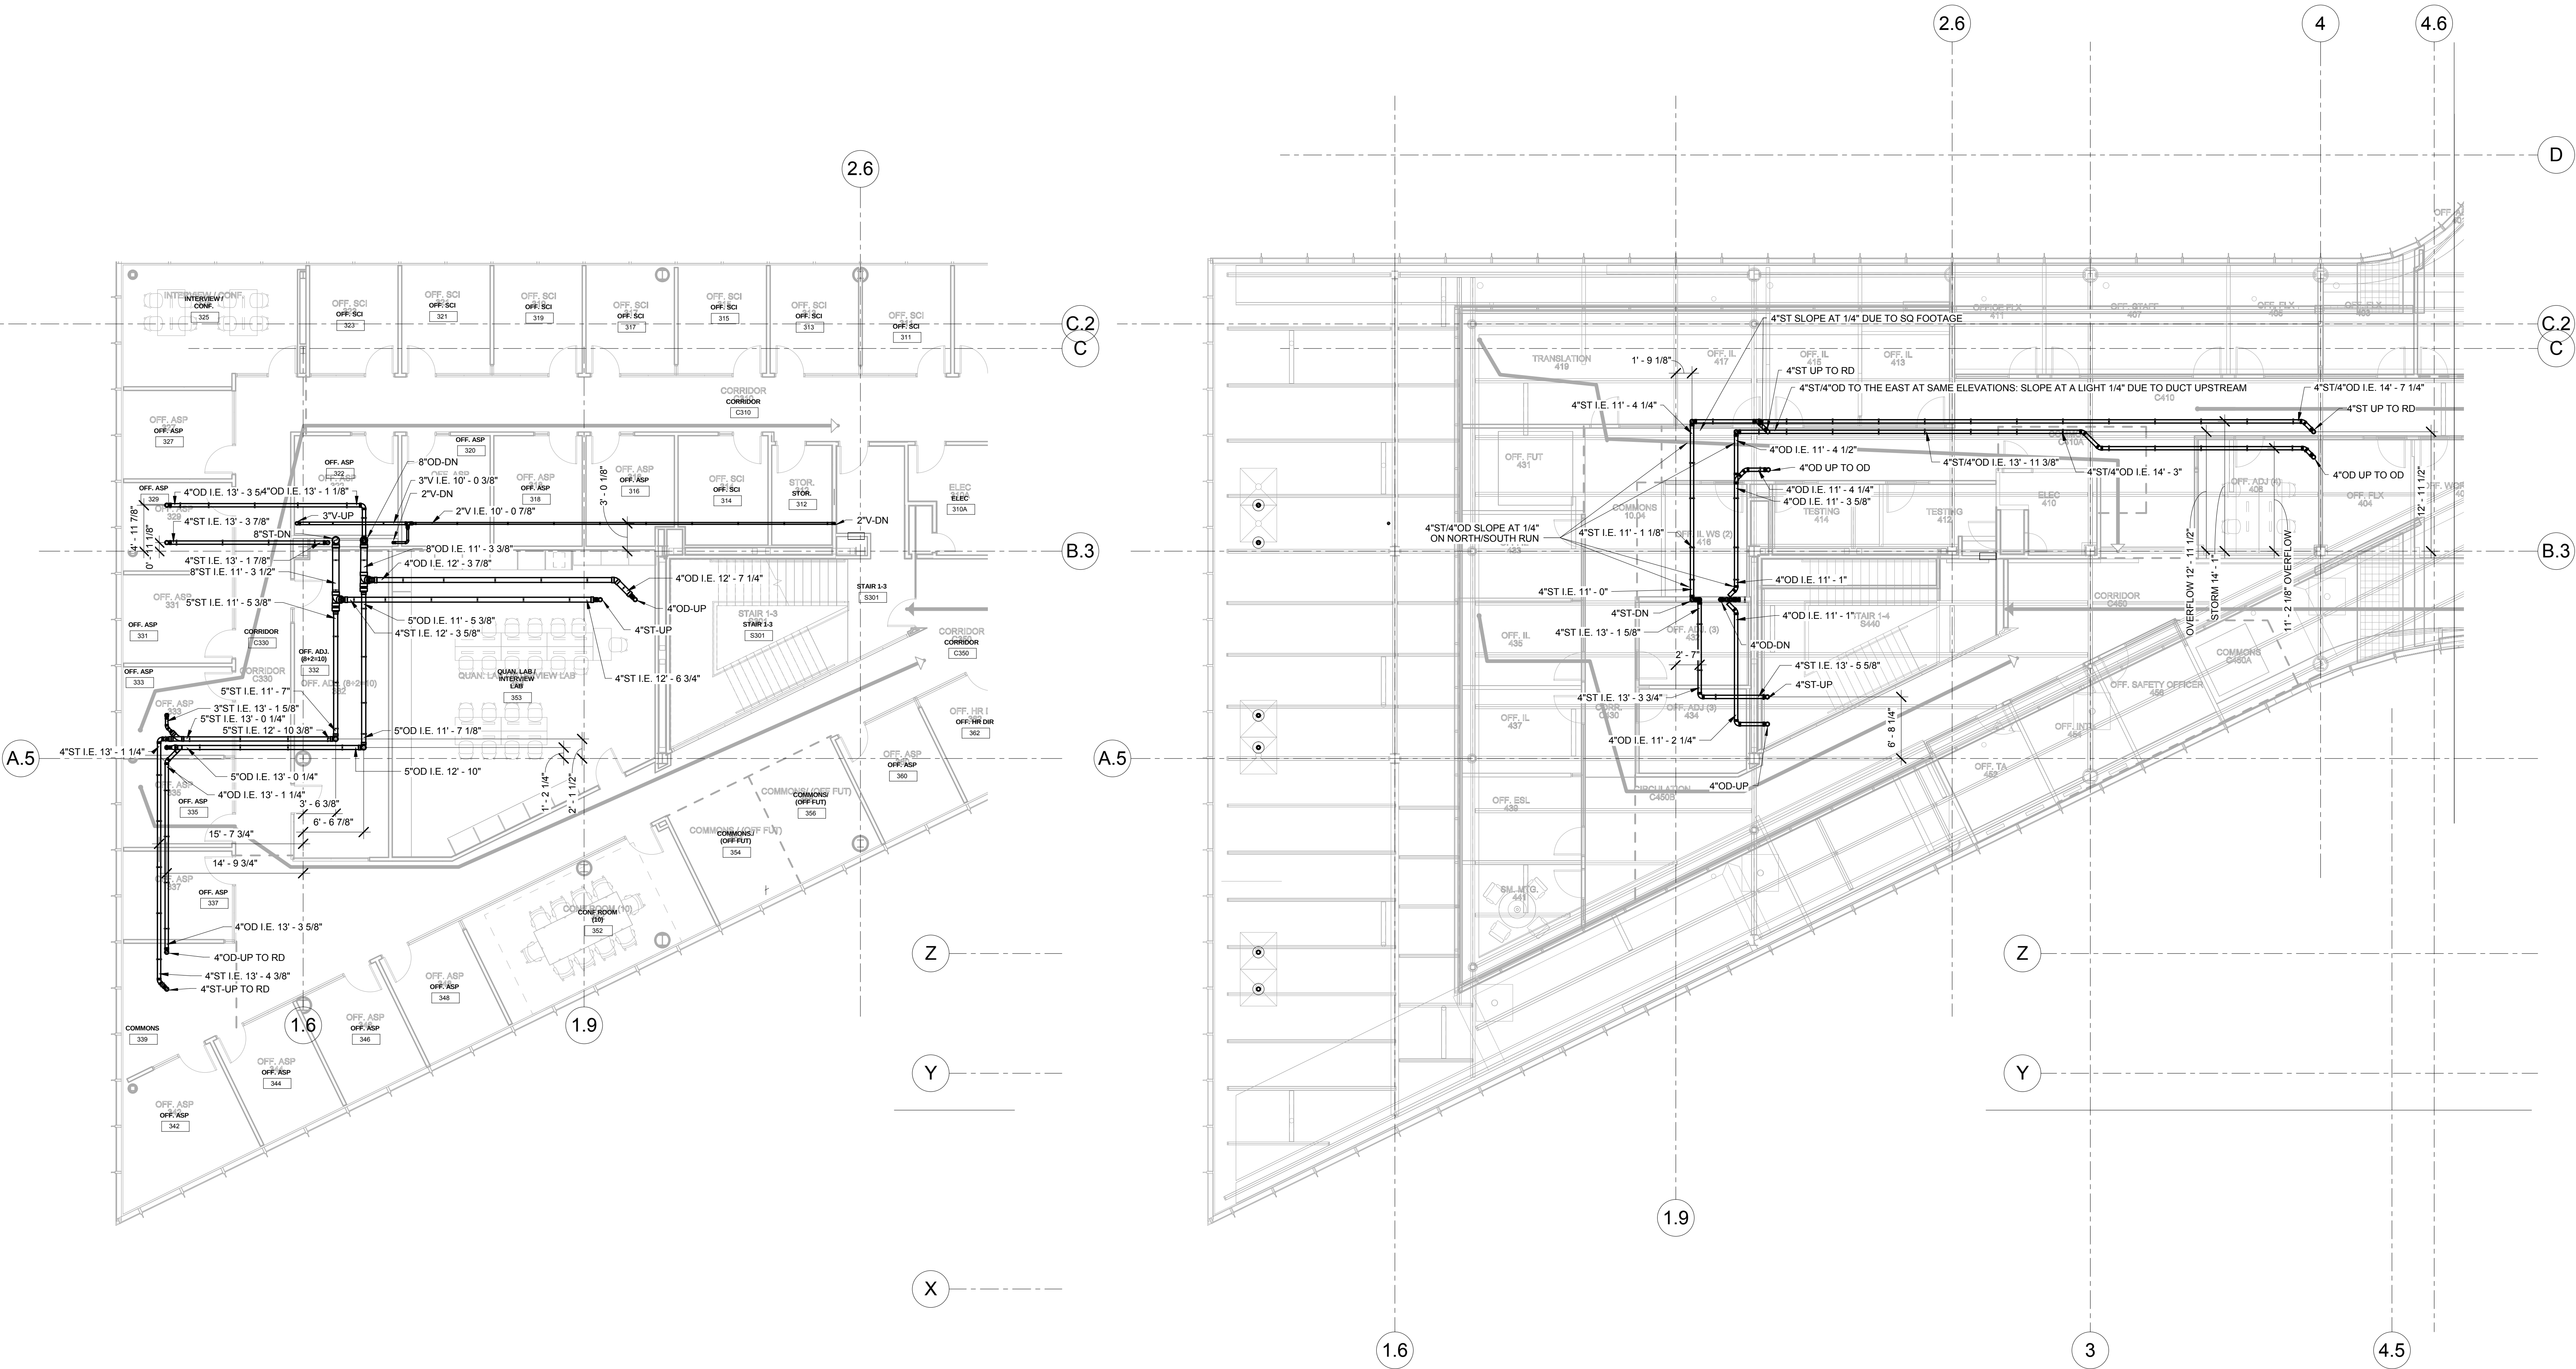

1 LEVEL 03 Field-DWV - Area B  
1/8" = 1'-0"

2 LEVEL 04 Field DWV - Area B  
1/8" = 1'-0"