



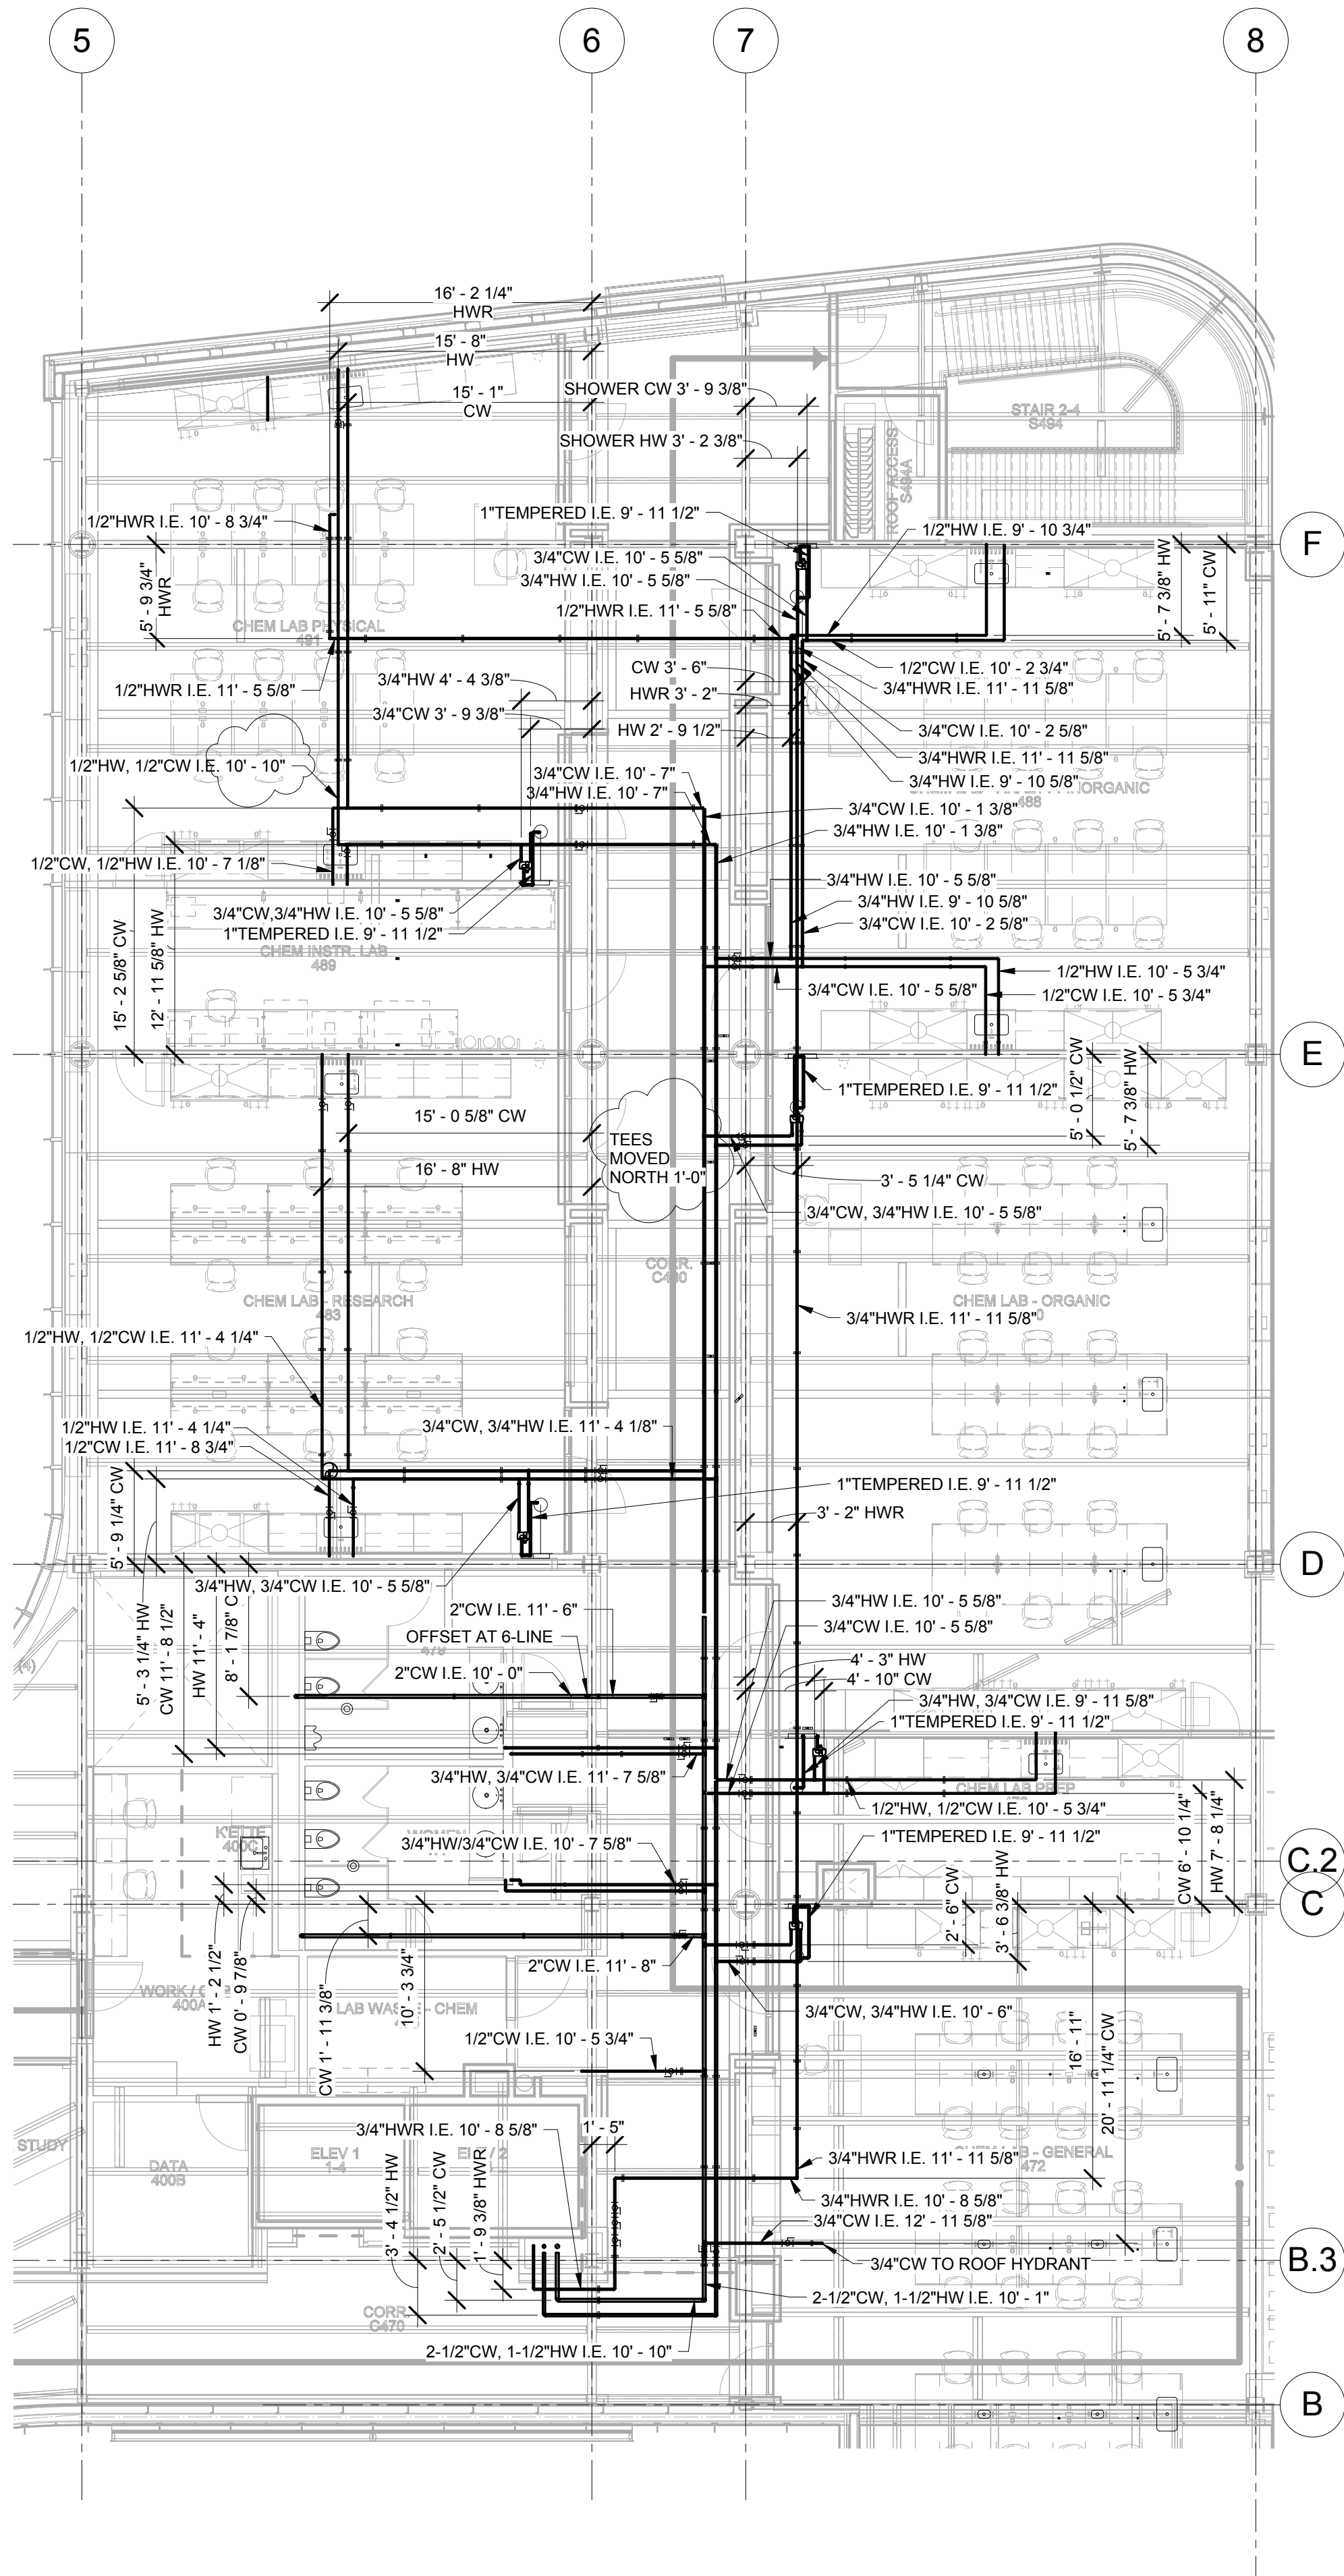

② LEVEL 04 Field Water
1/8" = 1'-0"

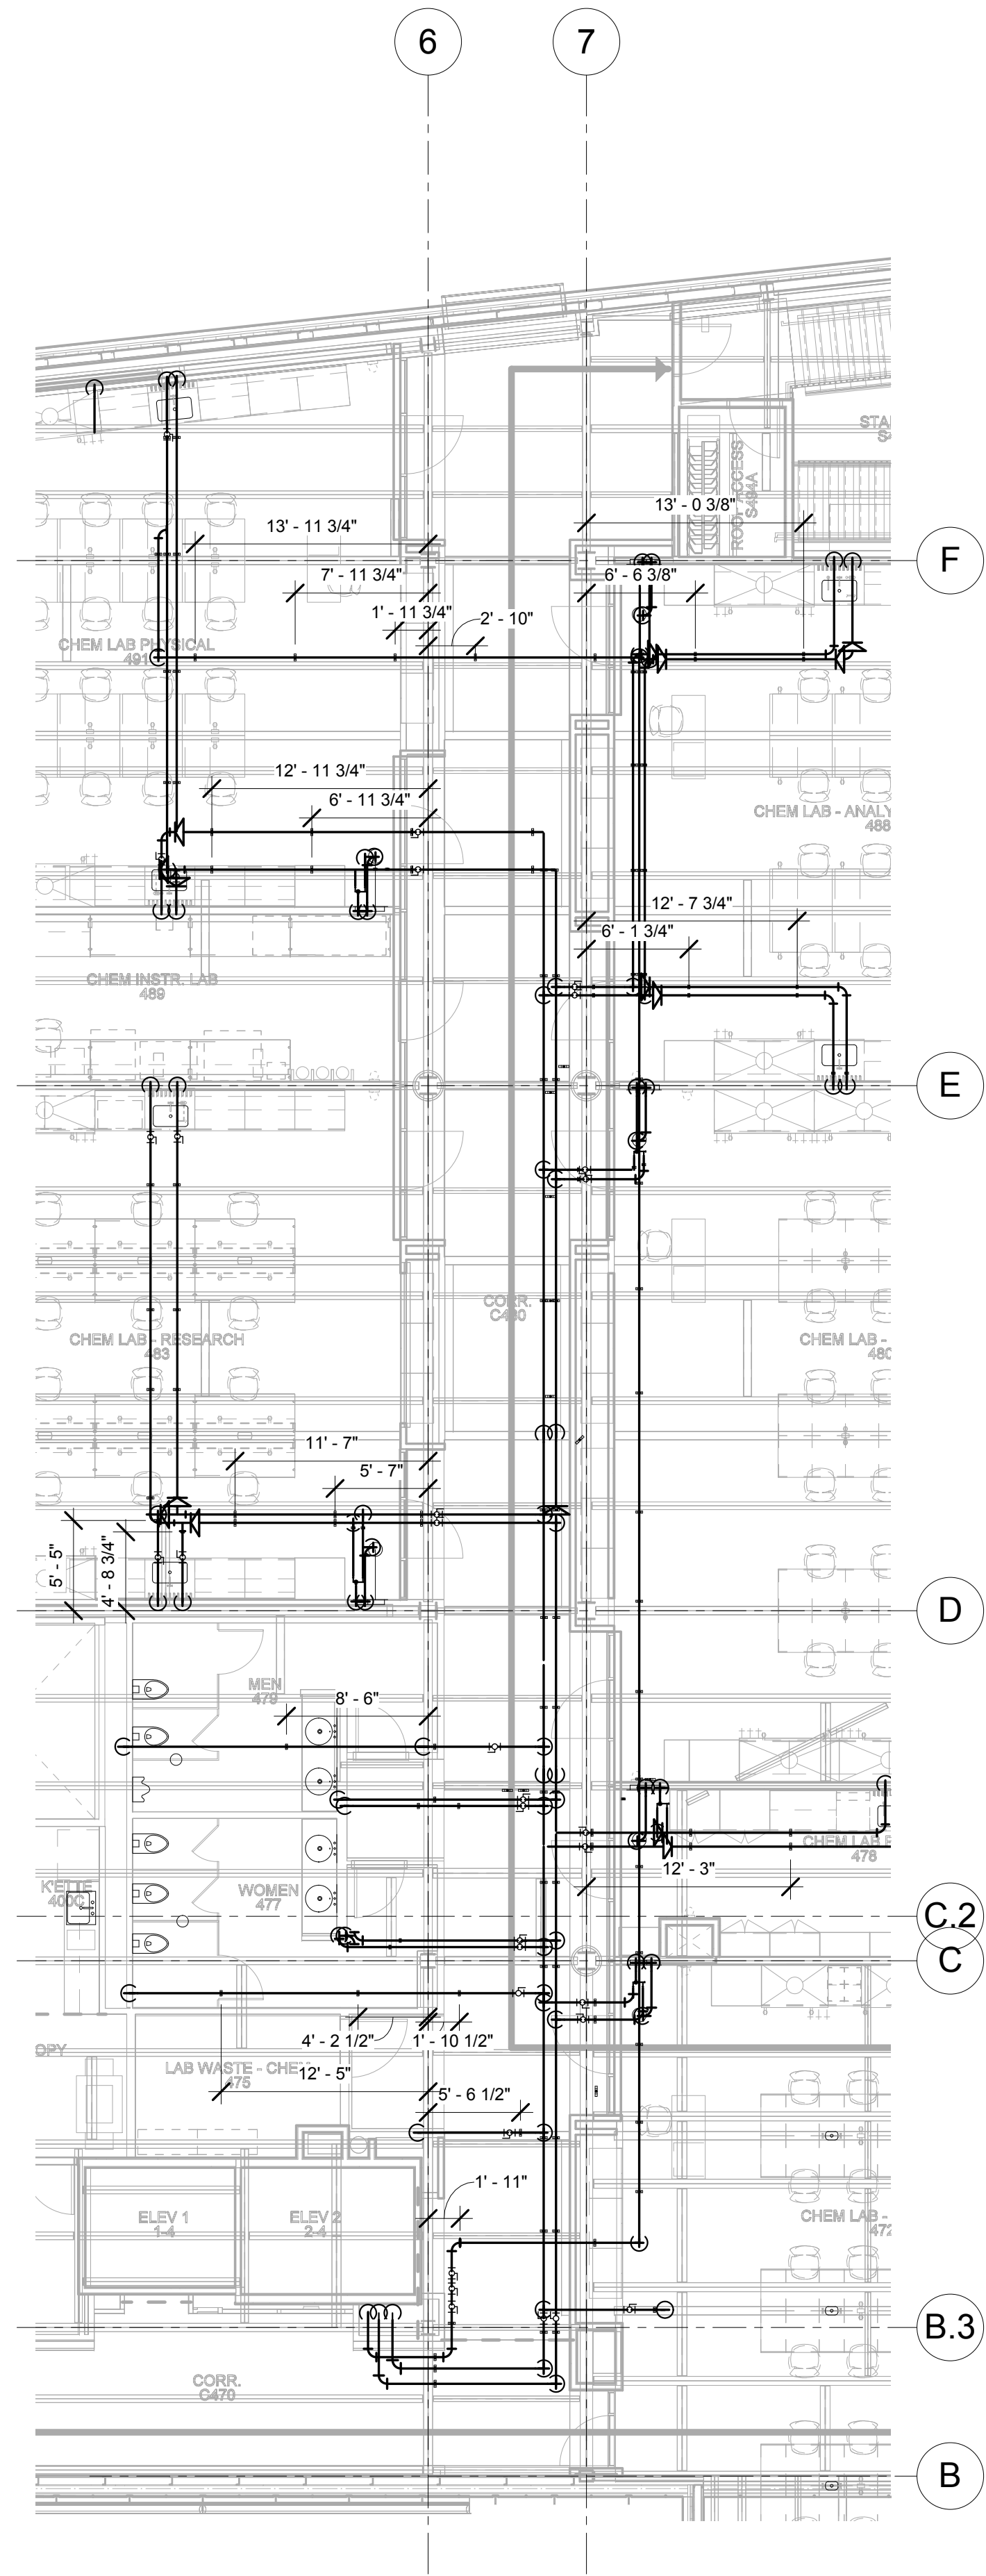

③ LEVEL 04 Field Water Hangers
1/8" = 1'-0"

No.	Issue Description:	Date:
1	FIELD ISSUE-GLAZING ADJUST	2017.01.19
2	AS-BUILT	2017.07.24

Drawn by:PCD Checked by:

Facility Index No.:

Sheet Title:
LEVEL 04 - AREA A -
WATER

Sheet Number: