


No.	Issue Description:	Date:
1	FIELD ISSUE	2016.11.23
2	AS-BUILT	2017.07.24

Drawn by:PCD Checked by:

Facility Index No.:

Sheet Title:
LEVEL 04 - AREA A - DWV

Sheet Number:

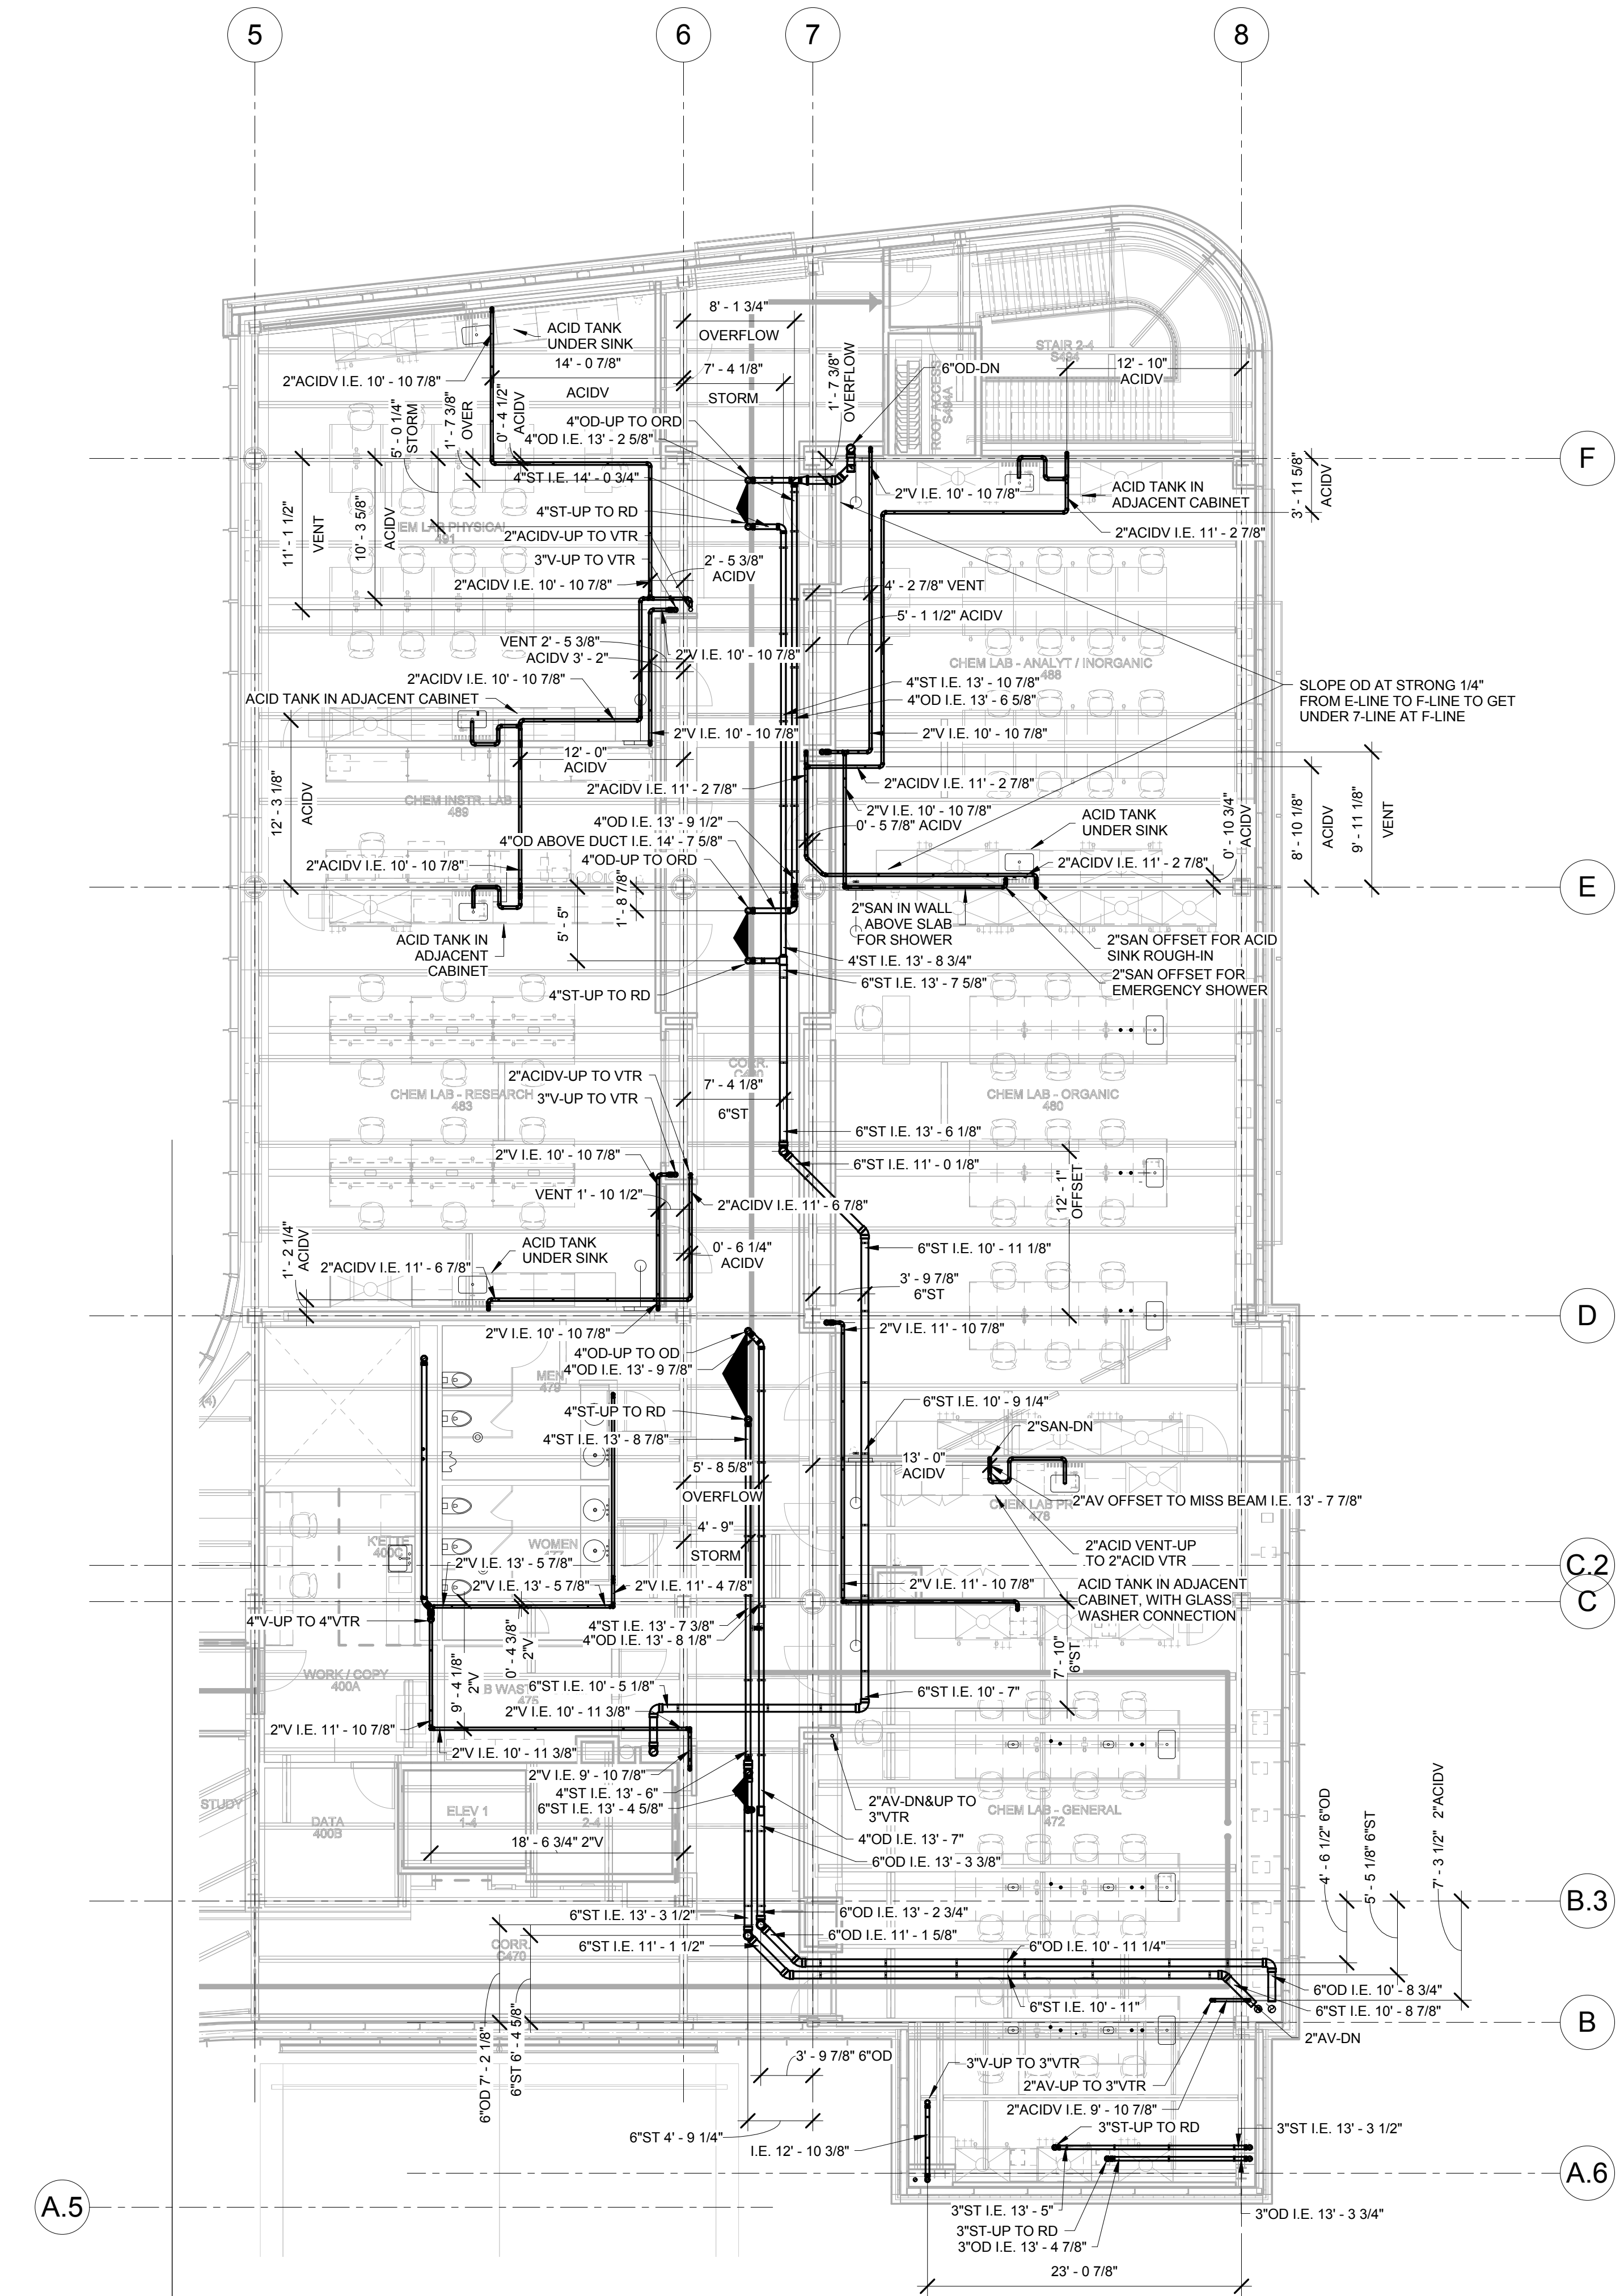

1 LEVEL 04 Field DWV - Area A
1/8" = 1'-0"