




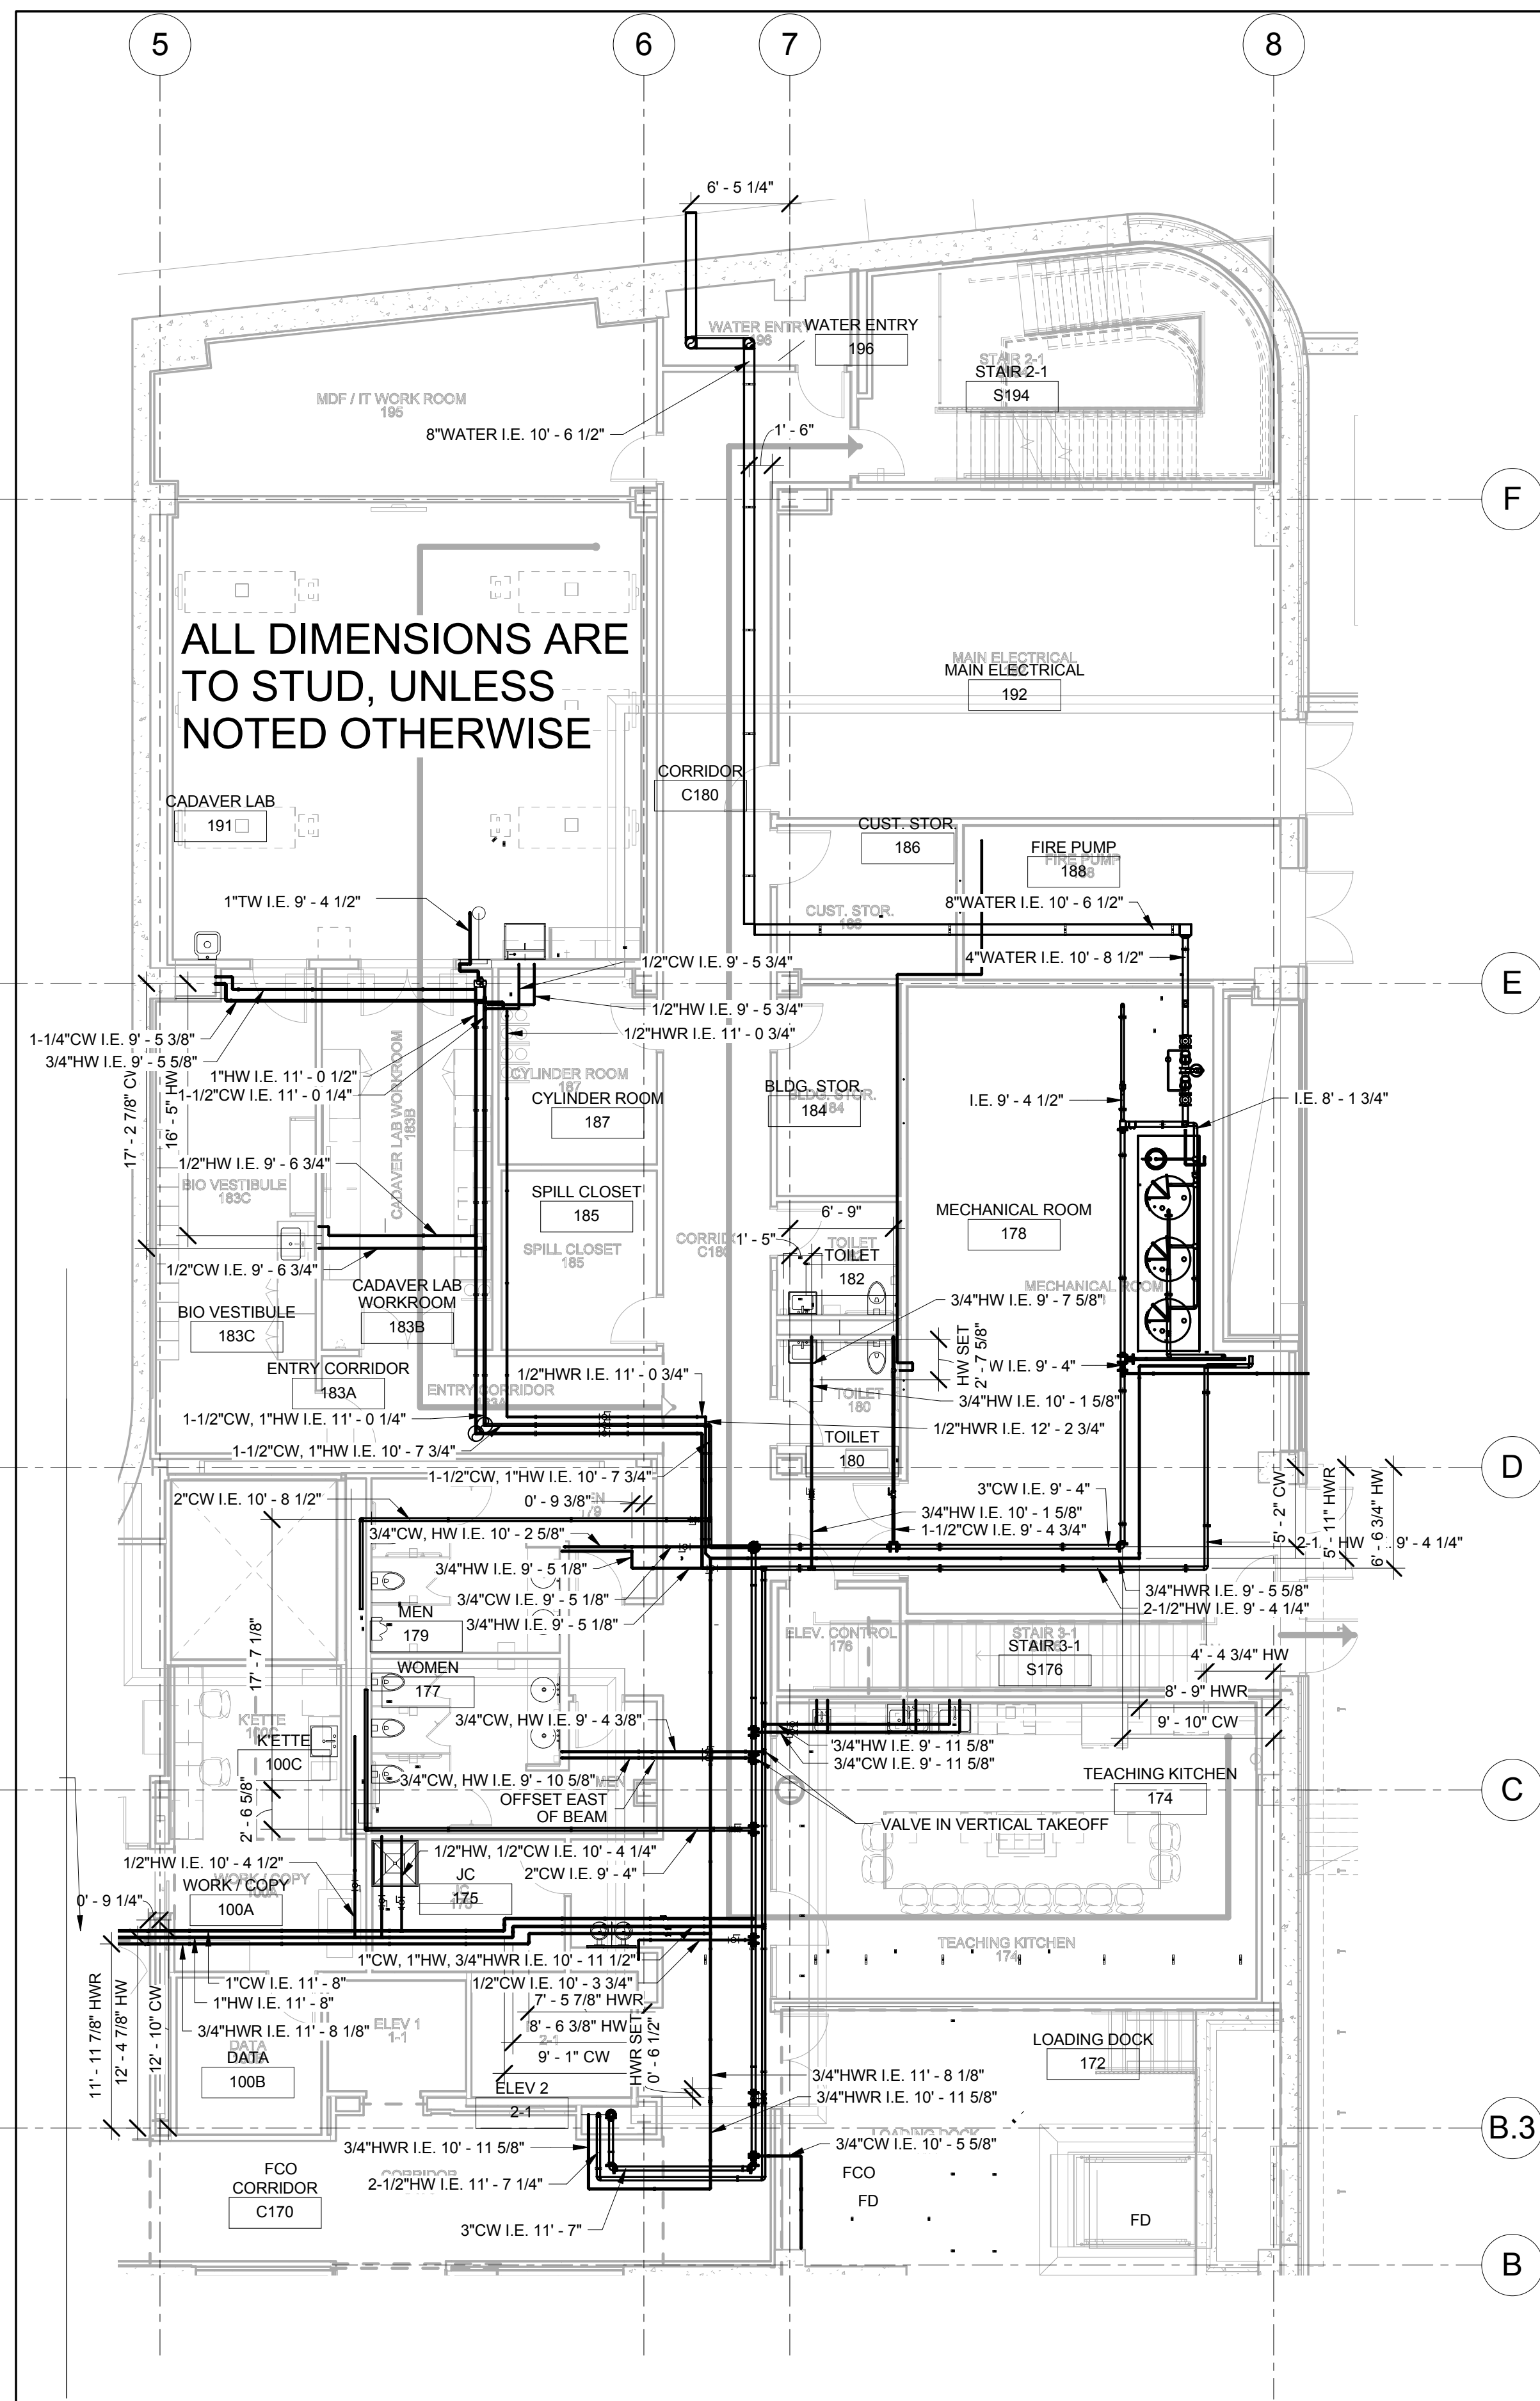


3 LEVEL 01 Field - WATER - AREA A
1/8" = 1'-0"

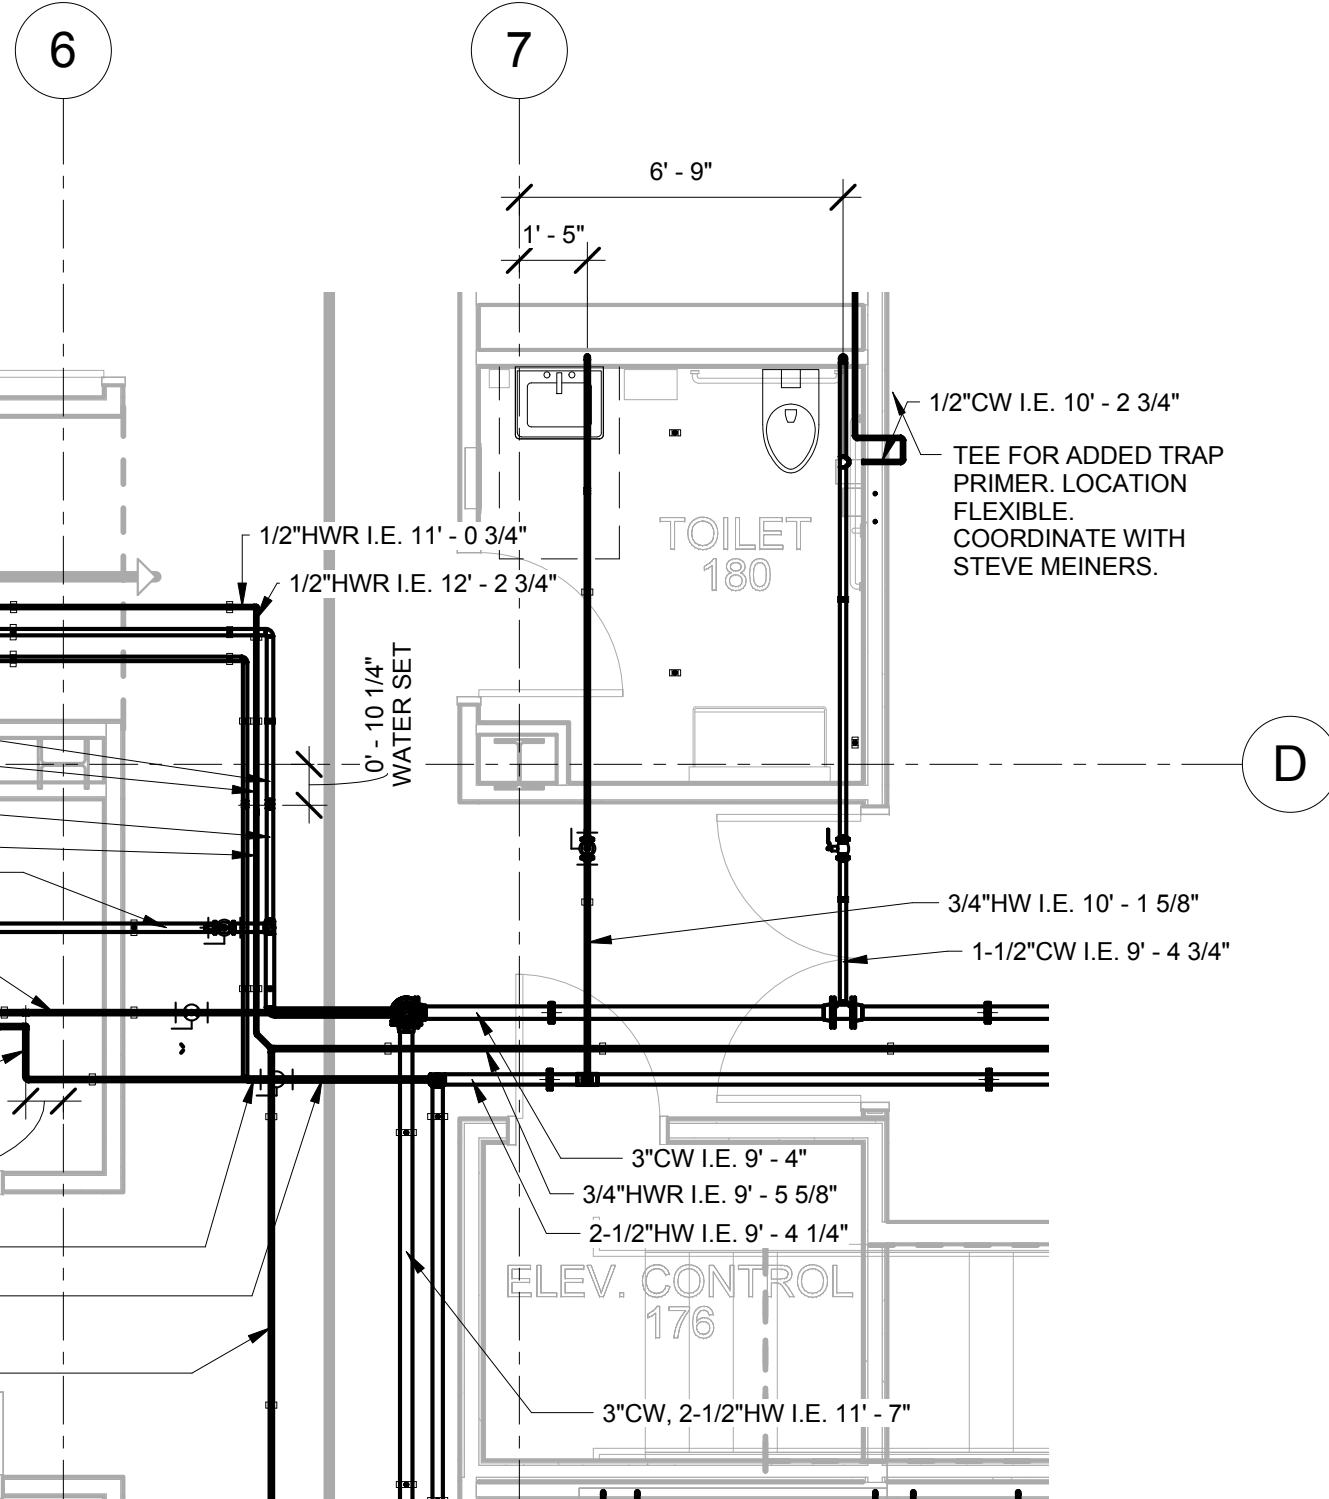

4 LEVEL 01 Field-water Enlarged Intersection
1/4" = 1'-0"

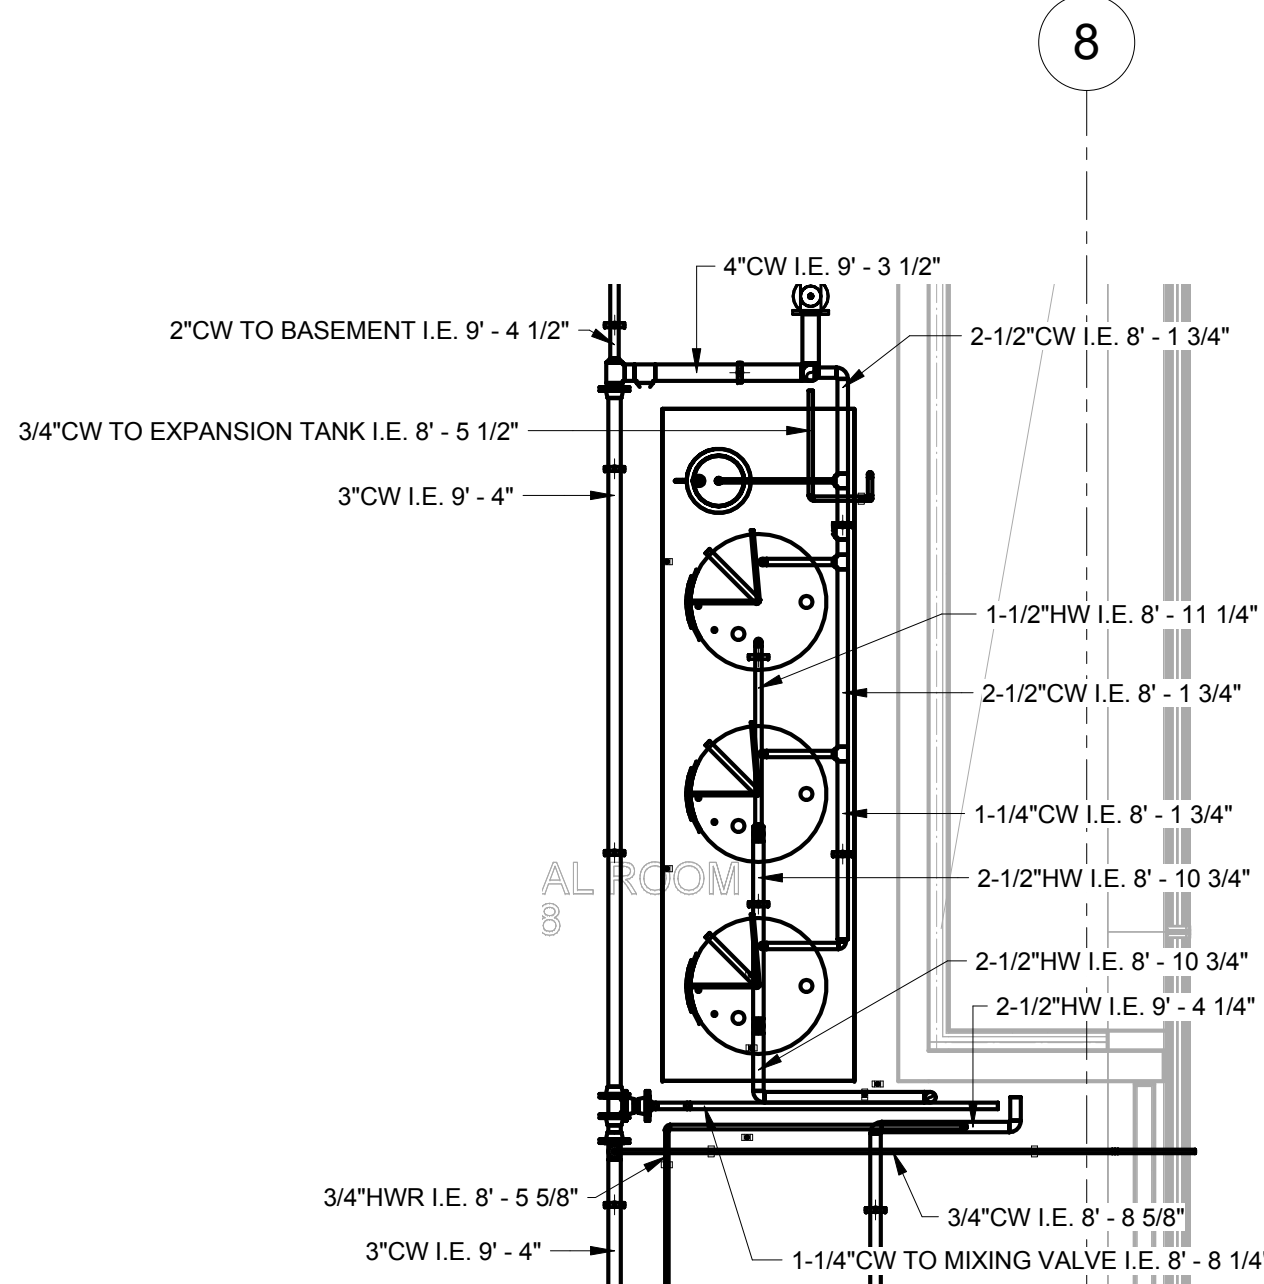

2 LEVEL 01 Field-water Enlarged
1/4" = 1'-0"

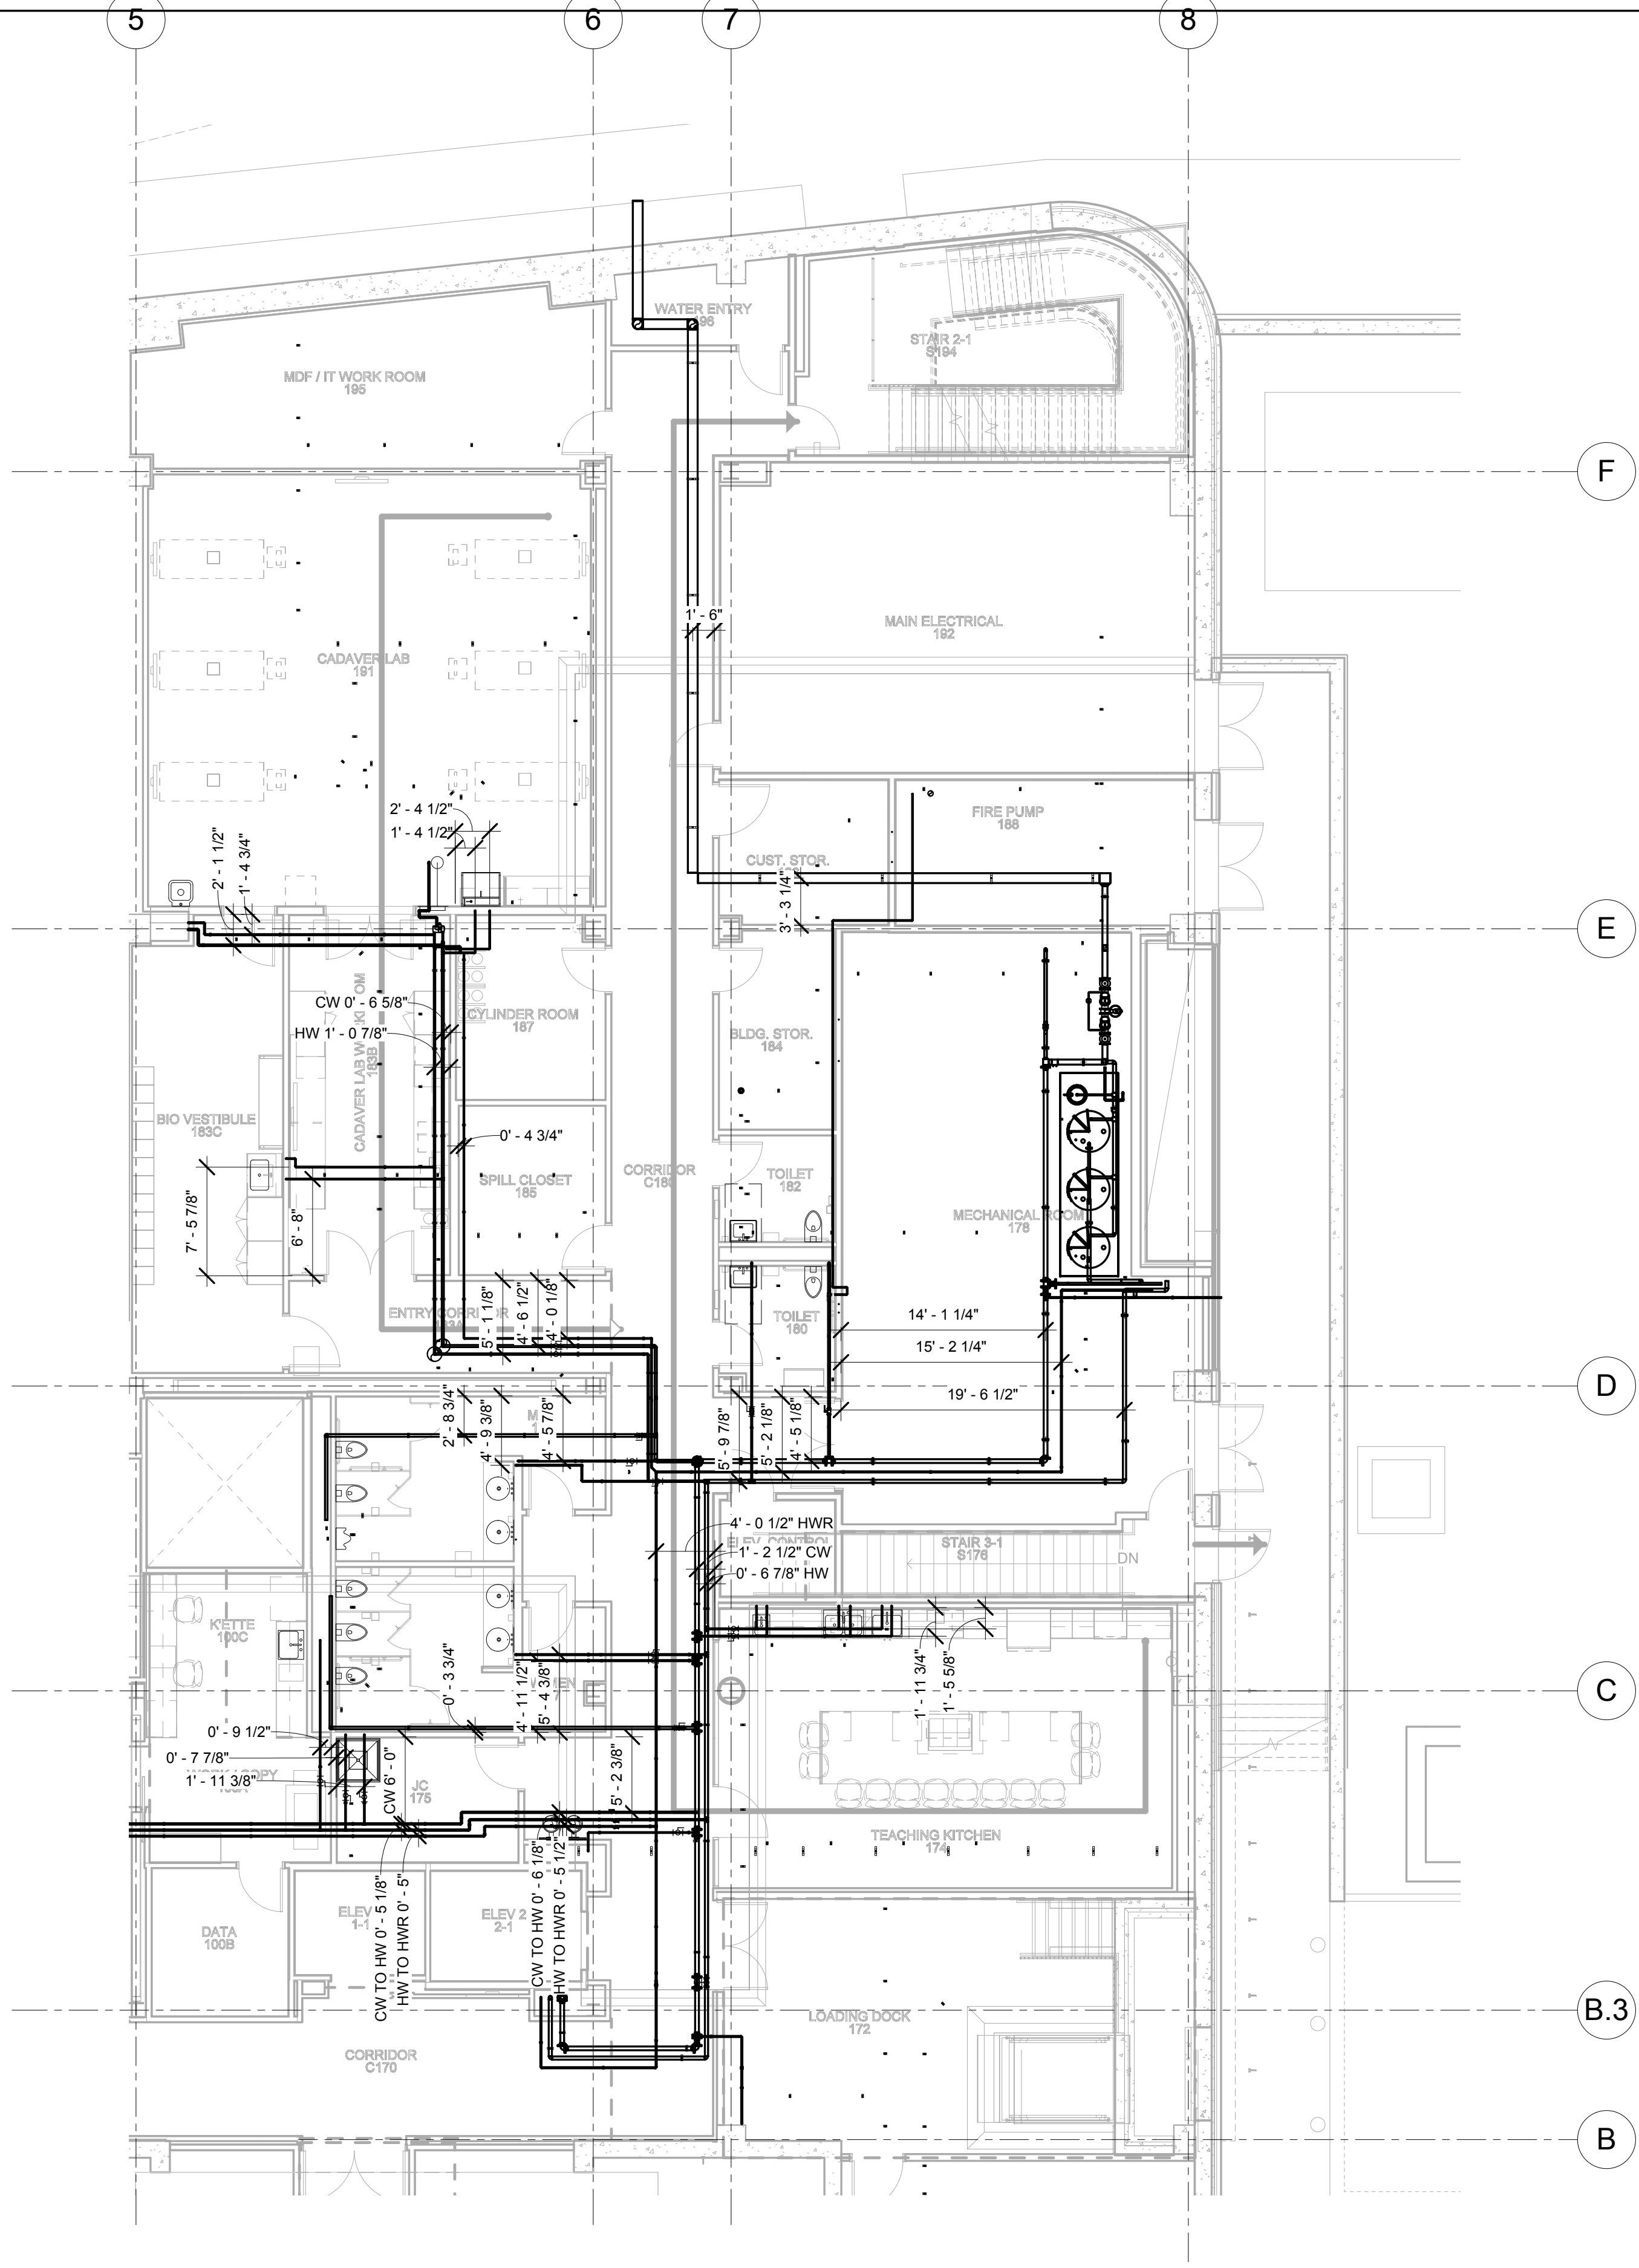

1 LEVEL 01 Field-water Dimensions
1/8" = 1'-0"


CANNONDESIGN

1100 Clark Avenue
St. Louis, Missouri 63102
T: 314.241.6250
F: 314.241.2570

CANNON DESIGN, Inc. - ARCHITECT
Missouri State Certificate of Authority #000051
Baltimore • Boston • Buffalo • Calgary • Chicago
Houston • Los Angeles • Mumbai • New York • Phoenix
St. Louis • San Francisco • Shanghai • Toronto
Vancouver • Victoria • Washington DC

CANNON DESIGN, Inc. - ENGINEER
Missouri State Certificate of Authority #000847

PARIC - Contractor
77 Westport Plaza, Suite 250
Saint Louis, MO
P: 636.561.9500

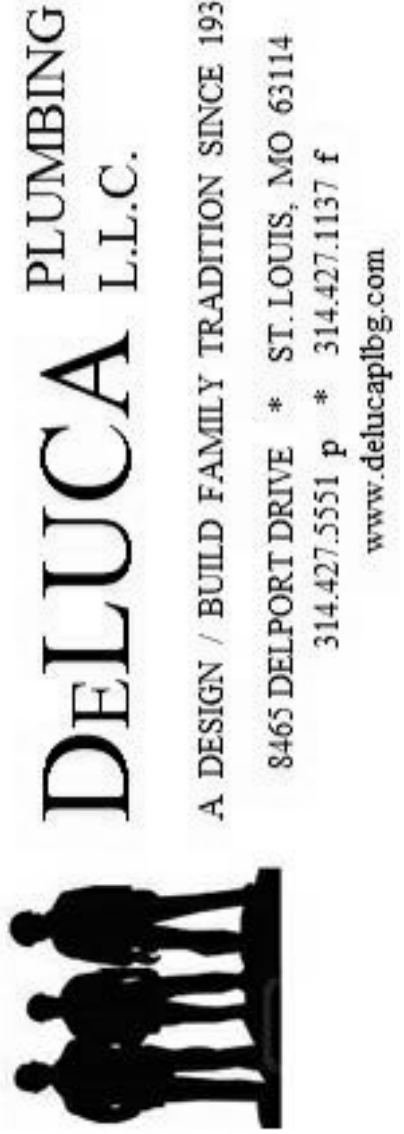

DELUCA PLUMBING L.L.C.
A DESIGN / BUILD FAMILY TRADITION SINCE 1938
8465 DELPORT DRIVE * ST. LOUIS, MO 63114
314.427.5551 p * 314.427.1137 f
www.delucaplbg.com

Project: WEBSTER UNIVERSITY
ISB

No.	Issue Description:	Date:
1	FIELD ISSUE-GLAZING ADJUST	2017.01.19
2	AS-BUILT	2017.07.24

Drawn by:PCD Checked by:

Facility Index No.:

Sheet Title:
LEVEL 01 - AREA A - DOMESTIC WATER

Sheet Number:

P01-0ADOM