



KEYED NOTES: (THIS SHEET ONLY)

- 1 NOT USED.
- 2 NOT USED.
- 3 PIPING IN EACH ROOM TO BE RUN AS HIGH AS POSSIBLE TO AVOID CONFLICTS. COORDINATE INSTALLATION AND ROUTING WITH OTHER TRADES PRIOR TO ROUGH-IN.
- 4 1/2" CW, 1/2" HW AND 2" VENT DOWN IN WALL TO SERVE FIXTURE.
- 5 BREAKROOM SINKS ARE TO BE SERVED FROM WATER, WASTE AND VENT PIPING IN TOILET ROOM CHASE.
- 6 PROVIDE SHUT-OFF VALVES AT THE ENTRY TO EACH ROOM.
- 7 EMERGENCY SHOWER TO BE SERVED WITH FIELD FURNISHED AND INSTALLED 1" TEMPERED WATER TO SHOWER HEAD FROM WALL RECESSED CABINET. EYEWASH PORTION OF ASSEMBLY TO 2" WASTE AND 2" VENT. TYPICAL FOR ALL INSTALLATIONS. REFER TO DRAWING P0403, DETAIL 3.
- 8 DECK MOUNTED EMERGENCY EYEWASH TO BE LOCATED AT SINK. INSTALL THERMOSTATIC MIXING VALVE IN CABINET SPACE BELOW THE SINK. COORDINATE MOUNTING REQUIREMENTS OF EYEWASH AND TMV WITH THE GENERAL CONTRACTOR. TYPICAL FOR ALL INSTALLATION. REFER TO DRAWING P0403, DETAIL 4.
- 9 DROP PIPING DOWN TO BELOW STRUCTURAL STEEL MEMBER. HOLD TIGHT TO BOTTOM OF STEEL.
- 10 PIPING IN CORRIDOR TO BE RUN AT BOTTOM OF STRUCTURAL STEEL CROSS MEMBERS. COORDINATE INSTALLATION WITH AND ROUTING WITH OTHER TRADES PRIOR TO ROUGH-IN.
- 11 4" SANITARY VENT RISER UP.
- 12 4" SANITARY WASTE RISER UP TO SERVE WATER CLOSETS, URINALS AND FLOOR DRAINS ON EACH LEVEL.
- 13 2" SANITARY WASTE RISER UP TO SERVE LAVATORIES ON EACH LEVEL.
- 14 NOT USED.
- 15 NOT USED.
- 16 HOT WATER RETURN CIRCUIT SETTER VALVE. LOCATE IN AN ACCESSIBLE LOCATION ABOVE THE CEILING. REFER TO DRAWING P0502, DETAIL 11/P0502.
- 17 WATER SERVICE UP TO ISLAND LAB BENCH SINKS ON LEVEL 4. COORDINATE WITH CASEWORK.
- 18 NOT USED.
- 19 ROOF DRAIN AND OVERFLOW DRAINS FROM LEVEL 4. REFER TO DRAWING P0104.A FOR CONTINUATION.
- 20 BACKFLOW PREVENTER FOR MECHANICAL MAKE-UP WATER. COORDINATE WITH THE MECHANICAL CONTRACTOR.
- 21 2" SANITARY VENT RISER UP TO SERVE LAVATORIES ON EACH LEVEL.
- 22 3/4" CW DOWN TO AUTOCLAVE. VERIFY SIZE AND CONNECTION POINT. PROVIDE ALL FITTINGS AS REQUIRED.
- 23 REFER TO DRAWING P0405 WATER SUPPLY RISER 7.
- 24 REFER TO DRAWING P0407 WATER SUPPLY RISER 1.
- 25 REFER TO DRAWING P0405 WATER SUPPLY RISER 3.
- 26 REFER TO DRAWING P0407 WATER SUPPLY RISER 5.
- 27 REFER TO DRAWING P0409 WATER SUPPLY RISER 1.
- 28 REFER TO DRAWING P0405 WATER SUPPLY RISER 5.
- 29 1/2" CW DOWN IN WALL TO SERVE ICE MACHINE. VERIFY CONNECTION POINT AND LOCATION. PROVIDE ALL FITTINGS AS REQUIRED.
- 30 1/2" HW DOWN IN WALL TO SERVE UNDERCOUNTER GLASS WASHER. VERIFY CONNECTION POINT TO UNIT AND LOCATION. PROVIDE ALL FITTINGS AS REQUIRED.
- 31 1/2" CW DOWN IN WALL TO SERVE FLOOR MOUNTED AUTOCLAVE. VERIFY EXACT EQUIPMENT PLACEMENT PRIOR TO ROUGH-IN.
- 32 PROVIDE WASTE TYPE TRAPE PRIMER (TP-3) ON LAVATORY DRAIN.
- 33 1/2" CW TRAP PRIMER DOWN IN WALL TO SERVE FLOOR SINK (FS-2).

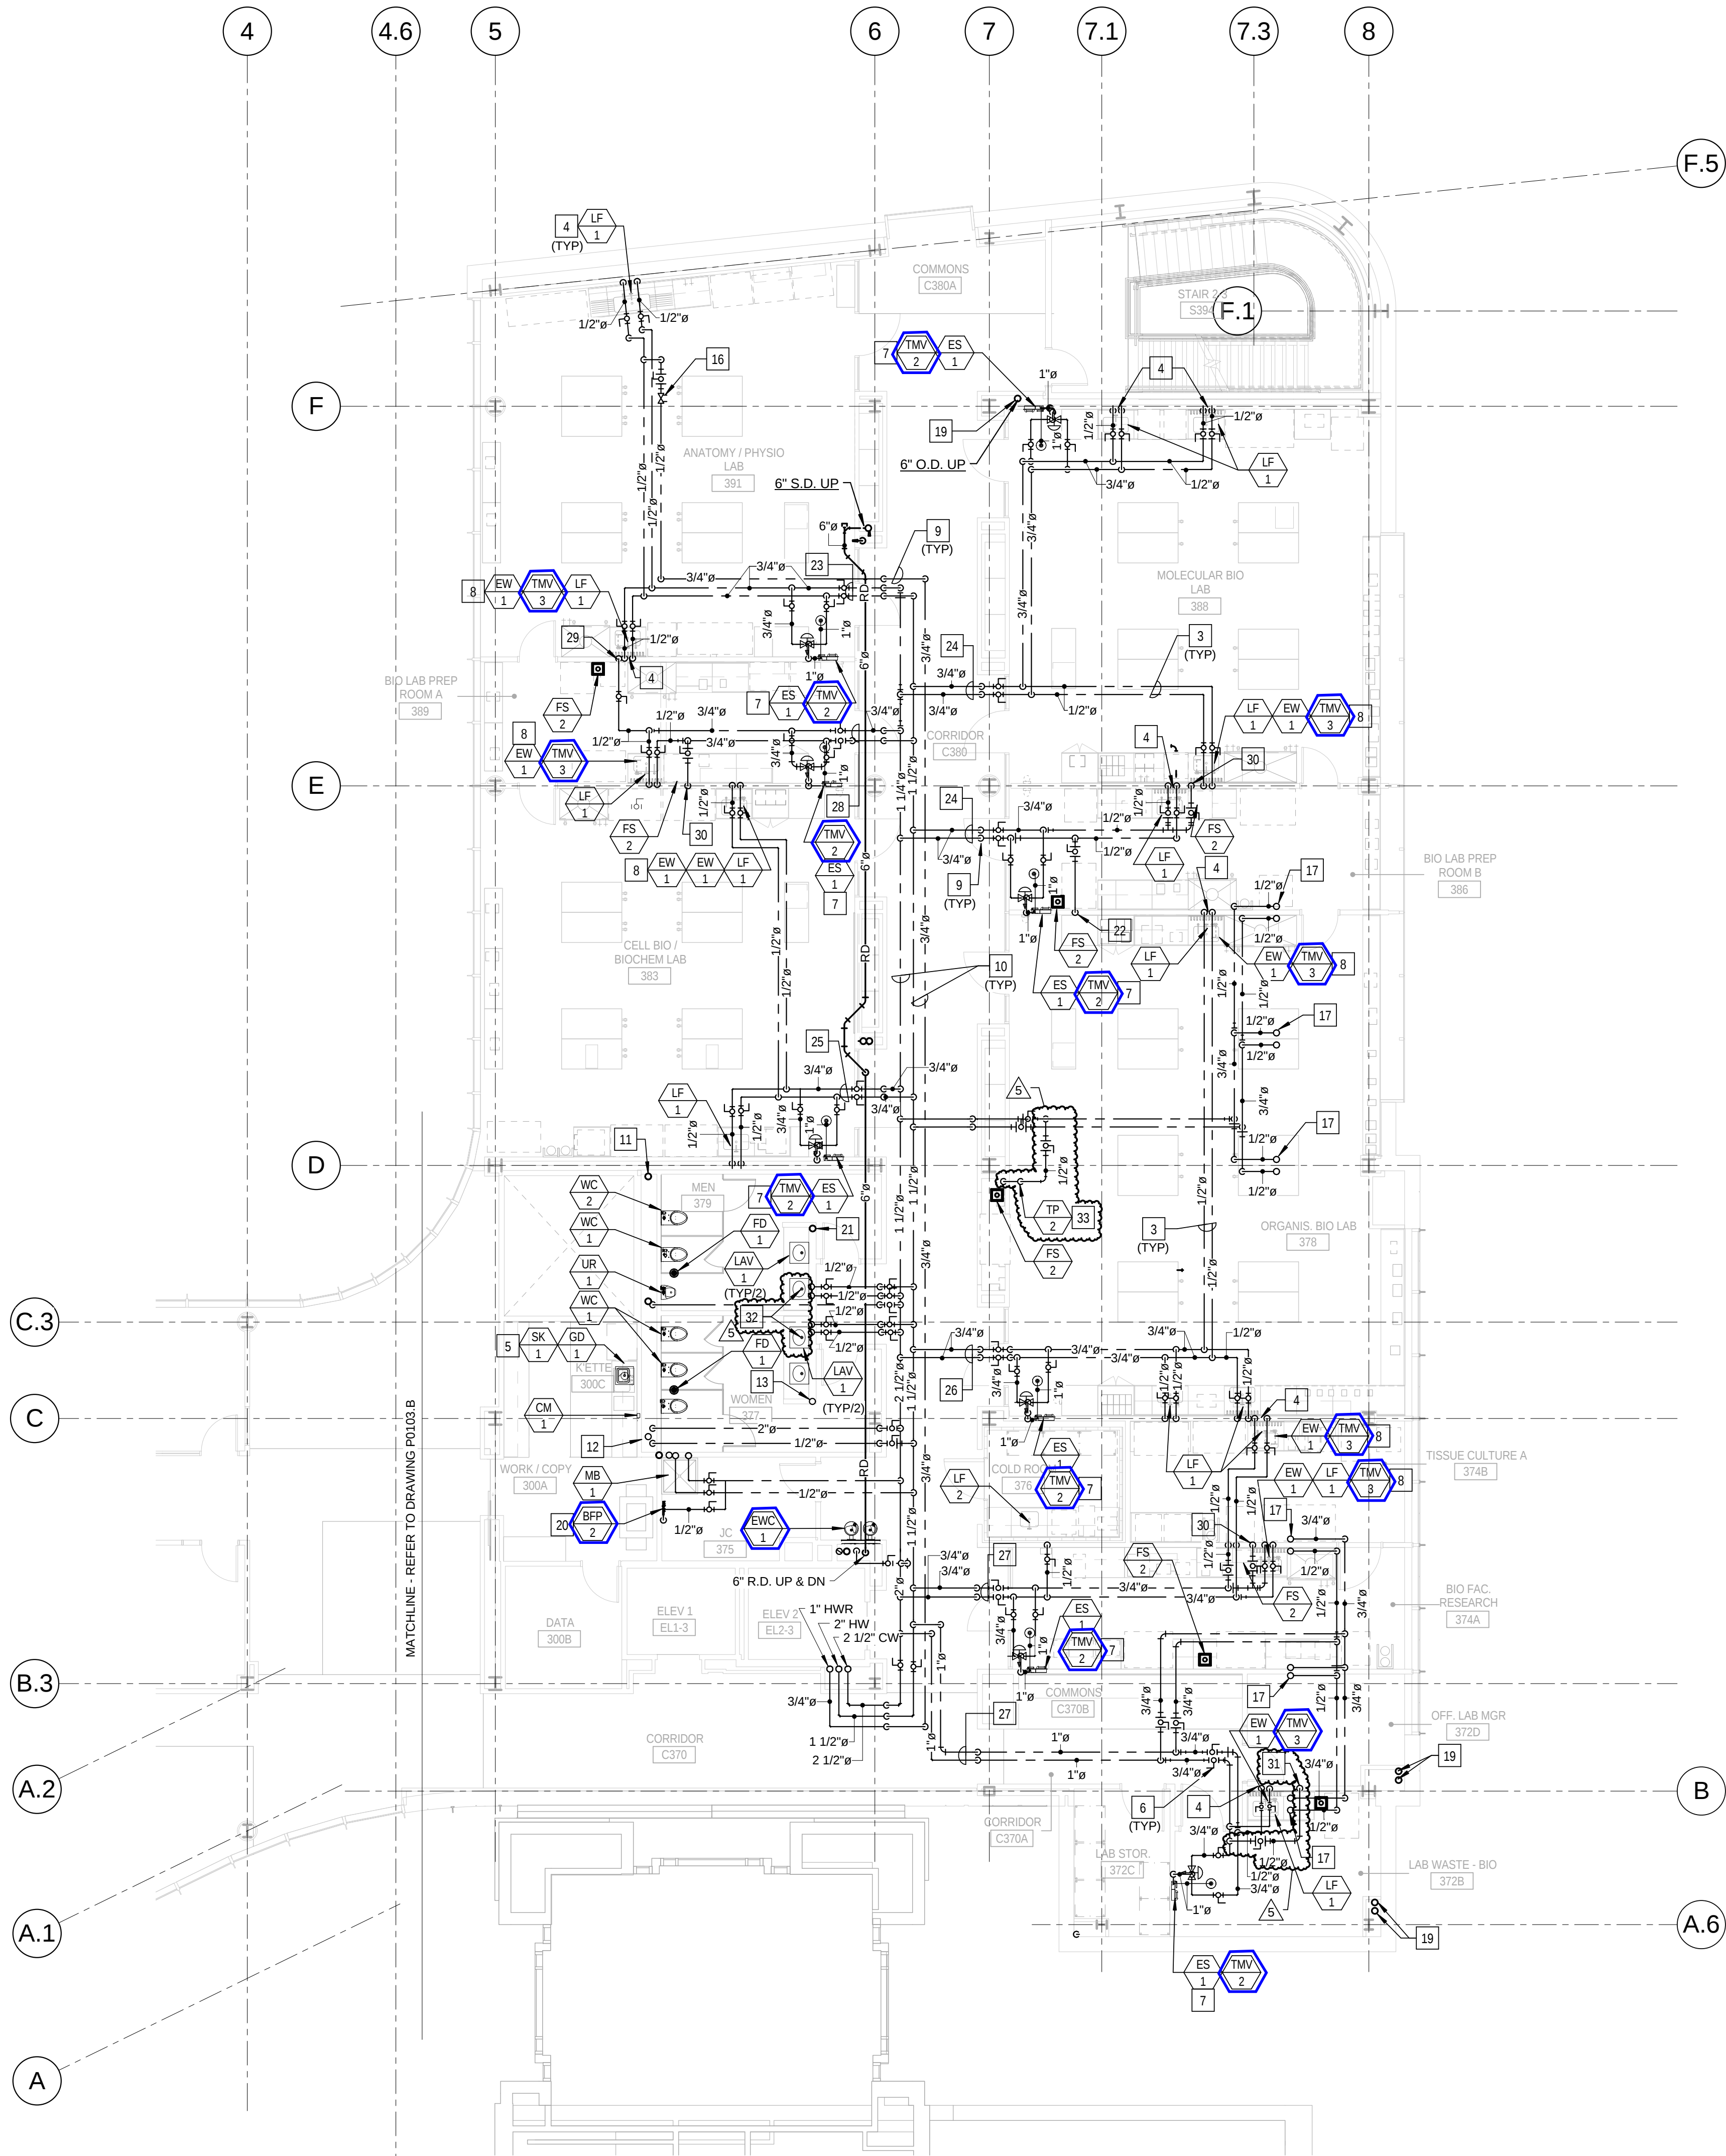

1 LEVEL 03 AREA A FLOOR PLAN - PLUMBING
1/8" = 1'-0"

5	ASI - 033 (RFI 261,286,309 & 310)	03 NOV 2016
4	ASI - 019 (RFI-193,208 & 212)	29 JUL 2016
3	ADDENDUM 2-4	24 MAY 2015
2	ADDENDUM 2-2	19 APR 2016
1	ADDENDUM 2-1	17 MAR 2016
-	ISSUED FOR CONSTRUCTION (BP2)	01 MAR 2016

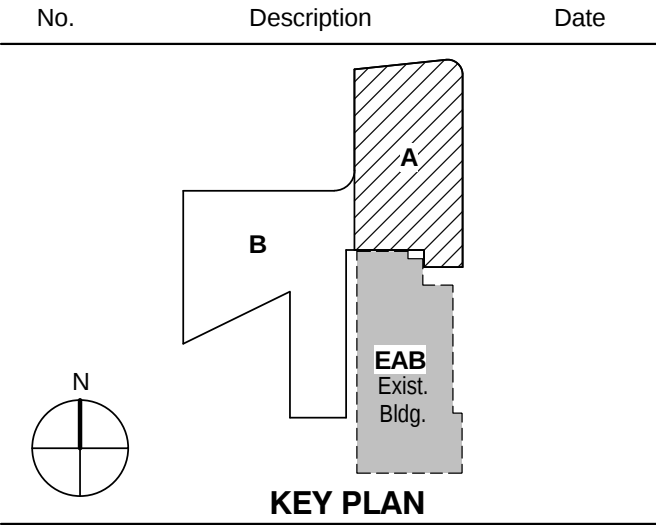

Drawing Title:
LEVEL 03 AREA A FLOOR
PLAN - PLUMBING

Project No.: 04561.01 Checked by:

P0103.A