


4	ASI - 025 Neutralization Tanks	09 SEP 2016
3	ASI - 024 (RFI 222,233,235 & 236)	24 AUG 2016
2	ADDENDUM 2-4	24 MAY 2016
1	ADDENDUM 2-2	19 APR 2016
-	ISSUED FOR CONSTRUCTION (BP2)	01 MAR 2016

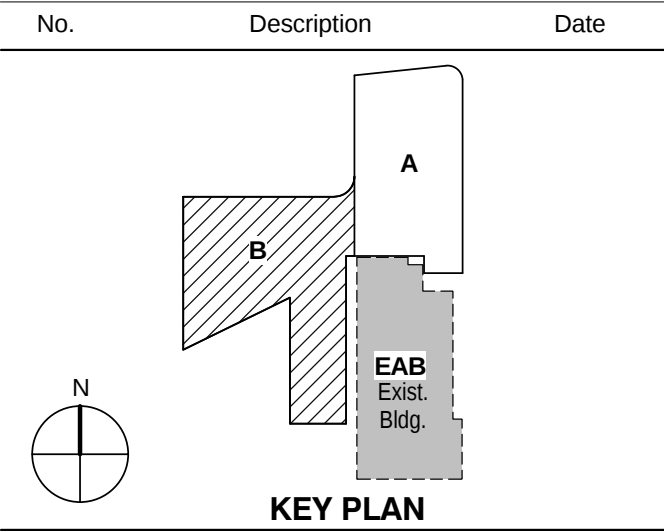


KEY PLAN

LEVEL 05 ROOF PLAN
AREA A - PLUMBING

Project No.: 04561.01 Checked by:

P0105.A

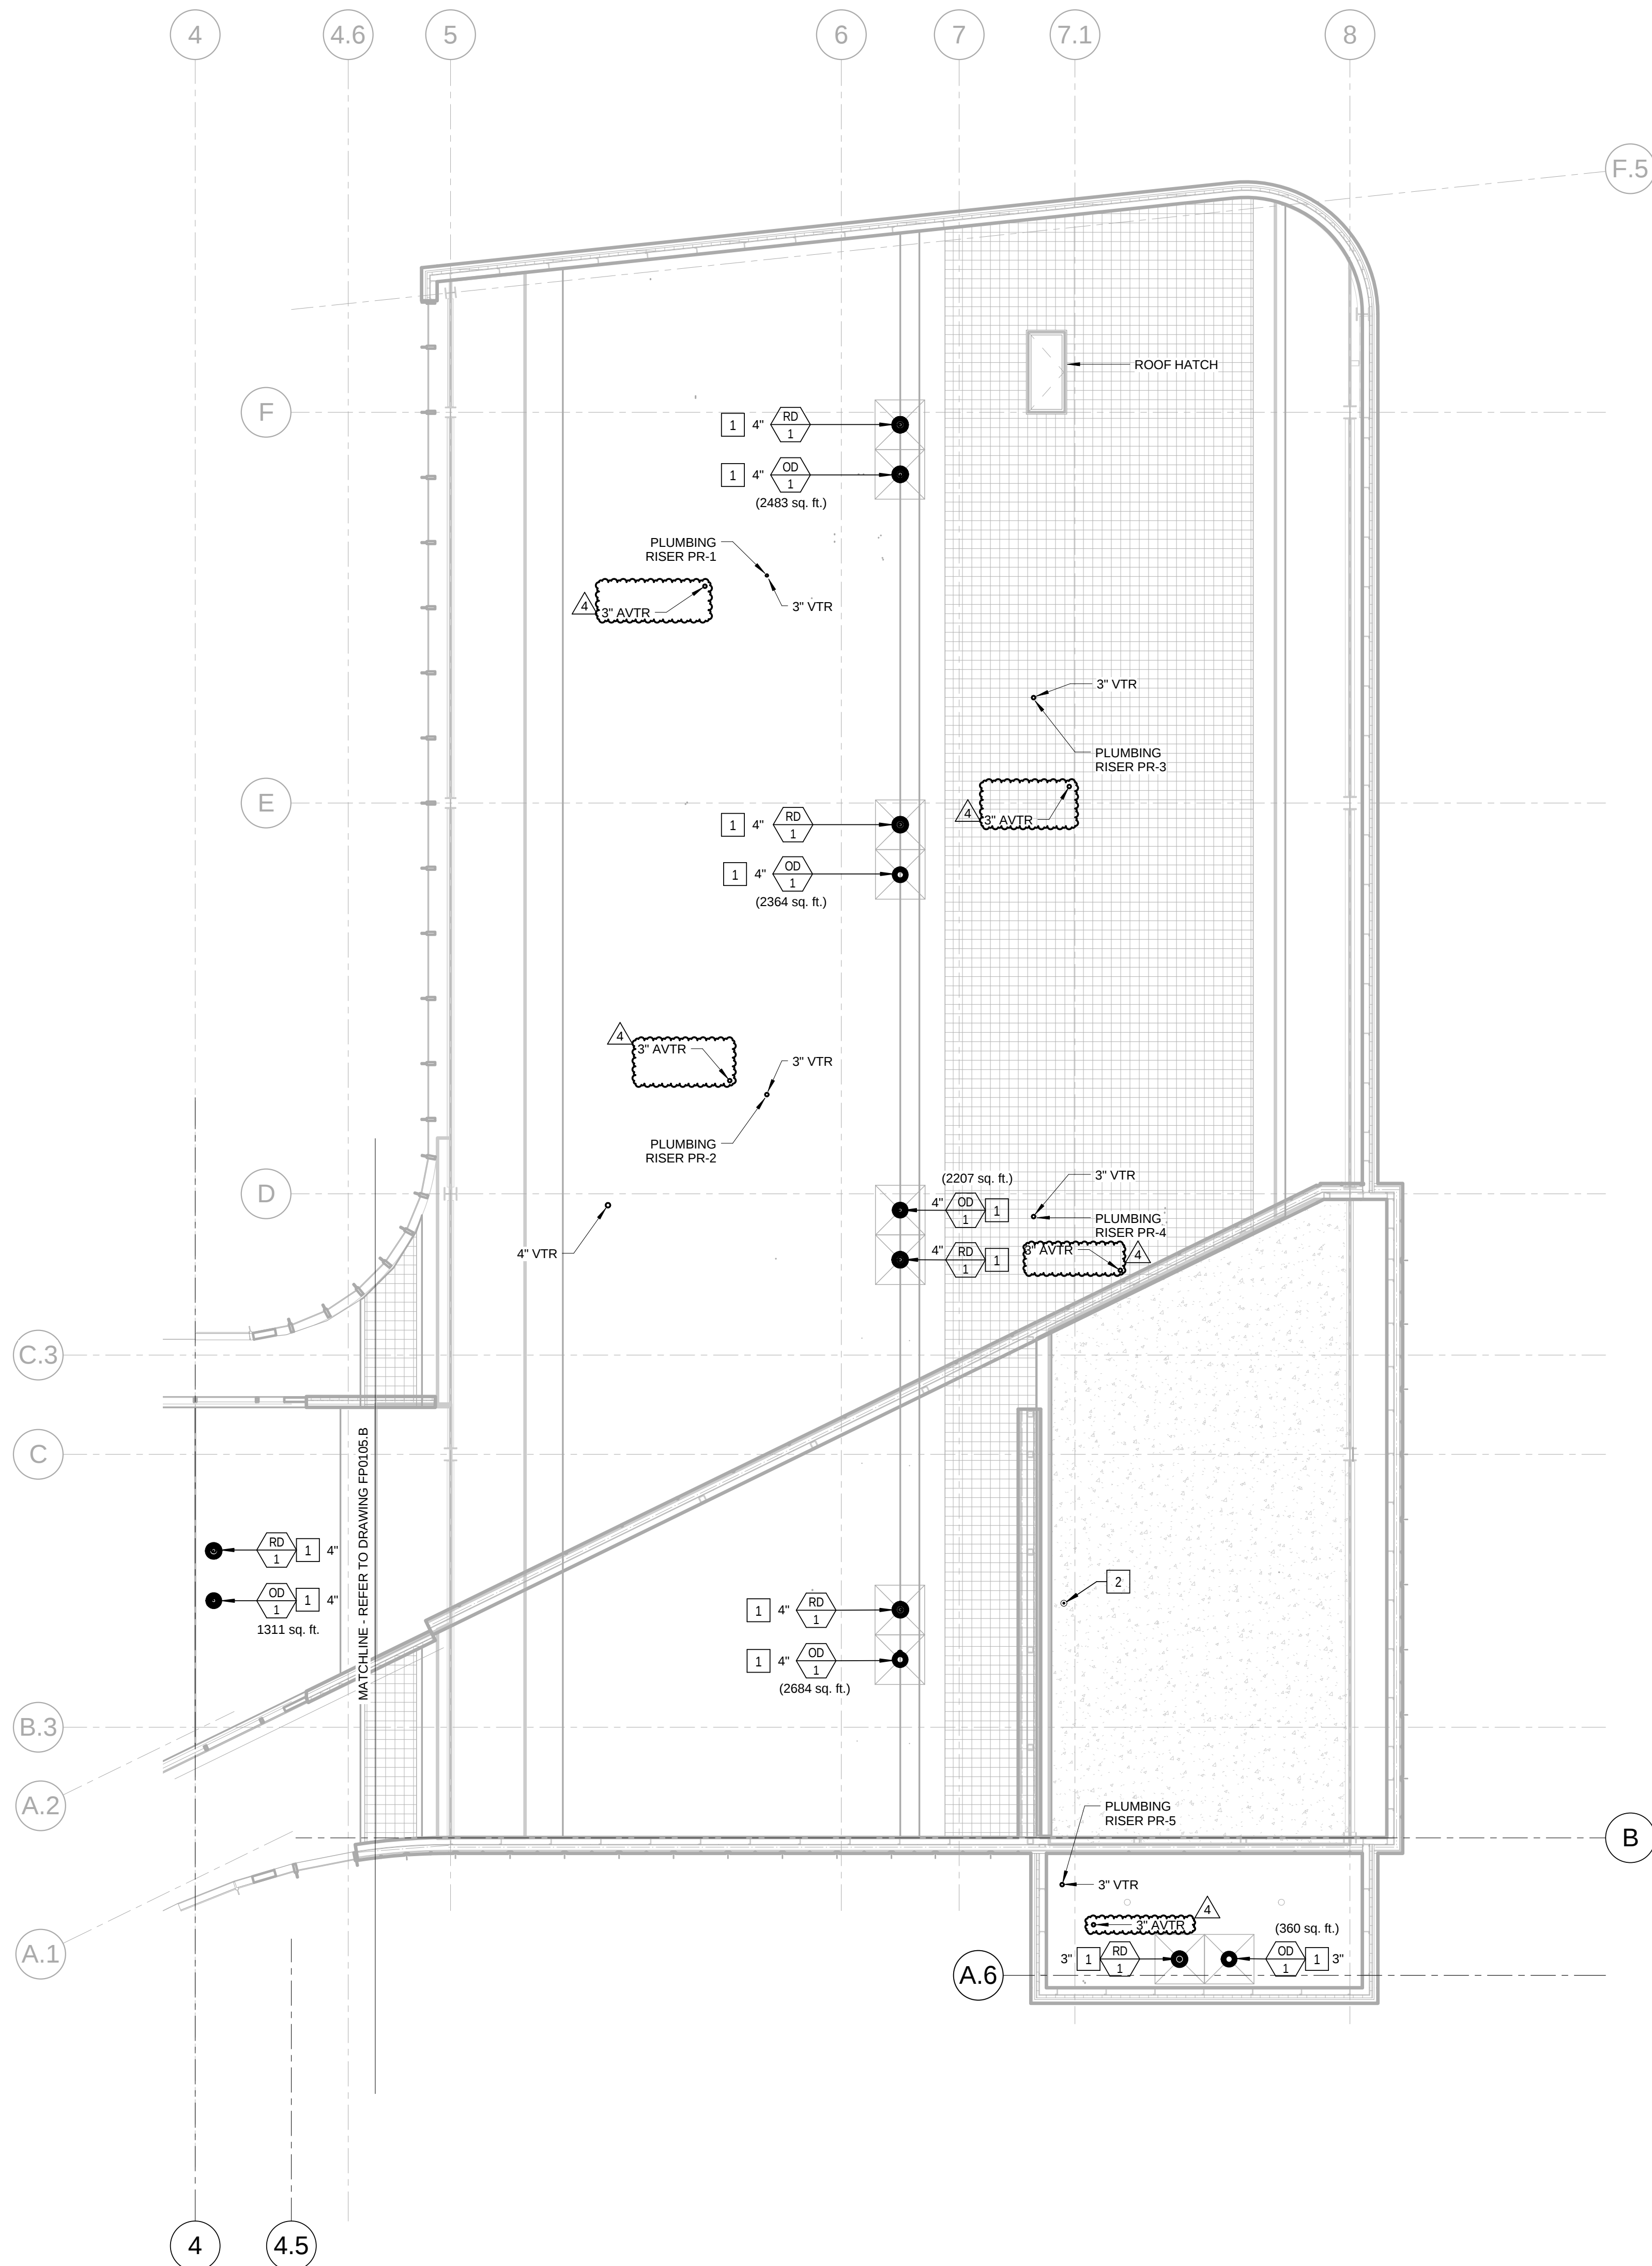

NOTE - PLUMBING NEW WORK

1. CONTRACTOR SHALL FURNISH AND INSTALL ROOF DRAINS AND OVERFLOW DRAINS. REFER TO DETAIL ON DRAWING P0501.
2. 3/4" CW SERVICE UP THOUGH ROOF TO SERVE NON-FREEZE SANITARY ROOF HYDRANT JAY R. SMITH MODEL 5903 OR EQUAL. VERIFY LOCATION WITH GENERAL CONTRACTOR PRIOR TO ROUGH-IN.