


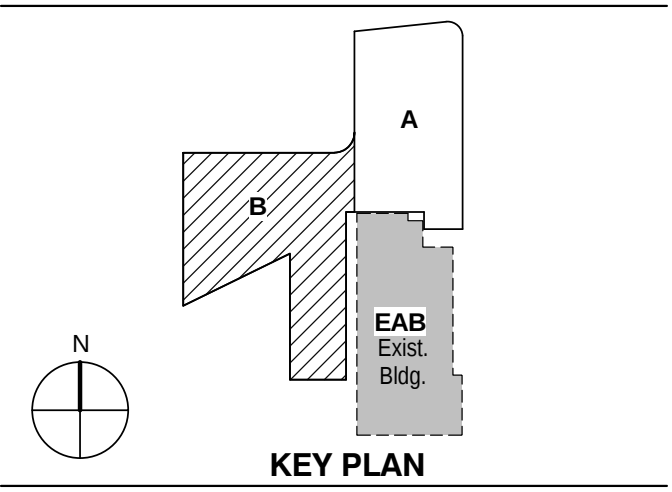


Drawing Title:

LEVEL 05 ROOF PLAN
AREA B - PLUMBING

Project No.: 04561.01 Checked by:

P0105.B

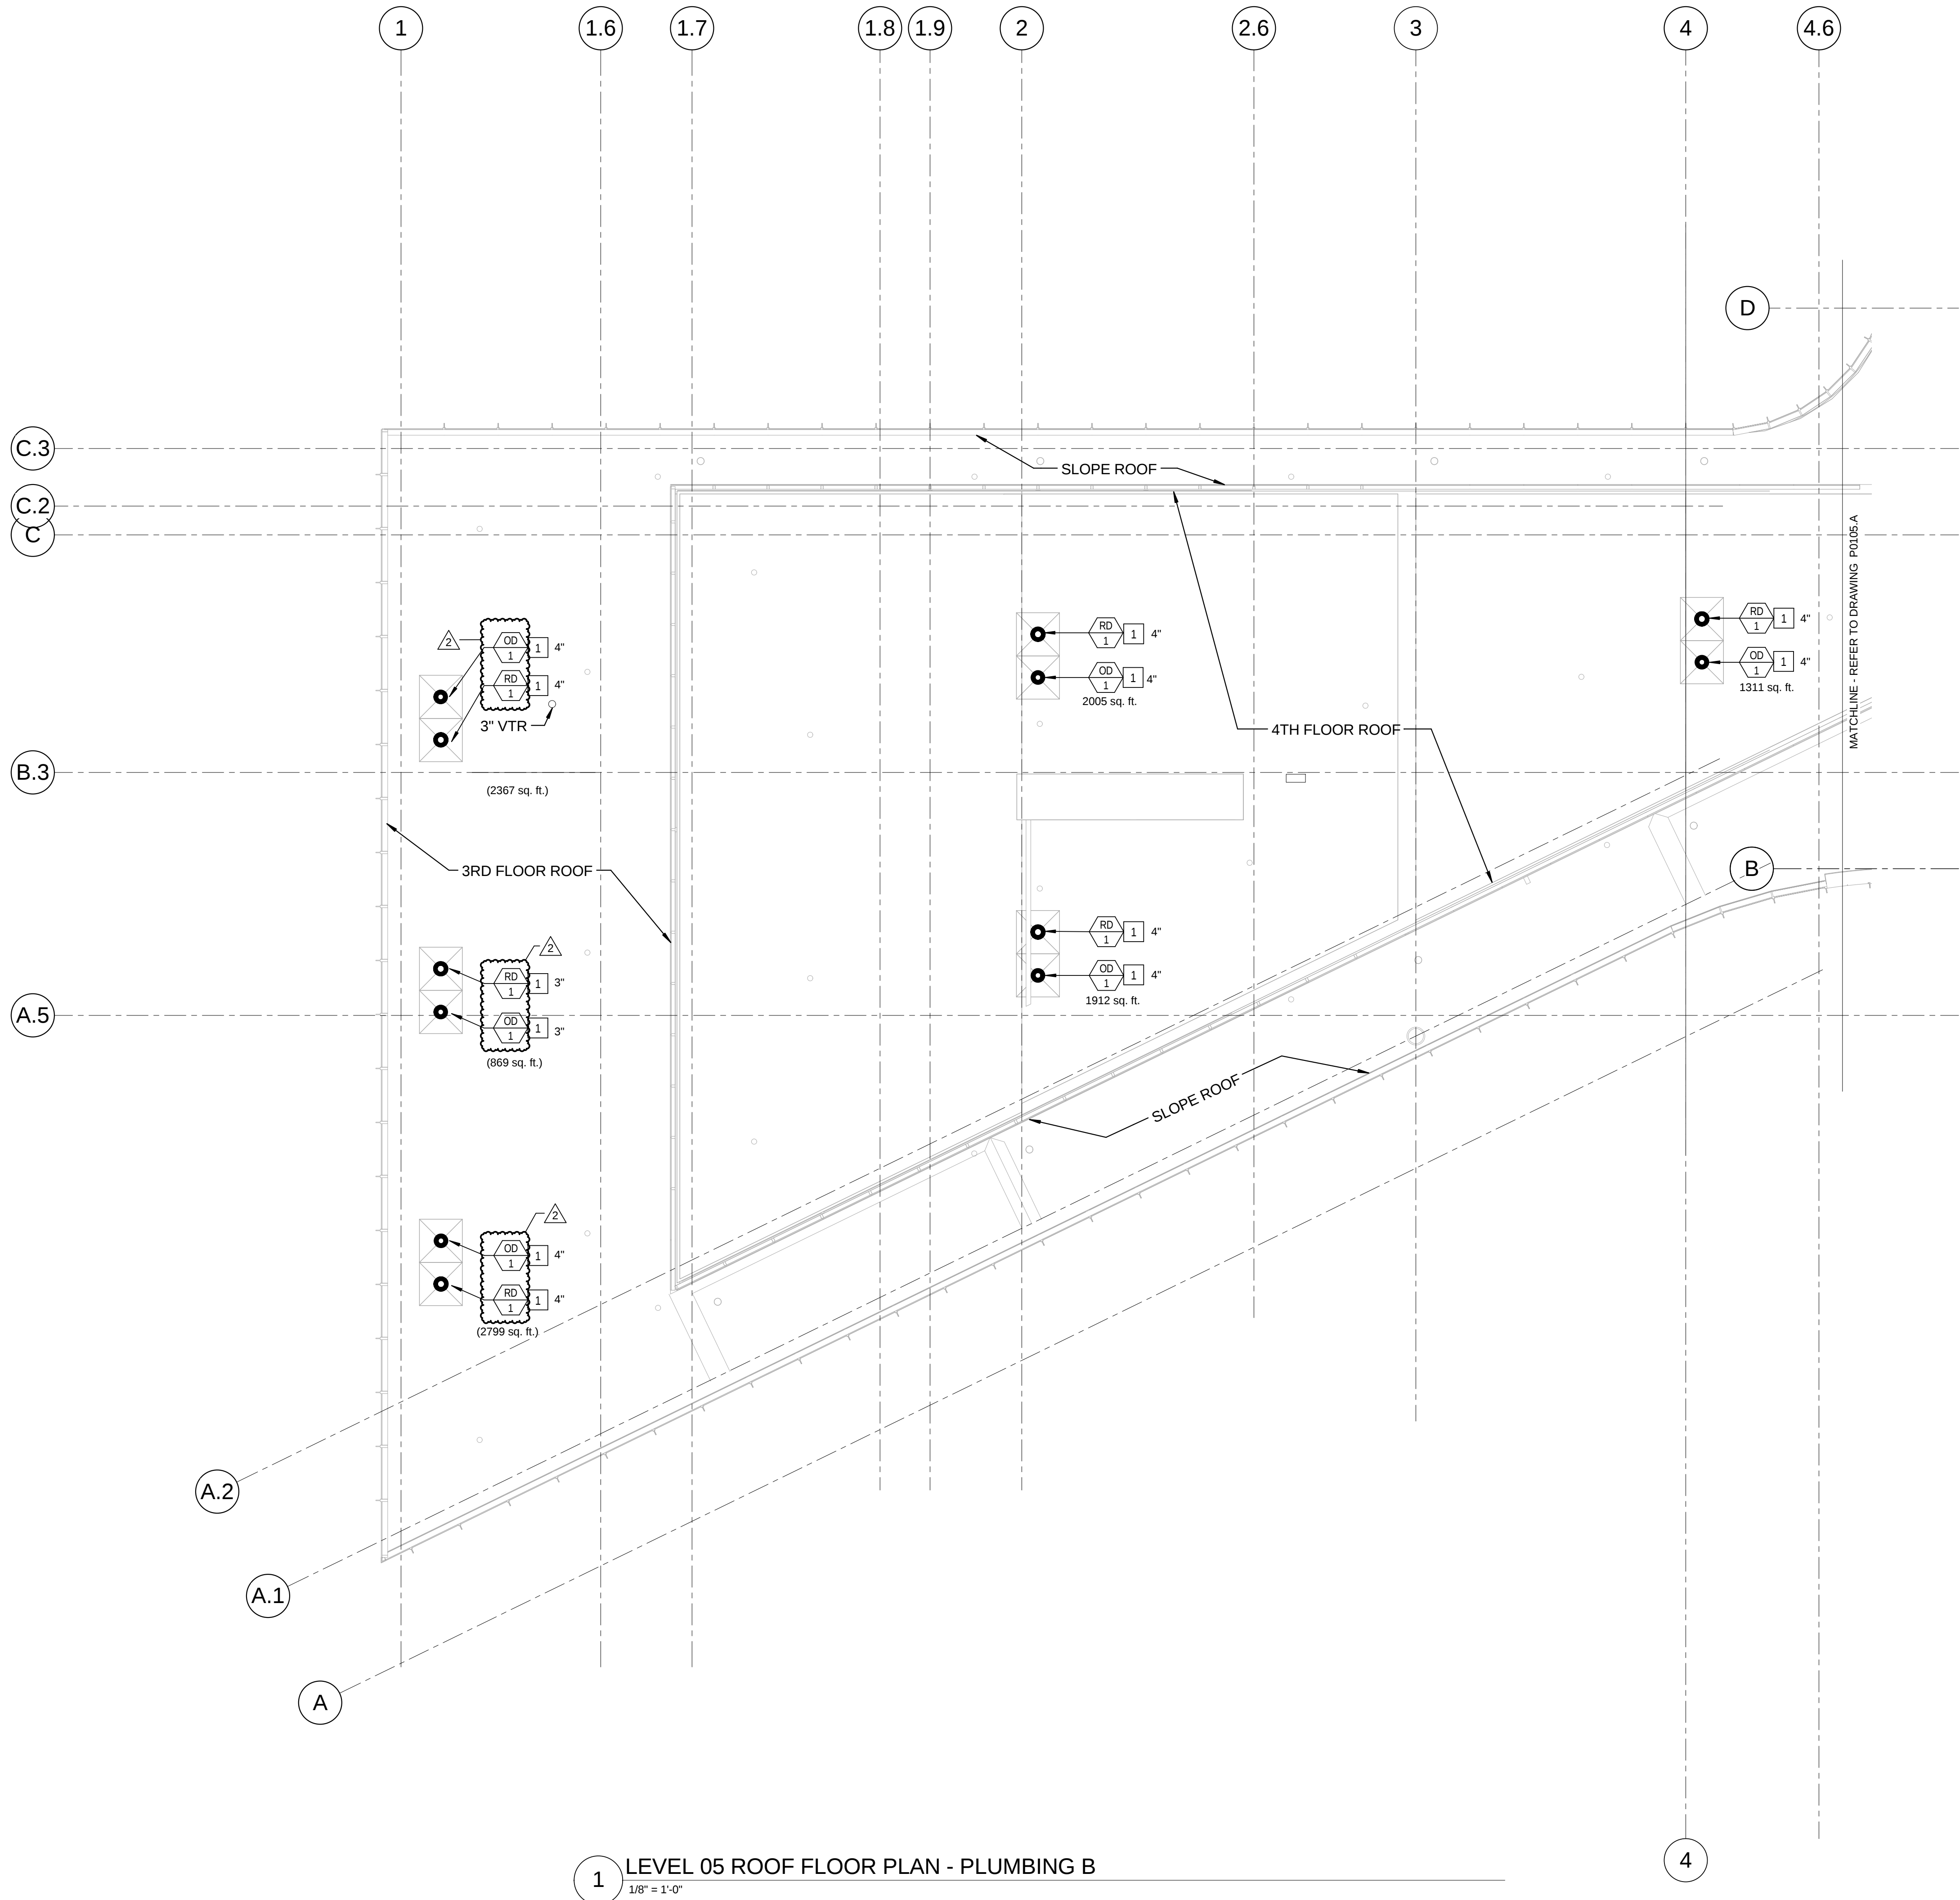

NOTE - PLUMBING NEW WORK

1. CONTRACTOR SHALL FURNISH AND INSTALL ROOF DRAINS AND OVERFLOW DRAINS. REFER TO DETAIL ON DRAWING P0501.
2. 3/4\"/>

1 LEVEL 05 ROOF FLOOR PLAN - PLUMBING B
1/8\"/>