


7	ASI - 033 (RFI 261,286,309 & 310)	03 NOV 2016
6	ASI - 025 Neutralization Tanks	09 SEP 2016
5	ASI - 024 (RFI 222,233,235 & 236)	24 AUG 2016
4	ASI - 014 (RFI-176)	21 JUL 2016
3	ADDENDUM 2-4	24 MAY 2015
2	ADDENDUM 2-2	19 APR 2016
1	ADDENDUM 2-1	17 MAR 2016
-	ISSUED FOR CONSTRUCTION (BP2)	01 MAR 2016

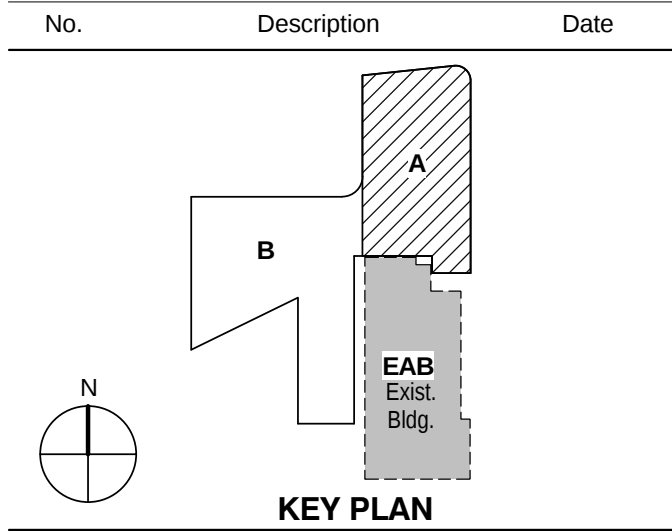


LEVEL 01 AREA A FLOOR
PLAN - PLUMBING WASTE
AND VENT

Project No.: 04561.01 Checked by:

P0111.A

KEYED NOTES: (THIS SHEET ONLY)

- 3" SANITARY WASTE AND 3" SANITARY VENT RISERS.
- 3" SANITARY WASTE OFF-SET ABOVE THE CEILING TO CONTINUE DOWN TO LEVEL 0.
- 4" SANITARY VENT RISER UP AND DOWN.
- 4" SANITARY WASTE UP AND DOWN. REFER TO DRAWING P0401 FOR RISER DIAGRAM.
- 2" SANITARY WASTE UP AND DOWN. REFER TO DRAWING P0401 FOR RISER DIAGRAM.
- 2" SANITARY VENT UP AND DOWN.
- 2" SANITARY VENT DOWN IN WALL TO SERVE LABORATORY SINK.
- 2" SANITARY VENT DOWN IN WALL TO SERVE EMERGENCY SHOWER.
- 2" SANITARY WASTE UP TO LEVEL 2 LAB SINK.
- 2" SANITARY WASTE UP TO LEVEL 2 EMERGENCY SHOWER EYE/FACE WASH STATION. REFER TO DRAWING P0403 DETAIL 3/ P0403.
- FLOOR SINK TO BE LOCATED BELOW THE CASEWORK TO ACCEPT DISCHARGE FROM THE DISHWASHER AND UNDER COUNTER ICE MAKER. COORDINATE LOCATION WITH CABINET AND APPLIANCES.
- 2" SANITARY VENT UP TO LEVEL 2, ALIGN WITH CASEWORK AND WALL ABOVE.
- FLOOR SINK SET TO SERVE LEVEL 2. COORDINATE LOCATION OF FLOOR SINK WITH CASEWORK ABOVE AND WITH ABOVE CEILING CONDITIONS ON THIS LEVEL.
- FLOOR SINK SET TO SERVE THIS LEVEL.
- PIPING IN EACH ROOM TO BE RUN AS HIGH AS POSSIBLE TO AVOID CONFLICTS. COORDINATE INSTALLATION AND ROUTING WITH OTHER TRADES PRIOR TO ROUGH-IN.
- 2" SANITARY WASTE AND 2" SANITARY VENT RISERS TO SERVE ELECTRIC WATER COOLERS ON EACH LEVEL. REFER TO DRAWING P0401 FOR WASTE AND VENT RISERS.
- 3" SANITARY WASTE AND 2" VENT RISERS TO SERVE MOP BASINS ON LEVELS 1 AND 3 AND COUNTERTOP SINK ON LEVEL 2. REFER TO DRAWING P0401 FOR WASTE AND VENT RISER.
- 2" VENT UP FROM LEVEL 0. REFER TO DRAWING P0011.
- 3" WASTE DOWN TO LEVEL 0. REFER TO DRAWING P0011 FOR CONTINUATION.
- 2" WASTE DOWN TO LEVEL 0. REFER TO DRAWING P0011 FOR CONTINUATION.
- 2" DISCHARGE FROM ELEVATOR SUMP PUMP. EXTEND TO ABOVE THE CEILING OF LEVEL 1 TO JANITOR CLOSET 175.
- TERMINATE ELEVATOR SUMP PUMP DISCHARGE AT THE MOP BASIN WITH AN IN-DIRECT WASTE INTO THE BASIN.
- REFER TO DRAWING P0402 DETAIL 2/ P0402, FOR PLUMBING RISER DIAGRAMS.
- REFER TO DRAWING P0402 DETAIL 1/ P0402, FOR PLUMBING RISER DIAGRAMS.
- REFER TO DRAWING P0404 SANITARY WASTE AND VENT RISER DIAGRAM 2-2.
- REFER TO DRAWING P0406 SANITARY WASTE AND VENT RISER DIAGRAM 3-2.
- REFER TO DRAWING P0406 SANITARY WASTE AND VENT RISER DIAGRAM 3-4.
- REFER TO DRAWING P0408 SANITARY WASTE AND VENT RISER DIAGRAM 4-1.
- REFER TO DRAWING P0408 SANITARY WASTE AND VENT RISER DIAGRAM 5-1.
- REFER TO DRAWING P0404 SANITARY WASTE AND VENT RISER DIAGRAM 1-1.
- TROUGH SAFETY PAN TO BE SUSPENDED BELOW SANITARY WASTE PIPING. EXTEND 1" DRAIN TO SANITARY FLOOD RECEPTOR. REFER TO PLUMBING DRAWING P0503, DETAIL 4.
- NOT USED.
- 2" VENT DOWN IN WALL TO SERVE FLOOR DRAIN IN LOADING DOCK.
- 4" C.I. STANDPIPE FOR SPRINKLER DRAIN. STUB 24" AFF.
- 2" SANITARY WASTE UP TO POINT-OF-USE NEUTRALIZATION TANK.

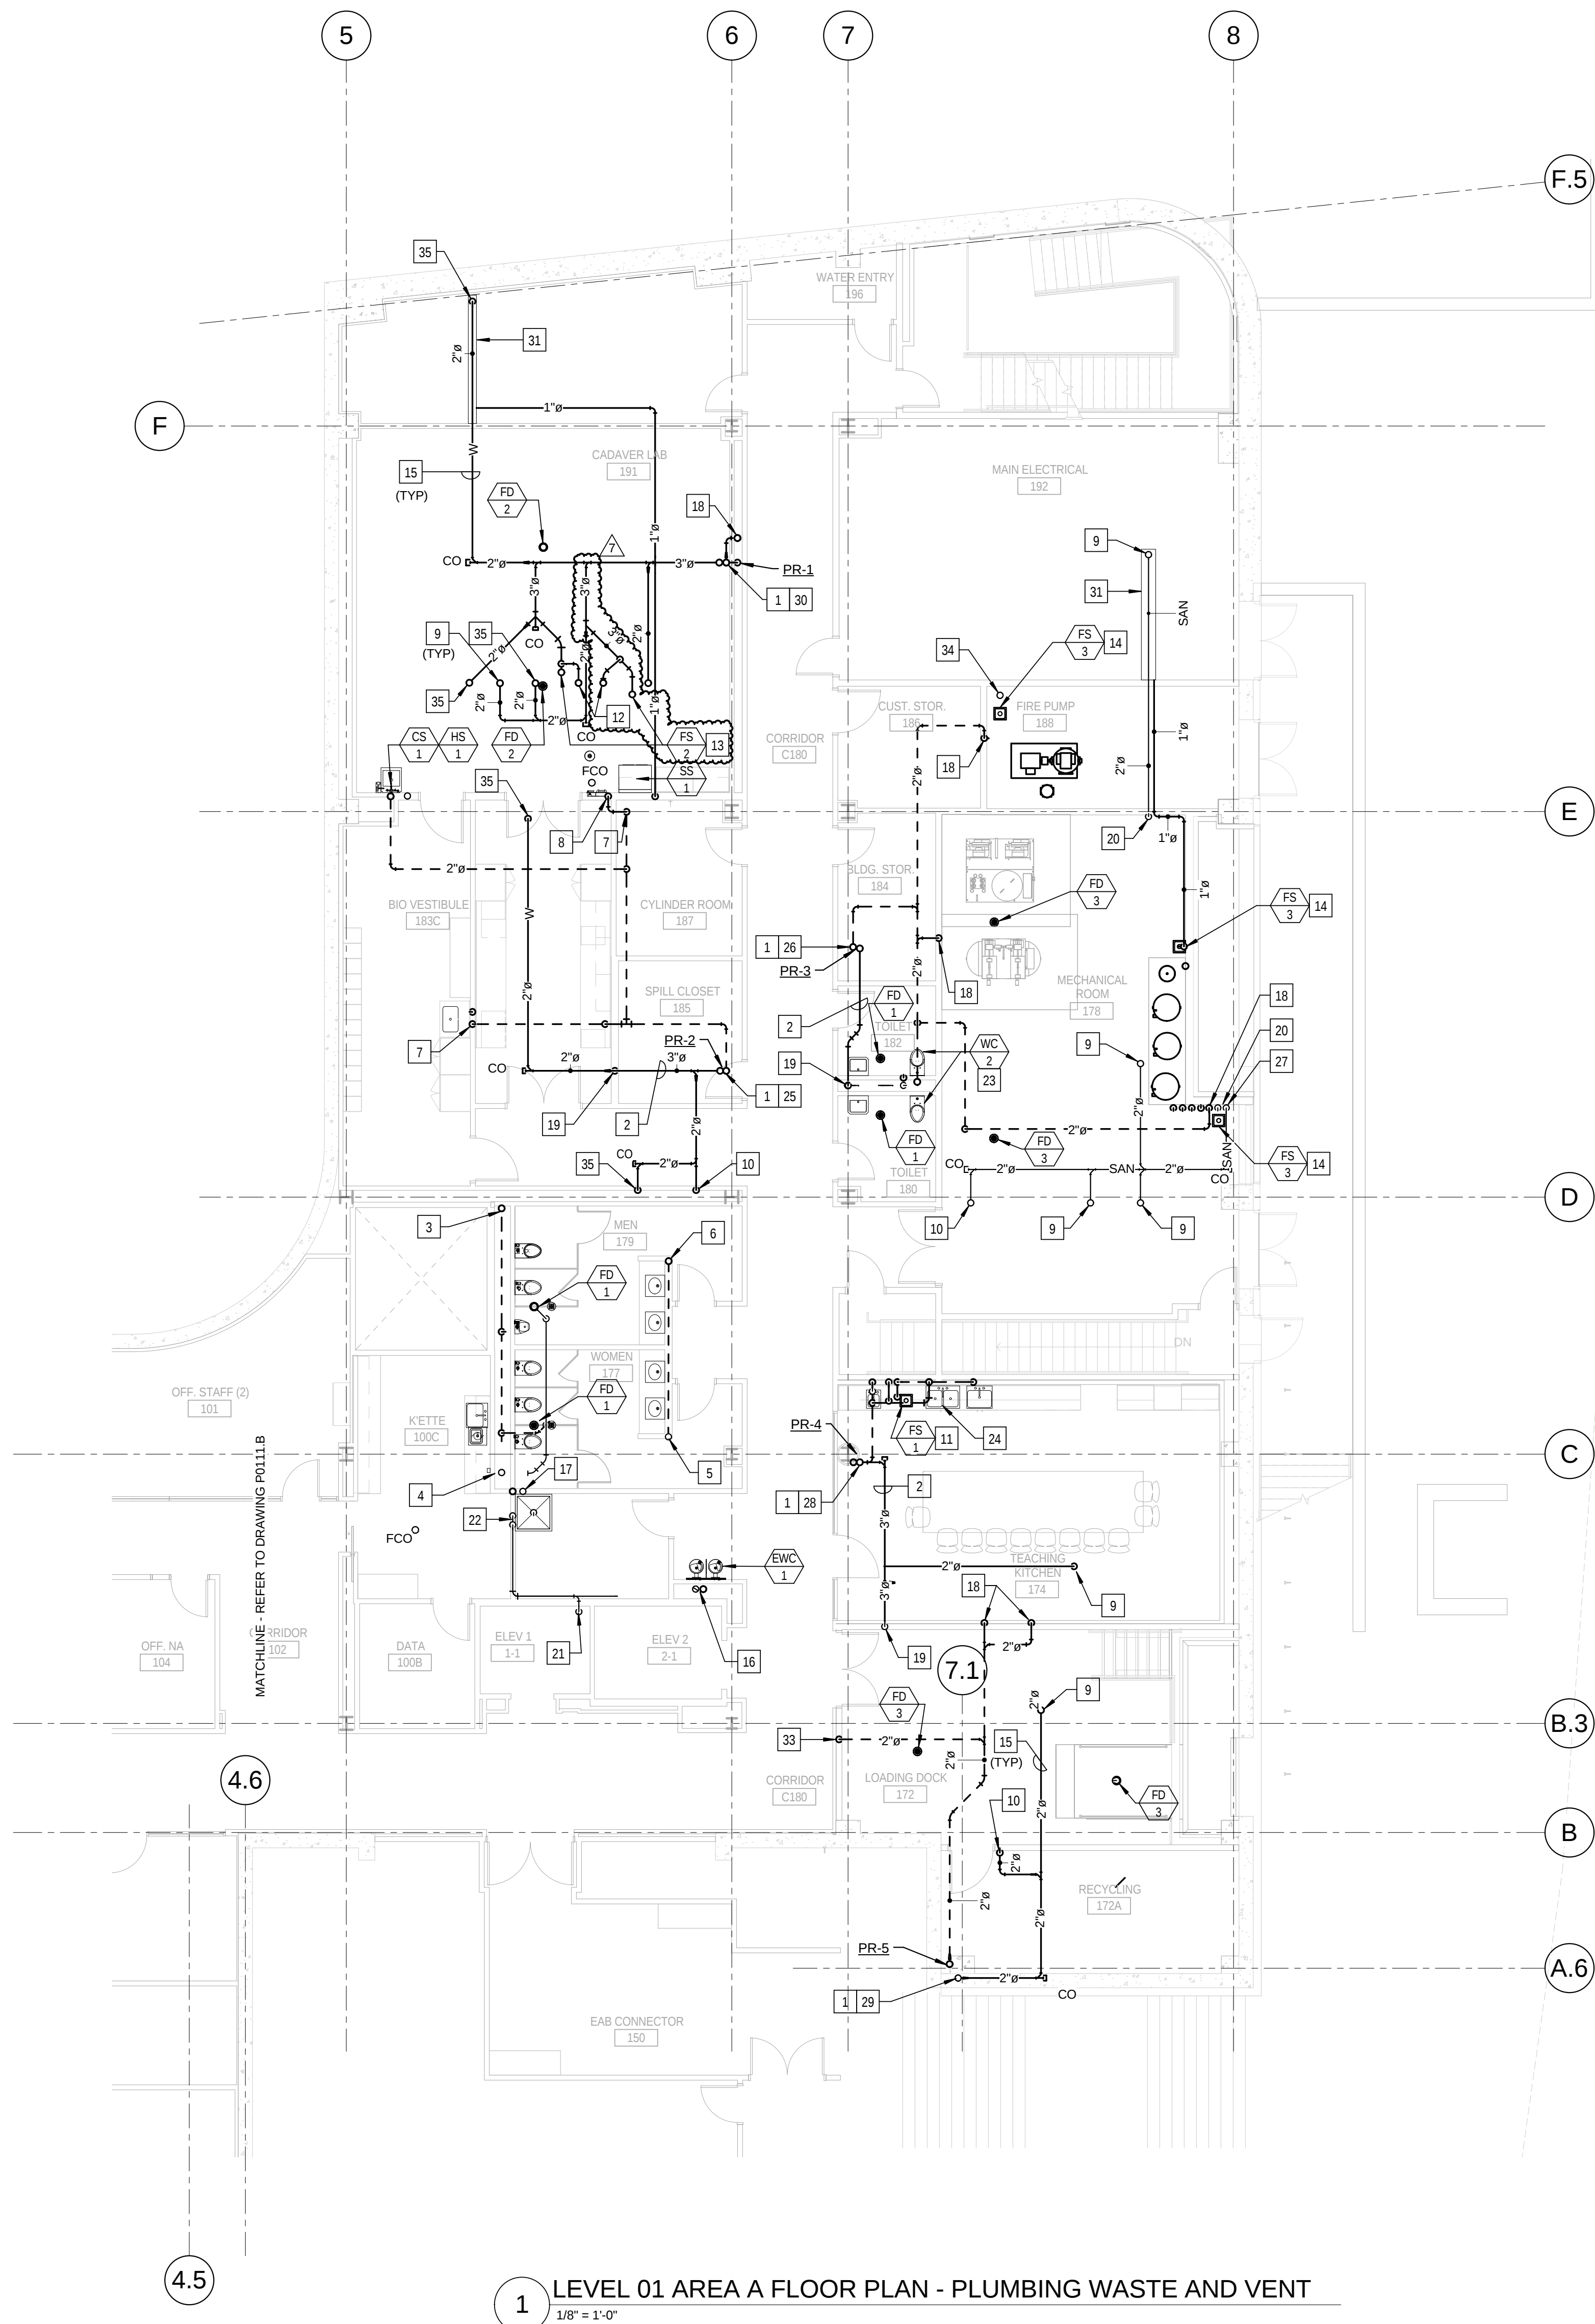

1 LEVEL 01 AREA A FLOOR PLAN - PLUMBING WASTE AND VENT
1/8" = 1'-0"