


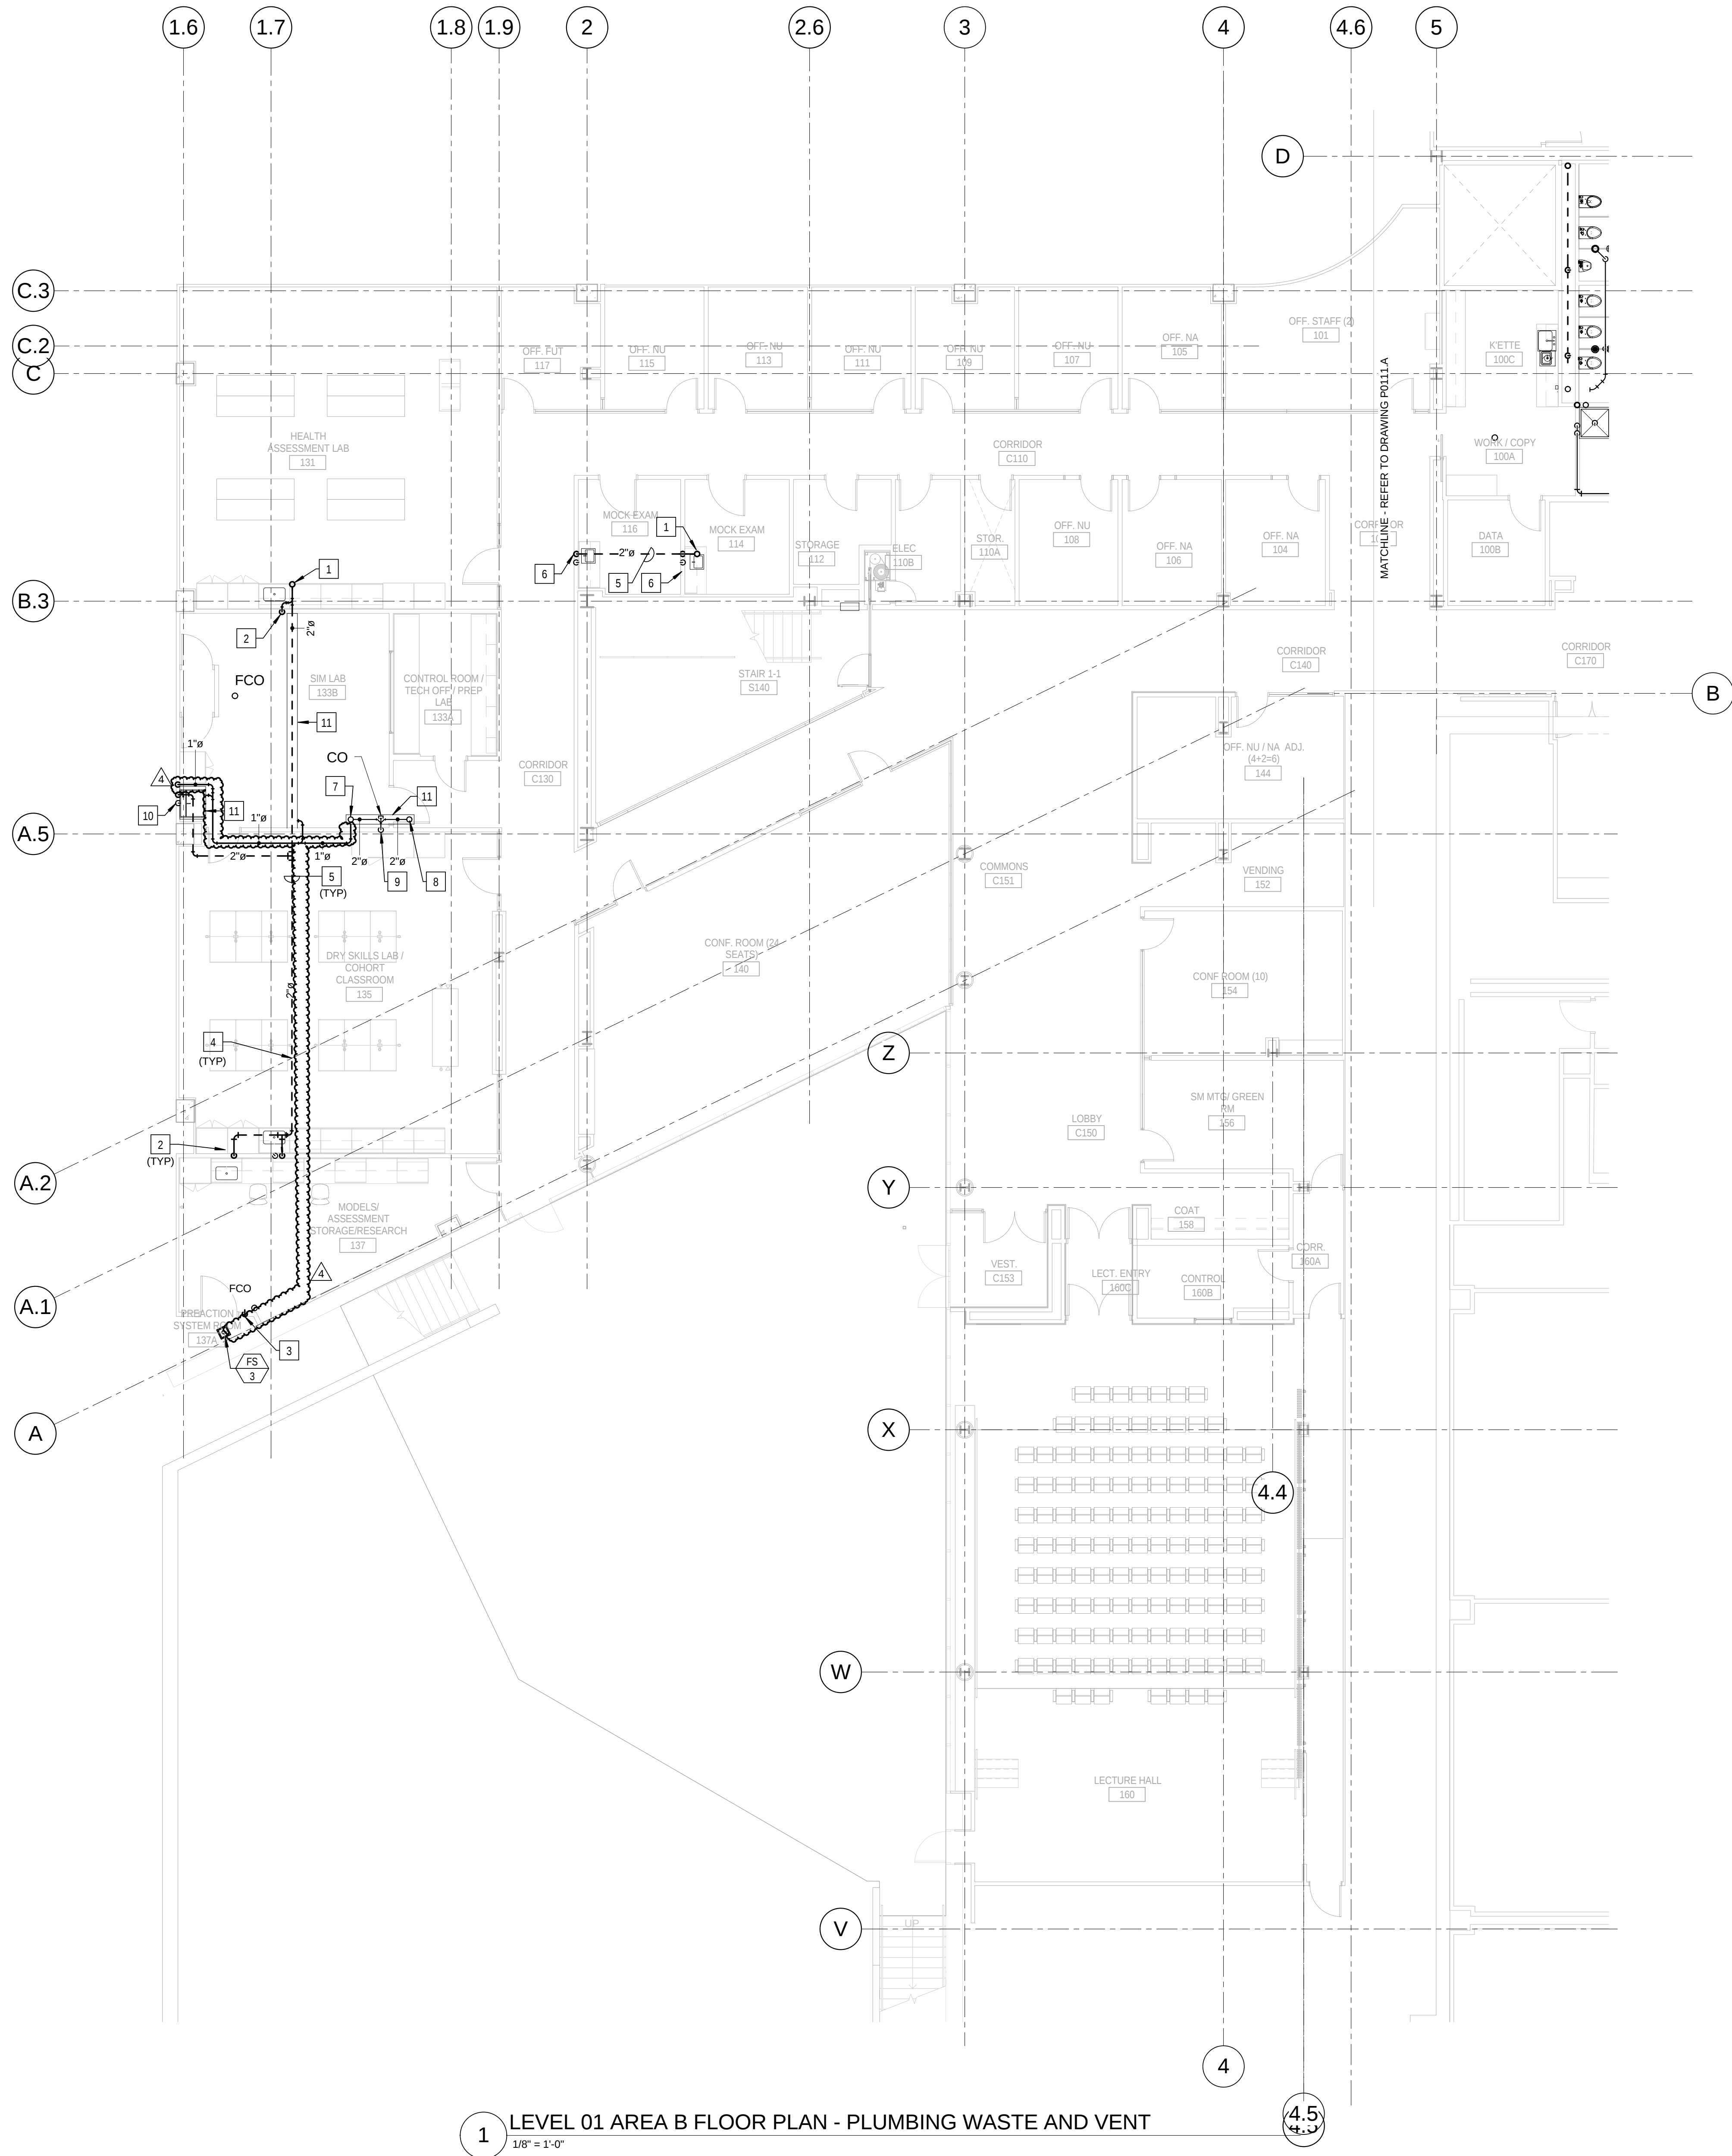


KEYED NOTES: (THIS SHEET ONLY)

- 1 2" SANITARY VENT UP TO LEVEL 2, ALIGN WITH WALLS ABOVE. REFER TO DRAWING P0112.B FOR CONTINUATION.
 - 2 2" SANITARY VENT DOWN IN WALL TO SERVE LAB SINK.
 - 3 2" SANITARY VENT IN WALL FROM UNDERFLOOR SERVING FLOOR SINK. COORDINATE ROUTING AND INSTALLATION WITH WALL CONSTRUCTION.
 - 4 HOLD PIPING TIGHT TO BOTTOM OF STRUCTURAL STEEL.
 - 5 PIPING IN EACH ROOM TO BE RUN AS HIGH AS POSSIBLE TO AVOID CONFLICTS. COORDINATE INSTALLATION AND ROUTING WITH OTHER TRADES PRIOR TO ROUGH-IN.
 - 6 2" SANITARY VENT DOWN IN WALL TO SERVE EXAM ROOM SINKS.
 - 7 2" SANITARY WASTE UP TO LEVEL 2 TO SERVE LAB SINK. ALIGN WITH WALL ABOVE. REFER TO DRAWING P0112.B FOR CONTINUATION.
 - 8 2" SANITARY WASTE UP TO LEVEL 2 EMERGENCY SHOWER EYE/FACE WASH STATION. ALIGN WITH WALL ABOVE. REFER TO DRAWING P0112.B FOR CONTINUATION.
 - 9 2" SANITARY WASTE DOWN IN WALL TO UNDERFLOOR. REFER TO DRAWING P0011 FOR CONTINUATION.
 - 10 2" SANITARY VENT DOWN IN WALL TO SERVE SURGICAL SCRUB SINK.
- SHEET METAL TROUGH BELOW PIPING. REFER TO DETAIL 4 ON DRAWING P0503. EXTEND DRAIN AS INDICATED AND TERMINATE AT FLOOR SINK.

4	ASI - 024 (RFI 222.233.235 & 236)	24 AUG 2016
3	ASI - 013 (RFI 110.153.161 & 178)	17 JUL 2016
2	ADDENDUM 2-2	19 APR 2016
1	ADDENDUM 2-1	17 MAR 2016
-	ISSUED FOR CONSTRUCTION (BP2)	01 MAR 2016

No.	Description	Date
-----	-------------	------

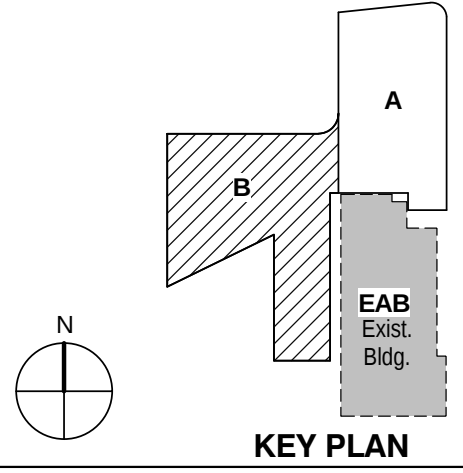

KEY PLAN

Drawing Title:

**LEVEL 01 AREA B FLOOR
PLAN - PLUMBING WASTE
AND VENT**

Project No.: 04561.01 Checked by:

P0111.B